

**Addendum No. 2  
January 19, 2024**

Project: **Lennox High School Addition**  
Lennox, South Dakota  
Architecture Incorporated Project No.: 2982

Architect: Architecture Incorporated

Letting: **Thursday, January 25, 2024  
2:00 p.m. (prevailing time)**

Location: Lennox School District Administrative Conference Room located at 305 West 5<sup>th</sup> Avenue, Lennox, SD 57039.

Scope of this Addendum:

To all bidders and all others to whom drawings and specifications have been issued by Architecture Incorporated, this Addendum forms a part of the Contract Documents. Acknowledge receipt of this addendum by listing its number and date in the bidder's Form of Proposal. Failure to do so may subject bidder to disqualification. This addendum modifies the drawings and specifications as follows:

1) GENERAL CLARIFICATIONS

- a) Any / all interior room signage will be furnished and installed by the Owner.
- b) Exterior aluminum signage is in the contract as specified per Addendum #2; see below.
- c) Audio – Video – Lighting drawing Sheets are being included for the Contractor's use / reference only; seven (7) pages total.
  - i. Reference A/V drawings Sheets AV-001, AV-002, AV101, AV102, AV103, AV-201 & AV211, all dated 12-21-23, attached to the end of this addendum.
  - i. CLARIFICATION: Per his Base Bid, the electrical contractor shall be responsible for furnishing all necessary AV raceways and boxes as indicated per the AV drawing Sheets; reference the electrical drawing Sheets for additional information / coordination.
- d) Reference supplemental architectural drawing SD-3, dated 1-19-24, attached to the end of this addendum for clarifications to the sound chamber plan details, specifically regarding hardwood veneer plywood paneling. Reference additional information in addendum Item #3.

2) SECTION 011000 - SUMMARY

- a) Paragraph 1.5.D. Work Sequence for Phase One: Add the following: The Tennis courts, alternates #2 and #3 if accepted by the Owner shall have substantial completion by August 16, 2024. Final completion of all push list items shall be completed by August 30, 2024.

3) 062023 INTERIOR FINISH CARPENTRY

- a) Add the following to Section 062023:
  - i. PANELING

- (1) Hardwood Veneer Plywood Paneling: Manufacturer's stock hardwood plywood panels complying with HPVA HP-1, **made without urea-formaldehyde adhesive.**

- (a) Face Veneer Species and Cut: **[Plain-sliced red oak]**
- (b) Veneer Matching: **[Random match]**.
- (c) Backing Veneer Species: **[Any hardwood compatible with face species]**.
- (d) Construction: Veneer core.
- (e) Thickness: 3/8".
- (f) Panel Size: As needed to match application shown on drawings.
- (g) Glue Bond: Type II (interior).
- (h) Finish: Stained as indicated in Section 099300.
- (i) Location: Theater recesses.

4) SECTION 096816 - SHEET CARPETING

- a) CLARIFICATION: All sheet carpeting to be installed in the most economical direction for each room.

5) SECTION 123216 – MANUFACTURED PLASTIC-LAMINATE-FACED CASEWORK

- a) CLARIFICATION:

- i. The following cabinet drawer construction shall be deemed acceptable:

- (1) 5/8" thick dovetailed drawer boxes made from hardwood.
- (2) Drawer floors made from 1/4" UV Birch in a captured dado.
- (3) Blum undermount glides; full access; with soft closure mechanism. Heavy-duty glides provided where specified.

6) SECTION 230800 – VENTILATION & AIR CONDITIONING

- a) Modify Article 1.06 - ENERGY RECOVERY VENTILATOR as follows:

- i. ERV: Delete bypass dampers.

7) SHEET 2.20 – SITE DEMOLITION

- a) Omit references to extent of existing asphalt paving and curb and gutter to be removed. The extent and location of asphalt paving and curb and gutter demolition is shown and noted on drawing 2.30.

8) SHEET 3.20-D – FOUNDATION PLAN – AREA D

- a) Reference door G118-2 (between Corridor D119 and Lobby G118); see architectural drawing Sheet 4.10-D.

- i. Sawcut the top of the existing foundation wall down 8" to allow the new slab-on-grade to pour on top of the existing foundation wall.

9) SHEET 3.21-G – MEZZANINE FLOOR & LOW ROOF FRAMING – AREA G

- a) Reference revised structural drawing Sheet 3.21-G, revision dated 1-18-24, attached to the end of this addendum for the following:

- i. Change detail reference of 17/3.51 (cut along the edge of the north and south mezzanine floor) to detail 22/3.51.
- ii. Add beam size tag along gridline G4 between grids GA and GC per the clouded revision on the attached revised sheet.

- iii. Change detail reference of 17/3.51 cut along the west edge of the mezzanine floor to 4/3.50 as shown within the clouded revision on the attached revised sheet.
  - iv. Add reference detail 4/3.50 SIM to north and south ends of raker framing to precast walls per the clouded revision on the attached revised sheet.
- 10) SHEET 3.22-G – CATWALK FRAMING – AREA G
  - a) CLARIFICATION: The Contractor shall reference architectural drawing Sheet 4.12-G for the extent of ½” plywood required to be installed over metal decking at the catwalk area that parallels the north wall of Theater G105.
    - i. Provide a plywood-covered walkway 48” wide as indicated per Sheet 4.12-G; full plywood coverage of metal decking at deck Type D4 in this vicinity is shown incorrectly on Sheet 3.22-G.
- 11) SHEET 3.41 – DETAILS - FOUNDATION
  - a) Detail 9: Change 12” thick pre-cast concrete wall and 12” thick cast-in-place foundation wall to 14” thick. Center #6 vertical bars in the center of the 14” thick cast-in-place foundation wall.
- 12) SHEET 3.42 – DETAILS - FOUNDATION
  - a) Detail 1: Add ½” dia. X 3” long HAS @ 24”oc to the bottom of the L3x3x1/16 x cont. angle. Add #4 dowels @ 24”oc; reference the clouded area on revised structural drawing Sheet 3.42, revision dated 1-18-24, attached to the end of this addendum.
- 13) SHEET 3.50 – DETAILS - PRECAST
  - a) Detail 13: Add L6x4x3/8 X cont. pour stop for concrete topping. Add ¼”x6”x6” embed plate @ 2’-0” o.c. w/ (2) ½” dia x 4” HSA for angle connection. Add weld notes for pour stop to plank connection, and guardrail to pour stop connection; reference the clouded area on revised structural drawing Sheet 3.50, revision dated 1-18-24, attached to the end of this addendum.
- 14) SHEET 3.51 - DETAILS - MASONRY
  - a) Reference revised structural drawing Sheet 3.51, revision dated 1-18-24, attached to the end of this addendum for the following:
    - i. Detail 11: Add 3/16”x2” long fillet weld between the ¼”x4” CONT. PLATE and the L4x4x4x1/4.
    - ii. Add detail 22.
  - b) CLARIFICATION: Detail 20 - Follow general framing notes for deck edge support.
- 15) SHEET 3.67 – DETAILS – FRAMING
  - a) Reference revised structural drawing Sheet 3.51, revision dated 1-18-24, attached to the end of this addendum for the following:
    - i. Detail 1: Add Iweiss clip and bolt to catwalk hangers at every third pipe of pipe grid.
    - ii. Detail 4: Add Iweiss wall stabilizer bracket every 4<sup>th</sup> pipe attached to concrete wall.

16) SHEET 3.68 – DETAILS – FRAMING

- a) Detail 5: Add L6X4X5/16” angle between catwalks for toe kicks. Attach angle to W14x22 with 3/16” fillet weld at 2@12”oc spacing; reference the clouded area on revised structural drawing Sheet 3.68, revision dated 1-18-24, attached to the end of this addendum.

17) SHEET 4.00-D – DEMOLITION PLAN – FIRST FLOOR

- a) The demolition floor plan note which reads “REMOVE DOORS” at the east end of Corridor D100A shall be changed to read:

***REMOVE DOOR LEAFS; EXISTING LINTEL AND DOOR FRAME TO REMAIN***

- b) Reference existing storage room D118. The existing south exterior door note shall be changed to remove existing hollow metal door and hardware. Salvage hardware to the owner, existing frame to remain.

18) SHEET 4.10-E – FLOOR PLAN – AREA E

- a) Reference *revised* drawing Sheet 4.10-E, dated 1-18-24, attached to the end of this addendum for following:
  - i. Locker Room E115, omit note regarding 87 lockers. Provide locker quantity as shown.
  - ii. Provide 2” of rigid insulation beneath the concrete floor slabs at all in-floor heat locations in Fitness Room E103, Lobby F101 and Vestibule F100 as shown on attached drawing 4.10-E.

19) SHEET 4.10-F – FLOOR PLAN – AREA F – BASE BID

- a) Reference *revised* drawing Sheet 4.10-F, dated 1-18-24, attached to the end of this addendum for identification of floor slab areas in Lobby F101 and Vestibule F100 that shall be provided with under-slab insulation.

20) SHEET 4.10-F-A – FLOOR PLAN – AREA F – ADD ALTERNATES

- a) Reference *revised* drawing Sheet 4.10-F-A, dated 1-18-24, attached to the end of this addendum for identification of floor slab areas in Lobby F101 and Vestibule F100 that shall be provided with under-slab insulation.

21) SHEET 4.11-F – MEZZANINE PLAN – AREA F – BASE BID

- a) CLARIFICATION: The dimensions shown at the northeast corner of Lobby F101 shall be changed to match the new aluminum storefront clerestory window (Base Bid) dimensions / layout identified per *revised* architectural drawing Sheet 5.14; reference revised drawing Sheet 5.14 which is attached to the end of this addendum.

22) SHEET 4.11-F-A – MEZZANINE PLAN – AREA F – ADD ALTERNATE

- a) CLARIFICATION: The dimensions shown at the northeast corner of Lobby F101 shall be changed to match the new aluminum storefront clerestory window (Add Alternate #1) dimensions / layout identified per *revised* architectural drawing Sheet 5.14; reference revised drawing Sheet 5.14 which is attached to the end of this addendum.



23) SHEET 4.20-E FINISH PLAN AREA E

- a) E103 Fitness Room: Add T-2 wall finish to room finish schedule. Provide T-2 at Electric Water Cooler as shown on finish plan.
- b) E110 Shower: Provide T-2 at shower walls extending the full length of the east wall.
- c) E117 Shower: Provide T-2 at shower walls extending the full length of the west wall.

24) SHEET 4.20-F FINISH PLAN AREA F

- a) F101 Lobby: Add T-4 and T-6 to room finish schedule. Provide T-4 and T-6 on wall at Electric Water Cooler as shown per interior elevation 2/4.51.

25) SHEET 4.20-F-A FINISH PLAN AREA F – ADD ALTERNATE

- a) F101 Lobby: Add T-4 and T-6 to room finish schedule. Provide T-4 and T-6 on wall at Electric Water Cooler as shown per interior elevation 2/4.51.

26) SHEET 4.40- ENLARGED PLANS – RESTROOM, LOCKER ROOM & CONCESSIONS

- a) Reference *revised* drawing Sheet 4.40, dated 1-18-24, attached to the end of this addendum for the following:
  - i. The Contractor shall include furnishing and installing metal trim / filler panels and sloped locker tops where the lockers form inside corners. Reference the NW & SW corners of Locker E115 and the NE & SE corners of Locker E108.
  - ii. The Contractor shall include furnishing and installing metal trim / filler panels and sloped locker tops where the lockers abut CMU walls in Locker E115 and Locker E108, as indicated per revised drawing Sheet 4.40.
  - iii. Provide an additional 16” of CMU wall at the entrance to Locker E115 to prevent line of sight issues as indicated per revised drawing Sheet 4.40.
  - iv. Provide an additional 16” of CMU wall at the entrance to Locker E108 to prevent line of sight issues as indicated per revised drawing Sheet 4.40.

27) SHEET 5.10 – EXTERIOR ELEVATIONS

- a) Reference *revised* drawing Sheet 5.10, dated 1-18-24, attached to the end of this addendum for the following:
  - i. The exterior lettering shown above the new east entrance has been changed to read **“ACTIVITIES ENTRANCE”** in lieu of ACTIVITIES ENTRY.
    - 1. This exterior lettering shall be furnished and installed by the Contractor under his Base Bid.
    - 2. Reference Section 101419 “*Dimensional Letter Signage*”, dated 1-16-24, attached to the end of this addendum for product specification; 5 pages total.
  - ii. Corrections have been made with regard to the precast wall panel finish; reference exterior elevations A, B & C/5.10.

28) SHEET 5.11 – EXTERIOR ELEVATIONS-AREA F-ADD ALTERNATE

- a) Reference *revised* drawing Sheet 5.11, dated 1-18-24, attached to the end of this addendum for the following:
  - i. The exterior lettering shown above the new east entrance shall be changed to read “**ACTIVITIES ENTRANCE**” in lieu of ACTIVITIES ENTRY.
    - 1. This exterior lettering shall be furnished and installed by the Contractor under his Base Bid.
    - 2. Reference Section 101419 “*Dimensional Letter Signage*”, dated 1-16-24, attached to the end of this addendum for product specification; 5 pages total.
  - ii. Corrections have been made with regard to the precast wall panel finish; reference exterior elevations A, B & C/5.11.

29) SHEET 5.13 – EXTERIOR ELEVATIONS

- a) Reference *revised* drawing Sheet 5.13, dated 1-18-24, attached to the end of this addendum for the following:
  - i. Corrections have been made with regard to the precast wall panel finish; reference exterior elevation C/5.13.

30) SHEET 5.14 – WINDOW/ STOREFRONT ELEVATIONS & DETAILS

- a) Reference *revised* drawing Sheet 5.14, dated 1-18-24, attached to the end of this addendum for the following:
  - i. Dimensional adjustments have been made to the Base Bid aluminum storefront clerestory windows; reference aluminum storefront elevation 10/5.14.
  - ii. Dimensional adjustments have been made to the Add Alternate #1 aluminum storefront clerestory windows; reference aluminum storefront elevation 10/5.14.

31) SHEET 5.21 – BUILDING SECTIONS

- a) Reference *revised* drawing Sheet 5.21, dated 1-18-24, attached to the end of this addendum for the following:
  - i. Additional wall detail callouts have been added to building sections A, E & F.
  - ii. Top of wall elevations have been added to building section E.
  - iii. Joist bearing elevations have been added to building sections B, C, E & F

32) SHEET 5.22 – BUILDING SECTIONS

- a) Additional detail callouts have been added to building sections B, C & E to identify the required detail where new roofs intersect existing building walls clad with (existing) metal wall panels.

33) SHEET 5.41 – SECTION DETAILS

- a) Revise detail 7/5.41 as indicated per *revised* drawing Sheet 5.41, dated 1-18-24, attached to the end of this addendum.
- b) Reference architectural supplemental drawing SD-1, dated 1-18-24 attached to the end of this addendum for existing metal wall panel tie-in detail.

34) SHEET 5.42 – SECTION DETAILS

- a) Reference *revised* drawing Sheet 5.42, dated 1-18-24, attached to the end of this addendum for following:
  - i. Detail 5/5.42 has been modified to match structural detail 7/3.60. The dimension from Grid EF to the roof edge has been changed to 2'-11".
  - ii. Detail 7/5.42 has been modified to match structural detail 2/3.60. The dimension from Grid E to the roof edge has been changed to 2'-3".
  - iii. **NEW** architectural detail 10/5.42 has been added to this Sheet; this detail is referenced per building section A/5.21.

35) SHEET 5.44 – SECTION DETAILS

- a) Reference *revised* drawing Sheet 5.42, dated 1-18-24, attached to the end of this addendum for following:
  - i. Detail 8/5.44: Change thickness of rigid insulation on the exterior side of the steel stud framing from 1 ½" thick to 3" thickness to match the 3" insulation below in detail 15/5.44.
  - ii. Details 10 & 11/5.44 have been modified to reference supplemental drawing SD-1.
    - (1) Reference architectural supplemental drawing SD-1, dated 1-18-24 attached to the end of this addendum for large scale detail at existing metal wall panel tie-in locations.
    - (2) CLARIFICATION: As indicated per supplemental drawing SD-1, the Contractor's Base Bid shall include removing the existing metal wall panels, modifying the length of the existing metal wall panels, and subsequently reinstalling the existing metal wall panels.

36) SHEET 5.45 – SECTION DETAILS

- a) Reference *revised* drawing Sheet 5.45, dated 1-18-24, attached to the end of this addendum for new head detail 6/5.45 and new sill detail 7/5.45 at door F200-2. These details are called out in building section E/5.21.

37) SHEET 5.50 – ROOF PLAN

- a) CLARIFICATION: The roof joist bearing elevation at the canopy above the new east entrance shall be 11'-8".
  - i. Disregard the 11'-4" joist bearing elevation originally shown.

38) SHEET 6.10-D – REFLECTED CEILING PLAN - AREA B, C & D

- a) Reference *revised* drawing Sheet 6.10-D, dated 1-18-24, attached to the end of this addendum for the location of existing acoustical ceilings that must be removed and reinstalled to allow for the installation of new mechanical piping, fire sprinkler piping & electrical work.
- b) Per the Base Bid the Contractor shall include removing and reinstalling existing acoustical ceiling tiles and ceiling grid at select locations located north of the existing CAFETERIA to allow for the installation of new mechanical piping, fire sprinkler piping & electrical work. **NOTE:** These areas do not show up on Sheet 6.10-D.
  - i. Reference the areas shaded in gray on supplemental architectural drawing SD-2, dated 1-18-24, attached to the end of this addendum.

39) SHEET 6.20 – CEILING DETAILS

- a) Detail 8/6.20 has been revised to correctly show that the existing door leafs (only) shall be removed; the existing door frame shall remain.
  - i. Reference *revised* drawing Sheet 6.20, dated 1-18-24, attached to the end of this addendum for additional information.

40) SHEET 10.20 – THEATRE DETAILS

- a) Add the following keynote to the empty leader on the left side of detail 3/10.20:

***1/2" PLYWOOD OVER METAL DECKING***

**MECHANICAL ITEMS:**

1) SHEET 8.11 – DETAILS

- a) Add INFLOOR HEAT PIPING DETAIL as indicated per *revised* mechanical drawing Sheet 8.11, dated 1-18-24, attached to the end of this addendum.

2) SHEET 8.30-E – UNDERFLOOR PLAN – AREA E – PLUMBING

- a) Add infloor heat zone & accessories as indicated per *revised* mechanical drawing Sheet 8.30-E, dated 1-18-24, attached to the end of this addendum.

3) SHEET 8.30-F – UNDERFLOOR PLAN – AREA F – PLUMBING

- a) Add infloor heat zone & accessories as indicated per *revised* mechanical drawing Sheet 8.30-F, dated 1-18-24, attached to the end of this addendum.

4) SHEET 8.30-F-A – UNDERFLOOR PLAN – AREA F – PLUMBING ADD ALTERNATE

- a) Add infloor heat zone & accessories as indicated per *revised* mechanical drawing Sheet 8.30-F-A, dated 1-18-24, attached to the end of this addendum.

5) SHEET 8.31 -E – FIRST FLOOR PLAN – AREA E – PLUMBING & HJEATING

- a) Add infloor heat zone & accessories as indicated per *revised* mechanical drawing Sheet 8.31-E, dated 1-18-24, attached to the end of this addendum.

6) SHEET 8.31 -F – FIRST FLOOR PLAN – AREA F – PLUMBING & HJEATING

- a) Add infloor heat zone & accessories as indicated per *revised* mechanical drawing Sheet 8.31-F, dated 1-18-24, attached to the end of this addendum.

7) SHEET 8.31-F-A - 1<sup>st</sup> FLOOR PLAN - AREA F - PLUMBING & HEATING - ADD ALTERNATE

- a) Add infloor heat zone & accessories as indicated per *revised* mechanical drawing Sheet 8.31-F-A, dated 1-18-24, attached to the end of this addendum.

- 8) SHEET 8.23-D – DEMOLITION PLAN – FIRST FLOOR – AREA B,C & D – VENILATION & A/C
- a) Change Note 3 to read “***ABANDON EXISTING IN-LINE EXHAUST FAN IN PLACE. CAP DUCT ON INLET SIDE OF FAN.***” Disregard reference to discharge side of fan.
- 9) SHEET 8.40-E – FIRST FLOOR PLAN – AREA E – VENTILATION & A/C
- a) Add in-floor heat control to thermostat for E103 Fitness Room.
- 10) SHEET 8.40-F – FIRST FLOOR PLAN – AREA F – VENTILATION & A/C – BASE BID
- a) The thermostat for Vestibule F100 shall serve CUH-F100A, CUH-F100B and the in-floor heat.
- 11) SHEET 8.40-F-A – FIRST FLOOR PLAN – AREA F – VENTILATION & A/C – ADD ALTERNATE
- a) The thermostat for Vestibule F100 shall serve CUH-F100A, CUH-F100B and the in-floor heat.
- 12) SHEET 8.40-G – FIRST FLOOR PLAN – AREA G – VENILATION & A/C
- a) Extend O/A ducts for BCU-G111 and BCU-G117 to IH-G119. Reference *revised* mechanical drawing Sheet 8.40-G, dated 1-18-24, attached to the end of this addendum.
- 13) SHEET 8.50 – SCHEDULES
- a) Reference *revised* mechanical drawing Sheet 8.50, dated 1-18-24, attached to the end of this addendum for the following:
- i. ENERGY RECOVERY VENILATOR SCHEDULE:
1. Change Supply Air fan MCA to 23.8.
  2. Change MOCP to 30.9.
  3. Change Exhaust Air fan MCA to 16.8.
  4. Change MOCP to 21.8.
- b) In reference to the FAN SCHEDULE, update fan EF-G207. Reference *revised* mechanical drawing Sheet 8.50, dated 1-18-24, attached to the end of this addendum
- c) In reference to the PUMP SCHEDULE : Add infloor heat pump P-4. See revised drawing sheet dated 1/18/2024.

#### **ELECTRICAL ITEMS:**

- 1) SHEET 9.10 and 9.11 ELECTRICAL SITE DEMOLITION AND SITE PLAN
- a) Remove and relocate 2 additional site parking lot poles as shown on attached sheet 9.10. Relocate to location as shown on attached sheet 9.11.
- b) One existing parking lot pole shown on sheet 9.10 noted to be removed shall be salvaged to the owner.

- 2) SHEET 9.40-E – FIRST FLOOR PLAN – AREA D – LIGHTING
  - a) Reference *revised* electrical drawing Sheet 9.40-E, dated 1-18-24, attached to the end of this addendum for miscellaneous electrical modifications.
- 3) SHEET 9.42-E – FIRST FLOOR PLAN – AREA E – LIGHTING
  - a) Reference *revised* electrical drawing Sheet 9.42-E, dated 1-18-24, attached to the end of this addendum for miscellaneous electrical modifications.
- 4) SHEET 9.44-F– FIRST FLOOR PLAN – AREA F – LIGHTING
  - a) Reference *revised* electrical drawing Sheet 9.44-F, dated 1-18-24, attached to the end of this addendum for miscellaneous electrical modifications.
- 5) SHEET 9.44-F-A – FIRST FLOOR PLAN – AREA F – LIGHTING – ADD ALTERNATE
  - a) Reference *revised* electrical drawing Sheet 9.44-F-A, dated 1-18-24, attached to the end of this addendum for miscellaneous electrical modifications.
- 6) SHEET 9.45-F – FIRST FLOOR PLAN – AREA F – POWER & SIGNAL
  - a) Reference *revised* electrical drawing Sheet 9.45-F, dated 1-18-24, attached to the end of this addendum for miscellaneous electrical modifications.
- 7) SHEET 9.45-F-A – FIRST FLOOR PLAN – AREA F – POWER & SIGNAL – ADD ALTERNATE
  - a) Reference *revised* electrical drawing Sheet 9.45-F-A, dated 1-18-24, attached to the end of this addendum for miscellaneous electrical modifications.
- 8) SHEET 9.46-G – FIRST FLOOR PLAN – AREA G – LIGHTING
  - a) Reference *revised* electrical drawing Sheet 9.46-G, dated 1-18-24, attached to the end of this addendum for miscellaneous electrical modifications.
- 9) SHEET 9.47-G – FIRST FLOOR PLAN – AREA F – POWER & SIGNAL
  - a) Reference *revised* electrical drawing Sheet 9.47-G, dated 1-18-24, attached to the end of this addendum for miscellaneous electrical modifications.
- 10) SHEET 9.48-F – MEZZANINE PLAN – AREA F – LIGHTING
  - a) Reference *revised* electrical drawing Sheet 9.48-F, dated 1-18-24, attached to the end of this addendum for miscellaneous electrical modifications.
- 11) SHEET 9.48-F-A – MEZZANINE PLAN – AREA F – LIGHTING ADD ALTERNATE
  - a) Reference *revised* electrical drawing Sheet 9.48-F-A, dated 1-18-24, attached to the end of this addendum for miscellaneous electrical modifications.
- 12) SHEET 9.49-F – MEZZANINE PLAN – AREA F – POWER & SIGNAL
  - a) Reference *revised* electrical drawing Sheet 9.49-F, dated 1-18-24, attached to the end of this addendum for miscellaneous electrical modifications.

- 13) SHEET 9.49-F-A – MEZZANINE PLAN – AREA F – POWER & SIGNAL – ADD ALTERNATE
  - a) Reference *revised* electrical drawing Sheet 9.49-F-A, dated 1-18-24, attached to the end of this addendum for miscellaneous electrical modifications.
- 14) SHEET 9.50-G – MEZZANINE PLAN – AREA G – ELECTRICAL
  - a) Reference *revised* electrical drawing Sheet 9.50-G, dated 1-18-24, attached to the end of this addendum for miscellaneous electrical modifications.
- 15) SHEET 9.51-G – CATWALK PLAN – AREA G - ELECTRICAL
  - a) Reference *revised* electrical drawing Sheet 9.51-G, dated 1-18-24, attached to the end of this addendum for miscellaneous electrical modifications.
- 16) SHEET 9.60 – ELECTRICAL SYMBOLS & ABBREVIATIONS
  - a) Reference *revised* electrical drawing Sheet 9.60, dated 1-18-24, attached to the end of this addendum for miscellaneous electrical modifications.
- 17) SHEET 9.61 – ELECTRICAL SCHEDULES
  - a) Reference *revised* electrical drawing Sheet 9.61, dated 1-18-24, attached to the end of this addendum for miscellaneous electrical modifications.
- 18) SHEET 9.62 – ELECTRICAL SCHEDULES
  - a) Reference *revised* electrical drawing Sheet 9.62, dated 1-18-24, attached to the end of this addendum for miscellaneous electrical modifications.

GENERAL APPROVALS:

The following material or equipment furnished by the manufacturers listed, may be substituted as equivalent providing that each item, material, and piece of equipment conforms to the design and requirement of the specifications.


<u>SECTION</u>	<u>ITEM</u>	<u>MANUFACTURER</u>
116133	Stage Curtains and Tracks	Gopher Stage Lighting TMS, Theatrical Media Services
323113	Tennis Posts Tennis Net Straps & Anchors	Douglas Sports; <i>Premier XS</i> Douglas Sports; <i>TN-36 Net</i> Douglas Sports
220400	Water Heaters	AO Smith, State Industries
220400	Flush Valves	American Standard
220400	Circulating Pumps	Grundfos
220400	Submersible Pumps	Zoeller
220600	Gas Vent Systems	Z-Vent

220600	Automatic Flow Control Valves	Hydronic Components
220600	Ice Storage	PhaseStor/IceStor
220600	Radiant Panels	Sterling, AeroTech
230800	Exhaust/Relief Air Hood	ACME
230800	Duct Free Split System	Samsung
230800	Energy Recovery Ventilator	Haakon, Scott Springfield
265110/265210	Interior and Exterior Lighting	
	Type A Series	Elite, Lithonia
	Type C Series	Lithonia
	Type D Series	Metalux, Columbia
	Type E, EB, E1, E2, E2B, E3, E4, E5	Emergi-Lite, Lithonia
	Type E6	Lithonia
	Type G	Spectrum
	Type H Series	Elite, Portfolio, Prescolite
	Type L	Gardco, Beacon
	Type M Series	Lithonia
	Type N	NVF, Kelvix, Accliam, Acolyte, LLI
	Type P Series	Portfolio, HE Williams Arch Light Works
	Type R	Aluz, Cole
	Type S, SE	Halo, Prescolite, Elite
	Type T, TW, T1, T1W, T2	Lithonia, Portfolio, HE Williams, Arch Light Works
	Type TA, TB1	Lithonia, Lumux
	Type V, VE	Lithonia
	Type Y Series	Gardco, Spitzer, McGraw-Edison
	TYPE Z Series	AEL, Fail-Safe, PACO


**NOTE:** The TS lights that were listed as an equal previously are not equal to the specified lights; NOT APPROVED.

END OF ADDENDUM No. 2



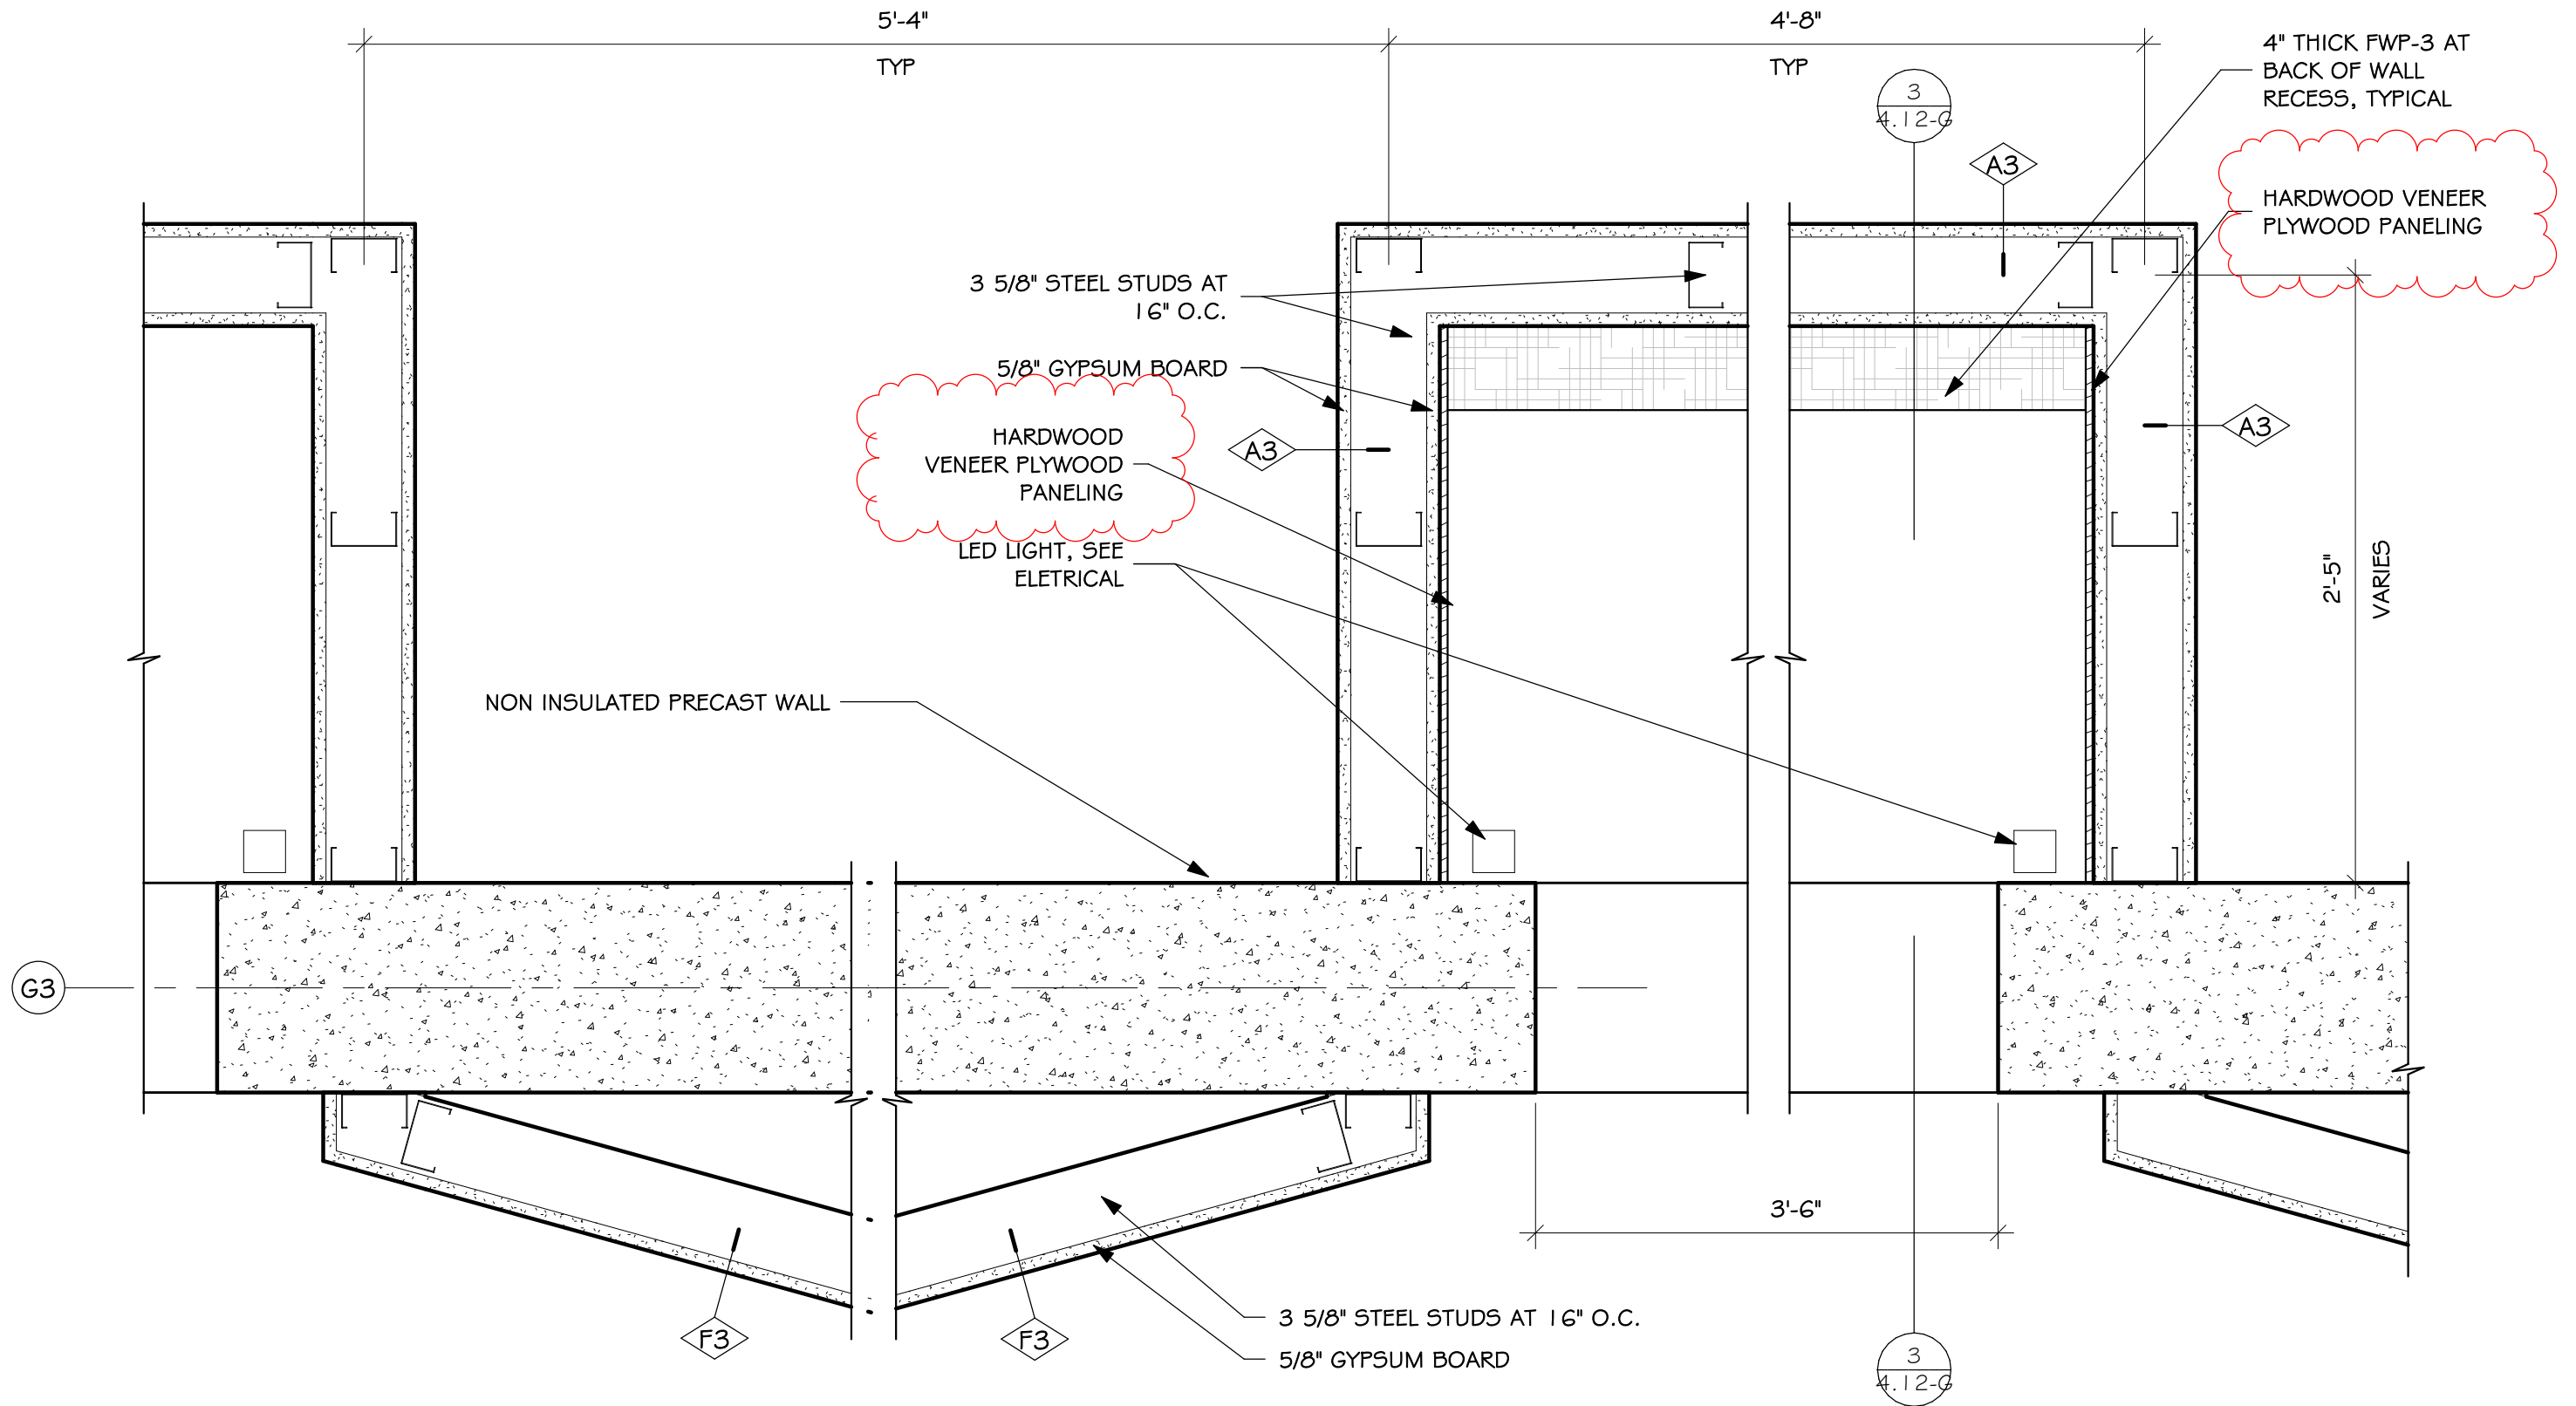

1
SD-3
**SOUND CHAMBER PLAN DETAIL - TYPICAL**  
 SCALE: 1 1/2" = 1'-0"

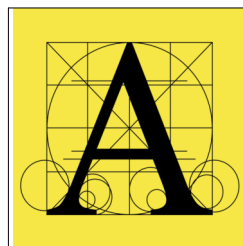

project LENNOX HIGH SCHOOL ADDITION

number 0215.2982.22

date 1/19/2024

drawn BJO checked SRJ

revision ADDENDUM #2

**Architecture Incorporated**

sioux falls and rapid city, south dakota

DRAWING

**SD-3**

## SECTION 101419 - DIMENSIONAL LETTER SIGNAGE

## PART 1 - GENERAL

## 1.1 RELATED DOCUMENTS

- A. Drawings and general provisions of the Contract, including General and Supplementary Conditions and Division 01 Specification Sections, apply to this Section.

## 1.2 SUMMARY

- A. Section Includes:
  - 1. Furnishing and installing cast aluminum dimensional characters.

## 1.3 ACTION SUBMITTALS

- A. Product Data: For each type of product.
- B. Shop Drawings: For dimensional letter signs.
  - 1. Include fabrication and installation details and attachments to other work.
  - 2. Show sign mounting heights, locations of supplementary supports to be provided by others, and accessories.
  - 3. Show message list, typestyles, graphic elements, and layout for each sign at least half size.
- C. Samples for Initial Selection: For each type of sign assembly, exposed component, and exposed finish.
  - 1. Include representative Samples of available typestyles and graphic symbols.

## 1.4 CLOSEOUT SUBMITTALS

- A. Maintenance Data: For signs to include in maintenance manuals.
- B. Warranty: for special warranty.

## 1.5 QUALITY ASSURANCE

- A. Installer Qualifications: Manufacturer of products or an entity that employs installers and supervisors who are trained and approved by manufacturer.

## 1.6 WARRANTY

- A. Special Warranty: Manufacturer agrees to repair or replace components of signs that fail in materials or workmanship within specified warranty period.
  - 1. Failures include, but are not limited to, the following:
    - a. Deterioration of finishes beyond normal weathering.
    - b. Separation or delamination of sheet materials and components.

2. Warranty Period: **[Five]** years from date of Substantial Completion.

## PART 2 - PRODUCTS

### 2.1 CAST DIMENSIONAL CHARACTERS

- A. Cast Characters : Characters with uniform faces, sharp corners, and precisely formed lines and profiles, and as follows:
  1. Manufacturers: Subject to compliance with requirements, **[available manufacturers offering products that may be incorporated into the Work include, but are not limited to, the following]**:
    - a. ACE Sign Systems, Inc.
    - b. APCO Graphics, Inc.
    - c. A.R.K. Ramos.
    - d. ASI Sign Systems, Inc.
    - e. Gemini Incorporated.
    - f. Metal Arts; Division of L & H Mfg. Co.
    - g. Metallic Arts.
    - h. Seton Identification Products.
  2. Character Material: Cast **[aluminum]**.
  3. Character Height: **[16 inches]**.
  4. Thickness **[Manufacturer's standard for size of characters indicated]**
  5. Finishes:
    - a. Integral Aluminum Finish: **[Color anodized]**.
    - b. Overcoat: **[Manufacturer's standard baked-on clear coating]**.
  6. Mounting: **[Concealed studs]**.
  7. Font: **[Arial]**, unless specifically indicated otherwise.
  8. Text: Provide **[16 inch]** high projected aluminum letters **[w/ color anodized finish]** on the face of the canopy that exists over doors F100-1 thru F100-5; reference exterior elevations A/5.10 & A/5.11.
    - a. Text: **ACTIVITIES ENTRANCE**
    - b. Color: **[BLACK]**.

### 2.2 DIMENSIONAL CHARACTER MATERIALS

- A. Aluminum Castings: ASTM B 26/B 26M, alloy and temper recommended by sign manufacturer for casting process used and for type of use and finish indicated.
- B. Paints and Coatings for Sheet Materials: Inks, dyes, and paints that are recommended by manufacturer for optimum adherence to surface and are UV and water resistant for colors and exposure indicated.

## 2.3 ACCESSORIES

- A. Fasteners and Anchors: Manufacturer's standard as required for secure anchorage of signage, noncorrosive and compatible with each material joined, and complying with the following:
1. Sign Mounting Fasteners:
    - a. Concealed Studs: Concealed (blind), threaded studs welded or brazed to back of sign material, screwed into back of sign assembly, or screwed into tapped lugs cast integrally into back of cast sign material, unless otherwise indicated.
    - b. Concealed Projecting Studs: Threaded studs with sleeve spacer, welded or brazed to back of sign material, screwed into back of sign assembly, or screwed into tapped lugs cast integrally into back of cast sign material, unless otherwise indicated.
  2. Provide concealed-fastener-type anchorage system at all exterior cast dimensional letters.
    - a. Letters which are to be mounted with projected studs will be determined by Architect during submittal review.
    - b. Projection distance from face of wall (where applicable) will be determined by Architect during submittal review.

## 2.4 FABRICATION

- A. General: Provide manufacturer's standard sign assemblies according to requirements indicated.
1. Preassemble signs and assemblies in the shop to greatest extent possible. Disassemble signs and assemblies only as necessary for shipping and handling limitations. Clearly mark units for reassembly and installation; apply markings in locations concealed from view after final assembly.
  2. Mill joints to a tight, hairline fit. Form assemblies and joints exposed to weather to resist water penetration and retention.
  3. Comply with AWS for recommended practices in welding and brazing. Provide welds and brazes behind finished surfaces without distorting or discoloring exposed side. Clean exposed welded and brazed connections of flux, and dress exposed and contact surfaces.
  4. Conceal connections if possible; otherwise, locate connections where they are inconspicuous.
  5. Internally brace signs for stability and for securing fasteners.
  6. Provide rebates, lugs, and brackets necessary to assemble components and to attach to existing work. Drill and tap for required fasteners. Use concealed fasteners where possible; use exposed fasteners that match sign finish.
  7. Castings: Fabricate castings free of warp, cracks, blowholes, pits, scale, sand holes, and other defects that impair appearance or strength. Grind, wire brush, sandblast, and buff castings to remove seams, gate marks, casting flash, and other casting marks before finishing.

## 2.5 GENERAL FINISH REQUIREMENTS

- A. Protect mechanical finishes on exposed surfaces from damage by applying a strippable, temporary protective covering before shipping.
- B. Appearance of Finished Work: Noticeable variations in same piece are not acceptable. Variations in appearance of adjoining components are acceptable if they are within the range of approved Samples and are assembled or installed to minimize contrast.

- C. Color Anodic Finish: AAMA 611, [**Class I, 0.018 mm**] or thicker.
- D. Organic, Anodic, and Chemically Produced Finishes: Apply to formed metal after fabrication but before applying contrasting polished finishes on raised features unless otherwise indicated.

## PART 3 - EXECUTION

### 3.1 EXAMINATION

- A. Examine substrates, areas, and conditions, with Installer present, for compliance with requirements for installation tolerances and other conditions affecting performance of signage work.
- B. Verify that sign-support surfaces are within tolerances to accommodate signs without gaps or irregularities between backs of signs and support surfaces unless otherwise indicated.
- C. Proceed with installation only after unsatisfactory conditions have been corrected.

### 3.2 INSTALLATION

- A. General: Install signs using mounting methods indicated and according to manufacturer's written instructions.
  - 1. Install signs level, plumb, true to line, and at locations and heights indicated, with sign surfaces free of distortion and other defects in appearance.
  - 2. Before installation, verify that sign surfaces are clean and free of materials or debris that would impair installation.
  - 3. Corrosion Protection: Coat concealed surfaces of exterior aluminum in contact with grout, concrete, masonry, wood, or dissimilar metals, with a heavy coat of bituminous paint.
- B. Mounting Methods:
  - 1. Concealed Studs: Using a template, drill holes in substrate aligning with studs on back of sign. Remove loose debris from hole and substrate surface.
    - a. Masonry Substrates: Fill holes with adhesive. Leave recess space in hole for displaced adhesive. Place sign in position and push until flush to surface, embedding studs in holes. Temporarily support sign in position until adhesive fully sets.
    - b. Thin or Hollow Surfaces: Place sign in position and flush to surface, install washers and nuts on studs projecting through opposite side of surface, and tighten.
  - 2. Projecting Studs: Using a template, drill holes in substrate aligning with studs on back of sign. Remove loose debris from hole and substrate surface.
    - a. Masonry Substrates: Fill holes with adhesive. Leave recess space in hole for displaced adhesive. Place spacers on studs, place sign in position, and push until spacers are pinched between sign and substrate, embedding the stud ends in holes. Temporarily support sign in position until adhesive fully sets.
    - b. Thin or Hollow Surfaces: Place spacers on studs, place sign in position with spacers pinched between sign and substrate, and install washers and nuts on stud ends projecting through opposite side of surface, and tighten.


3. Back Bar and Brackets: Remove loose debris from substrate surface and install backbar or bracket supports in position so that signage is correctly located and aligned.

### 3.3 ADJUSTING AND CLEANING

- A. Remove and replace damaged or deformed characters and signs that do not comply with specified requirements. Replace characters with damaged or deteriorated finishes or components that cannot be successfully repaired by finish touchup or similar minor repair procedures.
- B. Remove temporary protective coverings and strippable films as signs are installed.
- C. On completion of installation, clean exposed surfaces of signs according to manufacturer's written instructions, and touch up minor nicks and abrasions in finish. Maintain signs in a clean condition during construction and protect from damage until acceptance by Owner.

END OF SECTION 101419



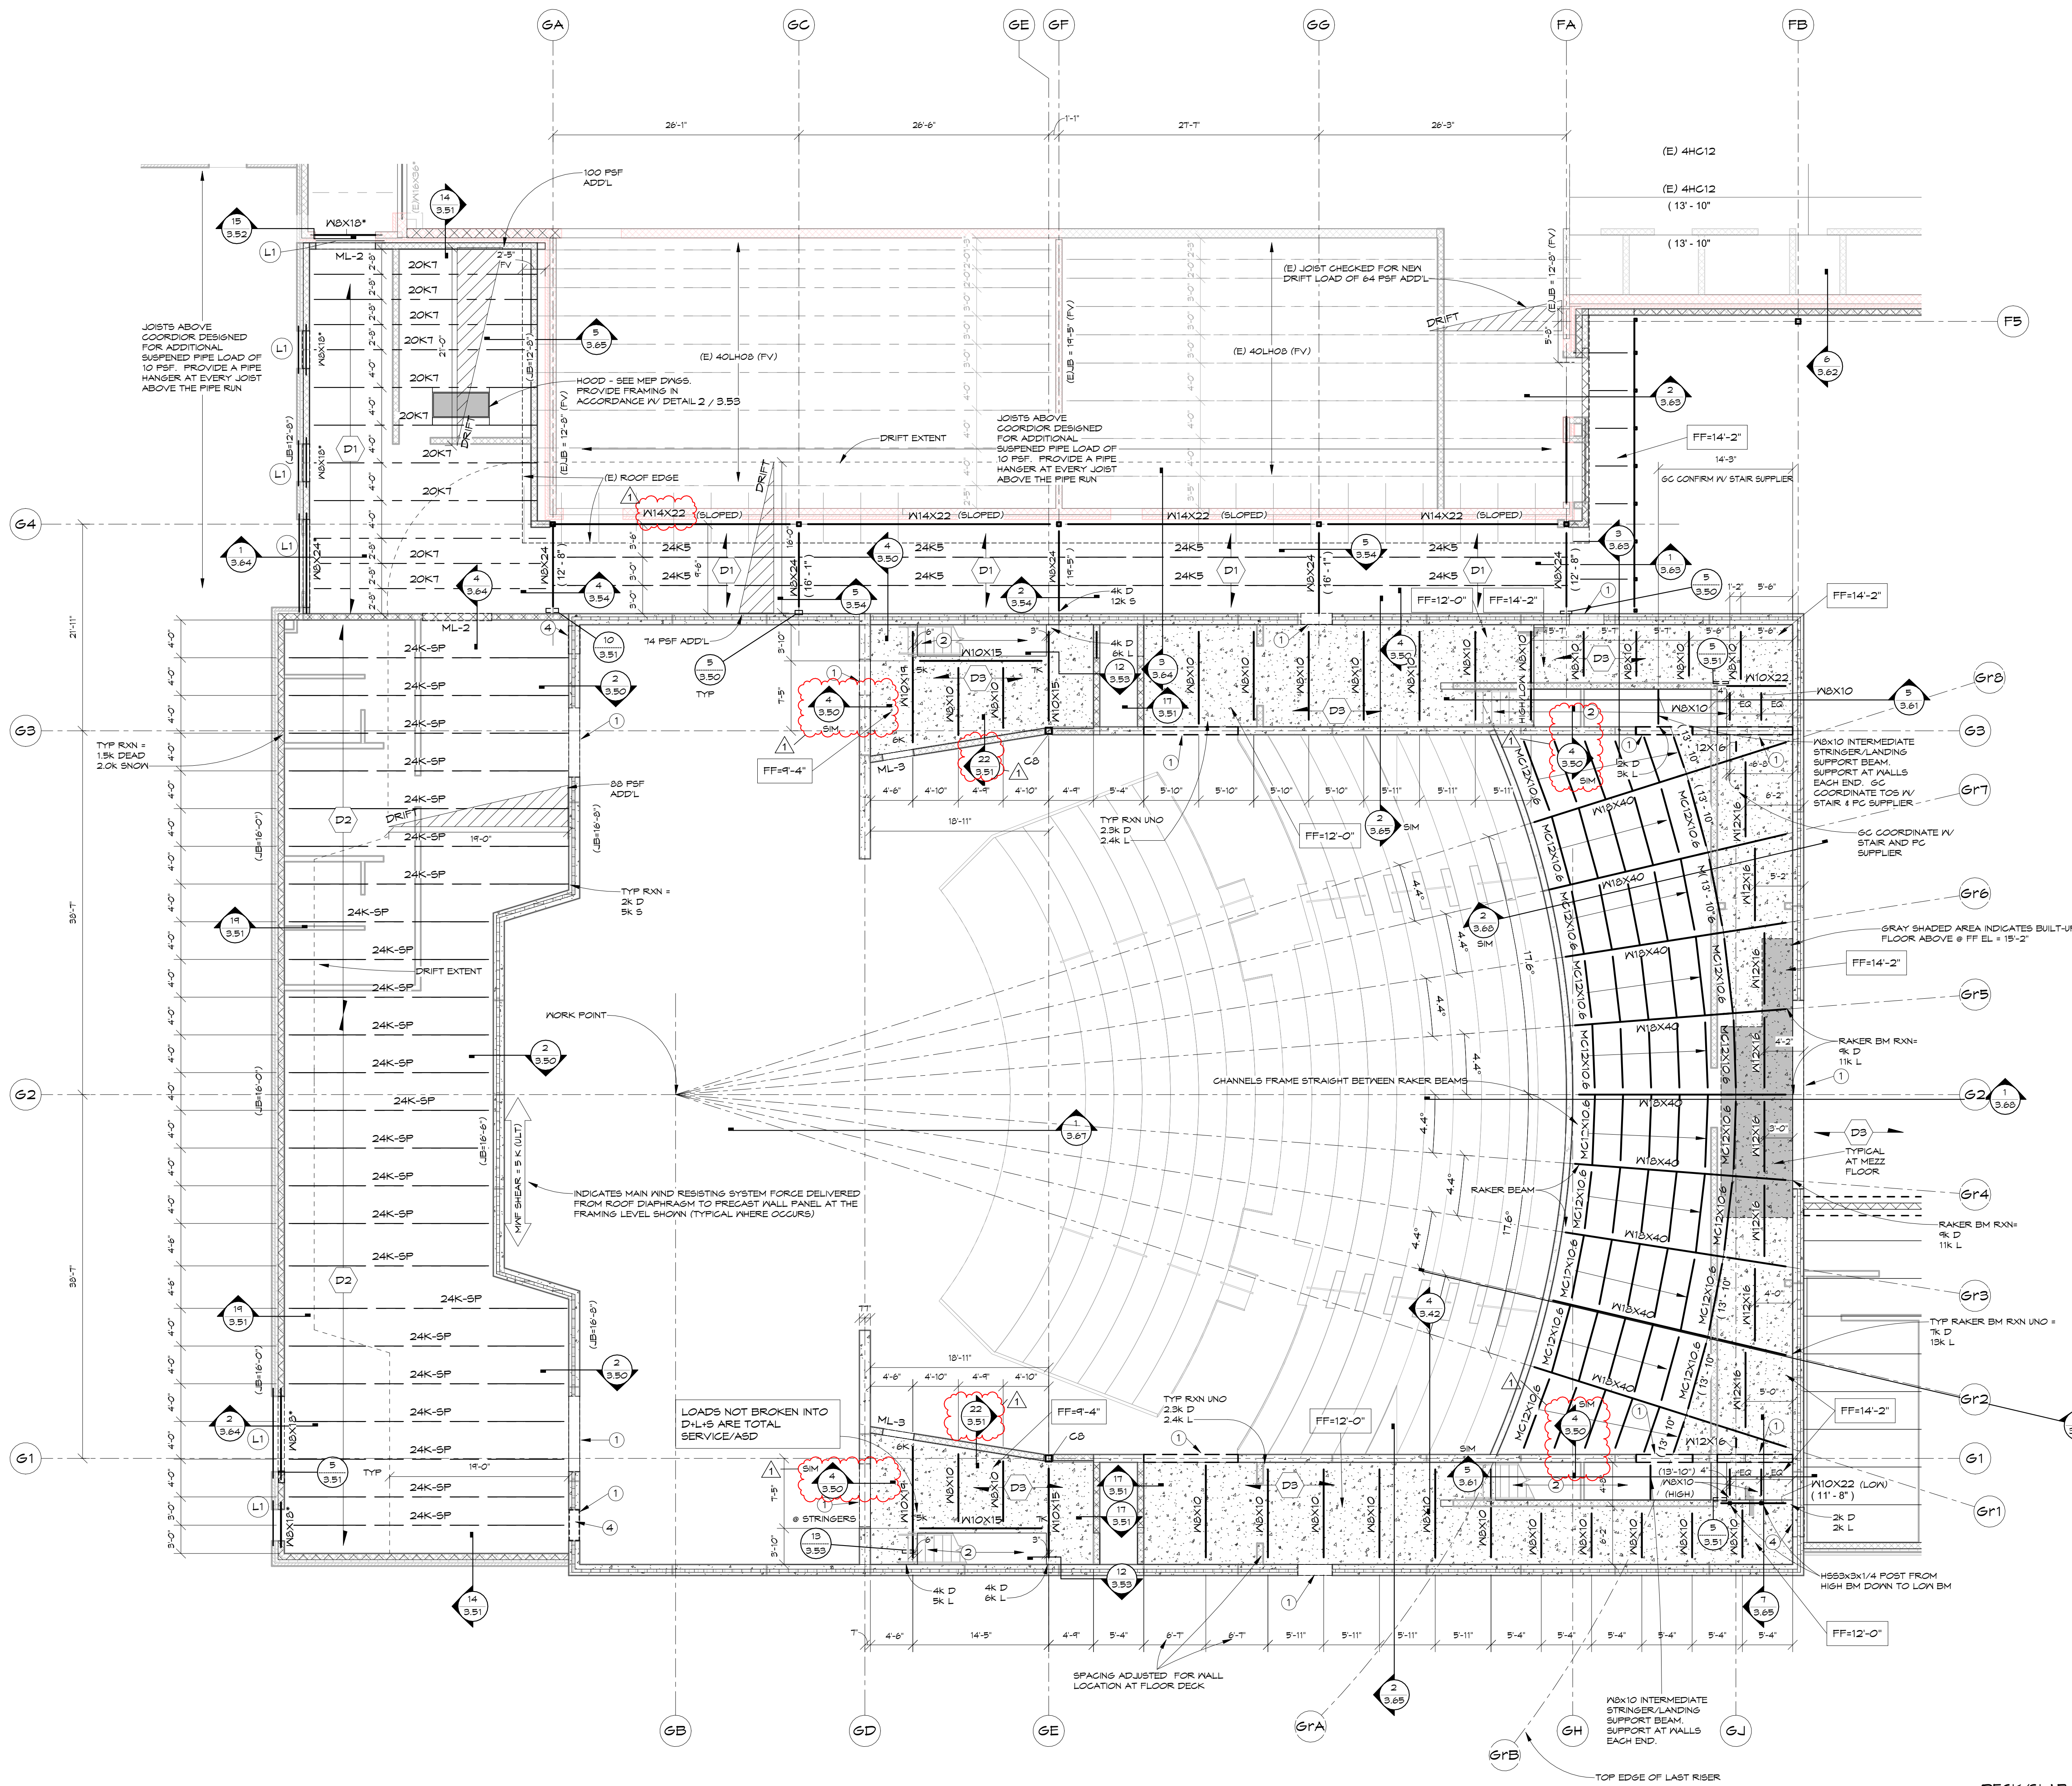


MEZZANINE FLOOR & LOW ROOF FRAMING - AREA G  
1/8" = 1'-0"

- FRAMING PLAN NOTES**
- CONCRETE HEADER INTEGRATED INTO PRECAST WALL. DESIGNED AND PROVIDED BY PRECAST SUPPLIER.
  - STAIR ASSEMBLY FRAMING DESIGNED AND PROVIDED BY THE STAIR SUPPLIER. SUBMIT SHOP DRAWINGS AND CALCULATIONS SEALED BY A S.E. FOR REVIEW BY THE A.C.R. & SEOR PRIOR TO FABRICATION.
  - GROUT ALL CELLS FULL HEIGHT. PROVIDE (1) #5 VERT. BAR CONTINUOUS FULL HEIGHT IN CORNER CELLS (4 TOTAL). PROVIDE #5 TIE BARS @ 8" OC.
  - MECHANICAL OPENING IN PG WALL/ HOLLOWCORE FLOOR DESIGNED BY PG SUPPLIER. GC/PG SUPPLIER COORDINATE OPENING SIZE AND LOCATION W/ MEP DWGS.
  - '(DUCT)' INDICATES BEAM PROVIDED FOR HVAC OPENING. GC COORDINATE EXACT SPAN LENGTH AND LOCATION W/ HVAC AND STEEL SUPPLIER. PROVIDE OTHER BEAMS FOR OPENINGS NOT SHOWN IN ACCORDANCE WITH THE 'MASONRY VENEER SCHEDULE' ON SHEET 3.10.

**DECK/SLAB SCHEDULE**

D1	METAL ROOF DECK: 1 1/2" x 22ga WIDE RIBBED (TYPE B). FASTEN TO SUPPORTS WITH 5/8" PUDDLE WELDS AT 36/4 FASTENER LAYOUT AND FASTEN SIDE LAPS WITH (8) #10 TEK SCREWS PER SPAN.
D2	METAL ROOF DECK: 1 1/2" x 22ga WIDE RIBBED (TYPE B). FASTEN TO SUPPORTS WITH 5/8" PUDDLE WELDS AT 36/5 FASTENER LAYOUT AND FASTEN SIDE LAPS WITH (7) #10 TEK SCREWS PER SPAN.
D3	METAL FLOOR DECK: 2 1/2" NORMAL HEIGHT CONCRETE OVER 1 1/2" x 22ga GALVANIZED COMPOSITE FLOOR DECK (4" TOTAL THICKNESS). METAL FLOOR DECK = VULCRAFT 15/L OR EQUAL. PROVIDE STRUX 90/40 (OR APPROVED EQUAL) MACRO FIBER MESH AT A DOSAGE RATE OF 44/CUBIC YARD.
D4	1 1/2" x 22ga WIDE RIBBED (TYPE B) W/ 1/2" PLYWOOD DECKING. FASTEN TO SUPPORTS W/ #12 TEK SCREWS OF PAFS @ 36/4 FASTENER LAYOUT. PROVIDE (3) #10 SCREW SIDE LAP FASTENERS PER SPAN.
HC1	8" THICK x 4'-0" WIDE PRECAST CONCRETE HOLLOW-CORE PLANKS WITH 2" COMPOSITE TOPPING. PROVIDE POLY FIBER MESH IN TOPPING. DESIGN LOADS: LIVE LOAD = 125PSF. DEAD LOAD = SELF WEIGHT + TOPPING = 15PSF MSC.

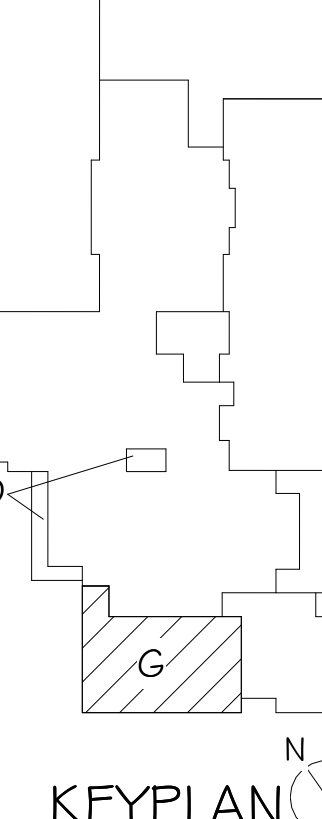

- FRAMING GENERAL NOTES**
- METAL ROOF DECK IS NOTED ON THE PLANS AND SHOULD BE IN ACCORDANCE WITH 1 / 3.53.
  - PROVIDE 4x4x1/4 ANGLE FRAMING AT ALL OPENINGS 12" OR LARGER IN METAL ROOF. THE GENERAL CONTRACTOR SHALL COORDINATE ROOF PENETRATIONS AND SIZES. FRAME OPENINGS IN ACCORDANCE WITH 2 / 3.55.
  - JOIST BRIDGES AND CONNECTIONS SHALL BE DESIGNED BY THE JOIST MANUFACTURER. ALL JOISTS BRIDGING SHALL BE DESIGNED FOR 20 PSF NET WIND UPLIFT UNLESS NOTED OTHERWISE ON THE PLANS. WHERE DUCTWORK MUST INTERRUPT BRIDGING REFER TO DETAIL 3 / 3.53.
  - ELEVATIONS AND DIMENSIONS SHOWN ON THE PLANS MUST BE COORDINATED WITH THE ARCHITECTURAL DRAWINGS. IT IS THE RESPONSIBILITY OF THE CONTRACTORS PERFORMING THE APPLICABLE WORK TO ADVISE THE A.C.R. AND SEOR OF DIMENSION OR ELEVATION DISCREPANCIES BETWEEN ARCHITECTURAL AND STRUCTURAL DRAWINGS PRIOR TO CONSTRUCTION. ARCHITECTURAL DRAWINGS GENERALLY GOVERN ELEVATIONS AND DIMENSIONS OF WALLS, BEAMS, AND LINTELS. ELEVATIONS SHOWN ON THE STRUCTURAL PLANS ARE INTENDED TO BENEFIT THE CONSTRUCTION PROCESS AND SIGNIFICANT EFFORT HAS BEEN MADE TO COORDINATE ELEVATIONS AND DIMENSIONS WITH THE ARCHITECTURAL DRAWINGS BUT PROVIDING THIS INFORMATION DOES NOT RELIEVE THE CONTRACTOR FROM CHECKING DIMENSIONS OR ELEVATIONS AGAINST ALL PLANS, SCHEDULES, AND DETAILS.
  - DETAILS LABELED AS 'TYP' SHOULD BE APPLIED AS TYPICAL CONSTRUCTION DETAIL UNO.
  - SEE ARCHITECTURAL PLANS FOR WALL HEIGHTS AND LOCATIONS. TYPICAL NON-LOAD BEARING PARTITION WALLS SHALL BE BRACED ACCORDING TO DETAILS 8 / 3.54, 9 / 3.54, 12 / 3.51, 12 / 3.51.
  - STEEL JOISTS LABELED AS 'SP' ARE JOIST WITH SPECIAL LOADING CRITERIA TO BE DESIGNED BY THE STEEL JOIST SUPPLIER. SEE PLANS AND LOADING DIAGRAMS.
  - STEEL JOISTS WITH POINT LOADS SHALL BE REINFORCED IN ACCORDANCE WITH DETAIL 4 / 3.53.
  - PROVIDE 3x3x1/4 CONTINUOUS ANGLE AROUND ALL DECK PERIMETERS UNLESS INDICATED OTHERWISE ON DETAILS.
  - 1" NEXT TO BEAM INDICATES BEAM HAS A 1" CONTINUOUS BOTTOM PLATE. DEPTH OF BOTTOM PLATE IS NOMINAL WIDTH OF MASONRY VENEER. PROVIDE ADDITIONAL PLATE WIDTH AS NEEDED TO SUPPORT VENEER WHERE NEEDED. SEE ARCH DWGS.
- MASONRY WALL GENERAL NOTES**
- PROVIDE THE FOLLOWING MINIMUM CMU WALL REINFORCEMENT UNO. ON THE PLANS AND DETAILS. LOCATE VERTICAL BARS PER DETAIL 2 / 3.51.
  - 6" OR 8" INTERIOR NON-JOIST OR DECK BEARING WALLS: (1) #5 VERTICAL @ 4'-0" OC.
  - 8" INTERIOR JOIST OR DECK BEARING WALLS: (1) #4 VERTICAL @ 4'-0" OC.
  - 8" EXTERIOR WALLS: (1) #5 VERTICAL @ 4'-0" OC.
  - 8" x 8" CMU WALL BOND BEAMS SHALL HAVE (2) #4 CONTINUOUS.
  - PROVIDE (2) CORNER BARS TO MATCH BOND BEAM REINFORCING @ ALL CORNERS.
  - PROVIDE CONTINUOUS BOND BEAMS AT TOP OF WALL. JOIST AND DECK BEARING, AND 8'-0" OC.
  - PROVIDE BOND BEAMS BELOW WINDOWS, EXTEND 24" EACH SIDE BEYOND OPENINGS.
  - REFER TO ARCHITECTURAL DRAWINGS FOR MASONRY CONTROL JOINT LOCATIONS. TYPICAL CONTROL JOINT CONSTRUCTION SHALL BE IN ACCORDANCE WITH DETAIL 1 / 3.51.
  - CONSTRUCT INTERIOR CMU WALL INTERSECTIONS PER DETAIL 3 / 3.51.
  - CONSTRUCT MASONRY FOR STEEL BEAM BEARING PER DETAIL 5 / 3.51.
  - PROVIDE TYPICAL STEEL BEAM LINTEL CONSTRUCTION PER DETAIL 4 / 3.51.

**MASONRY CMU LINTEL SCHEDULE-SEE DETAIL 9 / 3.51**

MARK	WIDTH	DEPTH	REINFORCING
ML-1	8"	8"	(2) #4 BOTTOM
ML-2	8"	16"	(2) #4 BOTTOM
ML-3	8"	24"	(2) #4 TOP & BOTTOM

**EXTERIOR MASONRY VENEER LINTELS**


MARK	DESCRIPTION	BRG LENGTH
(L1)	16x4x5/16 (LLH)	6"

**COLUMN SCHEDULE**

MARK	TYPE
C4	HSS4x4x1/4
C5	HSS5x5x1/4
C6a	HSS5x5x5/16
C6	HSS6x6x1/4
C8	HSS8x8x1/4

**Architecture Incorporated**  
415 South Main Avenue  
P.O. Box 2140  
Sioux Falls, South Dakota 57101  
Phone: (605) 339-1711

815 St Joseph Street, Suite 203  
P.O. Box 8047  
Rapid City, South Dakota 57701  
Phone: (605) 721-1158

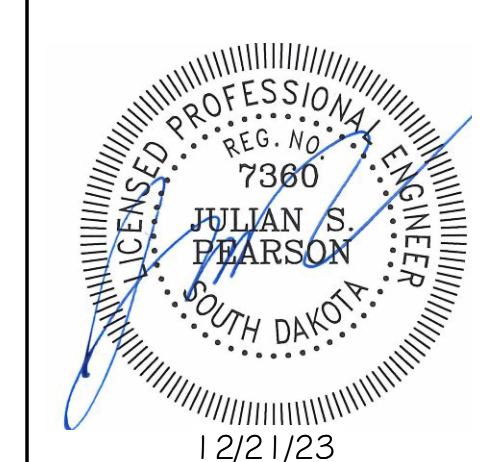


**LENNOX HIGH SCHOOL ADDITION**  
**MEZZANINE FLOOR & LOW ROOF FRAMING - AREA G**

Project: 0215.2982.22  
date: 1/22/2023  
revision: \_\_\_\_\_  
drawn: TNP/J checked: JJP  
NO. DATE DESCRIPTION  
1 1/18/24 ADDENDUM #2


**3.21-G**




1/18/2024 11:00:52 AM

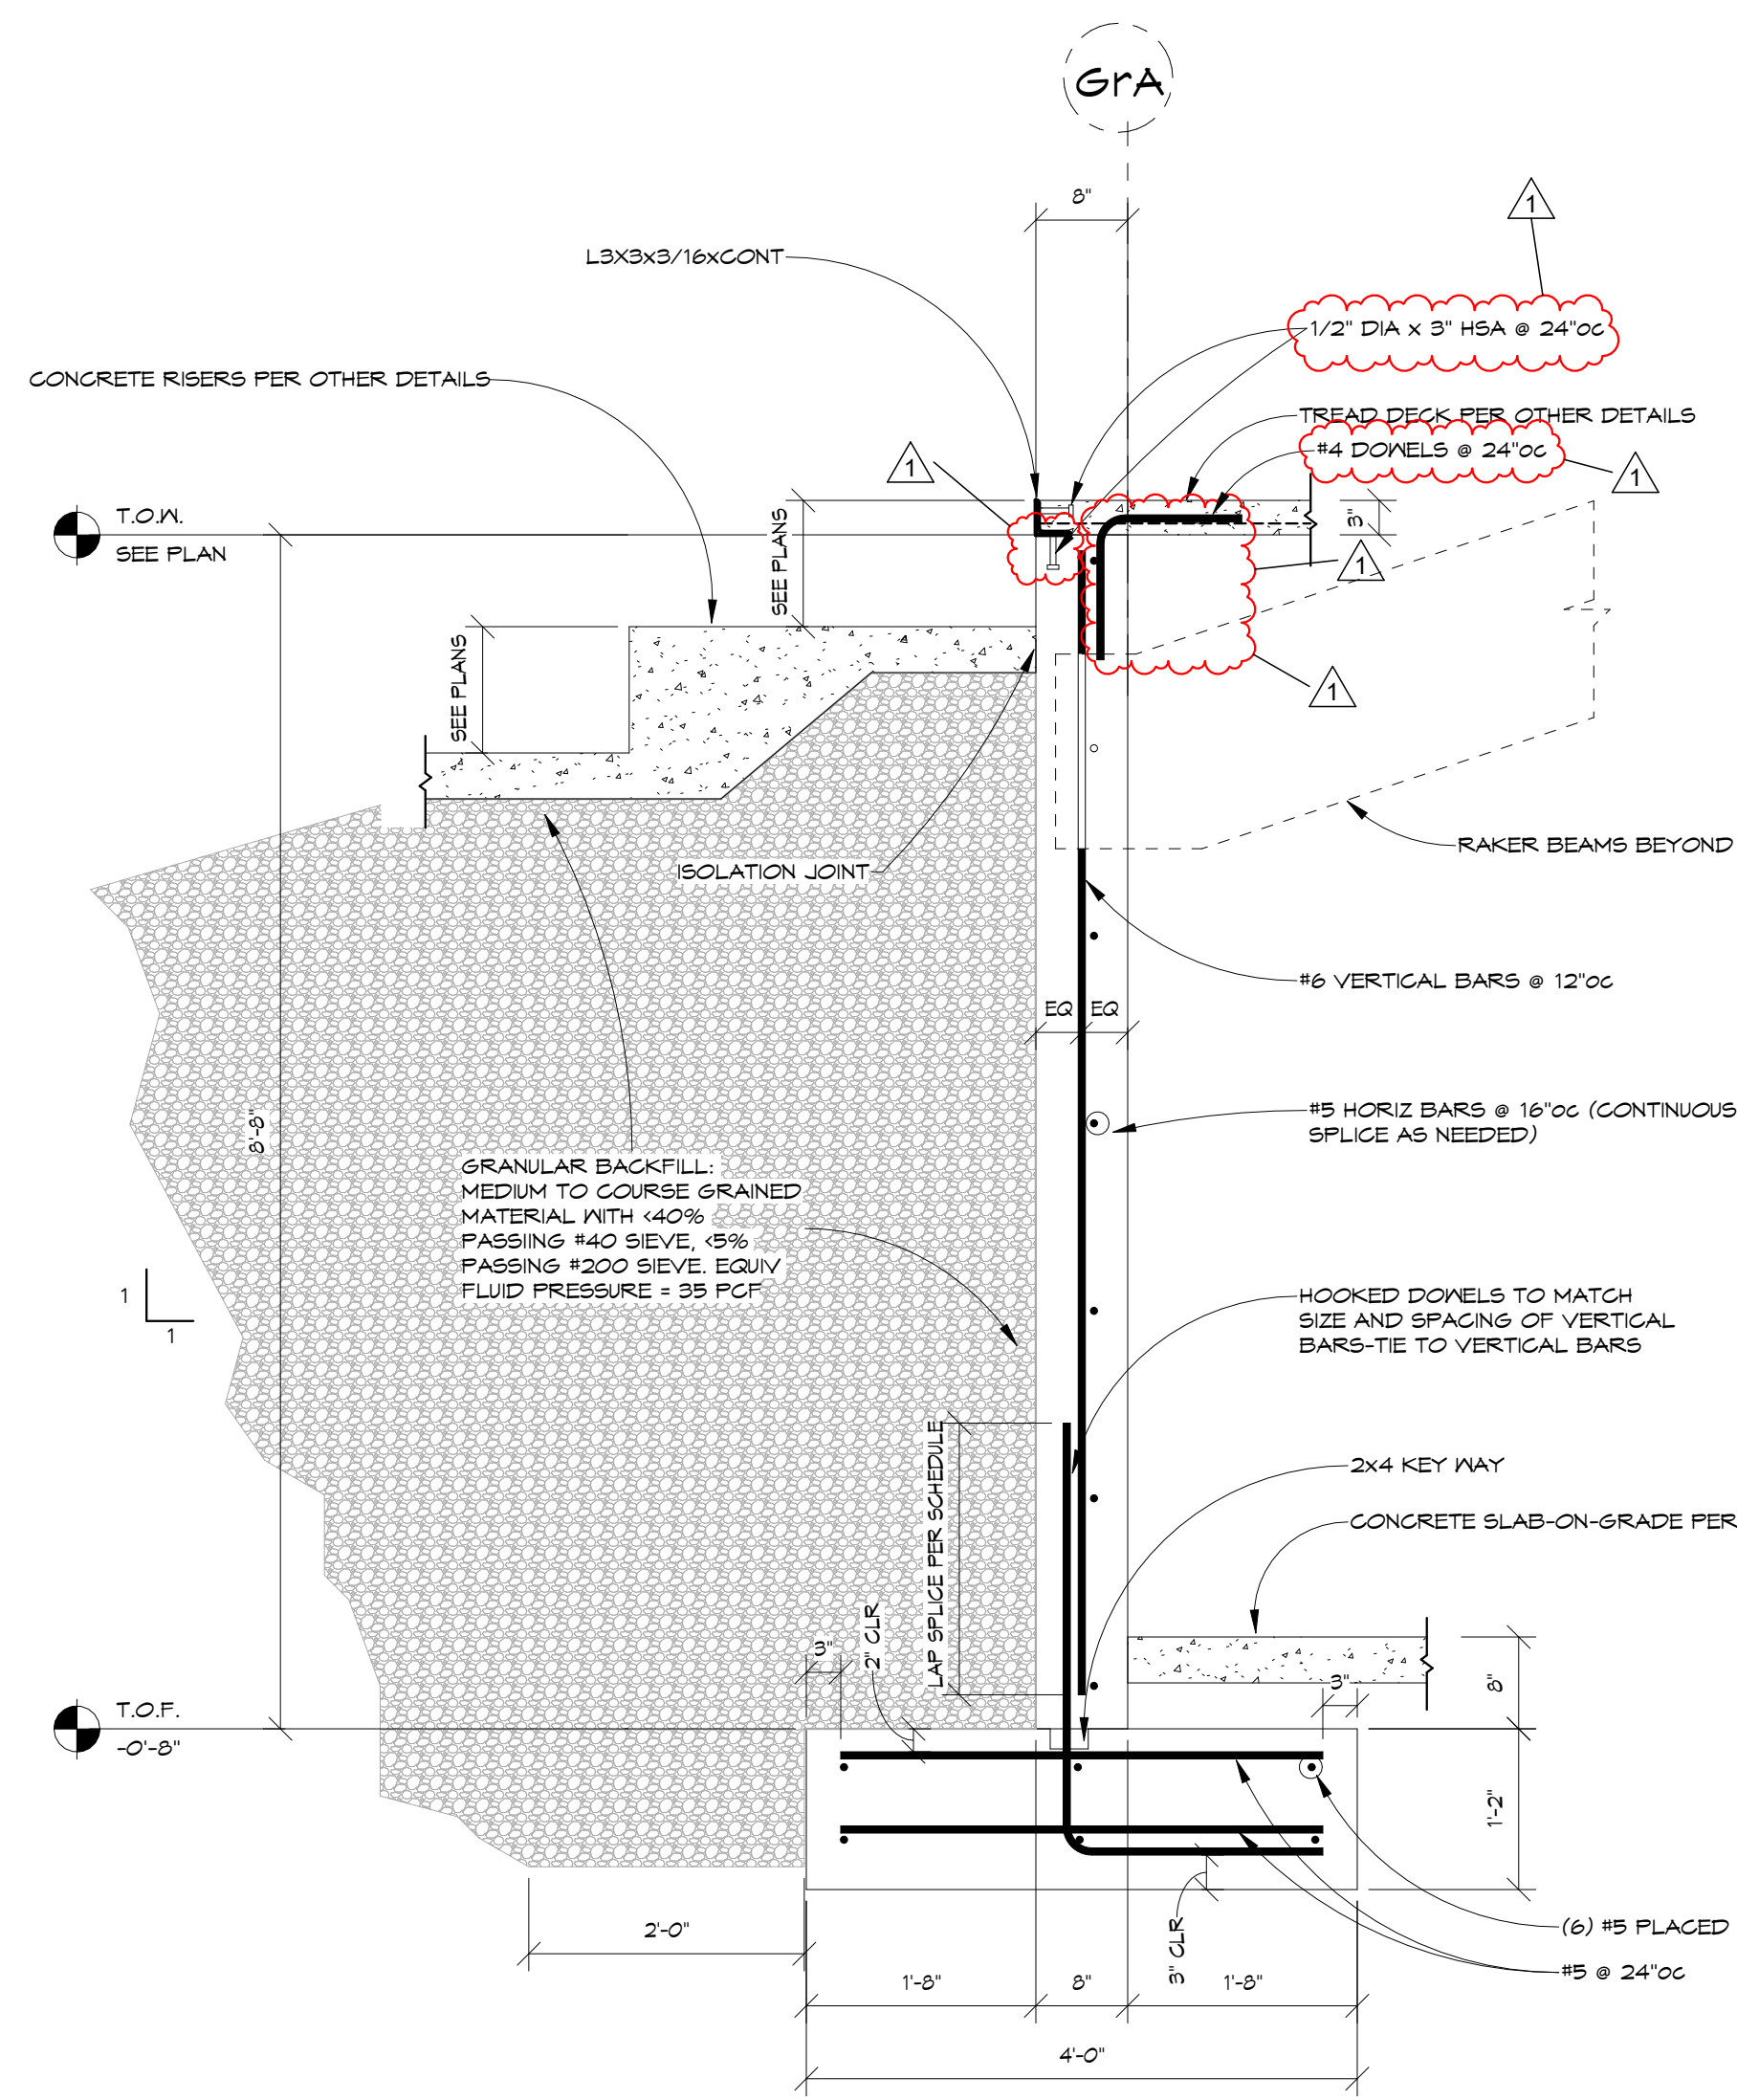

1 THEATRE SEATING RETAINING WALL  
3/4" = 1'-0"

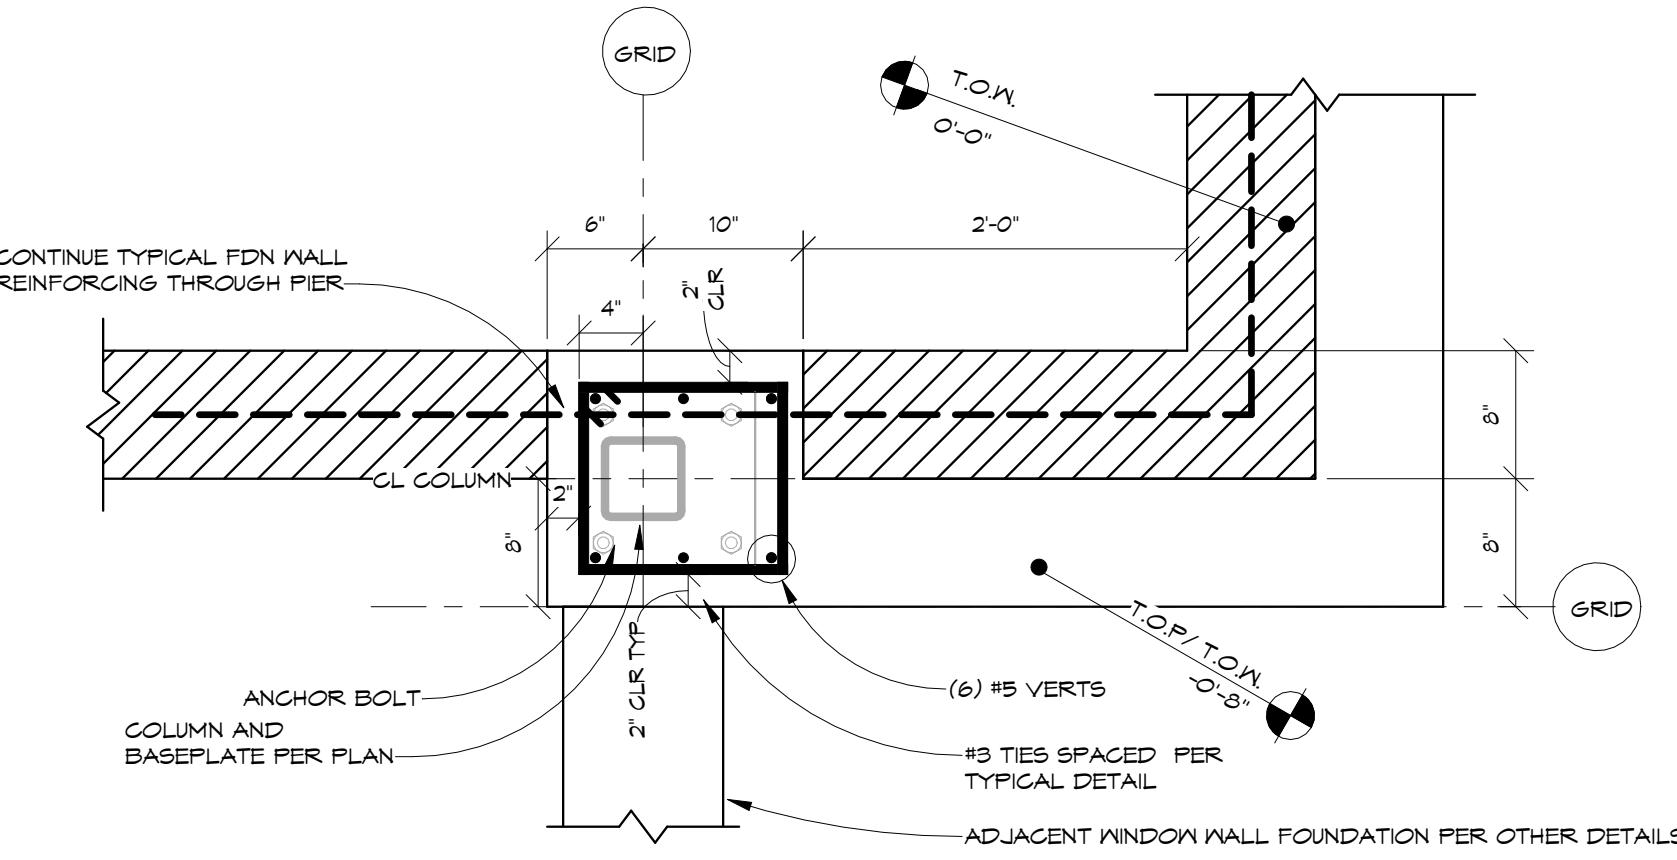


6 COLUMN ON FOUNDATION WALL  
1" = 1'-0"

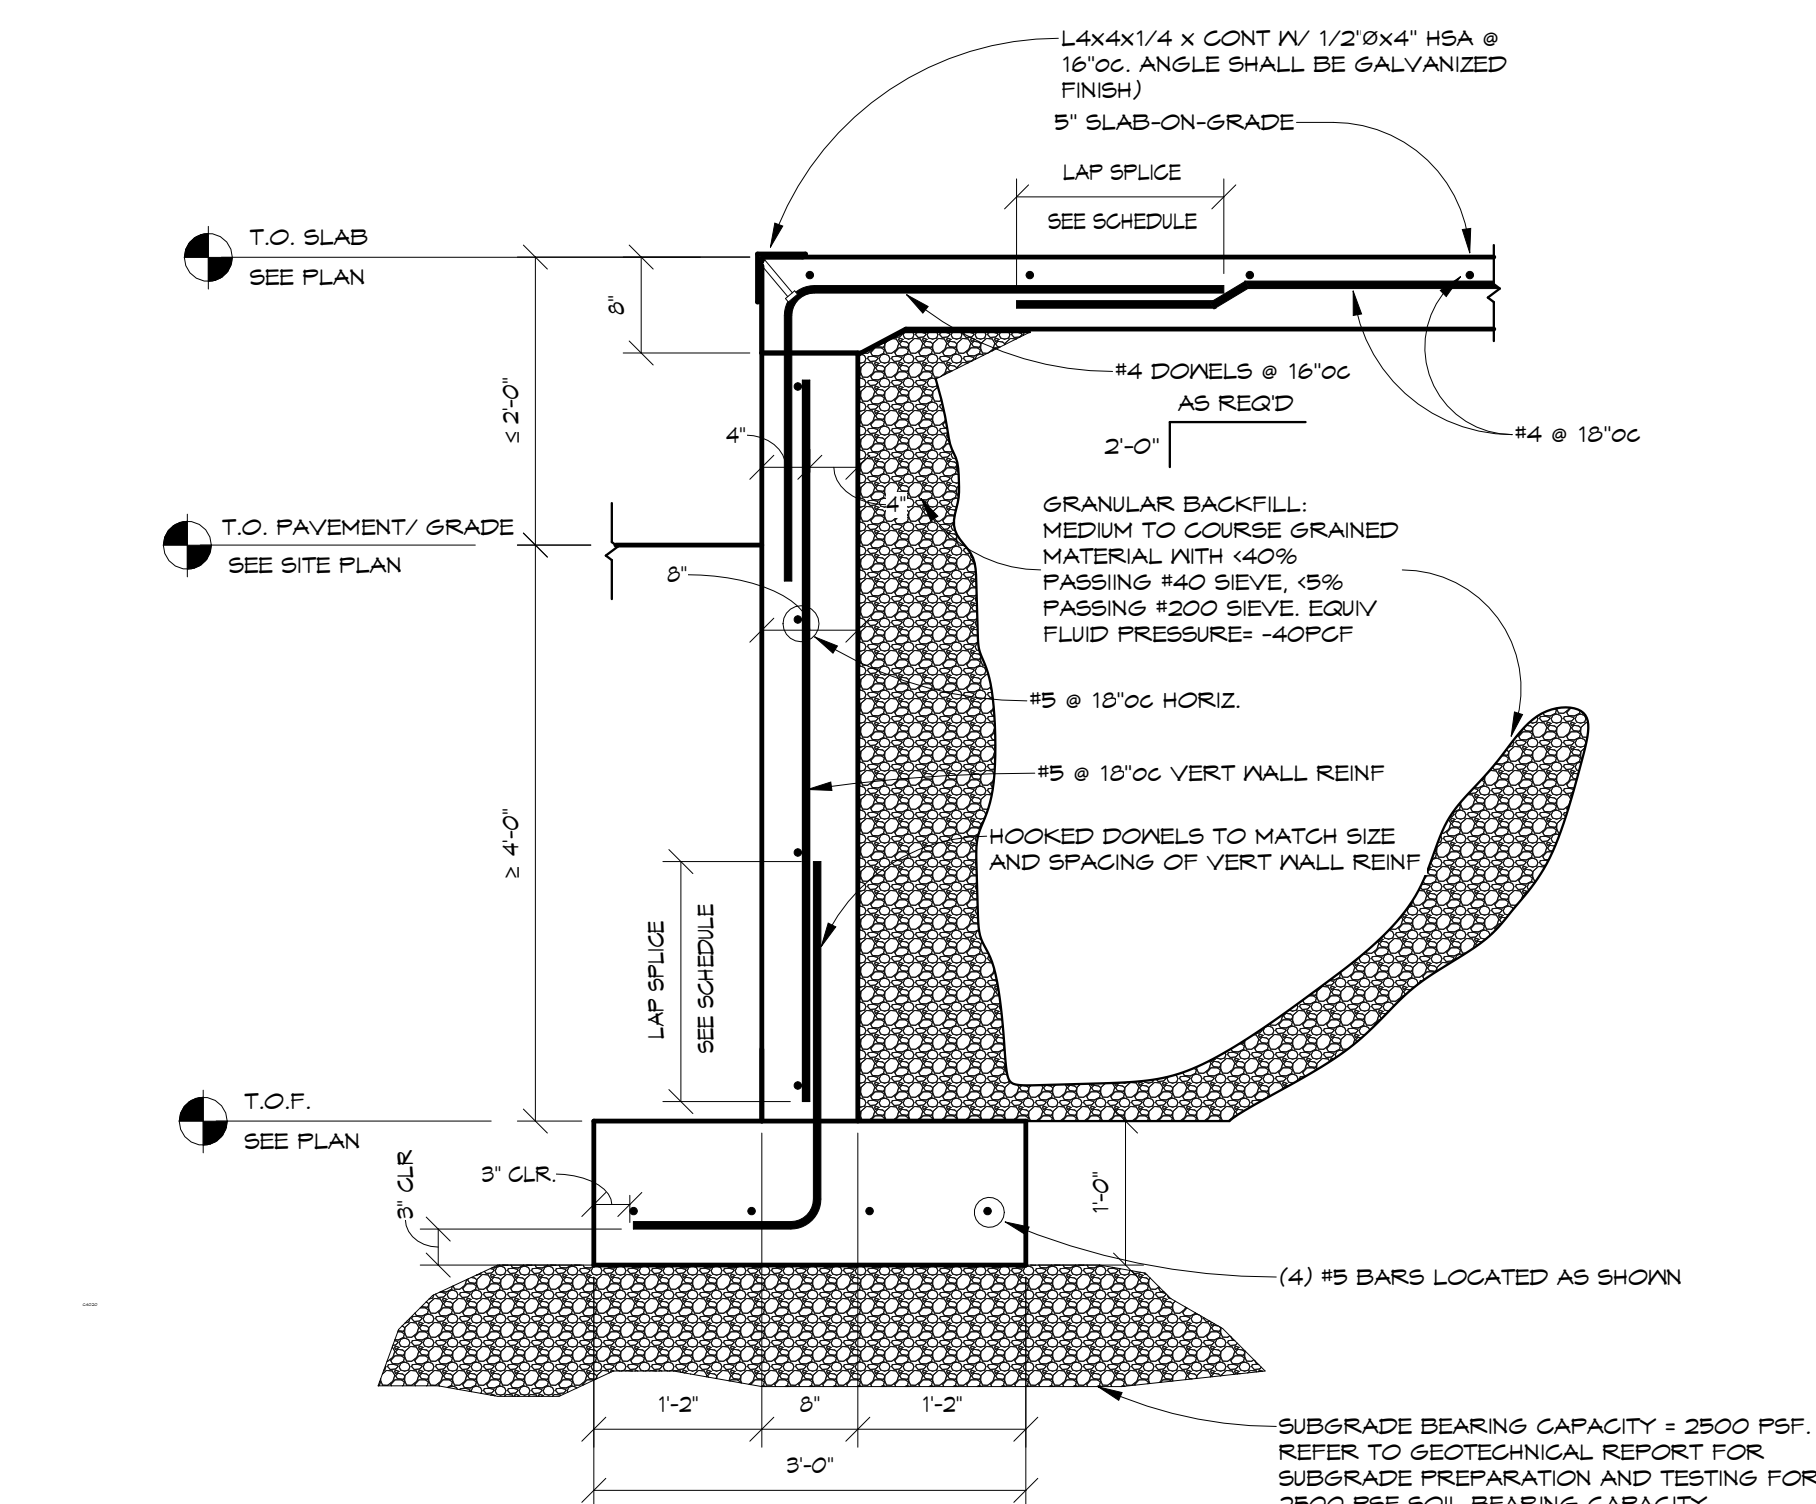


10 WALL SECTION AT LOADING DOCK (NO LEVELER)  
3/4" = 1'-0"


2 THEATRE WALL AT SIDE  
3/4" = 1'-0"

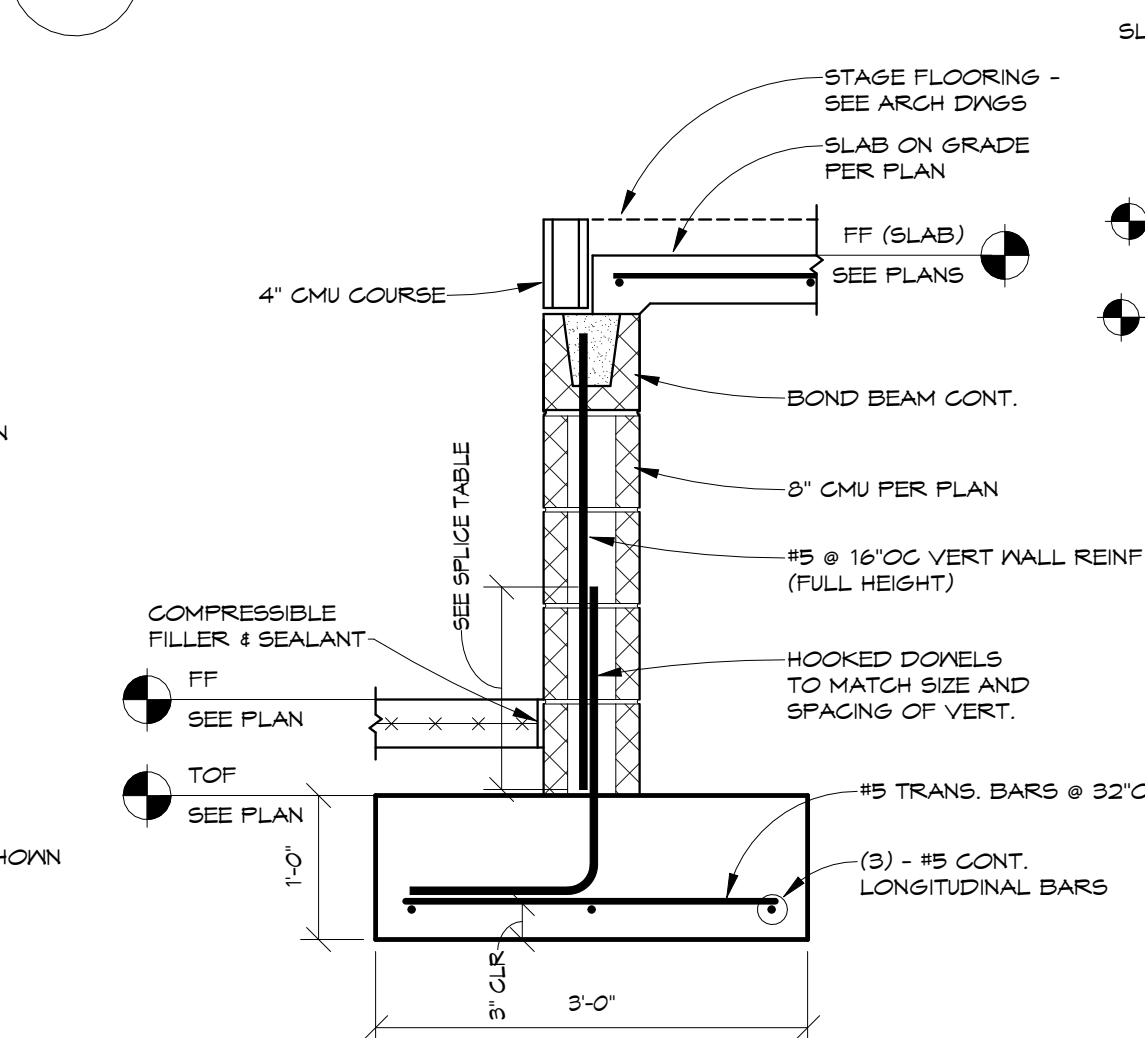

3 THEATRE WALL AT FRONT  
3/4" = 1'-0"

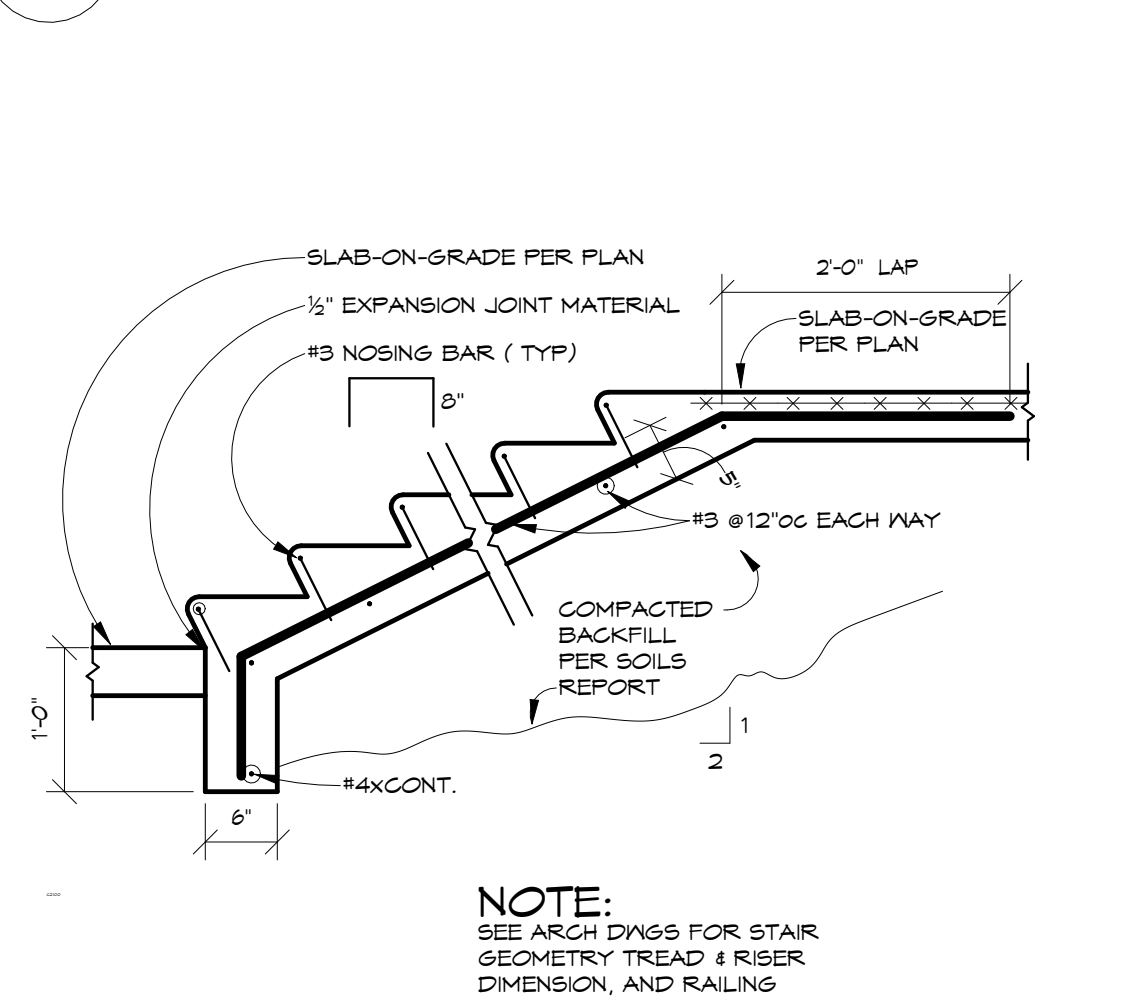


7 CONCRETE INTERIOR STAIR CONSTRUCTION  
3/4" = 1'-0"

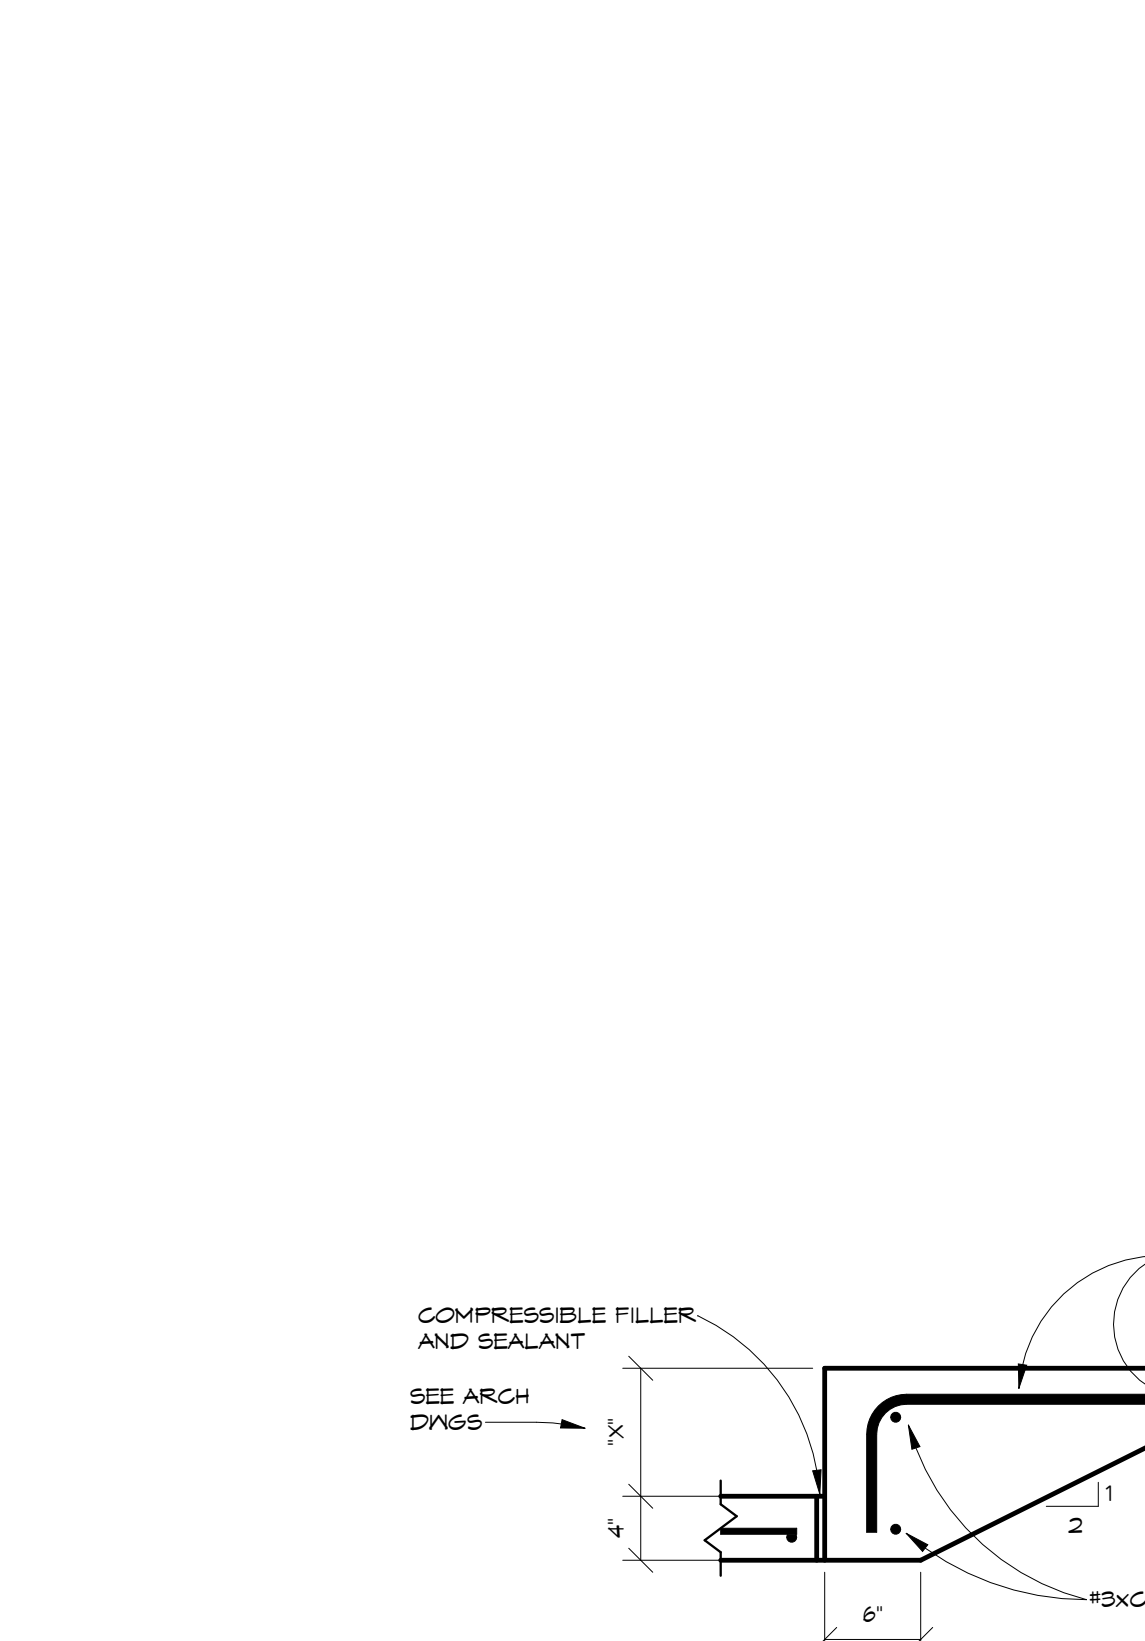


11 SLAB STEP  
1" = 1'-0"




4 THEATRE SEATING BACKFILL AGAINST PRECAST  
3/4" = 1'-0"

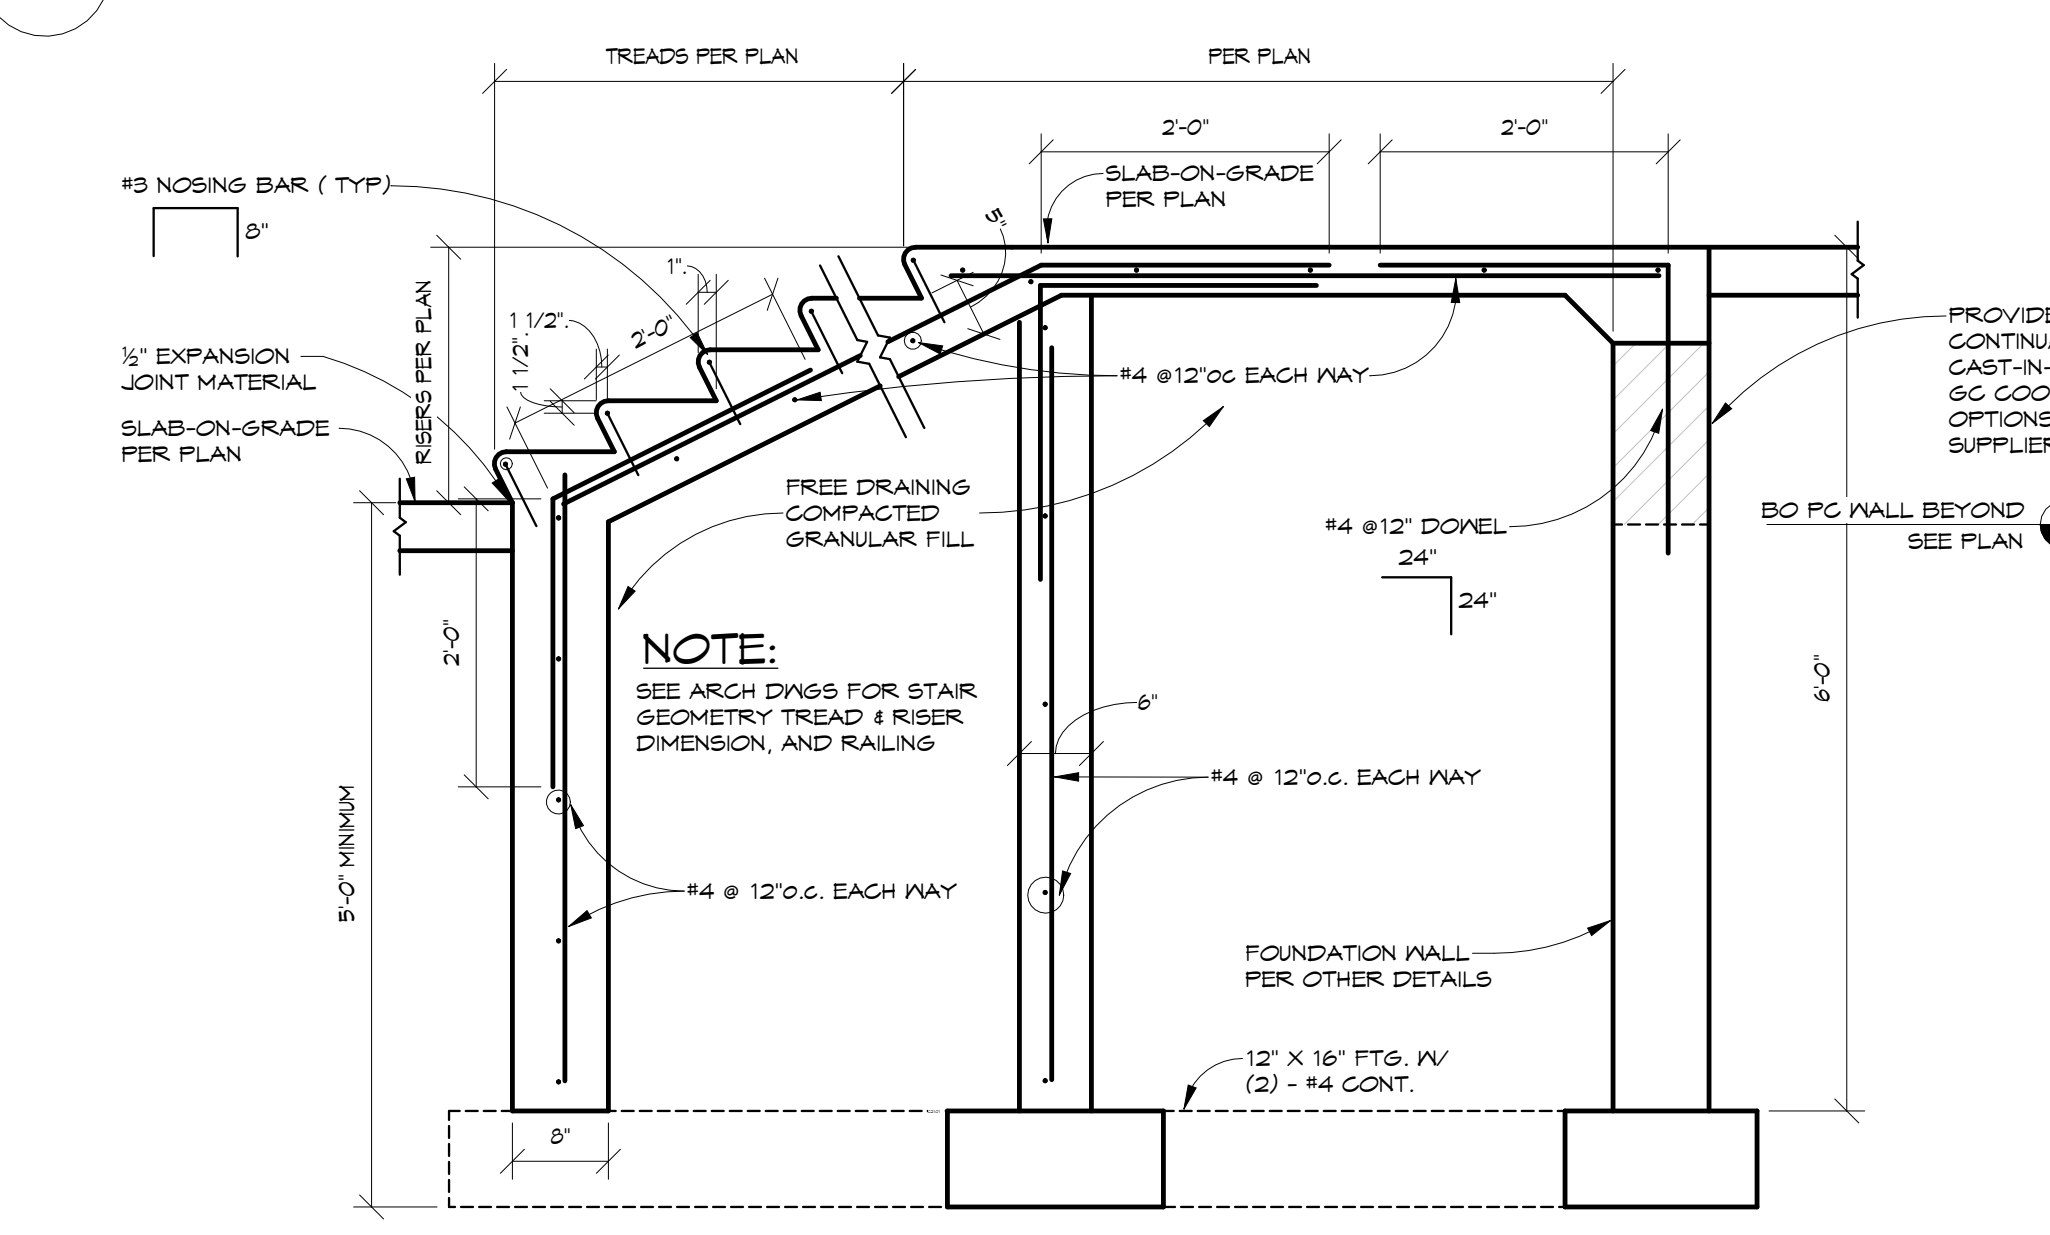



8 CONCRETE EXTERIOR STAIR CONSTRUCTION  
3/4" = 1'-0"

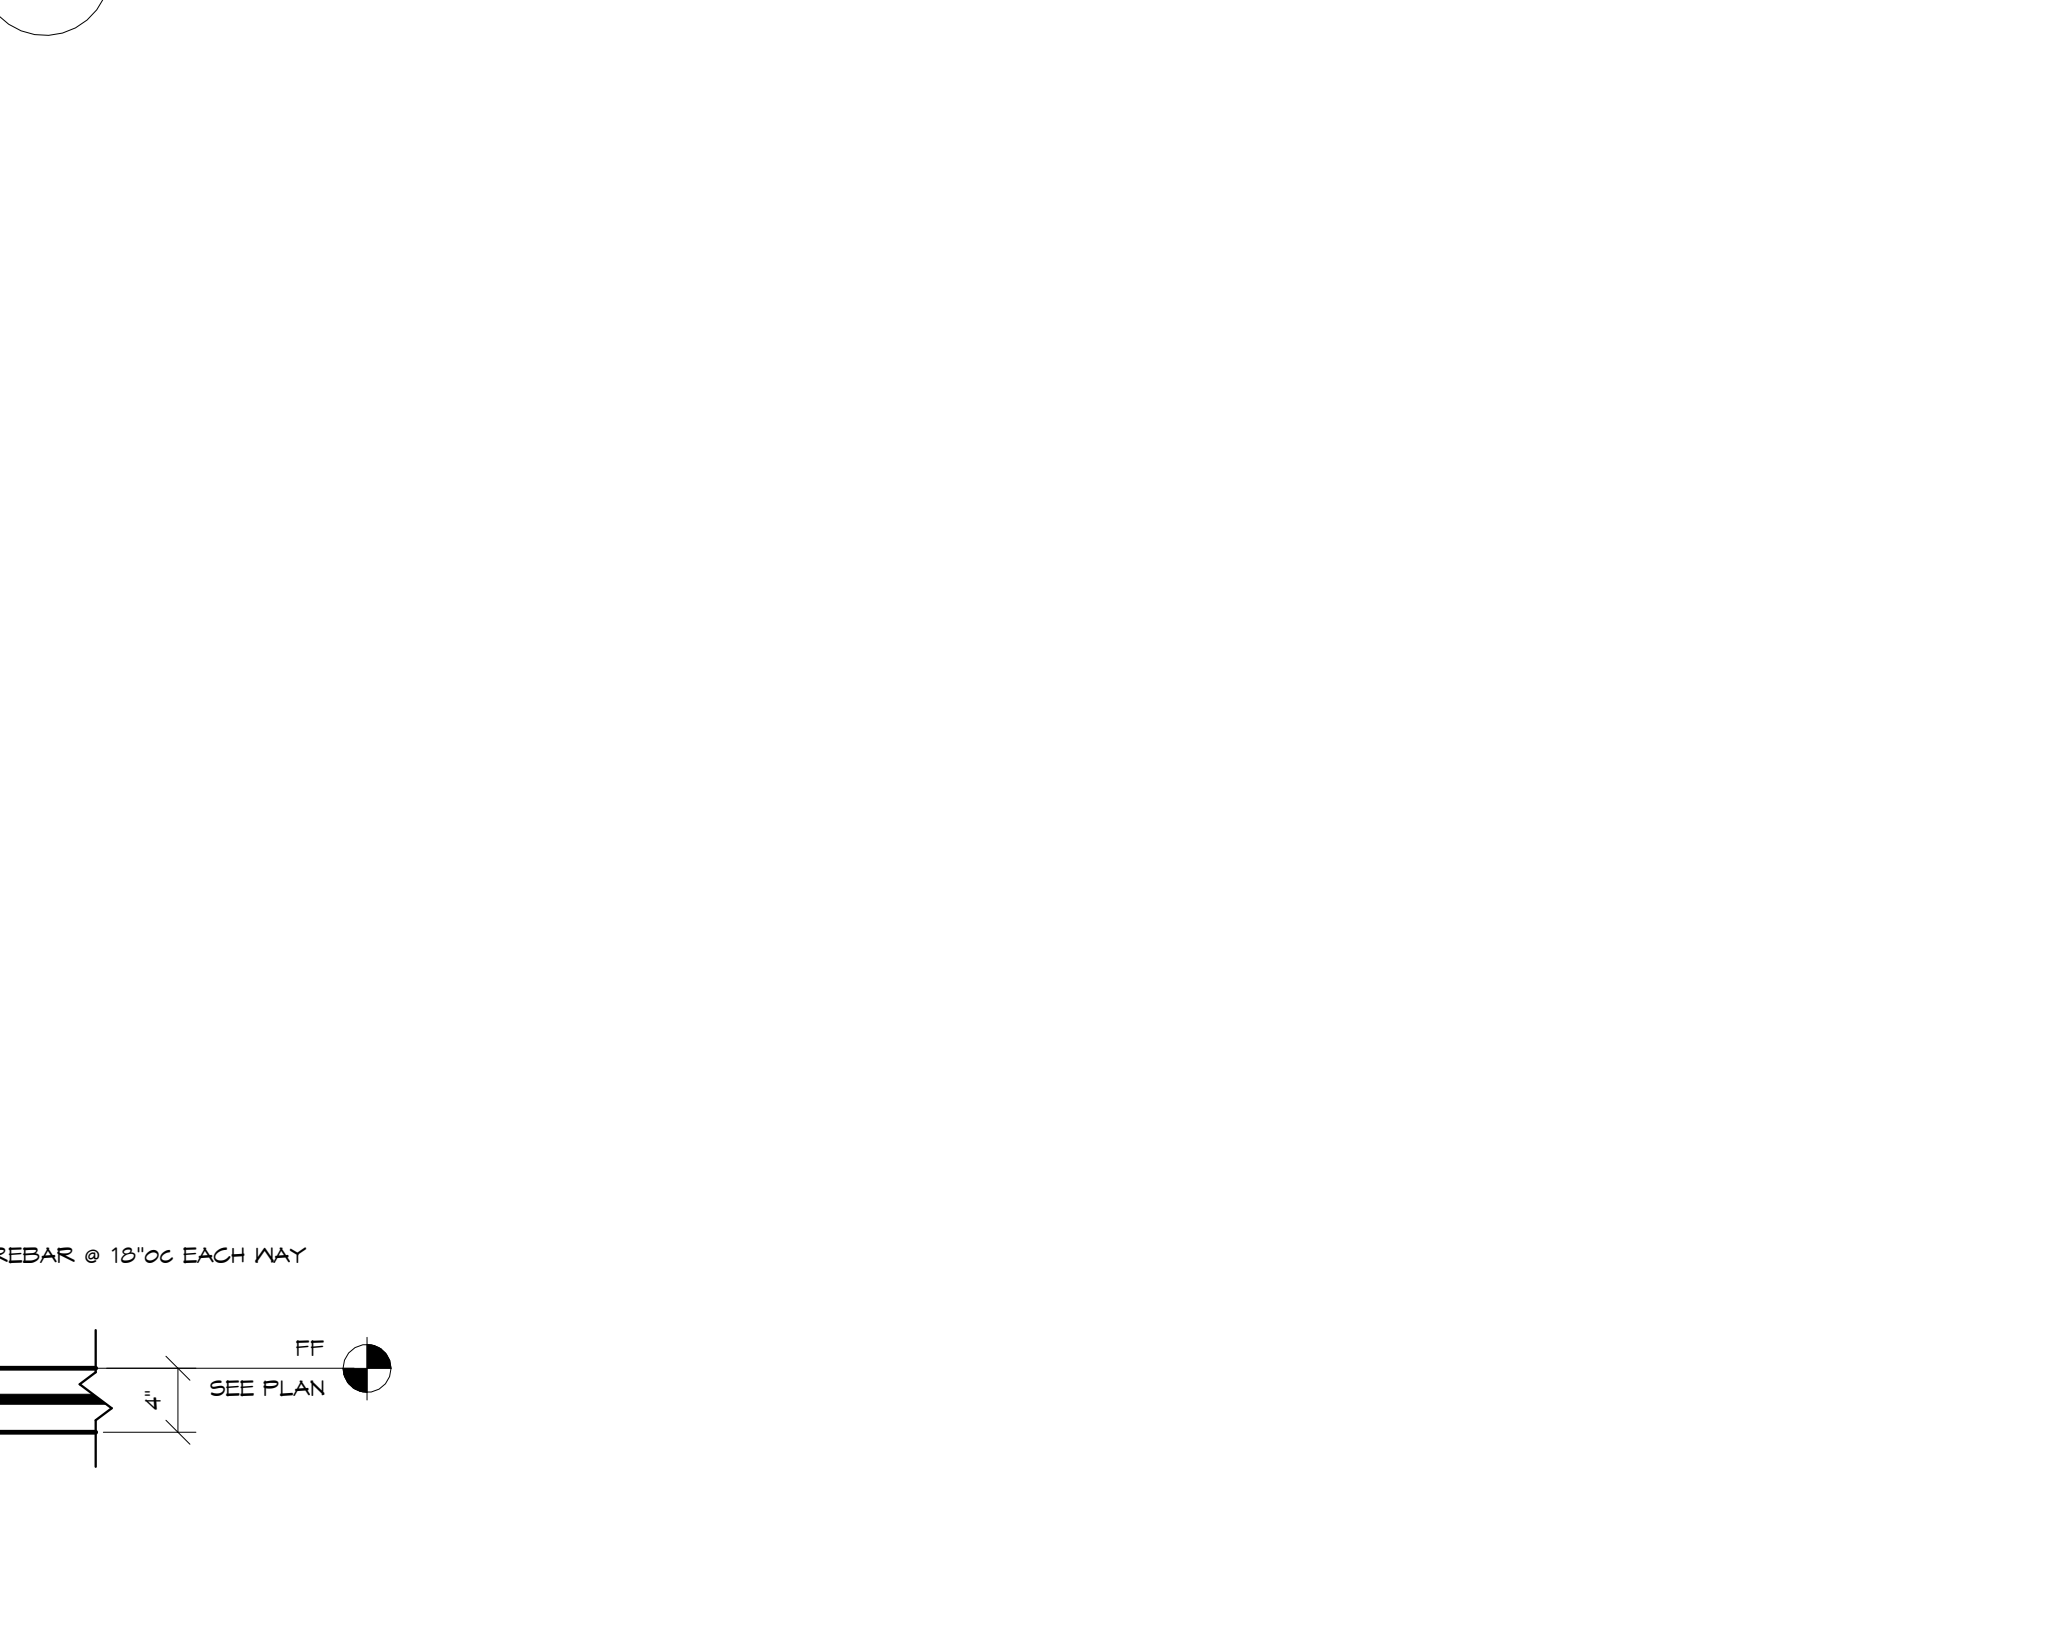

5 EXTERIOR PC WALL FOOTING AT EXTERIOR GRADE DROP - GYM  
3/4" = 1'-0"

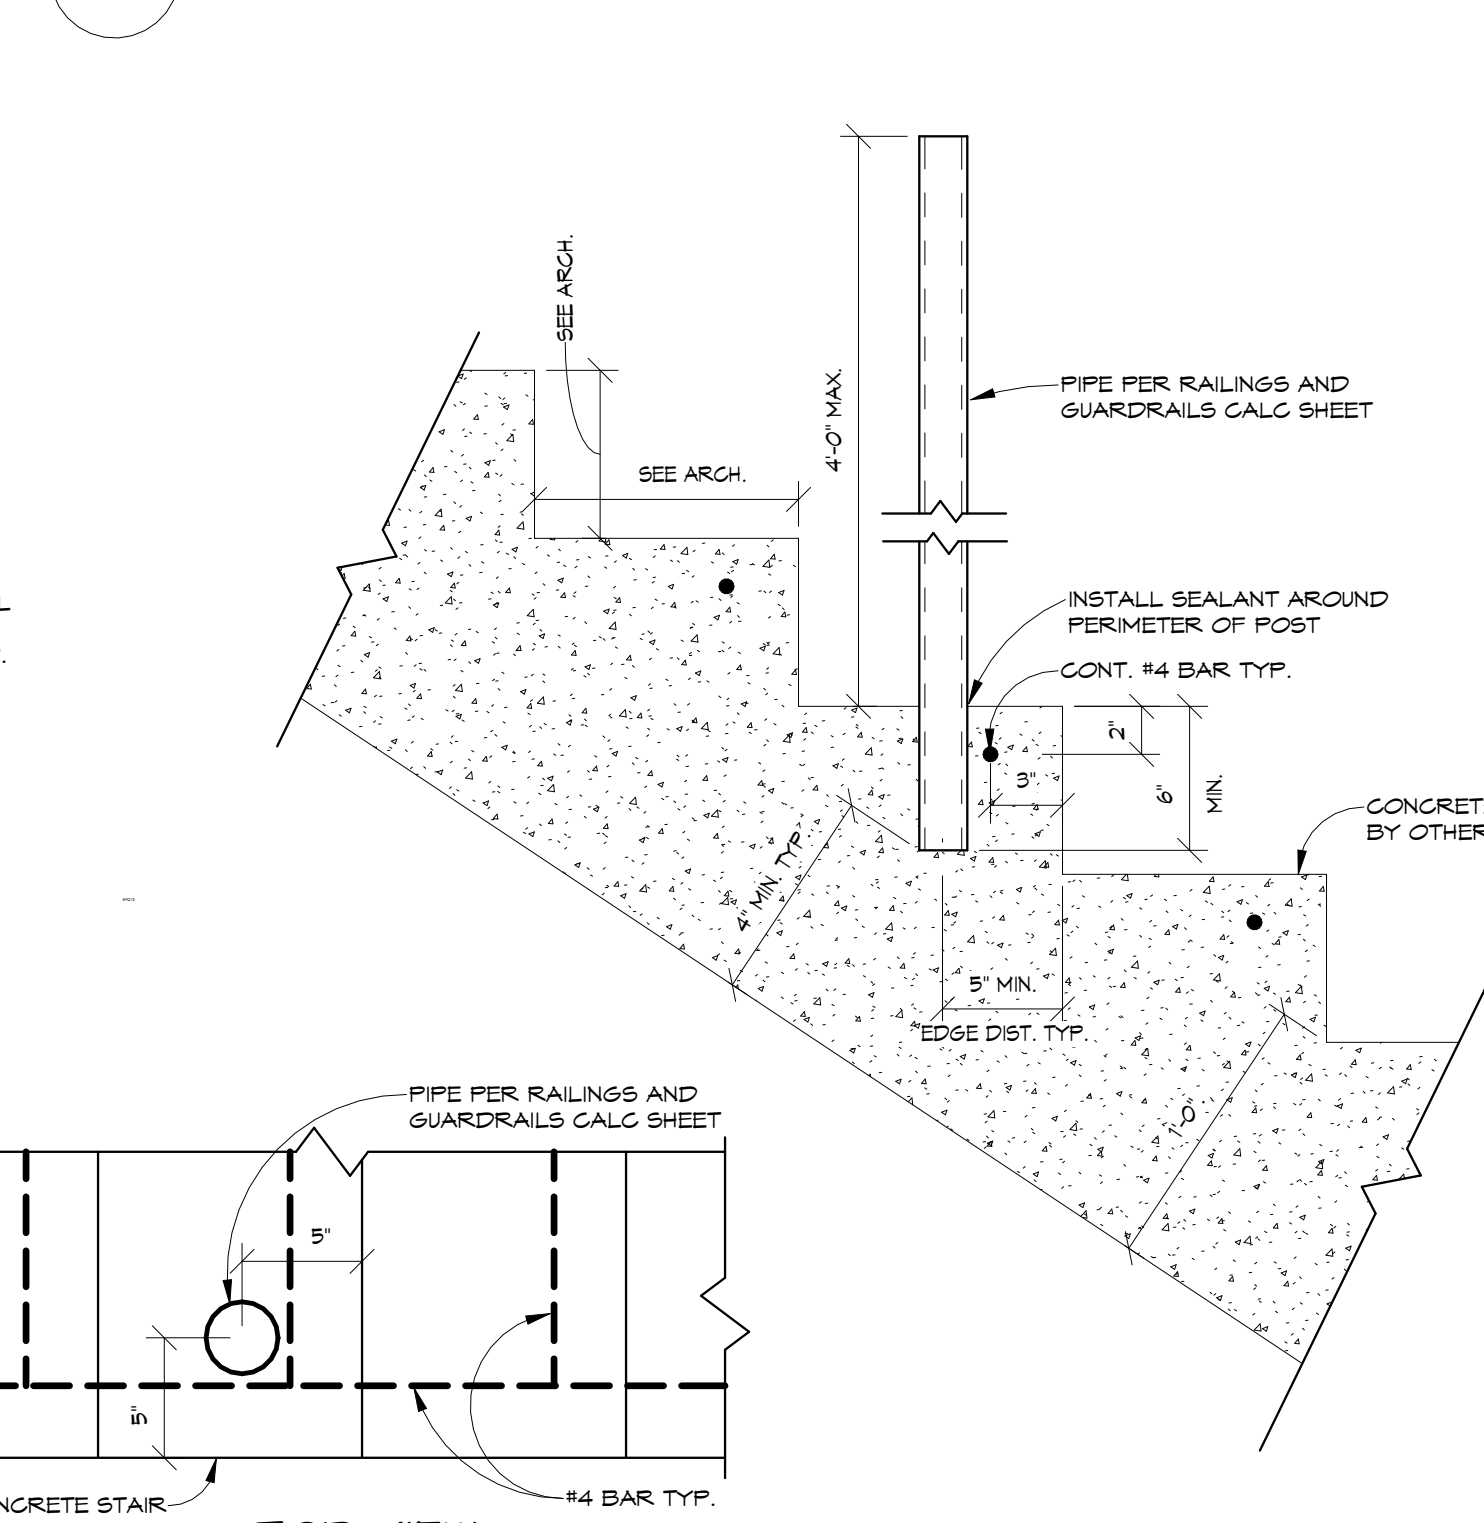

 
9 EXTERIOR RAILING INSTALLED IN CONCRETE  
1 1/2" = 1'-0"

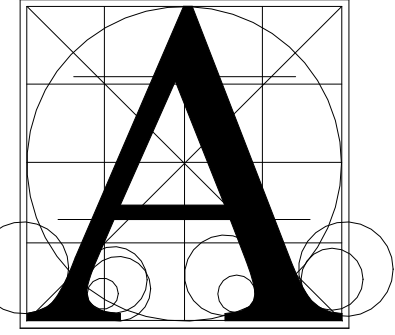

Architecture  
Incorporated

415 South Main Avenue  
P.O. Box 2140  
Sioux Falls, South Dakota 57101  
Phone: (605) 339-1711


815 St Joseph Street, Suite 203  
P.O. Box 8047  
Rapid City, South Dakota 57701  
Phone: (605) 721-1158

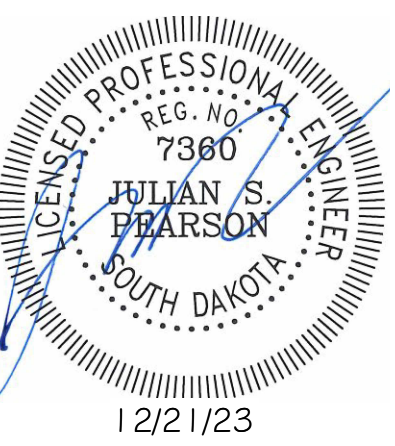

LENNOX HIGH SCHOOL ADDITION  
DETAILS - FOUNDATION

Project	number	0215.2982.22
	date	12/21/2023
	revision	
drawn	TN/JF	checked JP
1	1/18/24	ADDENDUM #2



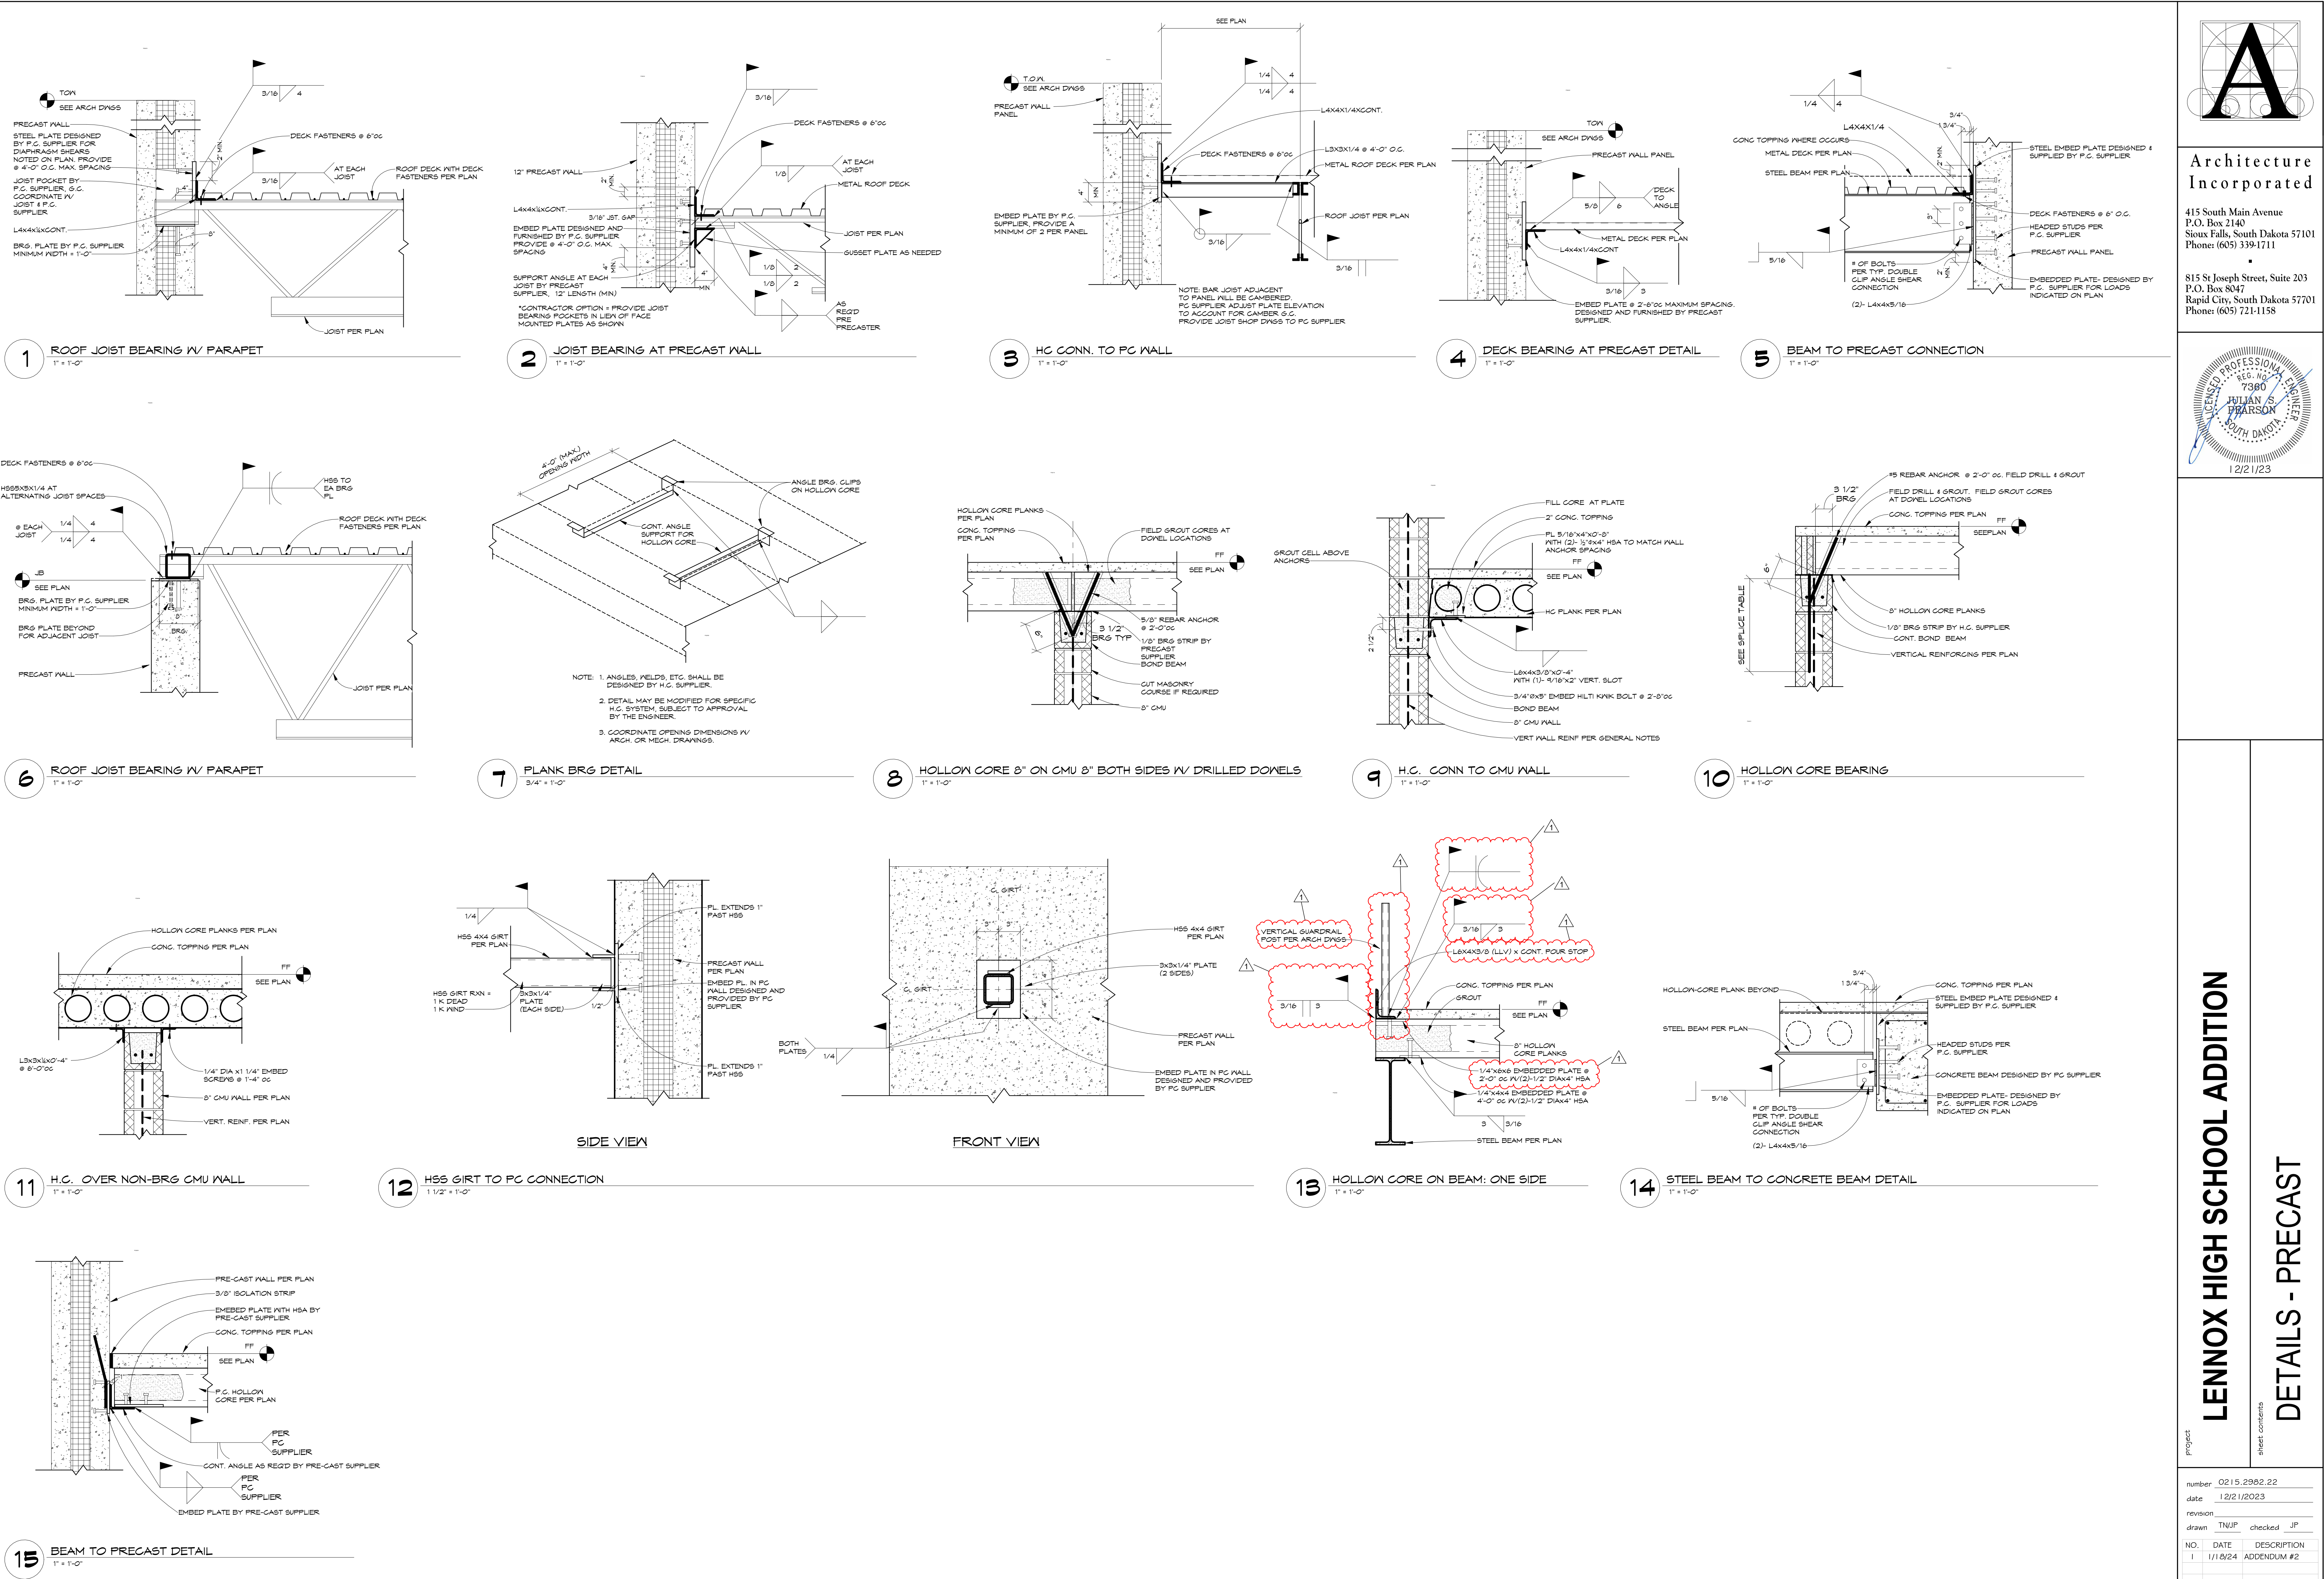




**Architecture Incorporated**

415 South Main Avenue  
P.O. Box 2140  
Sioux Falls, South Dakota 57101  
Phone: (605) 339-1711

815 St Joseph Street, Suite 203  
P.O. Box 8047  
Rapid City, South Dakota 57701  
Phone: (605) 721-1158

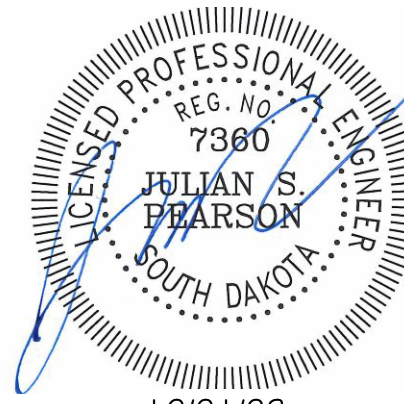


12/21/23

LENNOX HIGH SCHOOL ADDITION

DETAILS - PRECAST

number	0215.2982.22		
date	12/21/2023		
revision			
drawn	TN/JP	checked	JP
NO.	DATE	DESCRIPTION	
1	1/18/24	ADDENDUM #2	




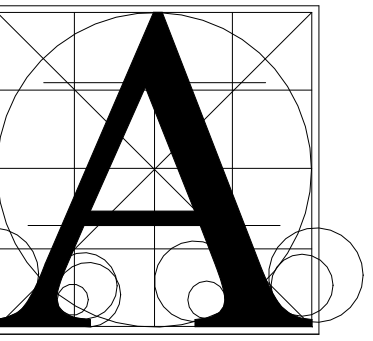

Architecture  
Incorporated

415 South Main Avenue  
P.O. Box 2140  
Sioux Falls, South Dakota 57101  
Phone: (605) 339-1711


815 St Joseph Street, Suite 203  
P.O. Box 8047  
Rapid City, South Dakota 57701  
Phone: (605) 721-1158

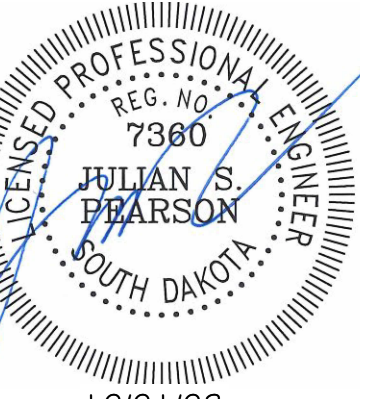

LENNOX HIGH SCHOOL ADDITION  
DETAILS - MASONRY

	sheet 001
number 0215.2982.22	
date 12/21/2023	
revision	
drawn by TN/JF	checked by JP
DATE	DESCRIPTION
1/18/24	ADDENDUM #2

3.51


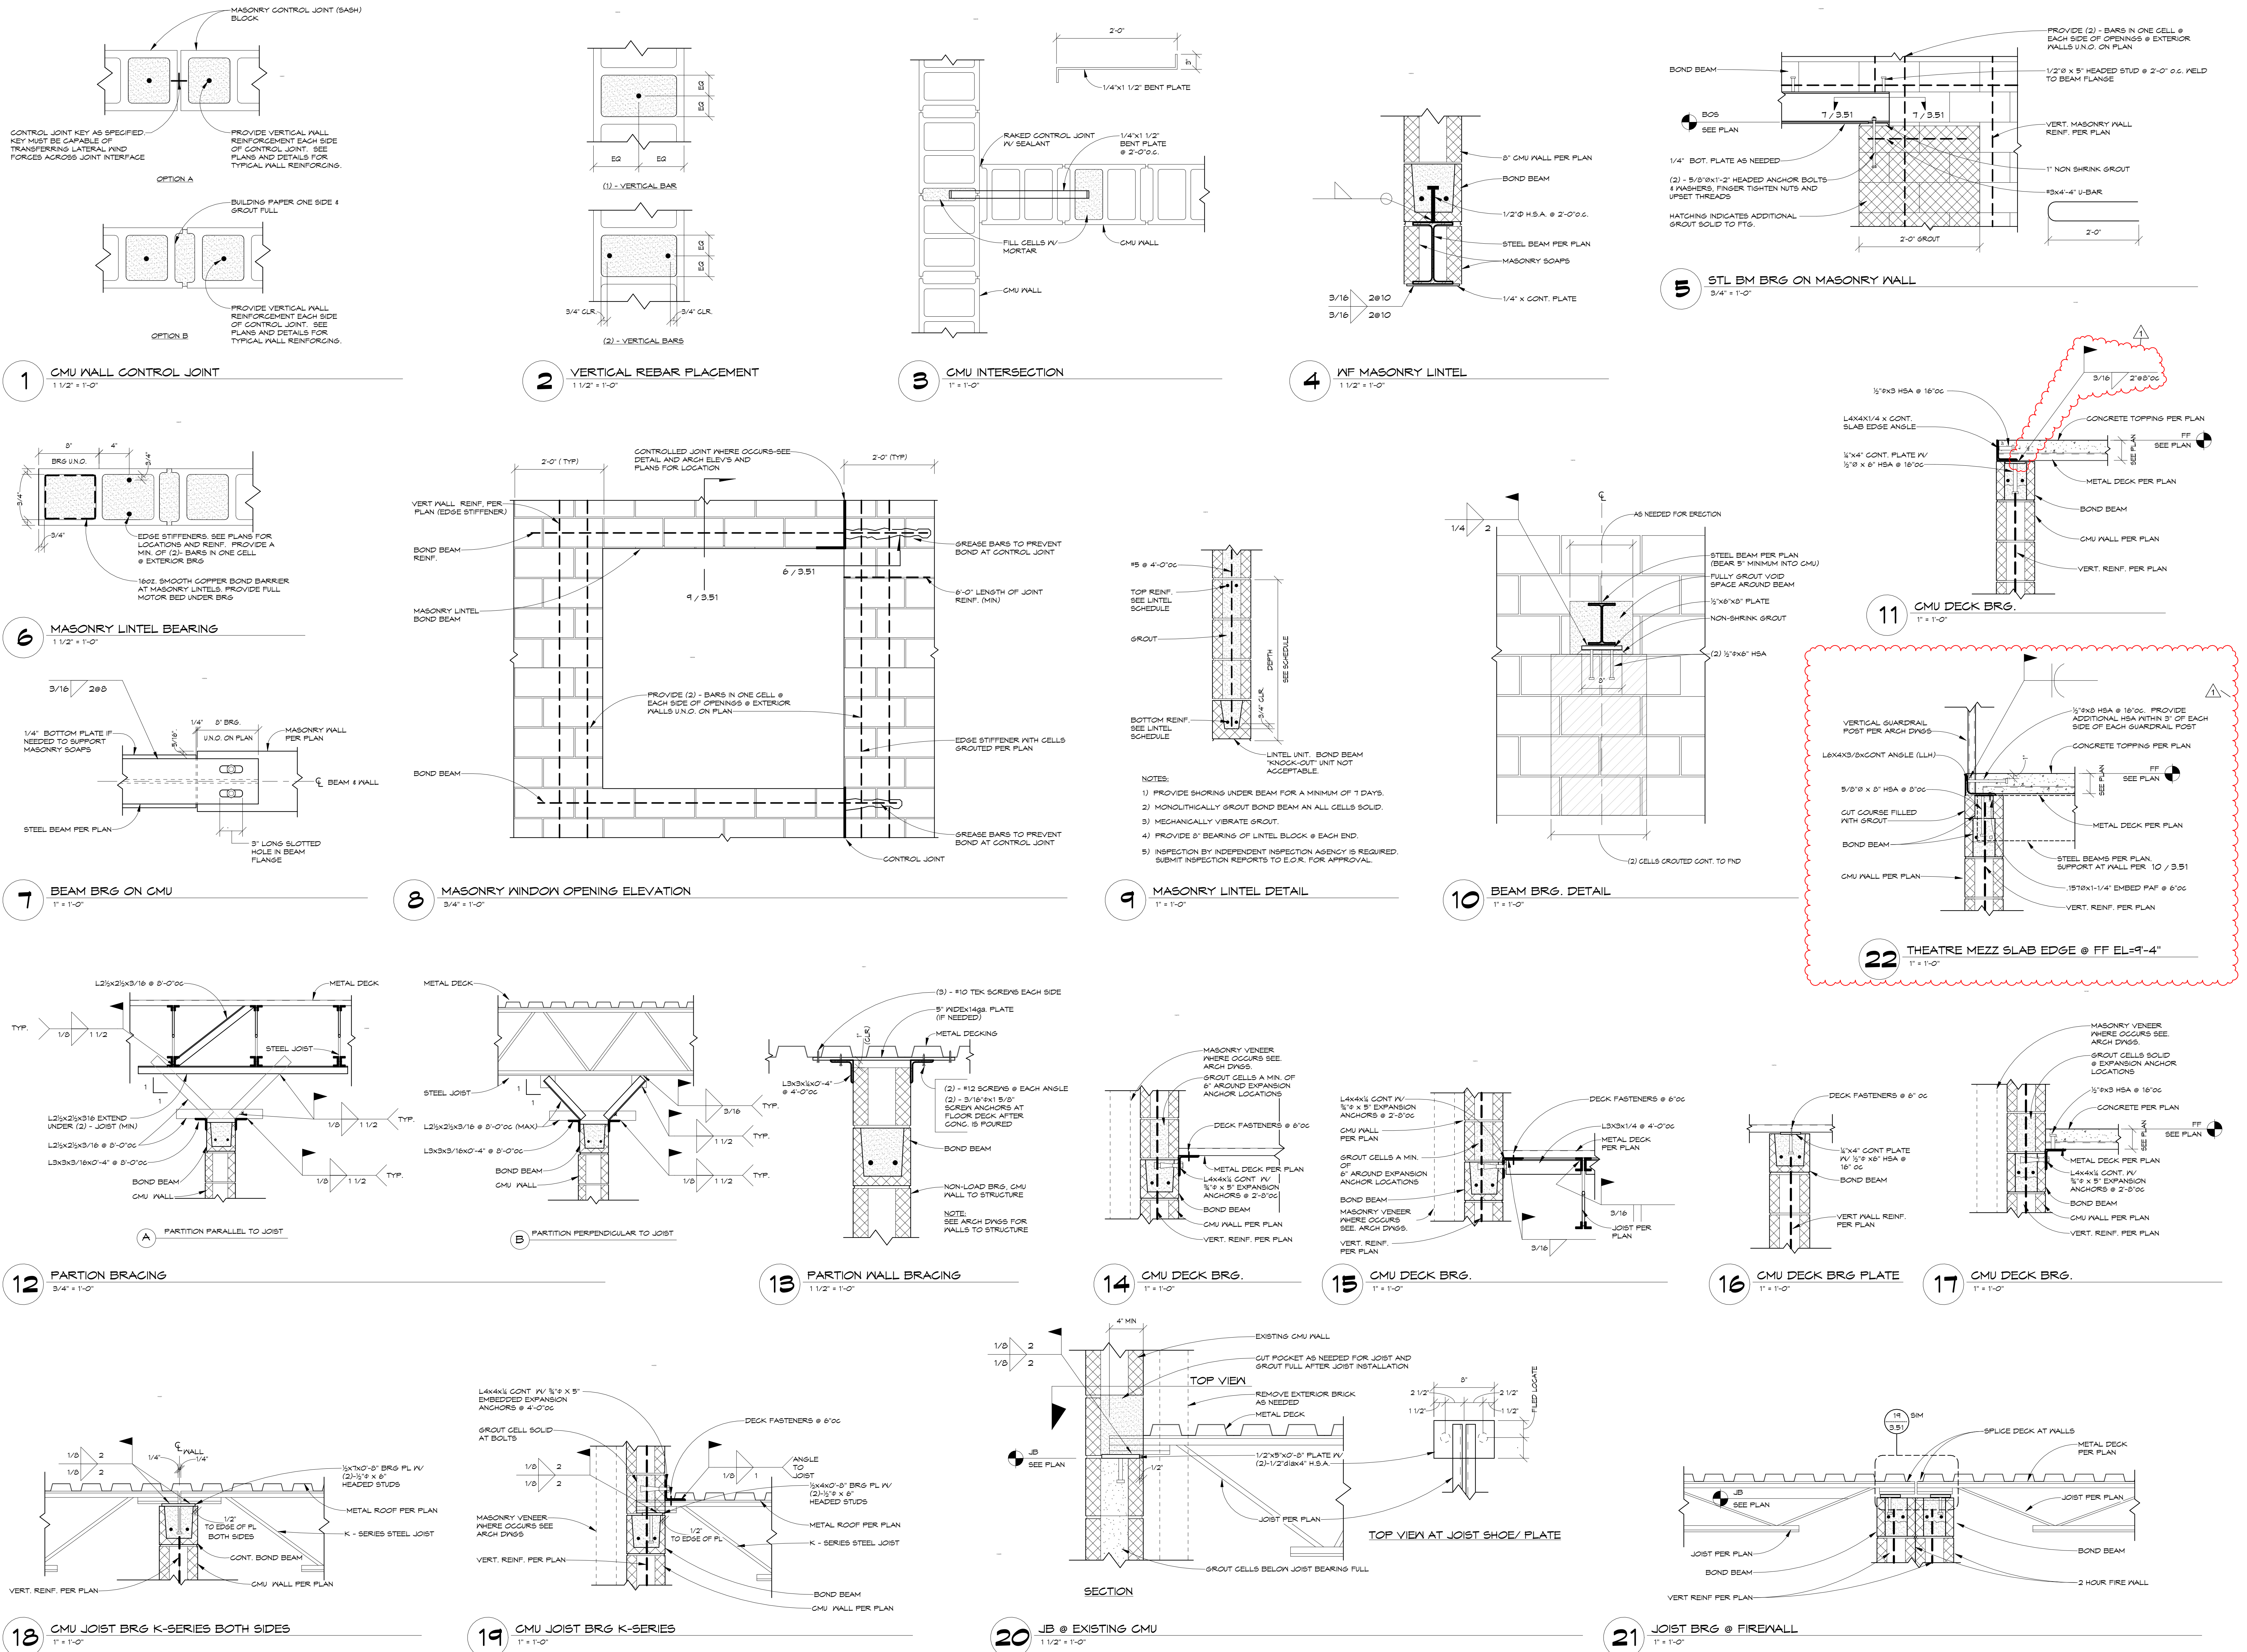









1/18/2024 11:01:02 AM

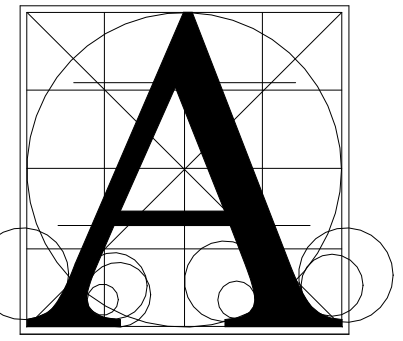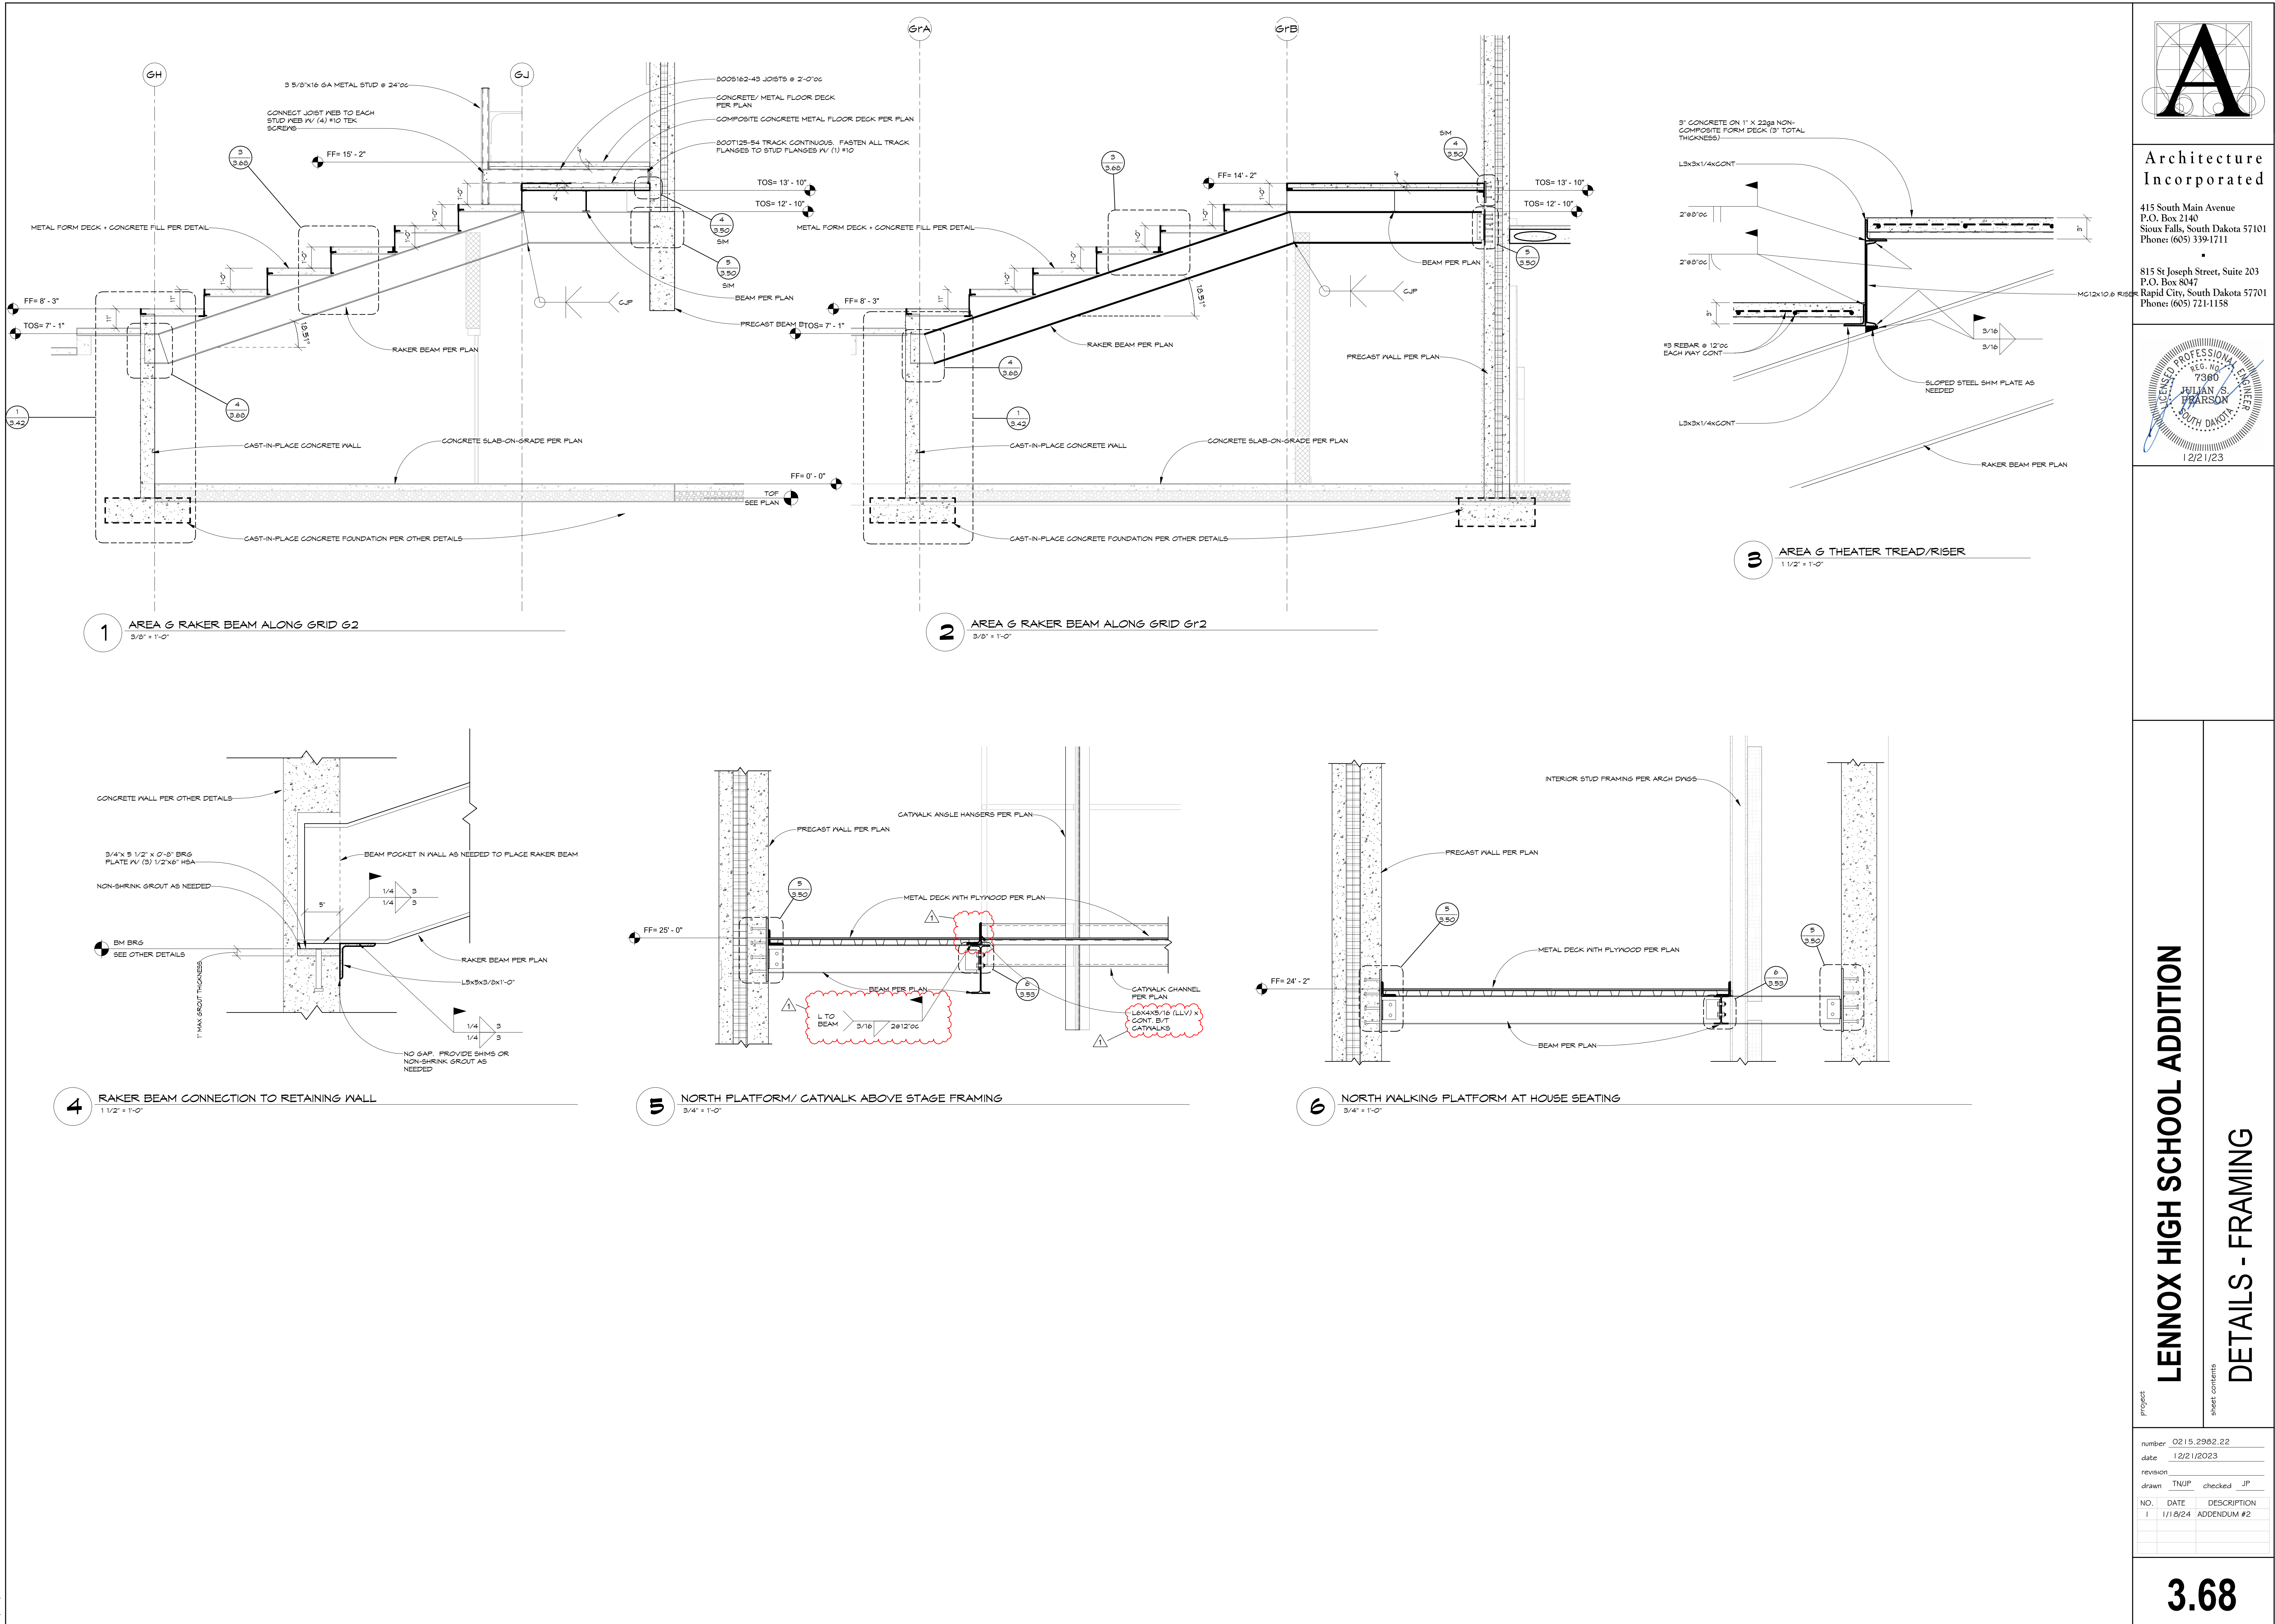

Architecture  
Incorporated

415 South Main Avenue  
P.O. Box 2140  
Sioux Falls, South Dakota 57101  
Phone: (605) 339-1711

815 St Joseph Street, Suite 203  
P.O. Box 8047  
Rapid City, South Dakota 57701  
Phone: (605) 721-1158

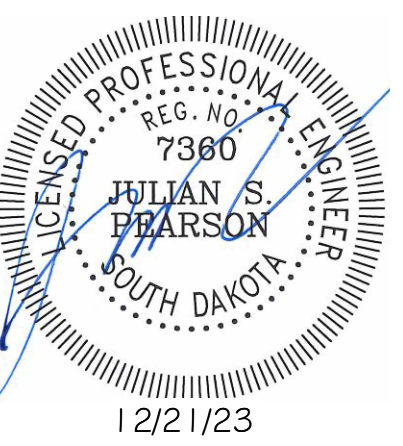


LENNOX HIGH SCHOOL ADDITION  
DETAILS - FRAMING

Project	number	0215.2982.22
	date	12/21/2023
	revision	
drawn	TN/JP	checked JP
NO.	DATE	DESCRIPTION
1	1/18/24	ADDENDUM #2





1/18/2024 5:17:32 PM

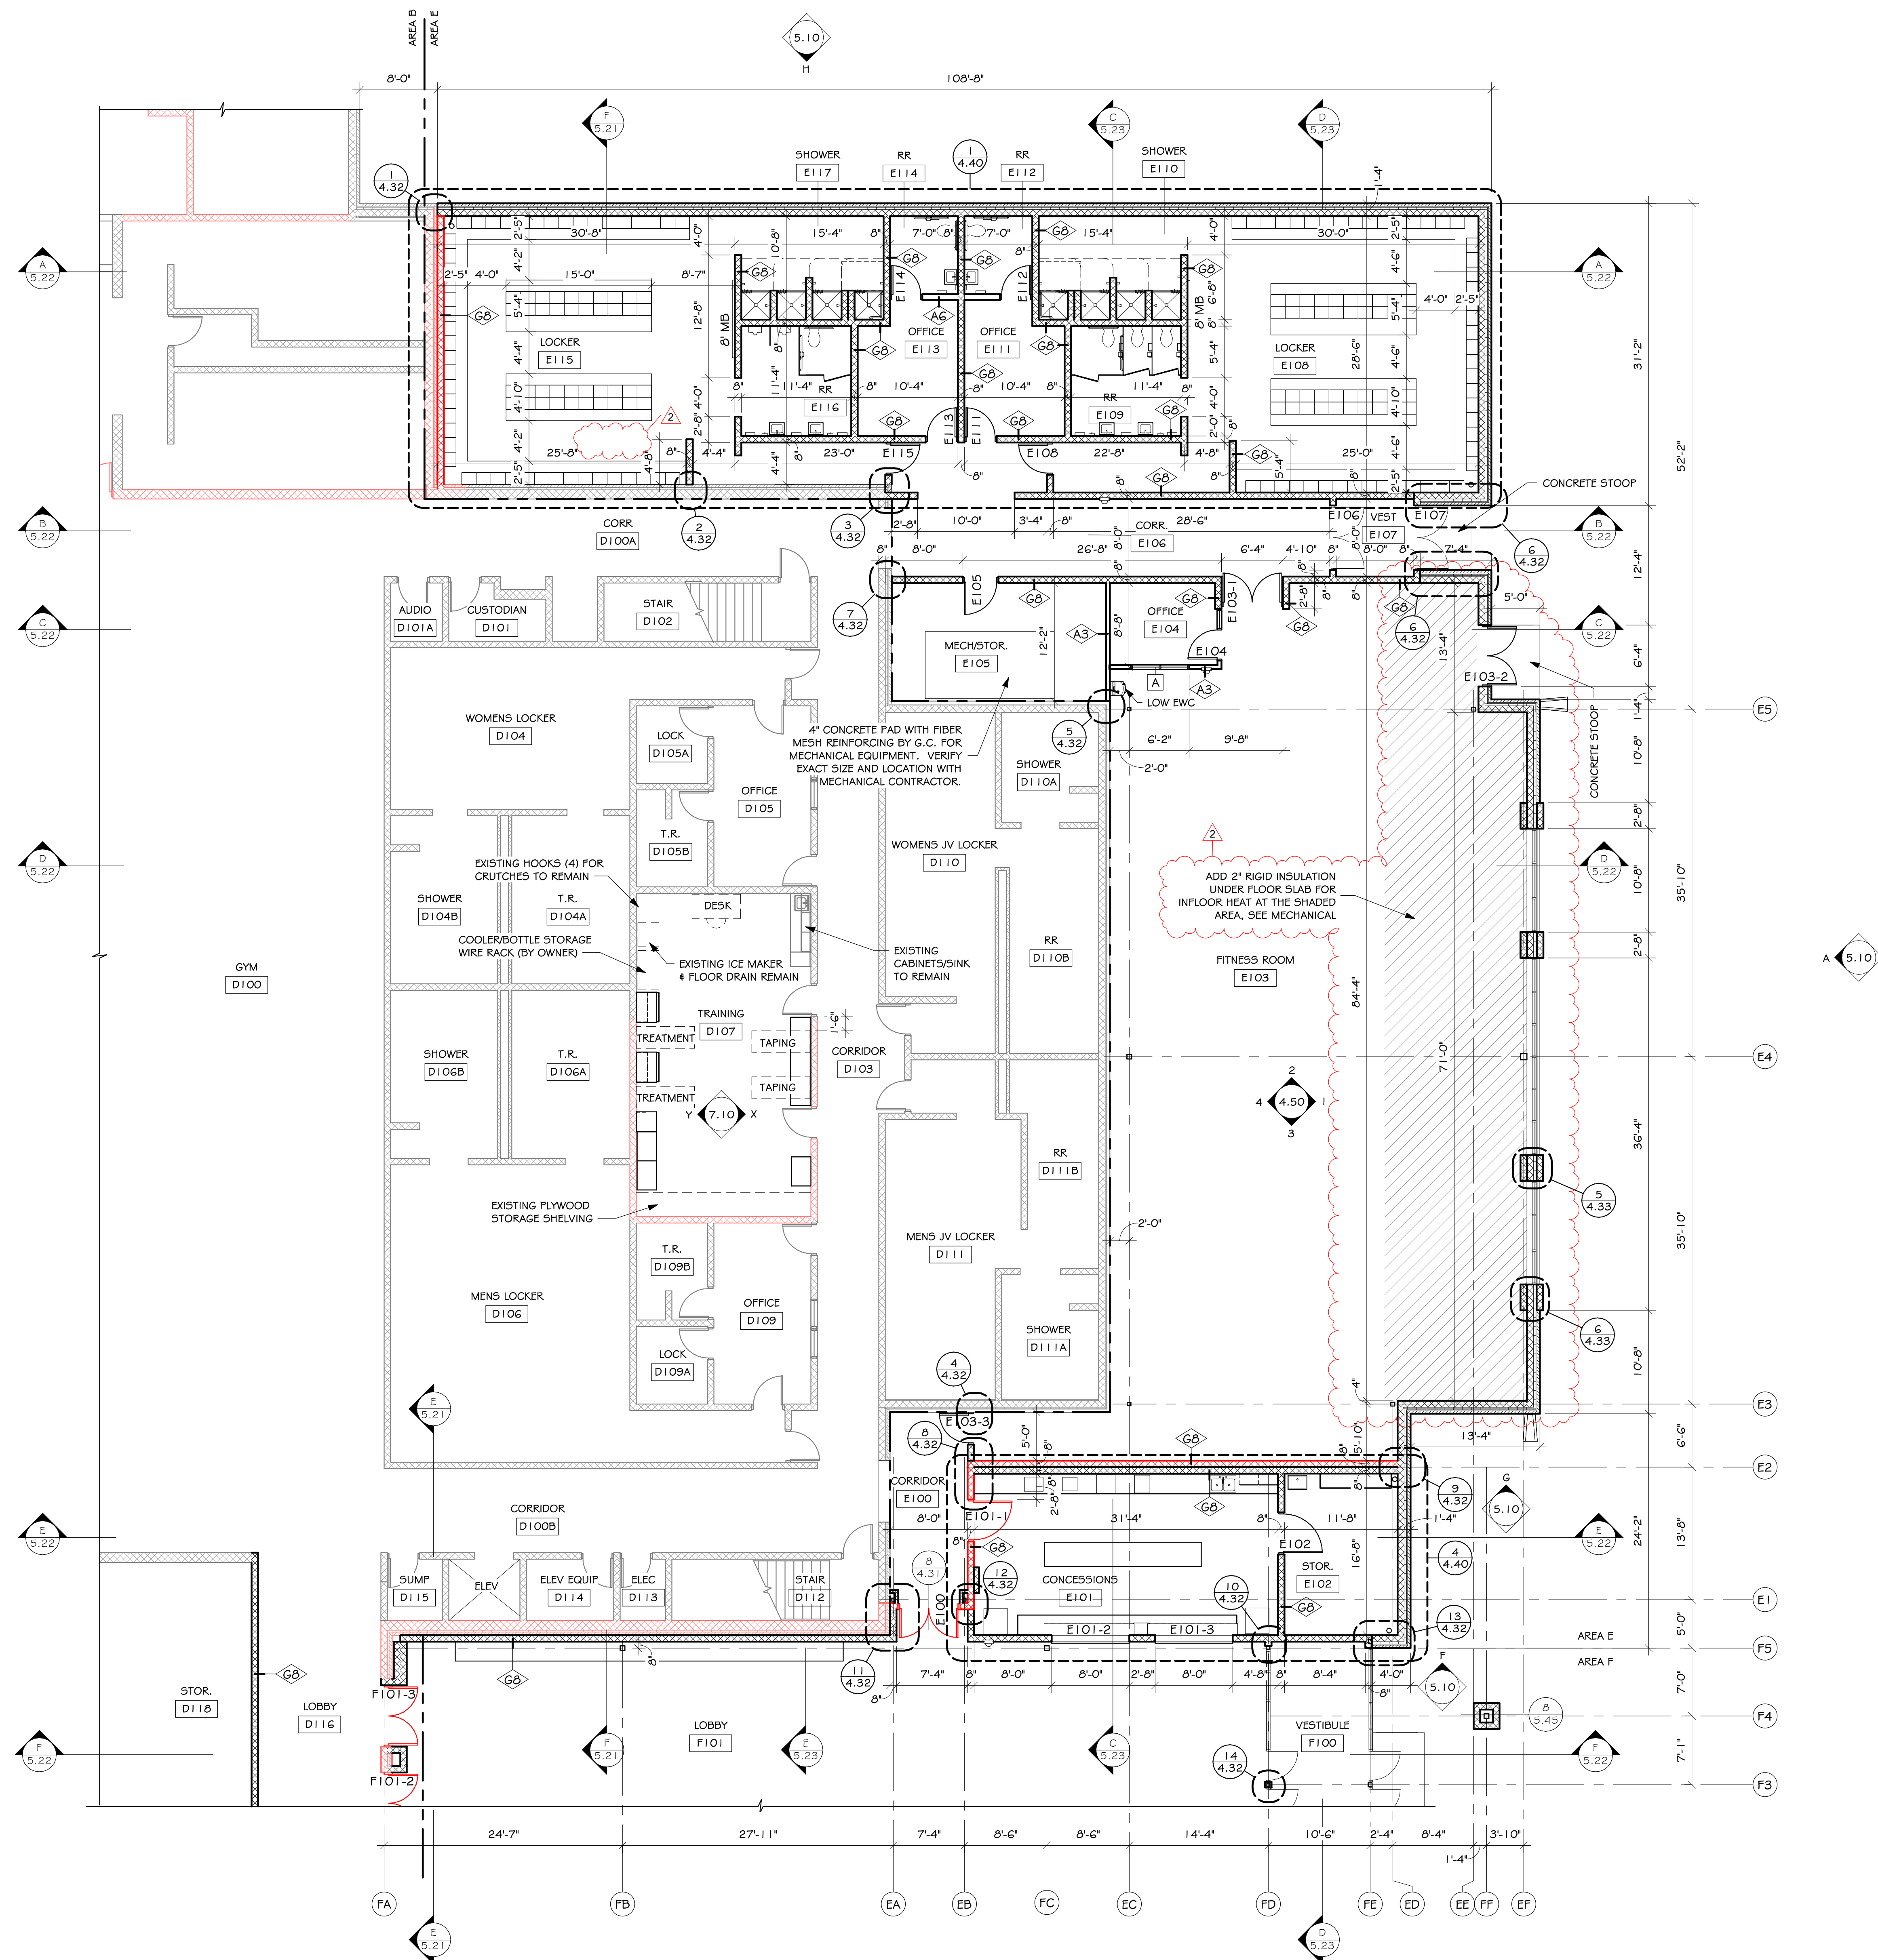

## FLOOR PLAN - AREA E


SCALE: 1/8" = 1'-0"

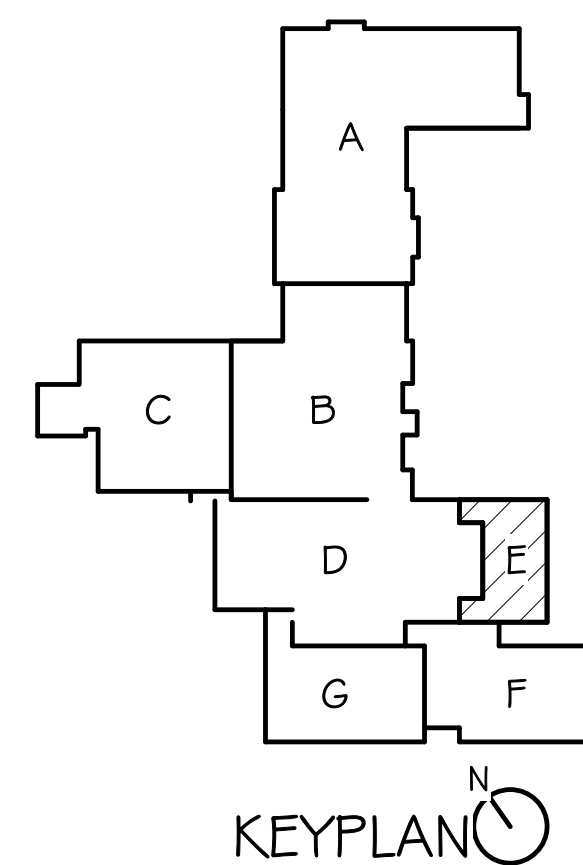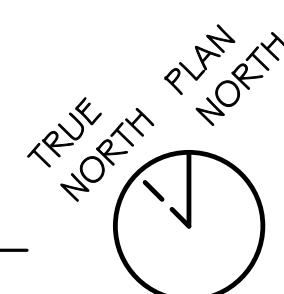

KEY PLAN

### GENERAL NOTES- FLOOR PLAN


- GENERAL CONTRACTOR TO VERIFY ALL EXISTING CONDITIONS AND DIMENSIONS AT THE JOB SITE. REPORT DISCREPANCIES TO THE ARCHITECT.
- SEE MECHANICAL AND ELECTRICAL DRAWINGS FOR ADDITIONAL INFORMATION.
- GENERAL CONTRACTOR RESPONSIBLE FOR PROTECTION OF ALL INTERIOR FINISHES AND EQUIPMENT THAT ARE TO REMAIN.
- SEE SHEET 1.10 FOR WALL TYPES.
- REFER TO FINISH PLANS FOR BURNISHED BLOCK LOCATIONS.

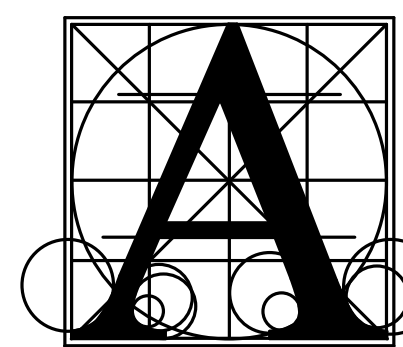

### Architecture Incorporated

415 South Main Avenue  
P.O. Box 2140  
Sioux Falls, South Dakota 57101  
Phone: (605) 339-1711

815 St. Joseph Street, Suite 203  
Rapid City, South Dakota 57701  
Phone: (605) 721-1158

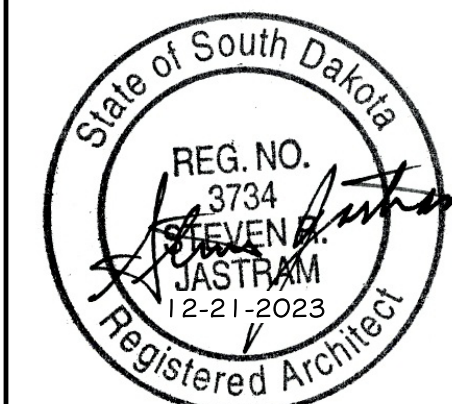

## LENNOX HIGH SCHOOL ADDITION

### FLOOR PLAN - AREA E

Project

number 0215.2902.22

date DECEMBER 21, 2023

revision

drawn SWP checked SRJ


DATE DESCRIPTION

1/18/2024 ADDENDUM #2

# 4.10-E




1/18/2024 5:17:36 PM

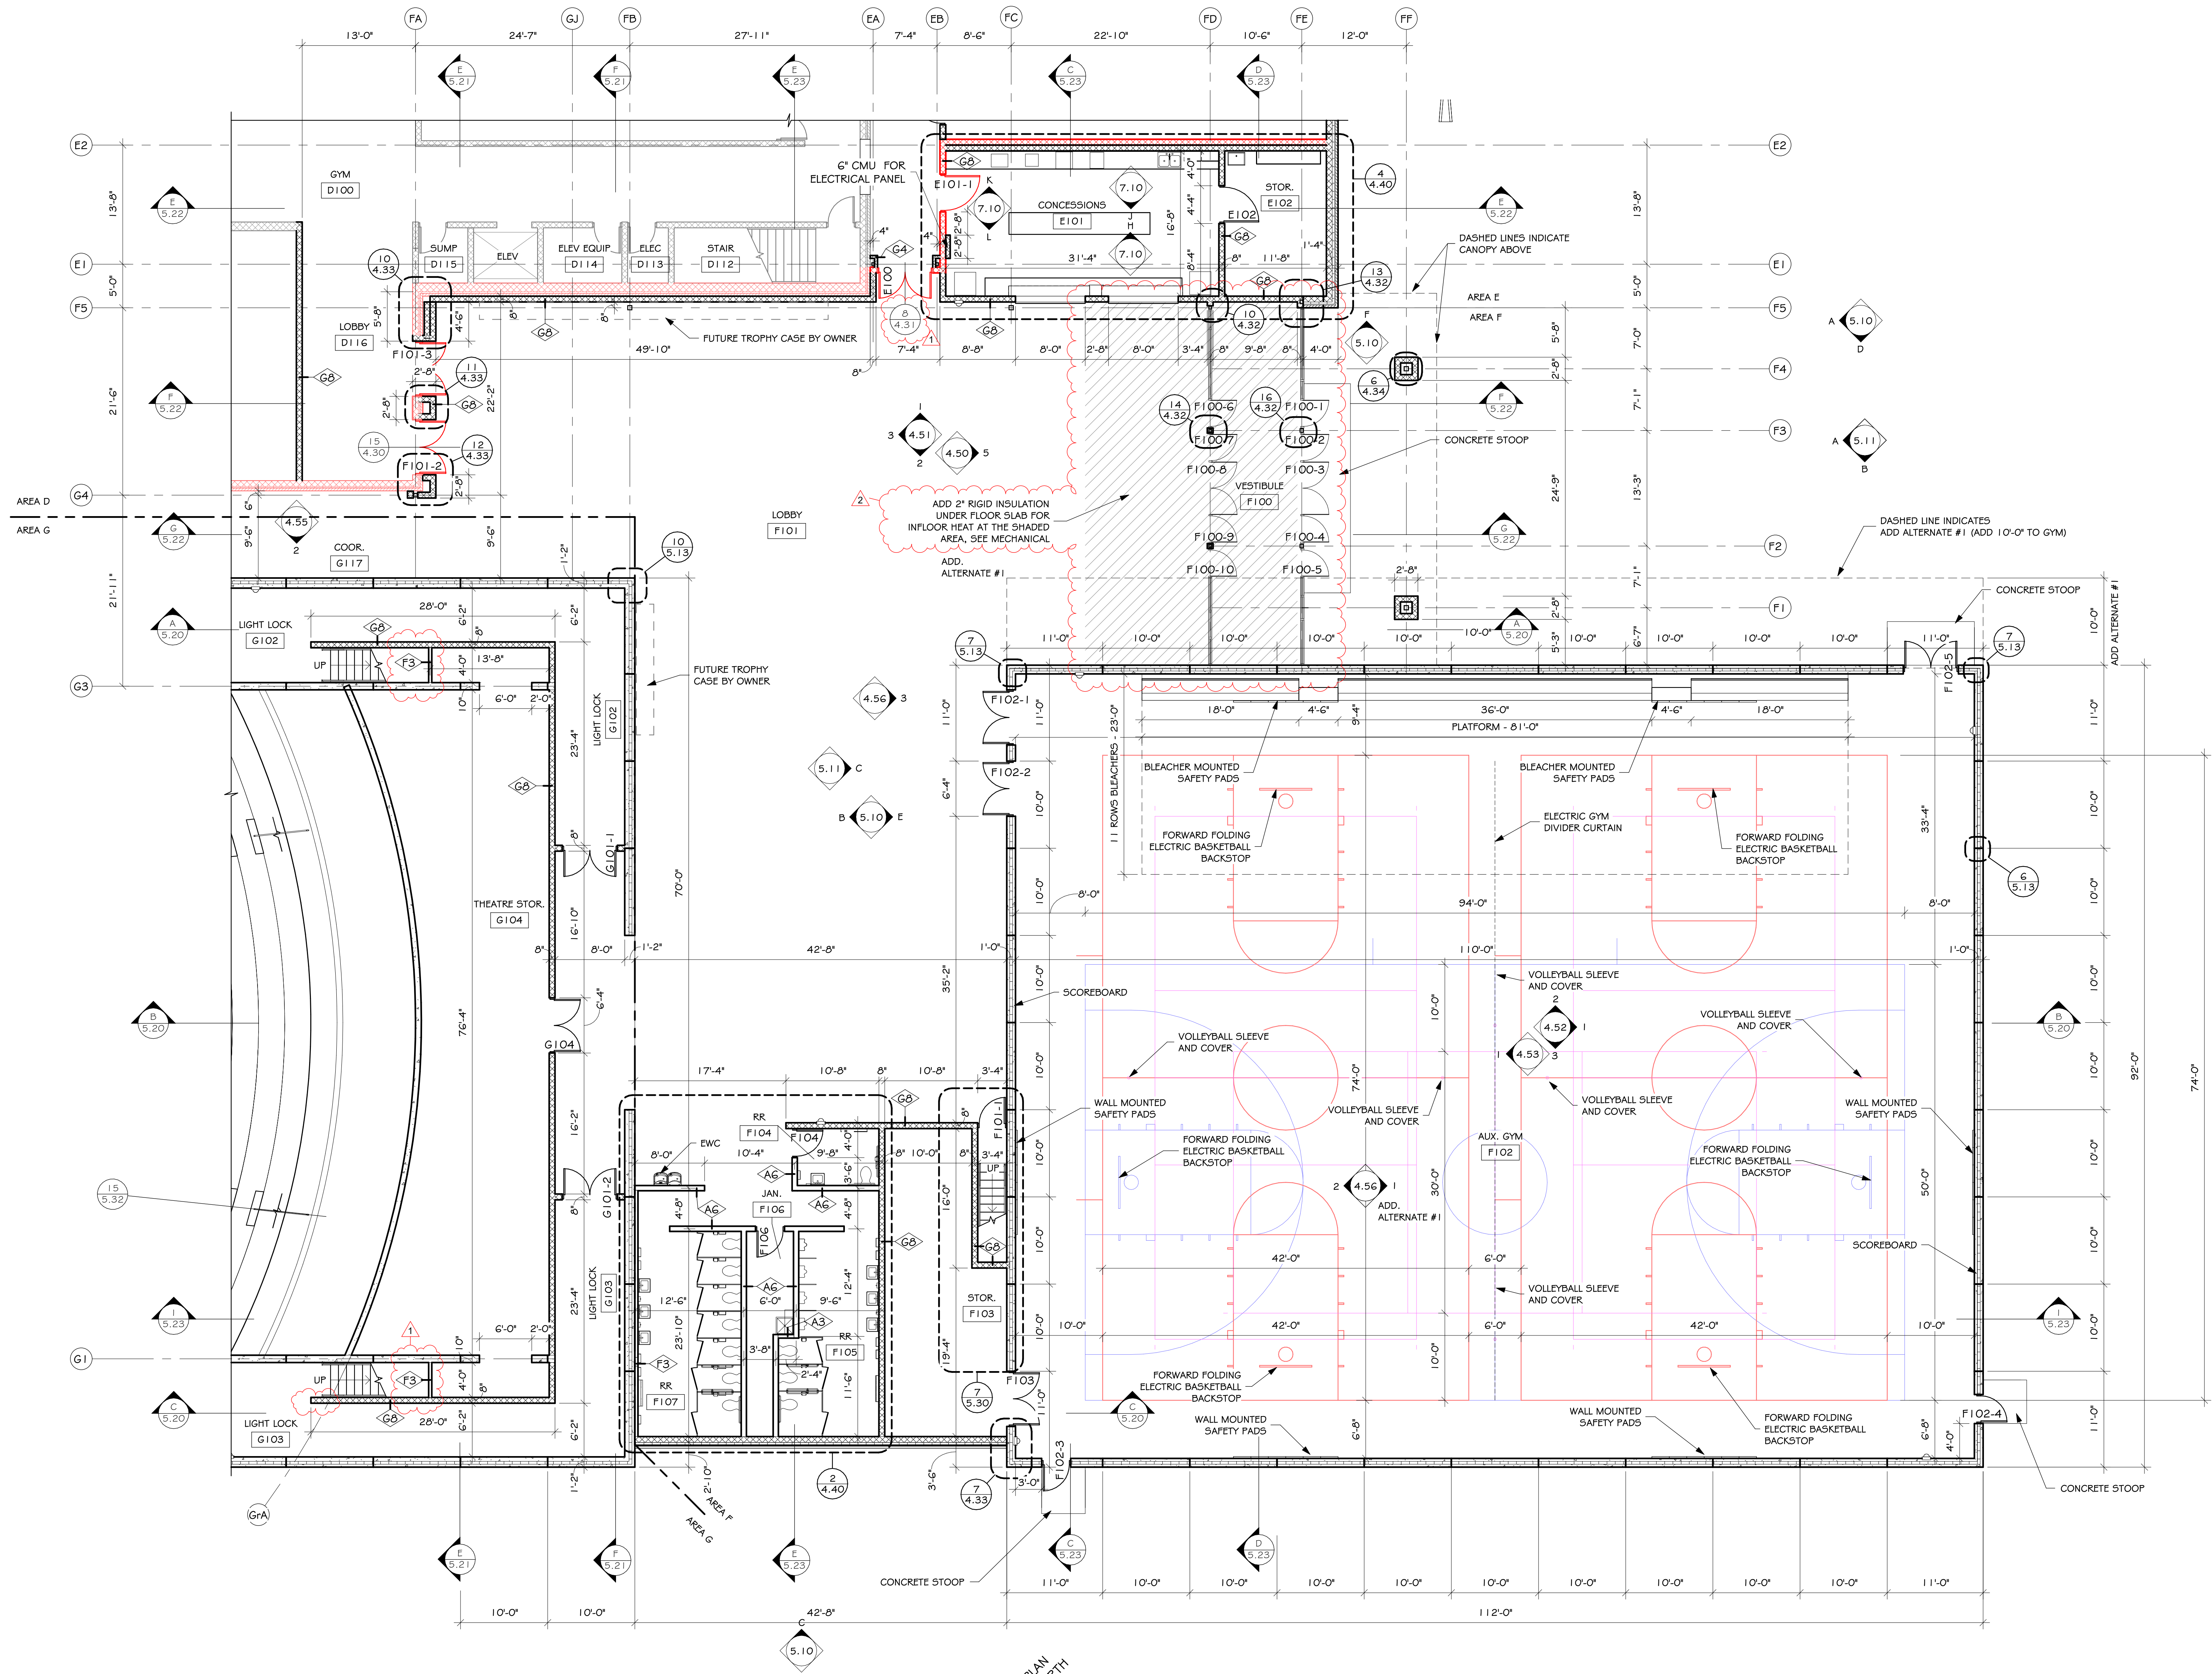


# FLOOR PLAN - AREA F - BASE BID

SCALE: 1/8" = 1'-0"

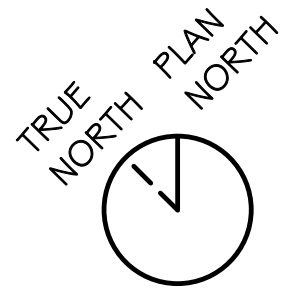

## GENERAL NOTES- FLOOR PLAN


- A. GENERAL CONTRACTOR TO VERIFY ALL EXISTING CONDITIONS AND DIMENSIONS AT THE JOB SITE. REPORT DISCREPANCIES TO THE ARCHITECT.
- B. SEE MECHANICAL AND ELECTRICAL DRAWINGS FOR ADDITIONAL INFORMATION.
- C. GENERAL CONTRACTOR RESPONSIBLE FOR PROTECTION OF ALL INTERIOR FINISHES AND EQUIPMENT THAT ARE TO REMAIN.
- D. SEE SHEET 1.10 FOR WALL TYPES.
- E. REFER TO FINISH PLANS FOR BURNISHED BLOCK LOCATIONS.

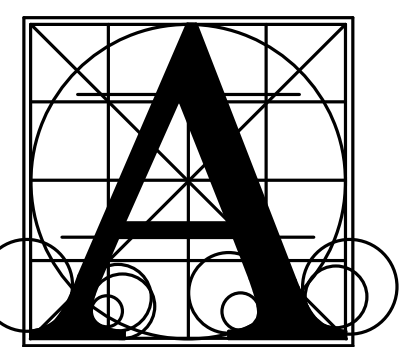

## Architecture Incorporated

415 South Main Avenue  
P.O. Box 2140  
Sioux Falls, South Dakota 57101  
Phone: (605) 339-1711

815 St Joseph Street, Suite 203  
Rapid City, South Dakota 57701  
Phone: (605) 721-1158

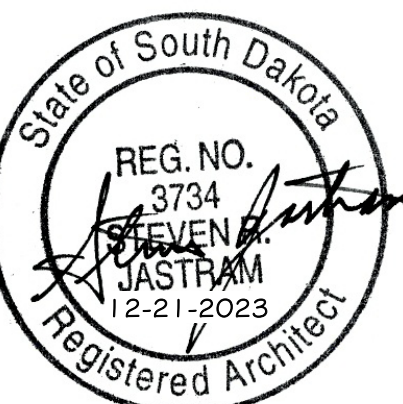

## LENNOX HIGH SCHOOL ADDITION

### FLOOR PLAN - AREA F - BASE BID


Project	number	0215.2902.22
	date	DECEMBER 21, 2023
	revision	
	drawn	SWP
	checked	SRJ

DATE	DESCRIPTION
1/11/2024	ADDENDUM #1
1/18/2024	ADDENDUM #2

# 4.10-F





1/18/2024 5:17:40 PM

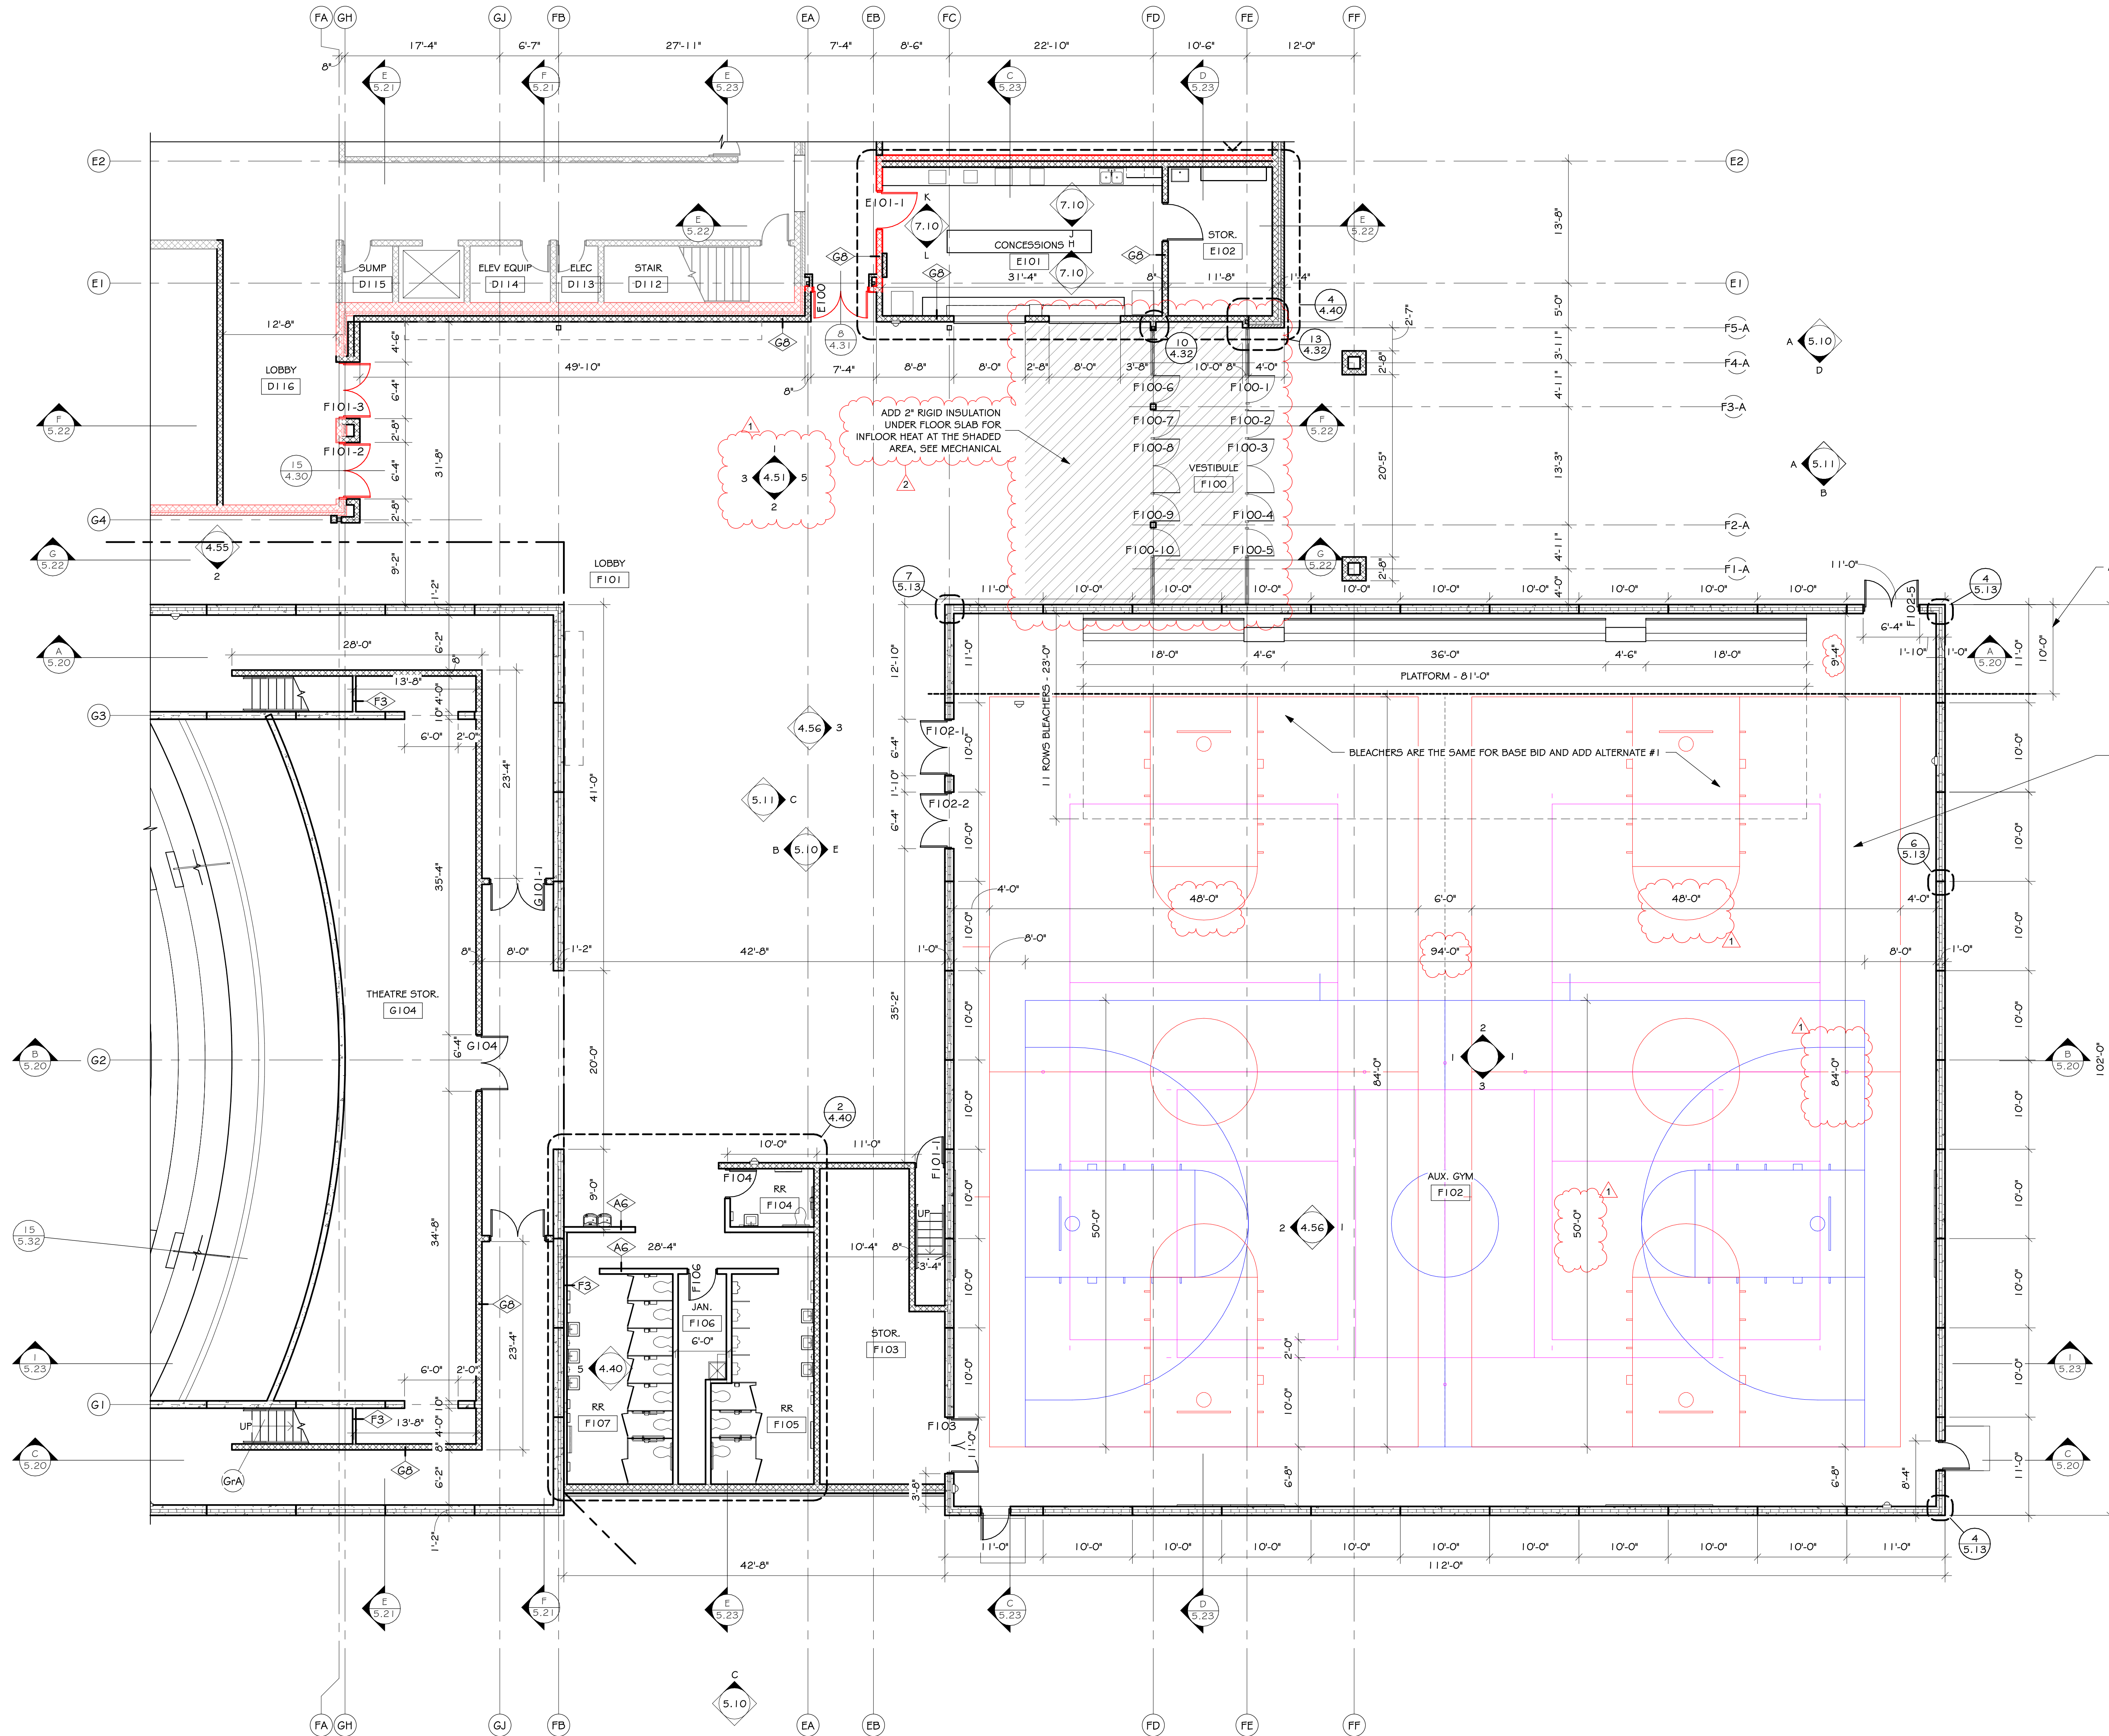

FLOOR PLAN - AREA F (ADD ALTERNATE #1)


SCALE: 1/8" = 1'-0"

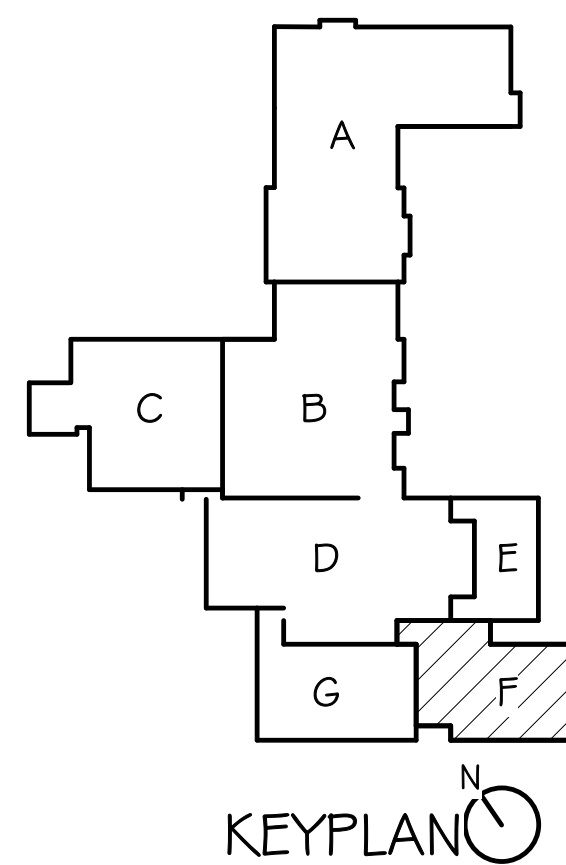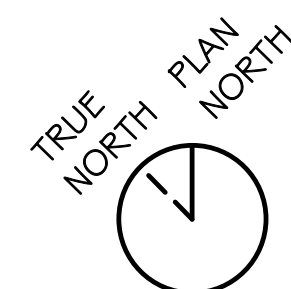

KEY PLAN

GENERAL NOTES- FLOOR PLAN

- GENERAL CONTRACTOR TO VERIFY ALL EXISTING CONDITIONS AND DIMENSIONS AT THE JOB SITE. REPORT DISCREPANCIES TO THE ARCHITECT.
- SEE MECHANICAL AND ELECTRICAL DRAWINGS FOR ADDITIONAL INFORMATION.
- GENERAL CONTRACTOR RESPONSIBLE FOR PROTECTION OF ALL INTERIOR FINISHES AND EQUIPMENT THAT ARE TO REMAIN.
- SEE SHEET 1.10 FOR WALL TYPES.
- REFER TO FINISH PLANS FOR BURNISHED BLOCK LOCATIONS.

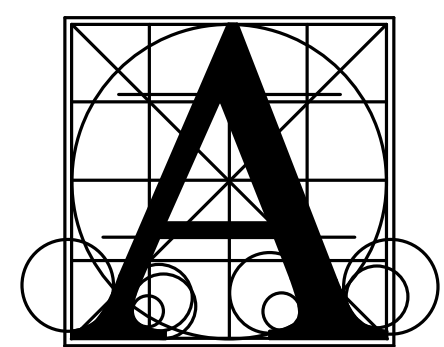

Architecture Incorporated

415 South Main Avenue  
P.O. Box 2140  
Sioux Falls, South Dakota 57101  
Phone: (605) 339-1711

815 St. Joseph Street, Suite 203  
Rapid City, South Dakota 57701  
Phone: (605) 721-1158



LENNOX HIGH SCHOOL ADDITION

FLOOR PLAN - AREA F - ADD ALTERNATE


Project

number 0215.2982.22  
date DECEMBER 21, 2023  
revision  
drawn SWP checked SRJ


DATE	DESCRIPTION
1/11/2024	ADDENDUM #1
1/18/2024	ADDENDUM #2

4.10-F-A




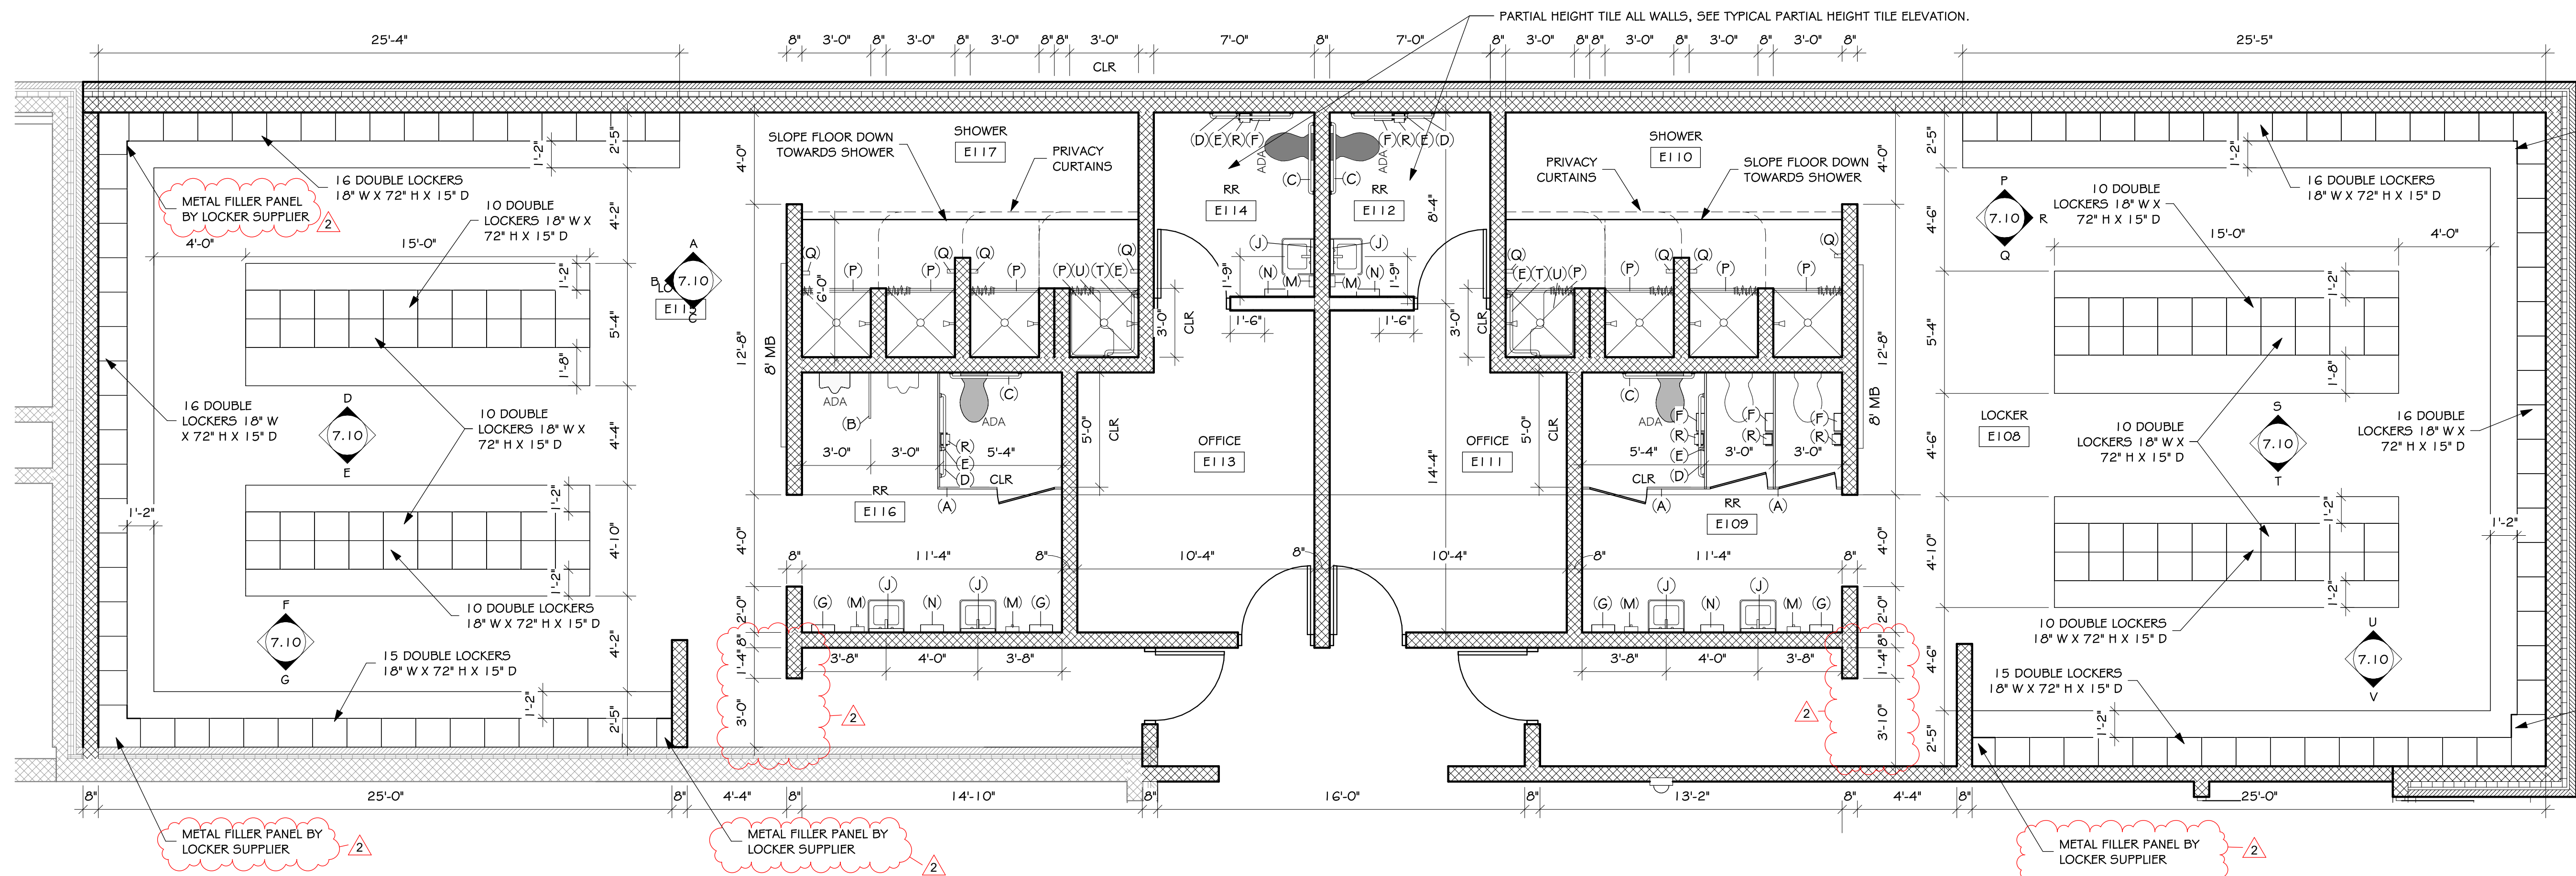


1  
4.40 FLOOR PLAN AREA E - LOCKER ROOMS  
SCALE: 1/4" = 1'-0"

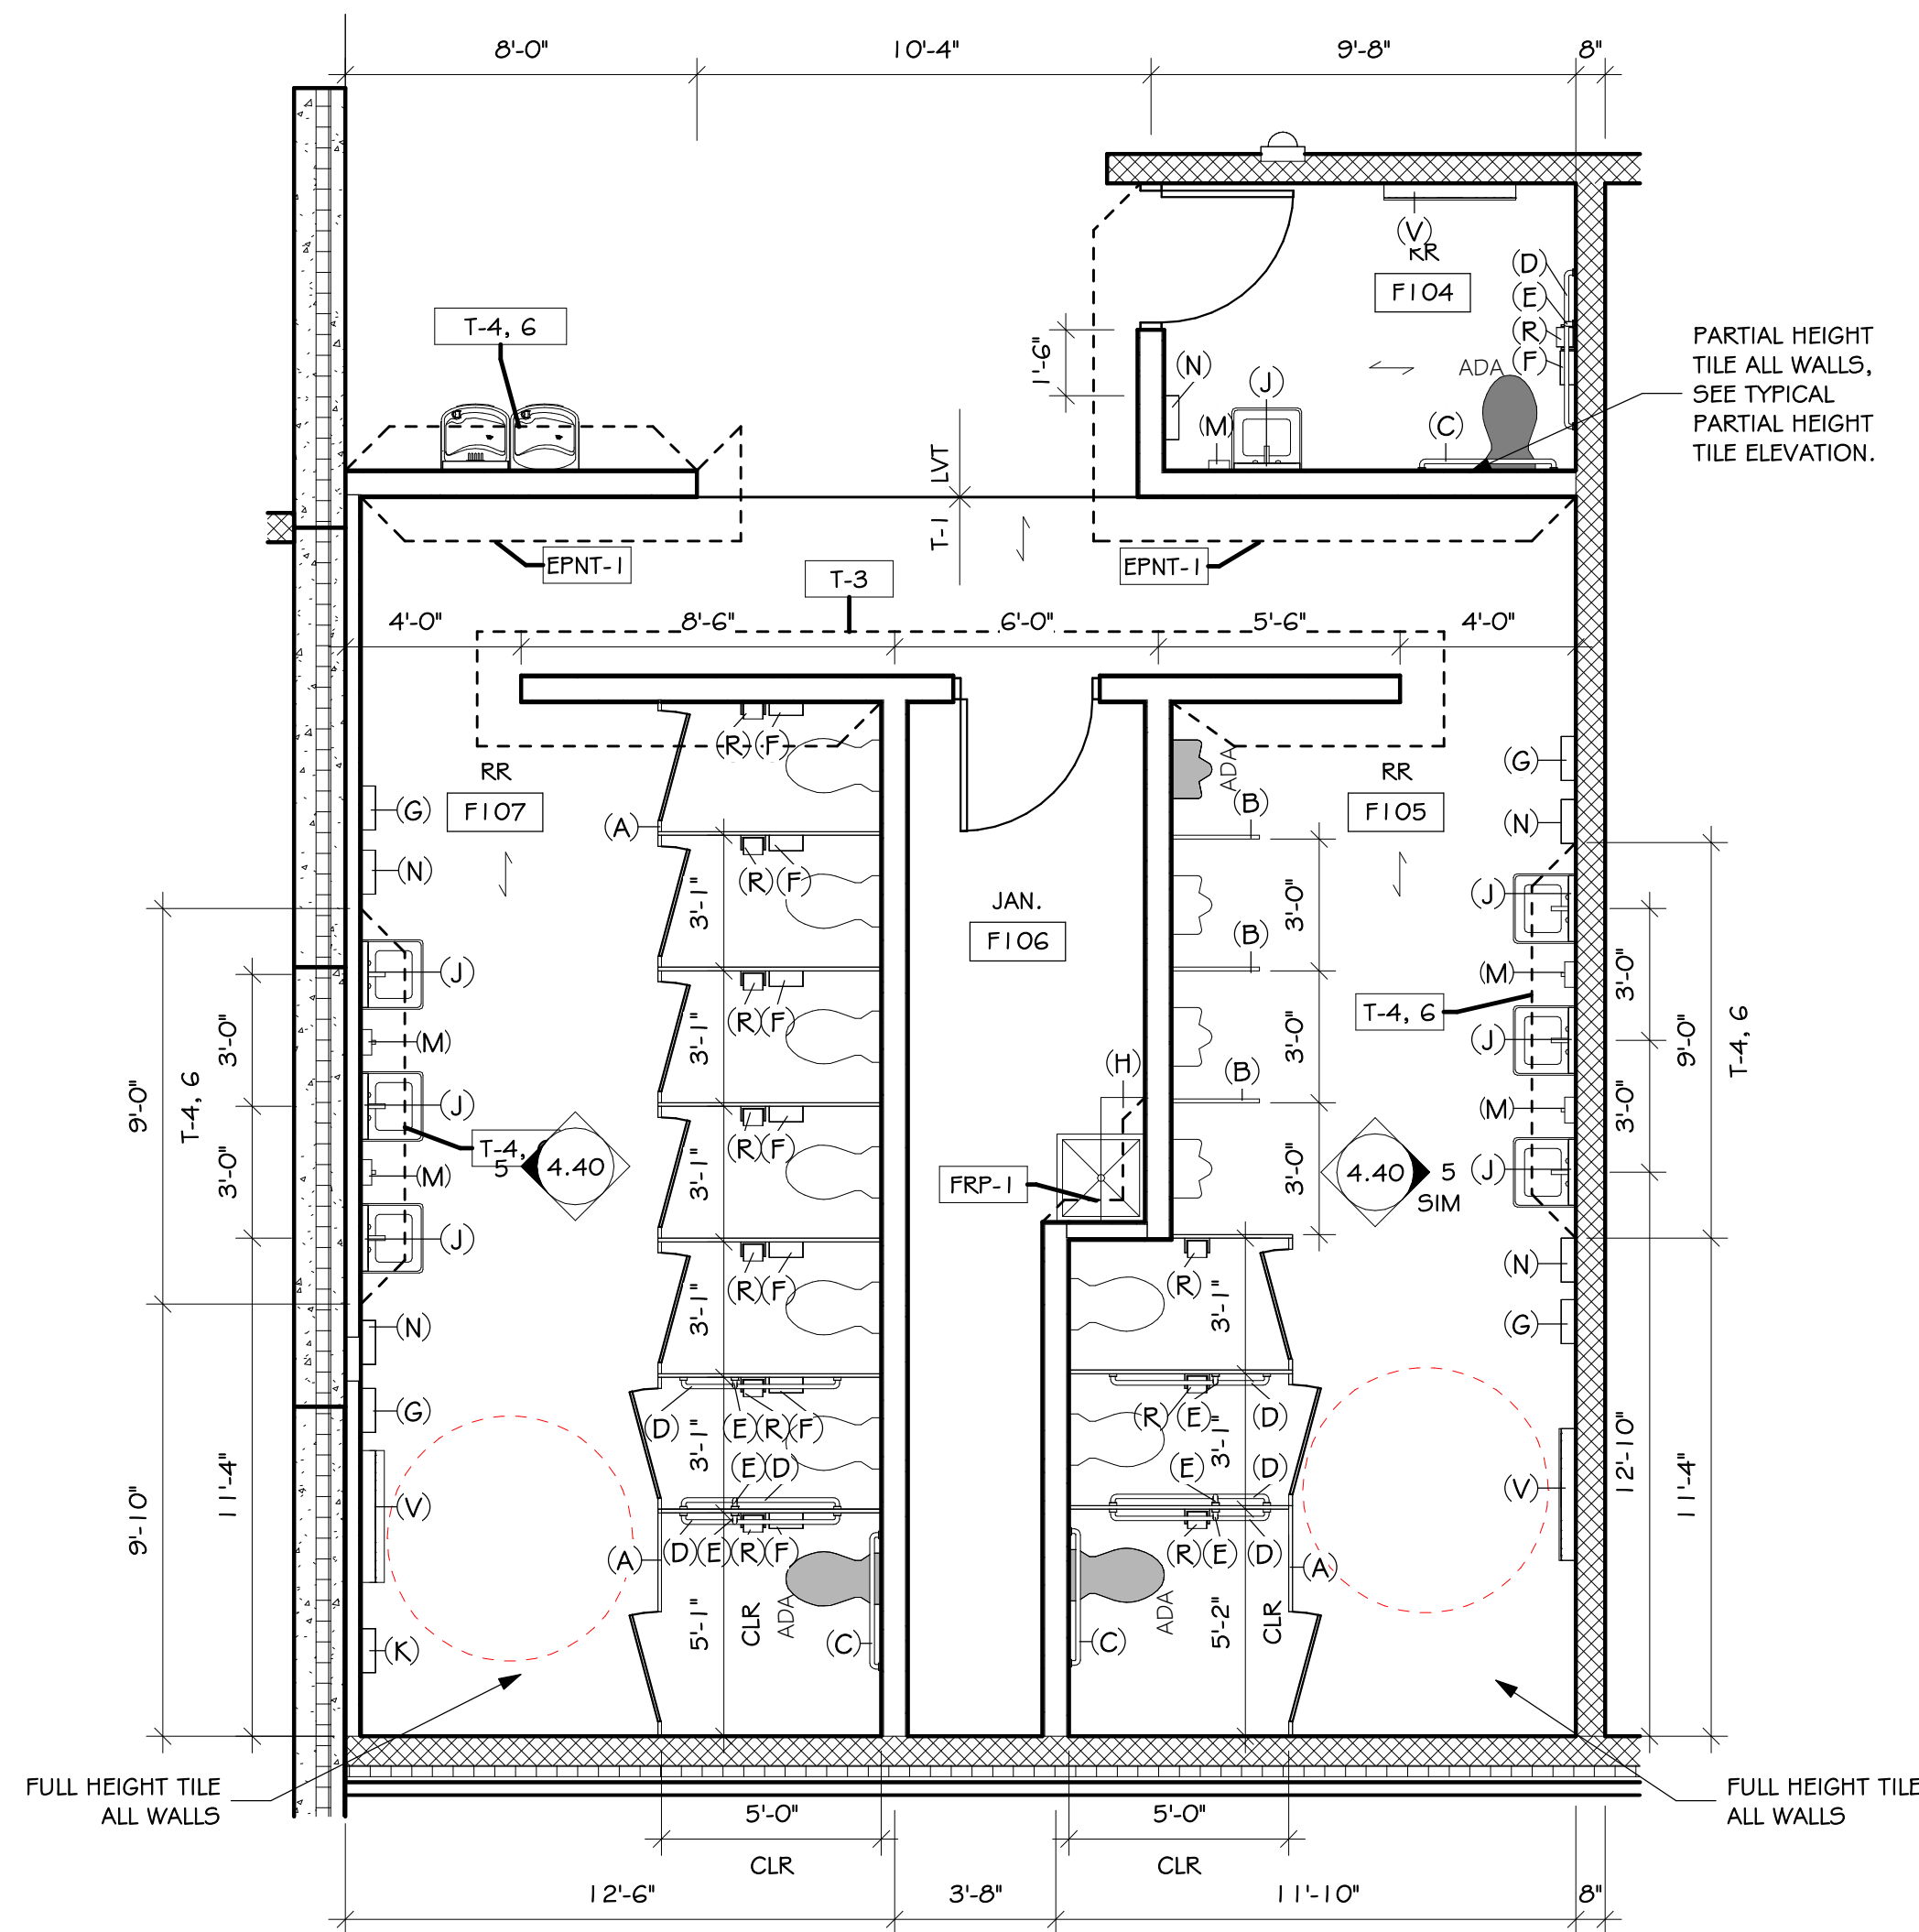


2  
4.40 ENLARGED F104, F105 & F107  
SCALE: 1/4" = 1'-0"

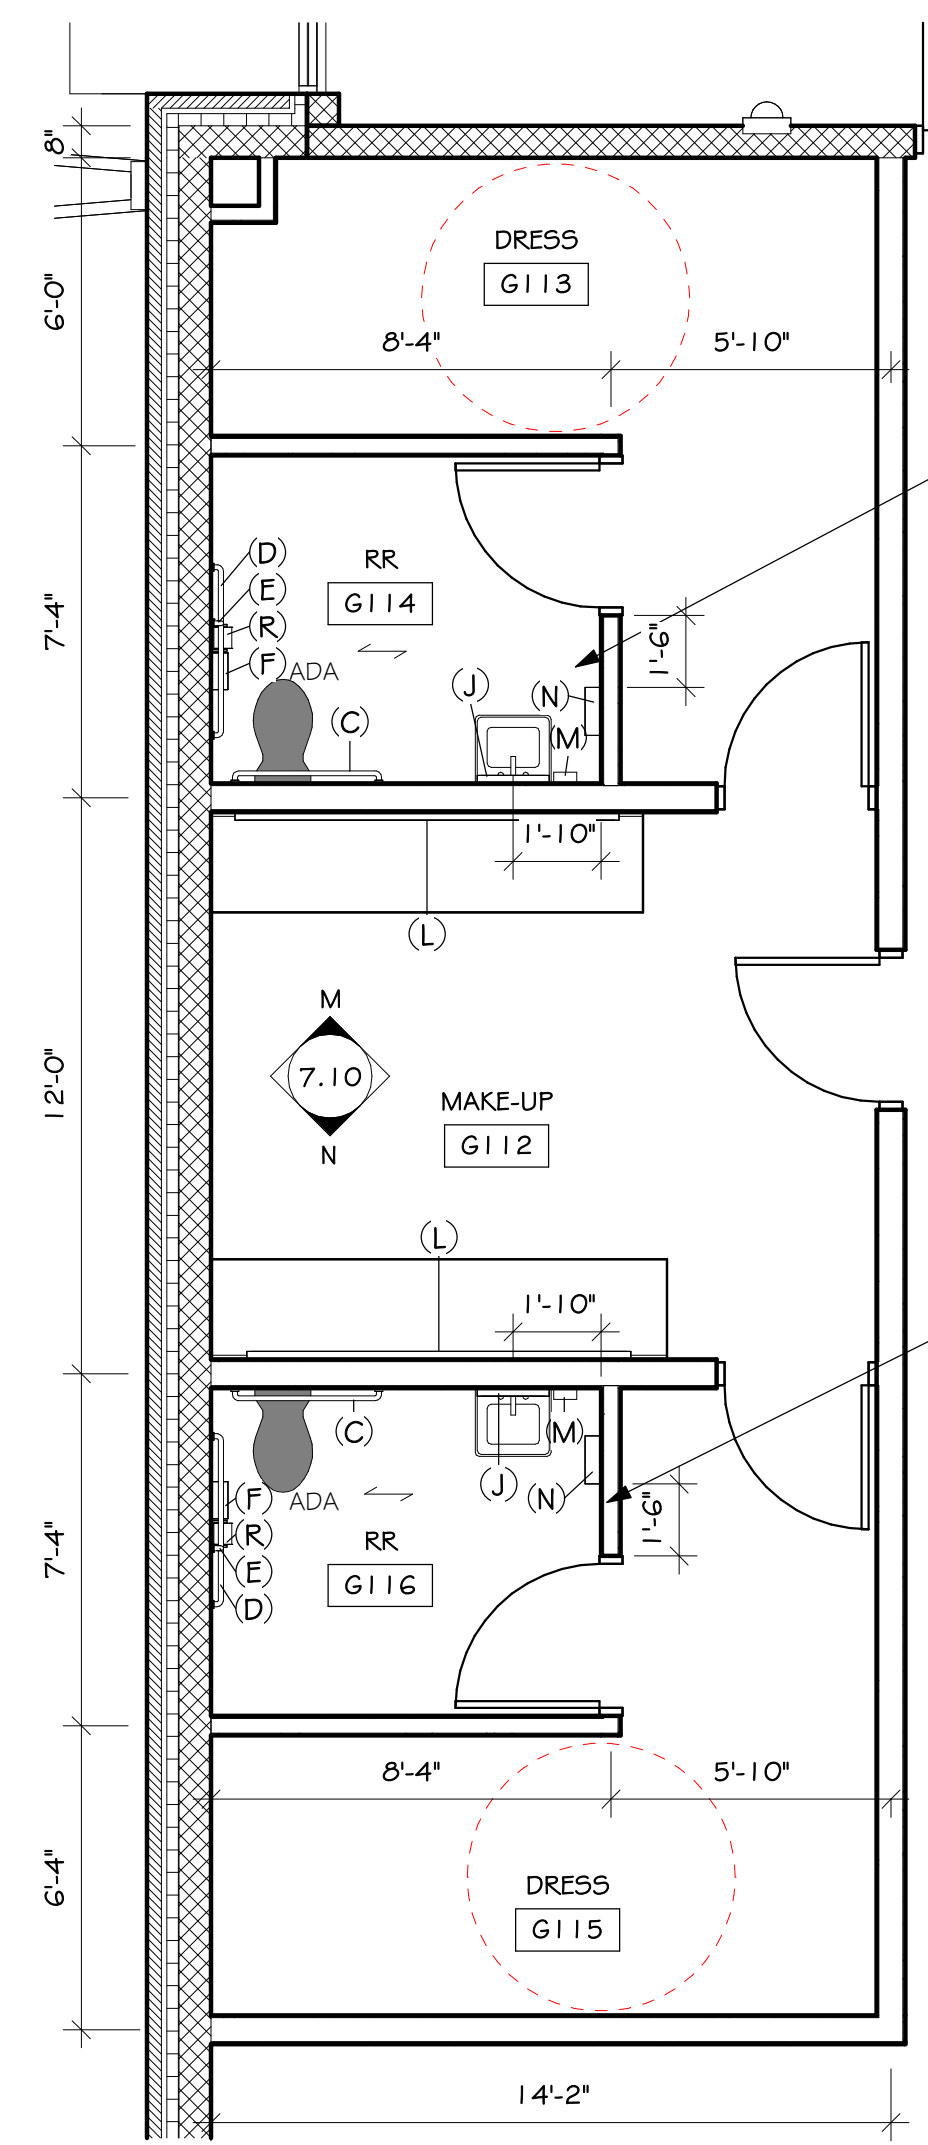


3  
4.40 ENLARGED DRESSING ROOMS  
SCALE: 1/4" = 1'-0"

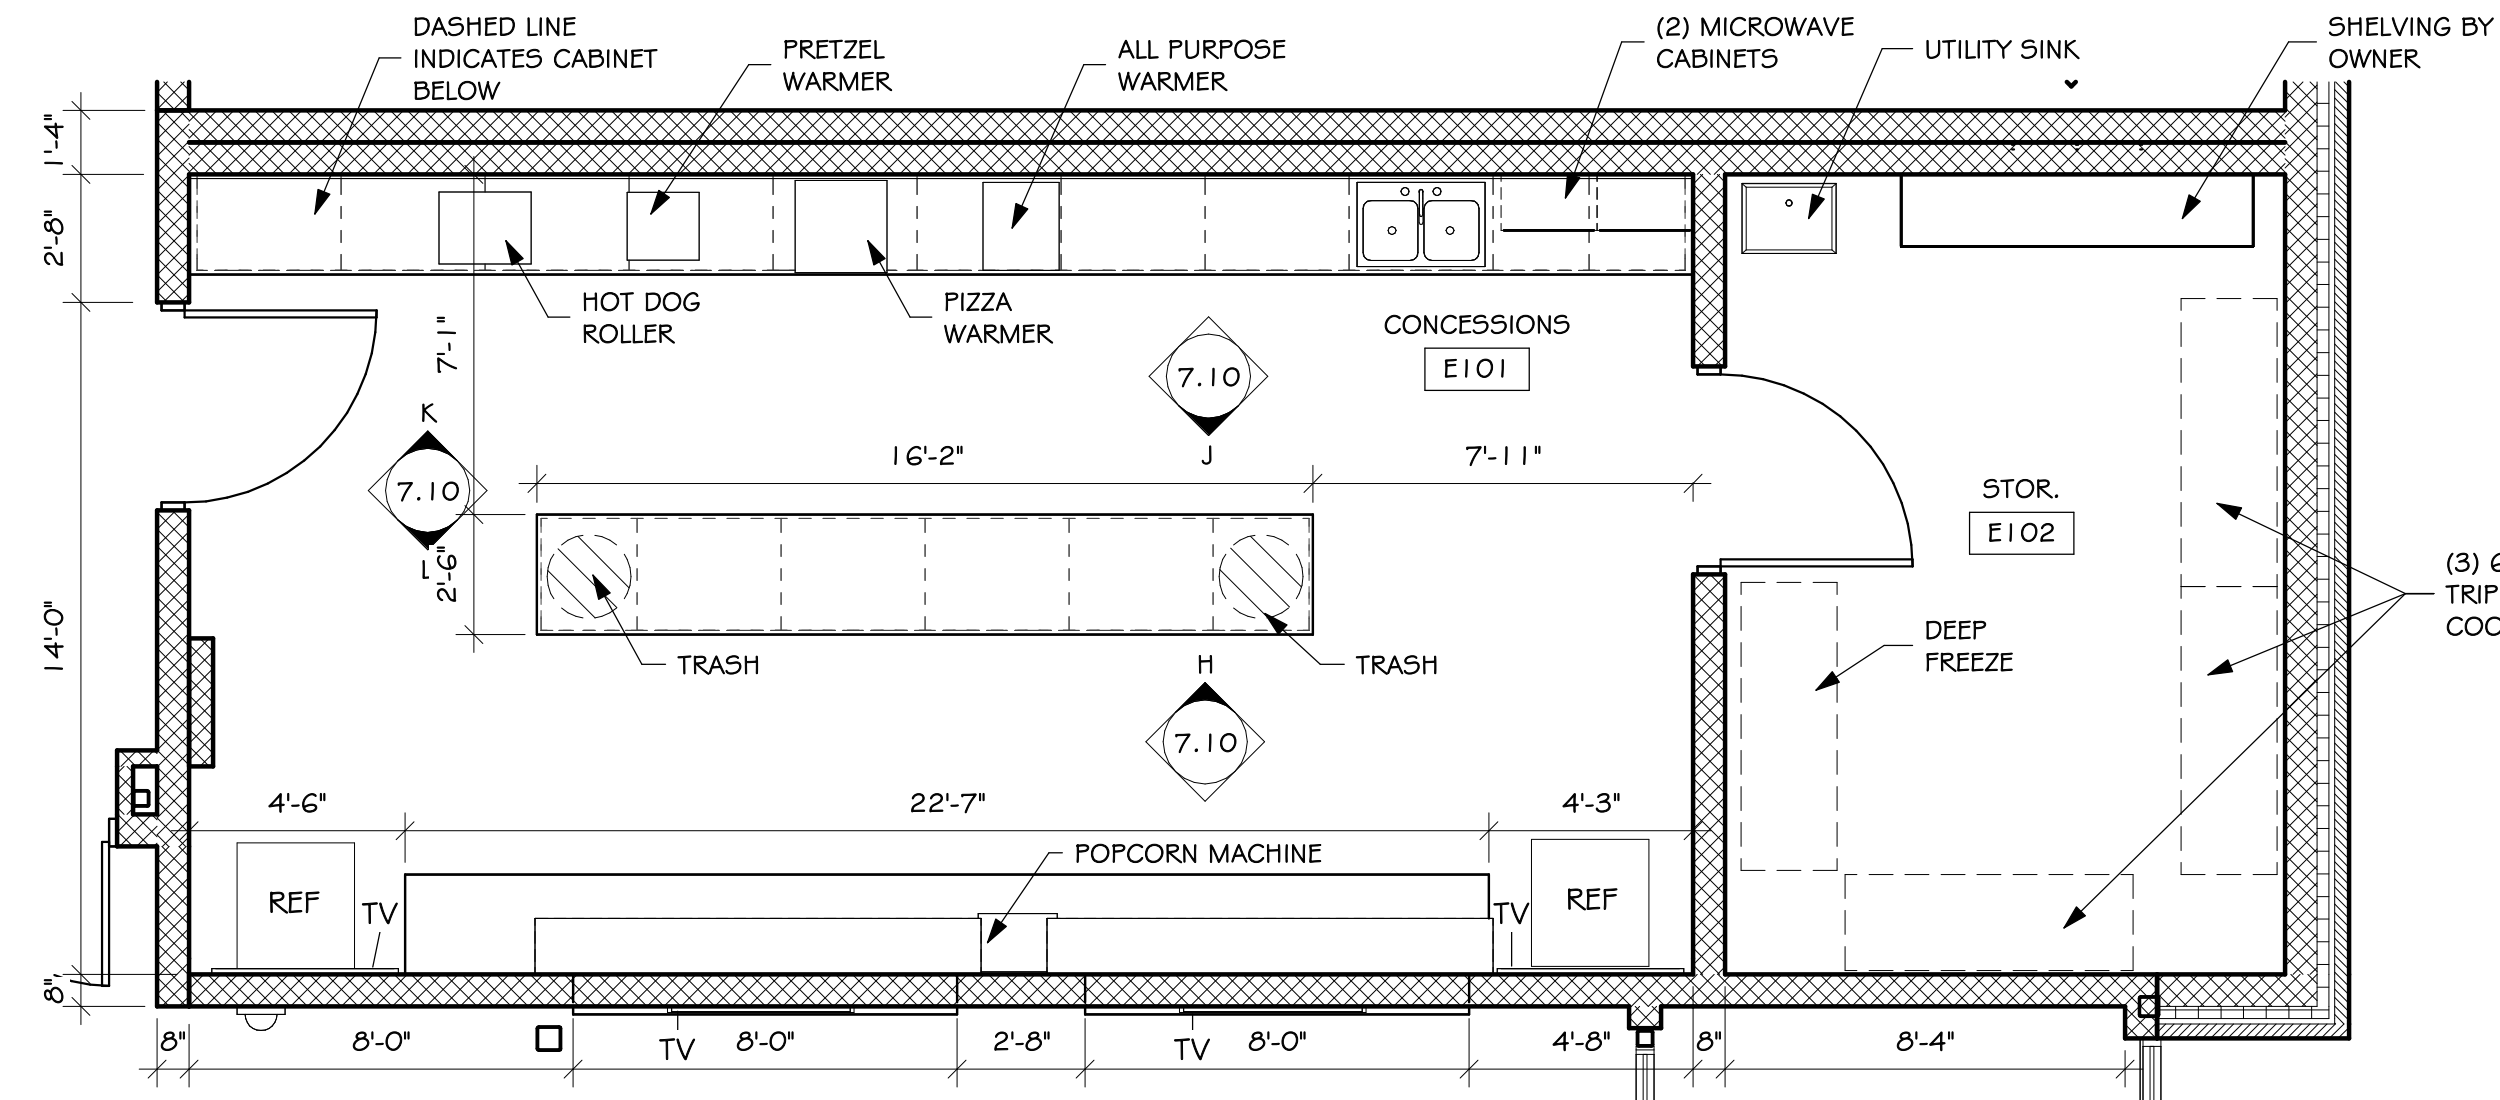

4  
4.40 ENLARGED CONCESSIONS  
SCALE: 1/4" = 1'-0"

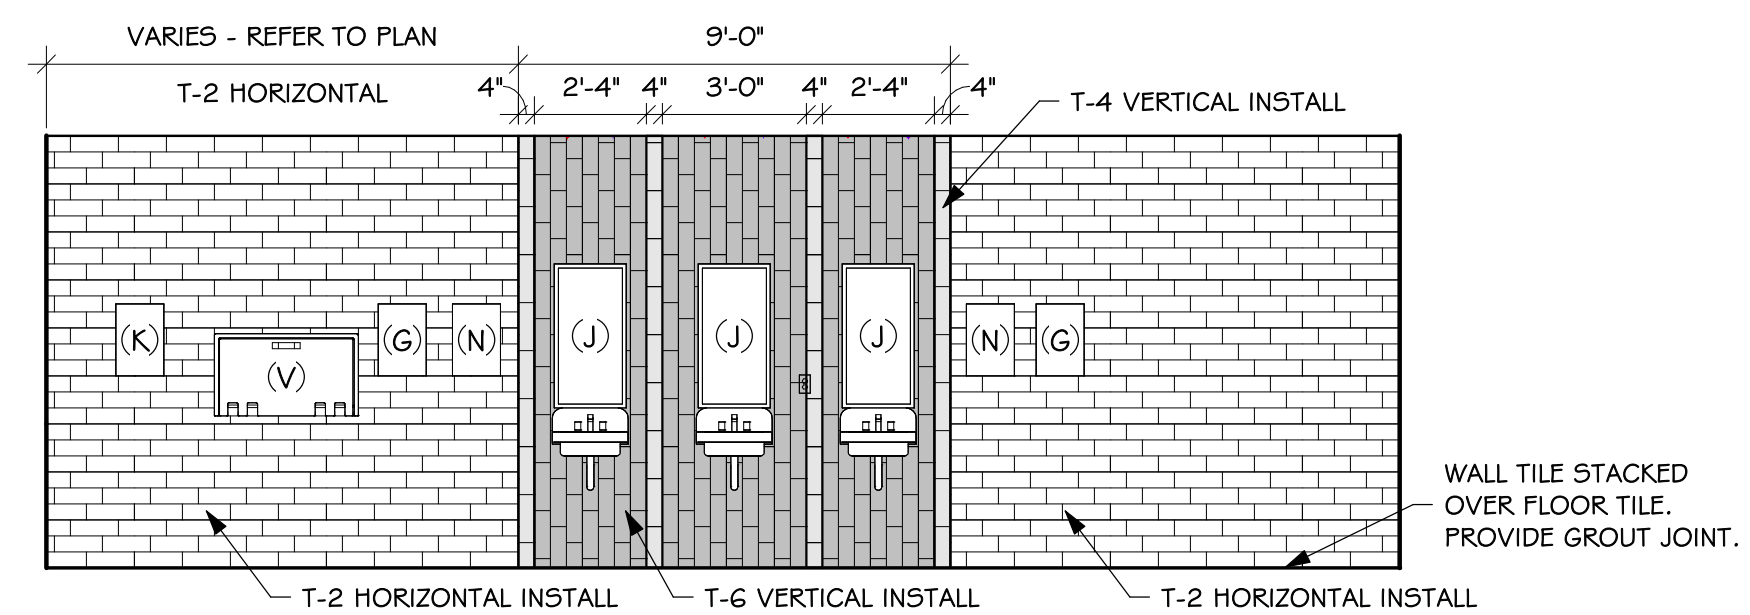

5  
4.40 TYP. FULL HEIGHT RESTROOM TILE  
SCALE: 1/4" = 1'-0"

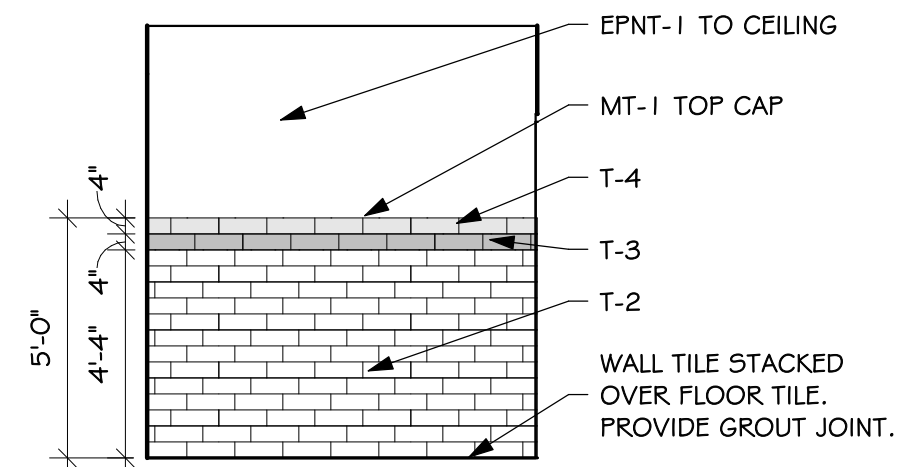


6  
4.40 TYP. PARTIAL HEIGHT TILE  
SCALE: 1/4" = 1'-0"

TOILET/BATH ACCESSORIES SCHEDULE		
MARK	ACCESSORY	NOTES
A	FLOOR MOUNTED O.H. BRACED TOILET PARTITIONS	1, 4
B	URINAL SCREEN	1, 4
C	1 1/2" O.D. GRAB BAR 36" LONG	1, 4
D	1 1/2" O.D. GRAB BAR 42" LONG	1, 4
E	1 1/2" O.D. GRAB BAR 18" LONG	1, 4, 5
F	SANITARY NAPKIN DISPOSAL	1, 4
G	ELECTRIC HAND DRYER	1, 4, 7
H	MOP & BROOM HOLDER/SHELF	1, 4
J	1'-6" W X 3'-0" H FRAMED MIRROR	1, 4
K	SANITARY NAPKIN DISPENSER	1, 2
L	8'-0" W X 4'-0" H FRAMED MIRROR	1, 6
M	SOAP DISPENSER	1, 3
N	PAPER TOWEL DISPENSER	1, 2
P	SHOWER CURTAIN WITH STAINLESS STEEL ROD	1, 4
Q	CLOTHES HOOK	1, 4
R	TOILET PAPER DISPENSER	1, 3
T	SHOWER GRAB BAR	1, 4
U	SOLID PHENOLIC FOLDING SHOWER SEAT	1, 4
V	BABYCHANGING STATION	1, 4

ACCESSORY NOTES	
1.	SURFACE MOUNTED
2.	OWNER PROVIDED, OWNER INSTALLED
3.	OWNER PROVIDED, CONTRACTOR INSTALLED
4.	CONTRACTOR PROVIDED, CONTRACTOR INSTALLED
5.	MOUNT VERTICALLY
6.	REFER TO MANUFACTURER'S INSTALLATION INSTRUCTIONS
7.	SEE ELECTRICAL SPECIFICATION

ACCESSORY SYMBOLS	
(A)	ACCESSORY SYMBOL

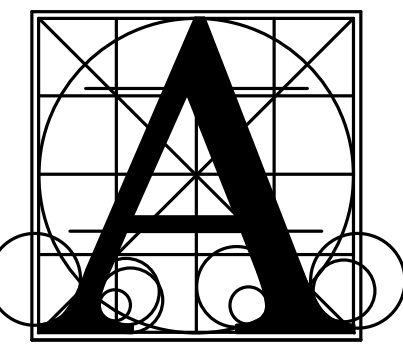

Architecture  
Incorporated  
415 South Main Avenue  
P.O. Box 2140  
Sioux Falls, South Dakota 57101  
Phone: (605) 339-1711

815 St Joseph Street, Suite 203  
Rapid City, South Dakota 57701  
Phone: (605) 721-1158



LENNOX HIGH SCHOOL ADDITION


ENLARGED PLANS - RESTROOM, LOCKER ROOM & CONCESSIONS

number	0215.2902.22
date	DECEMBER 21, 2023
revision	
drawn	BJO
checked	SRJ

DATE	DESCRIPTION
1/1/8/2024	ADDENDUM #2




1/10/2024 4:23:47 PM

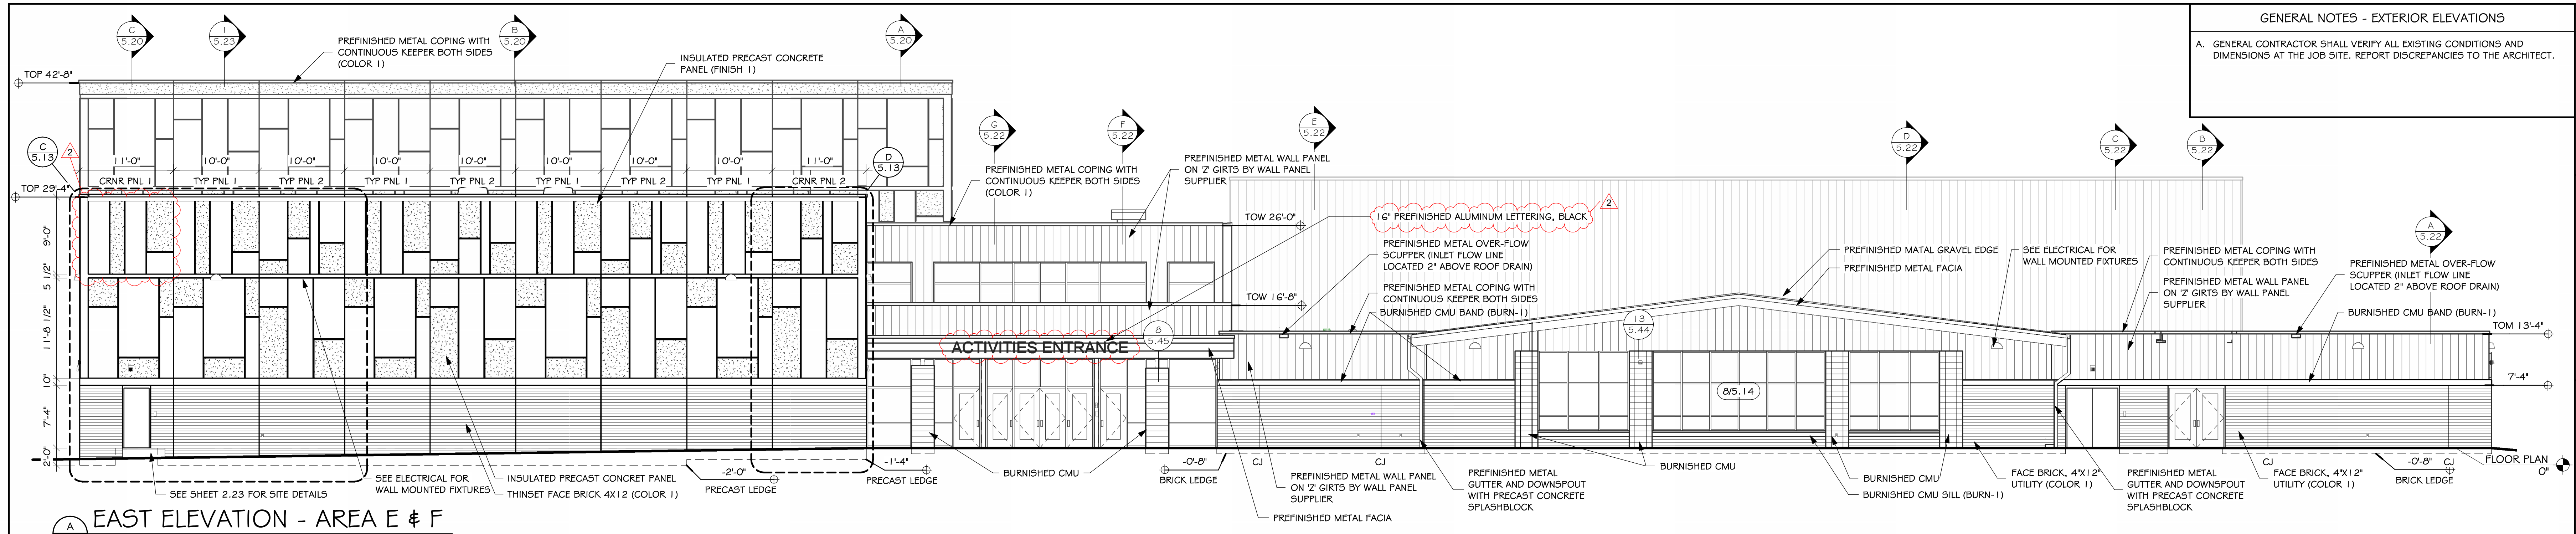


EAST ELEVATION - AREA E & F

SCALE: 1/8" = 1'-0"

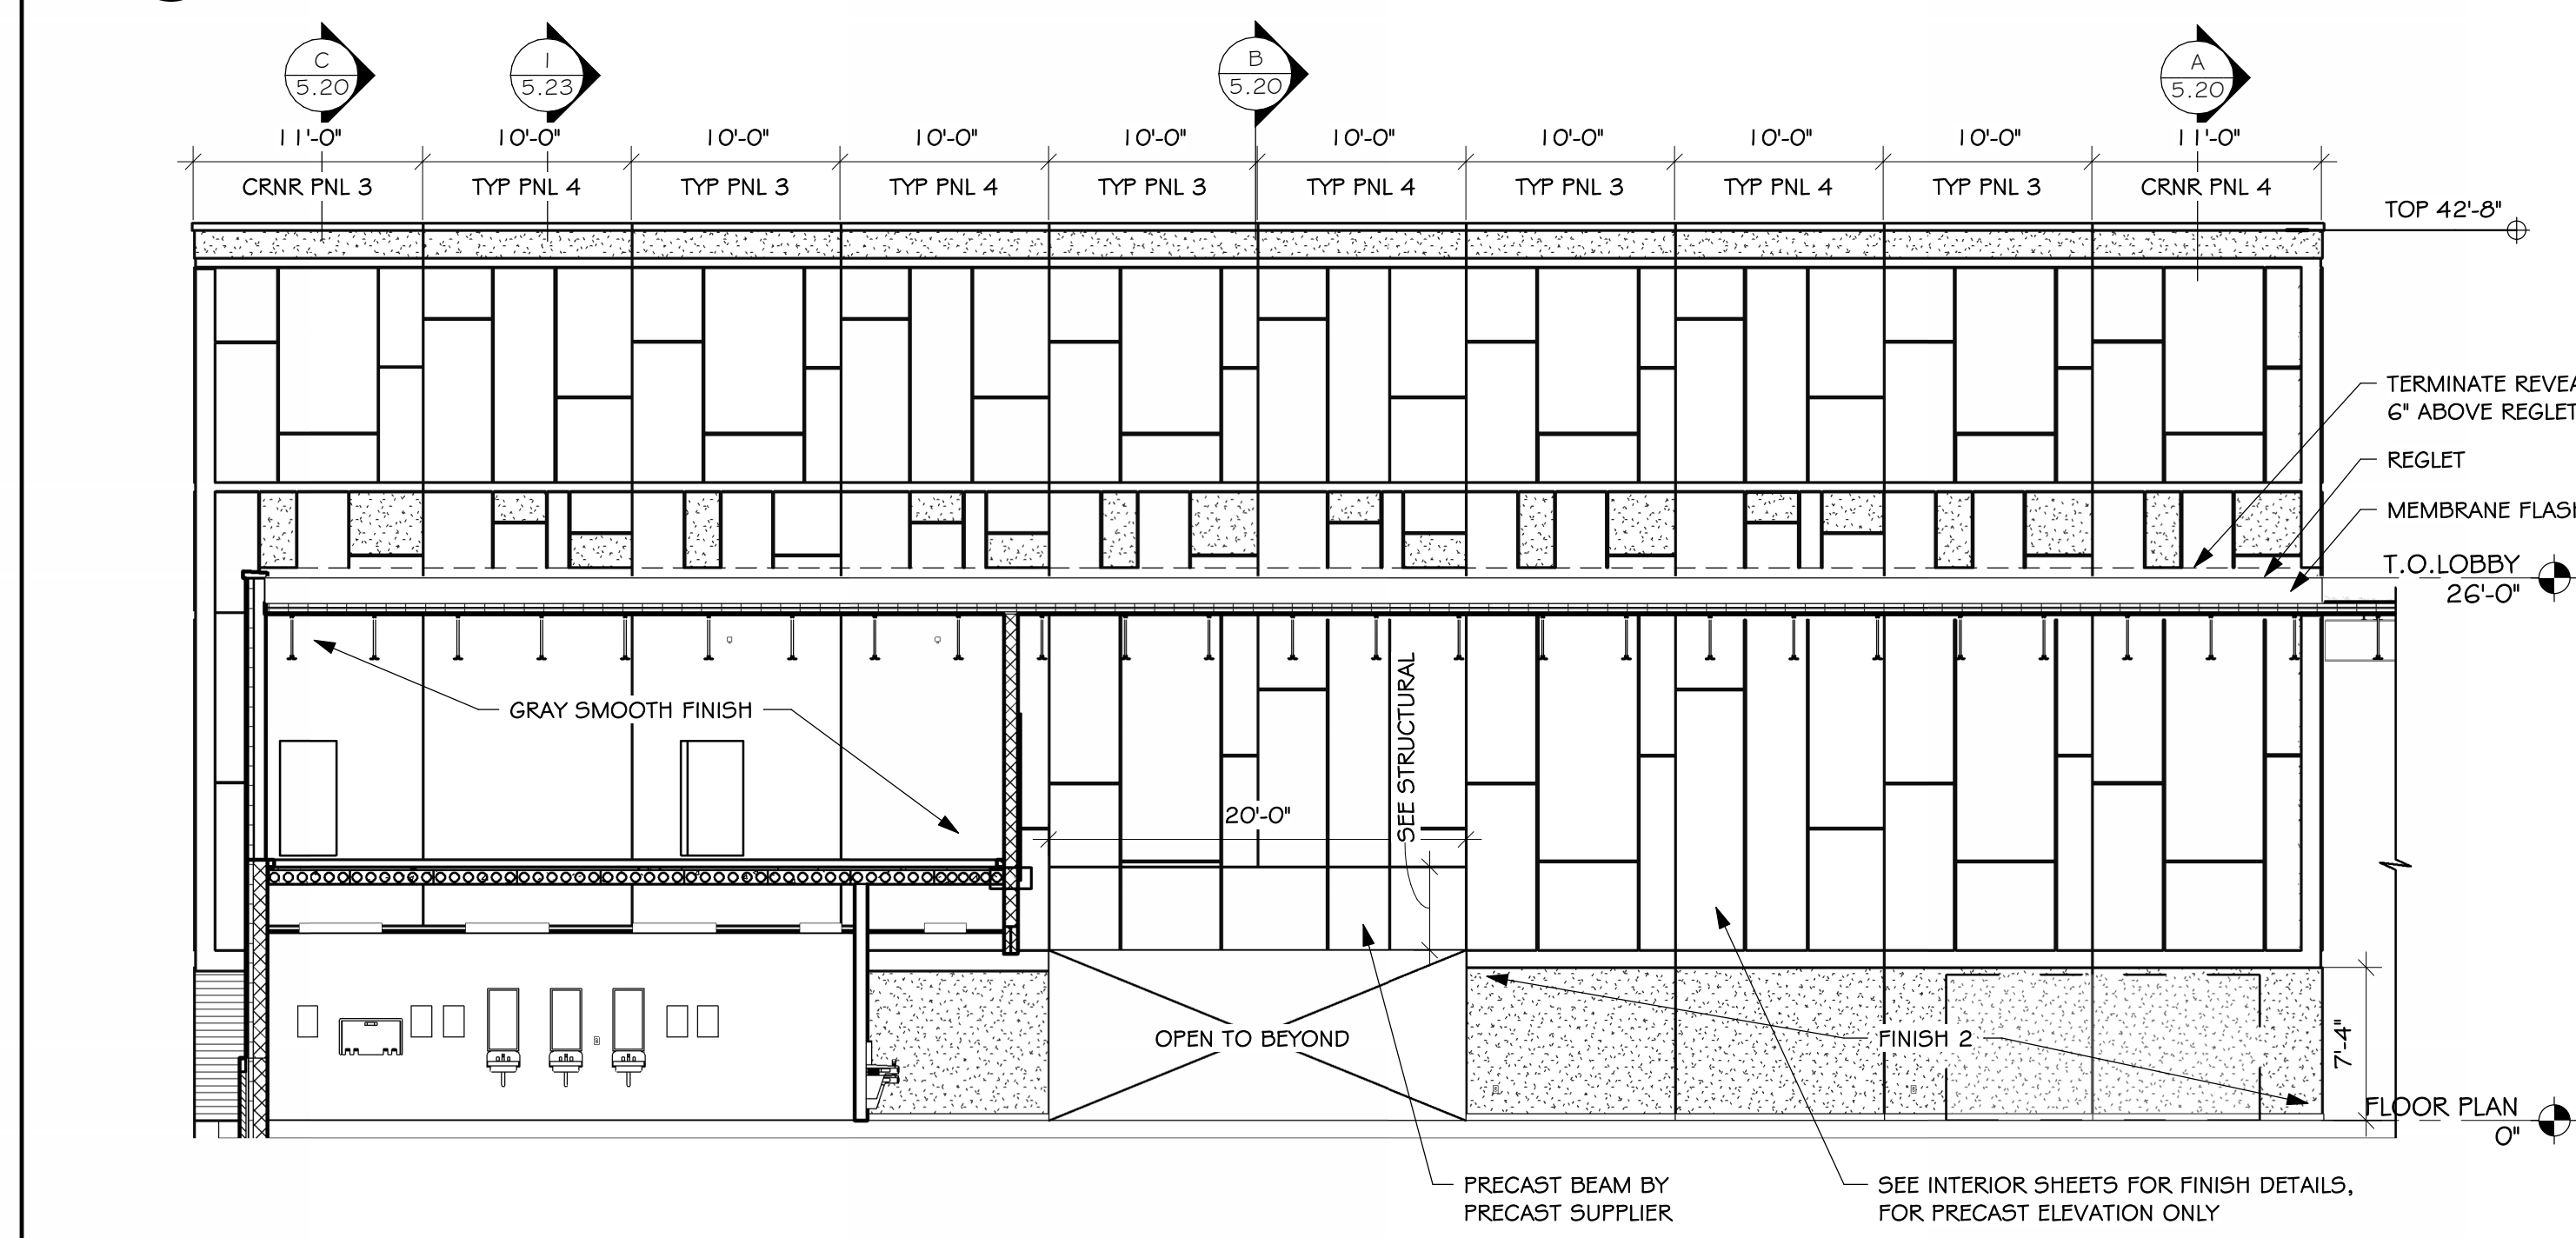


EAST ELEVATION / SECTION AREA F & G

SCALE: 1/8" = 1'-0"

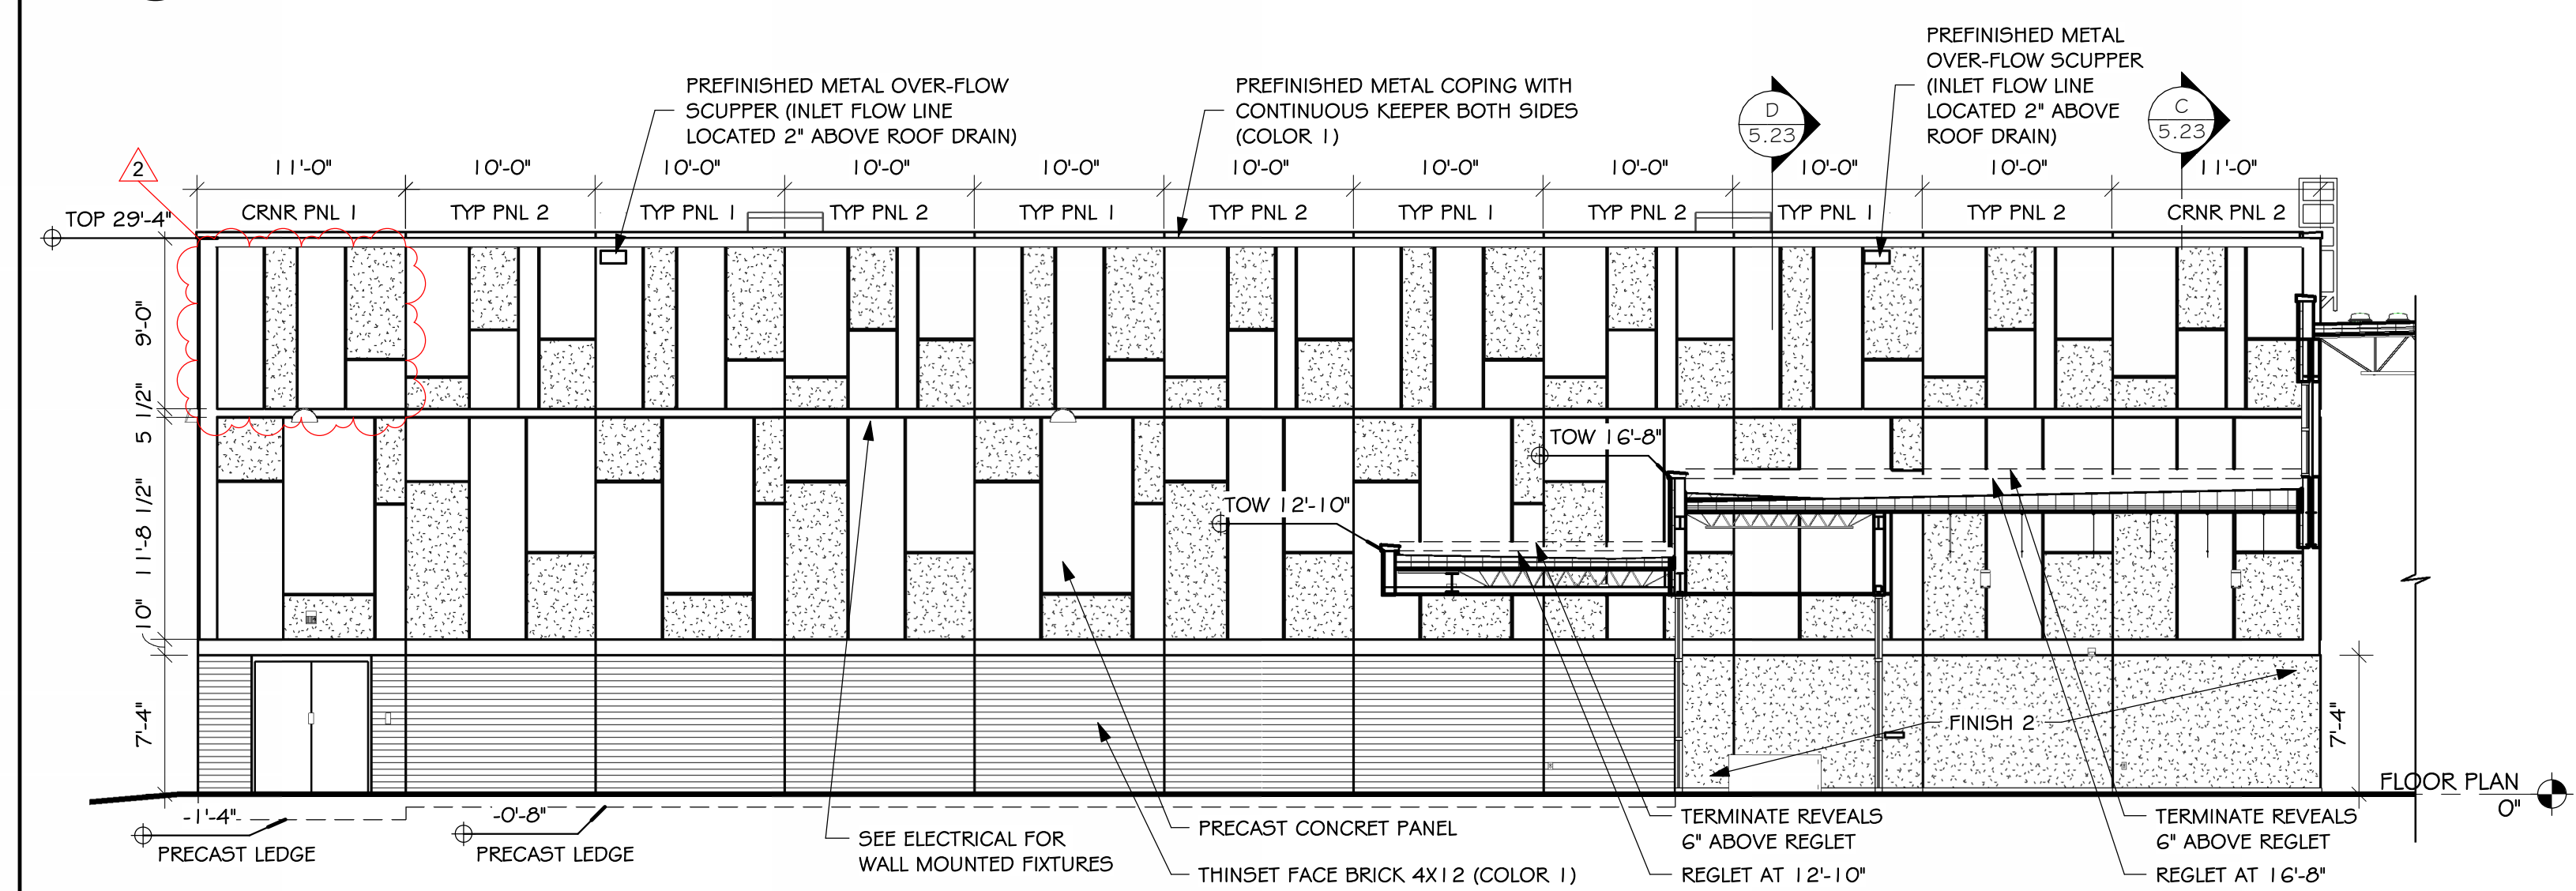

NORTH ELEVATION / SECTION AREA F

SCALE: 1/8" = 1'-0"

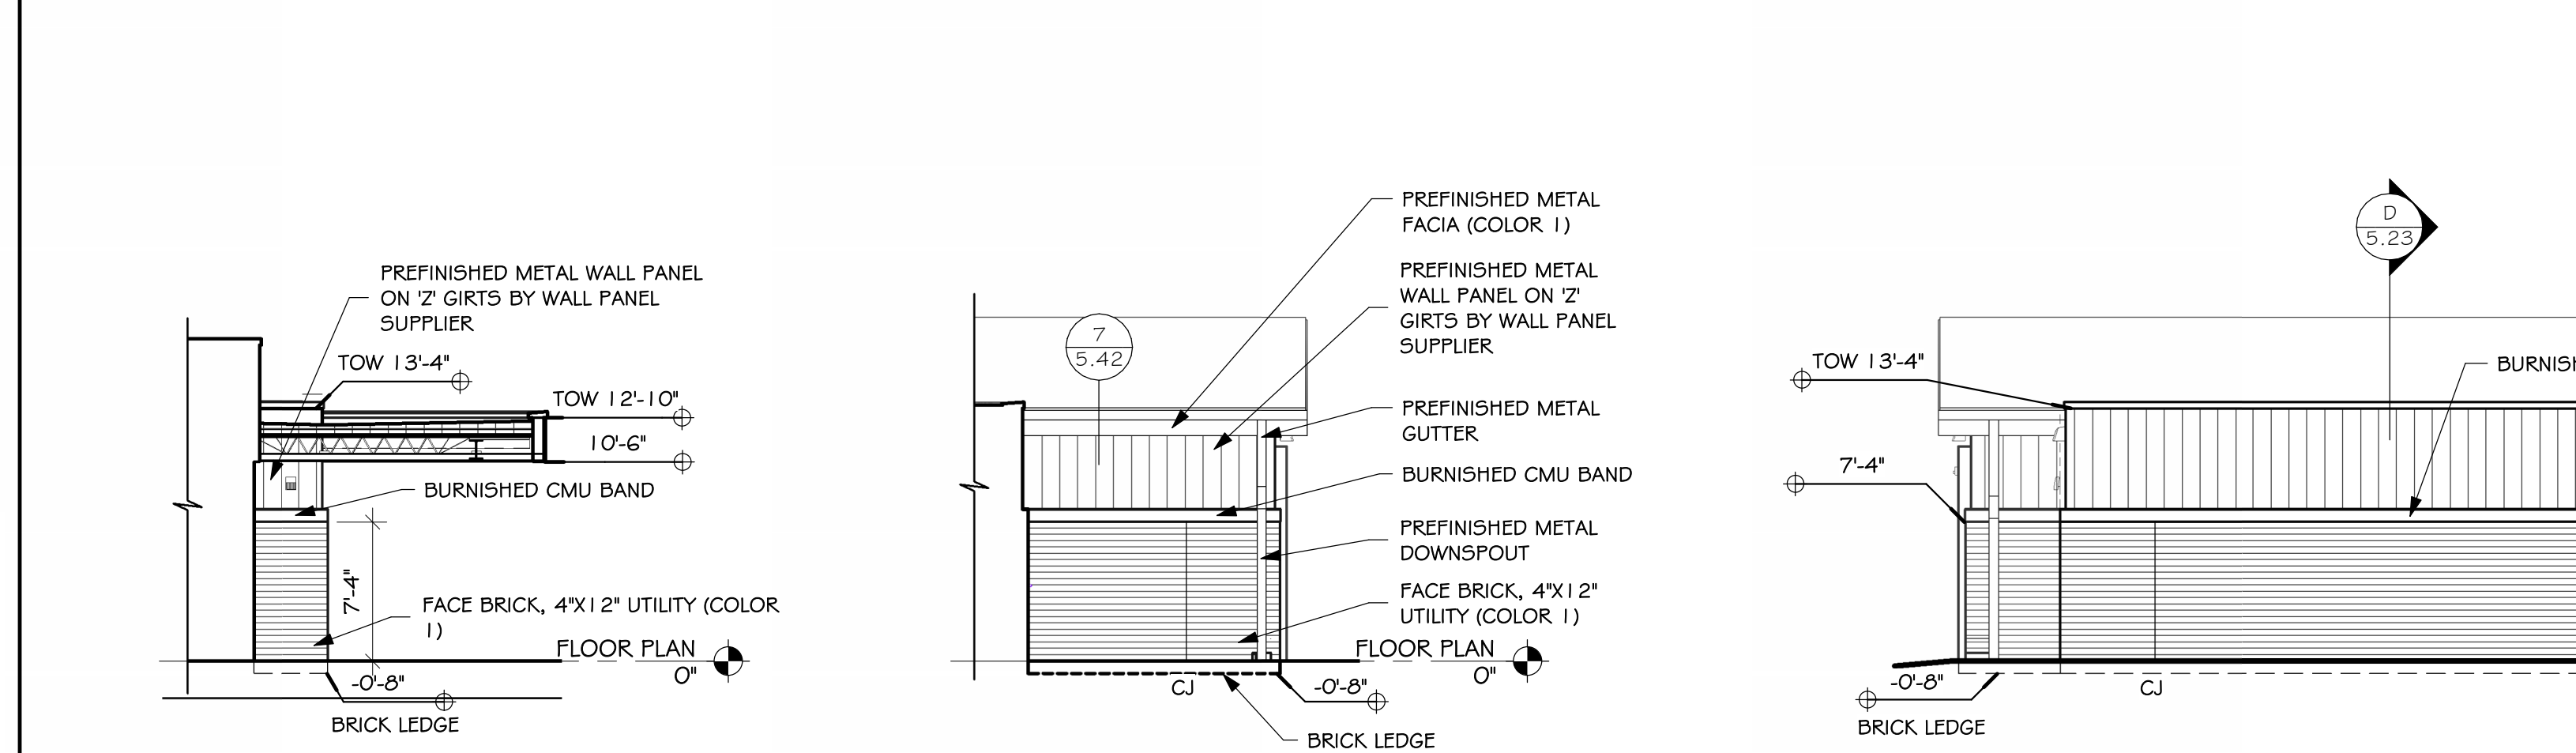


SOUTH ELEVATION - AREA F

SCALE: 1/8" = 1'-0"


SOUTH ELEVATION - AREA F

SCALE: 1/8" = 1'-0"

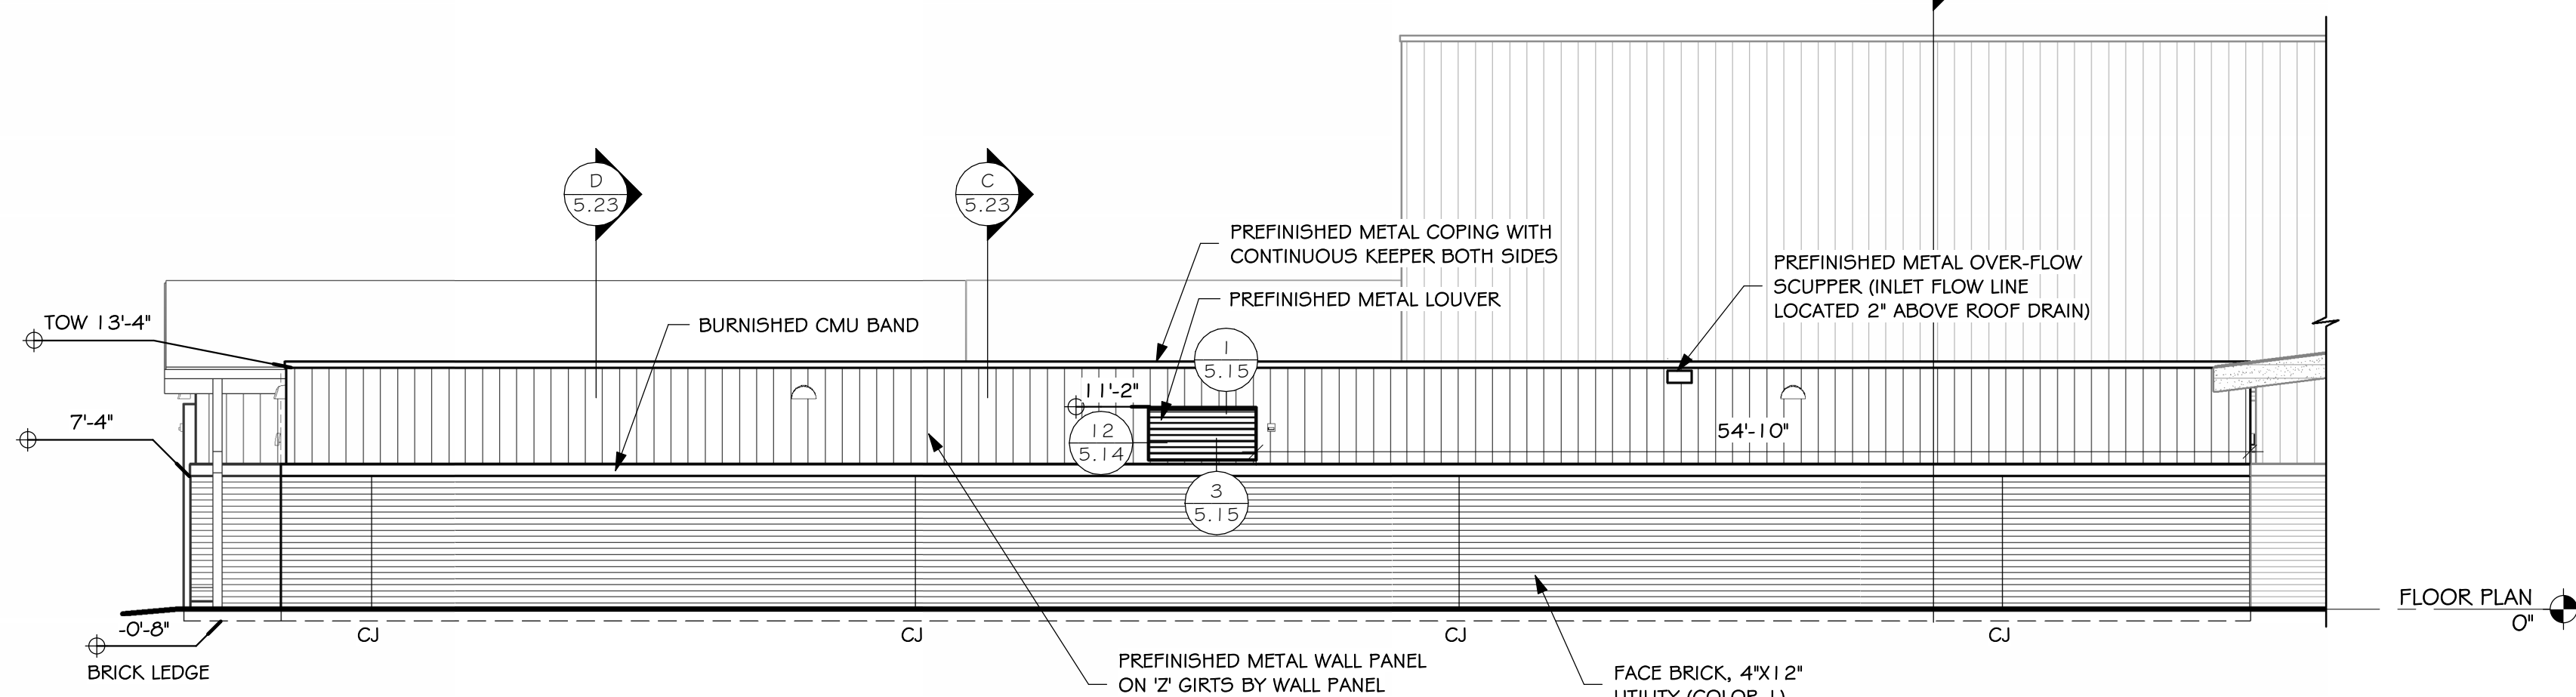


NORTH ELEVATION - AREA E

SCALE: 1/8" = 1'-0"

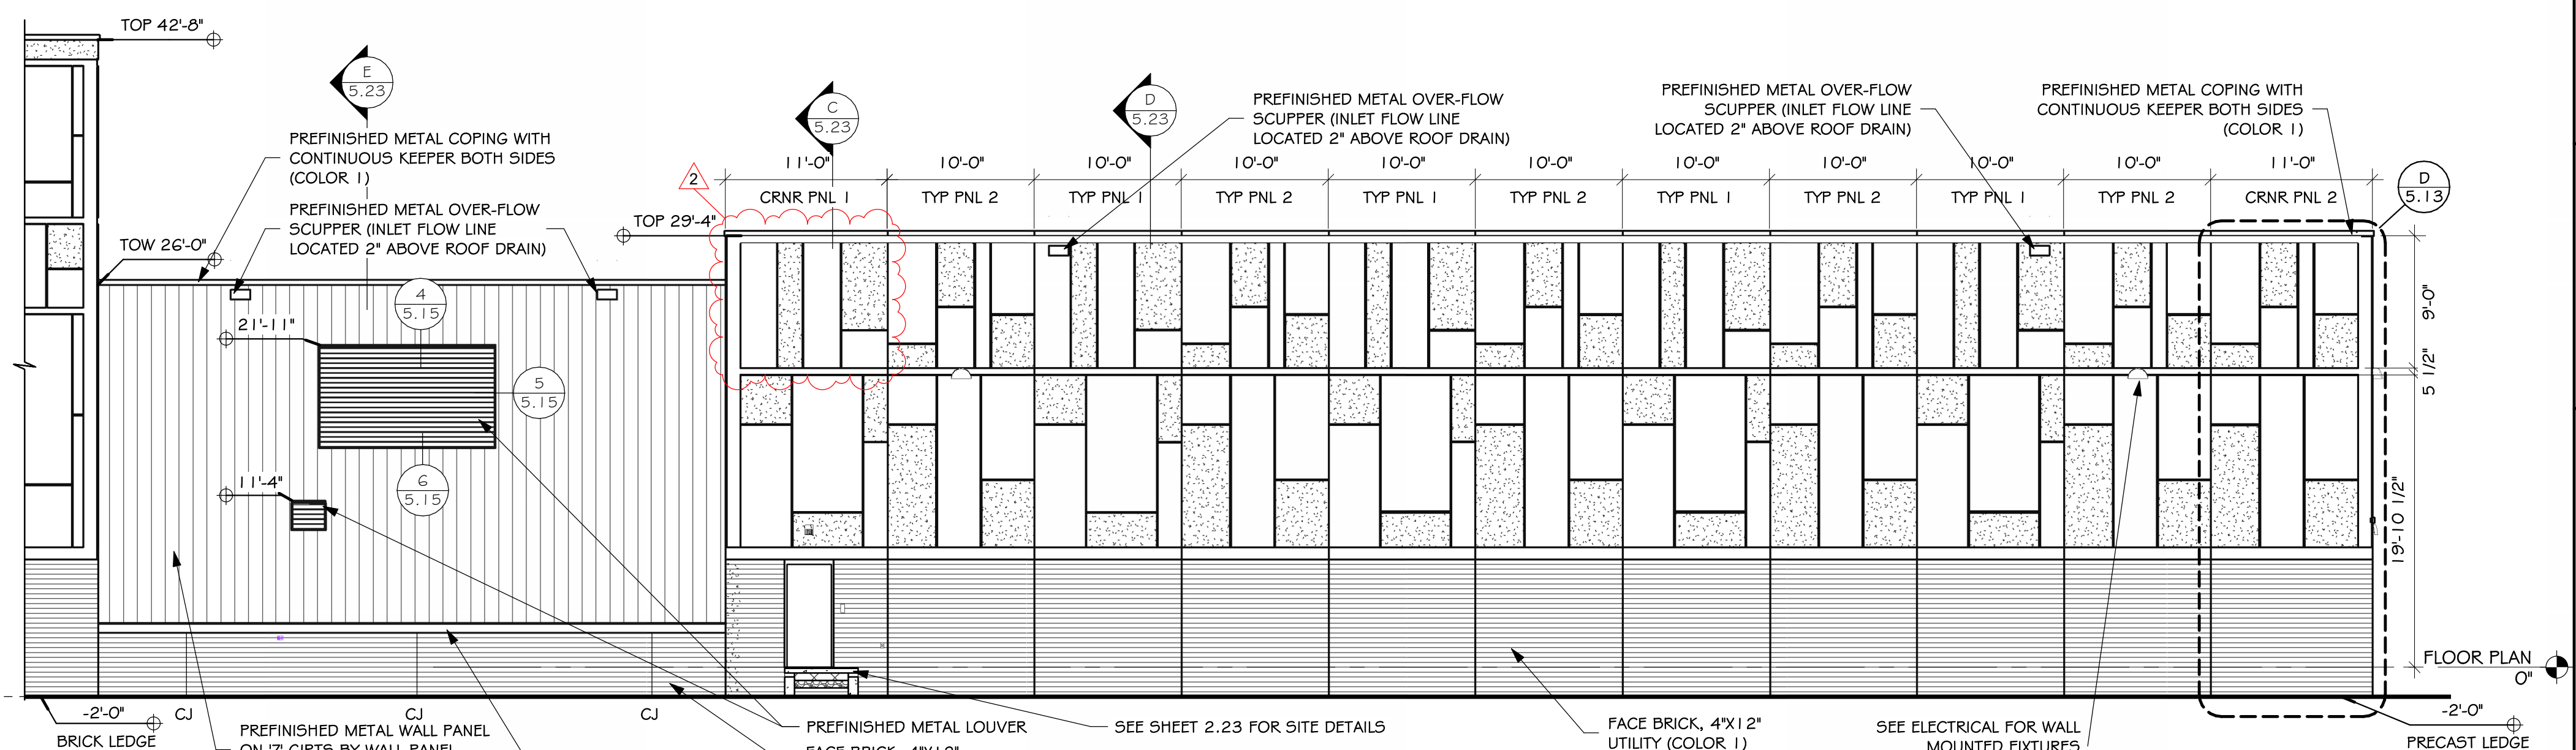

SOUTH ELEVATION - AREA F

SCALE: 1/8" = 1'-0"

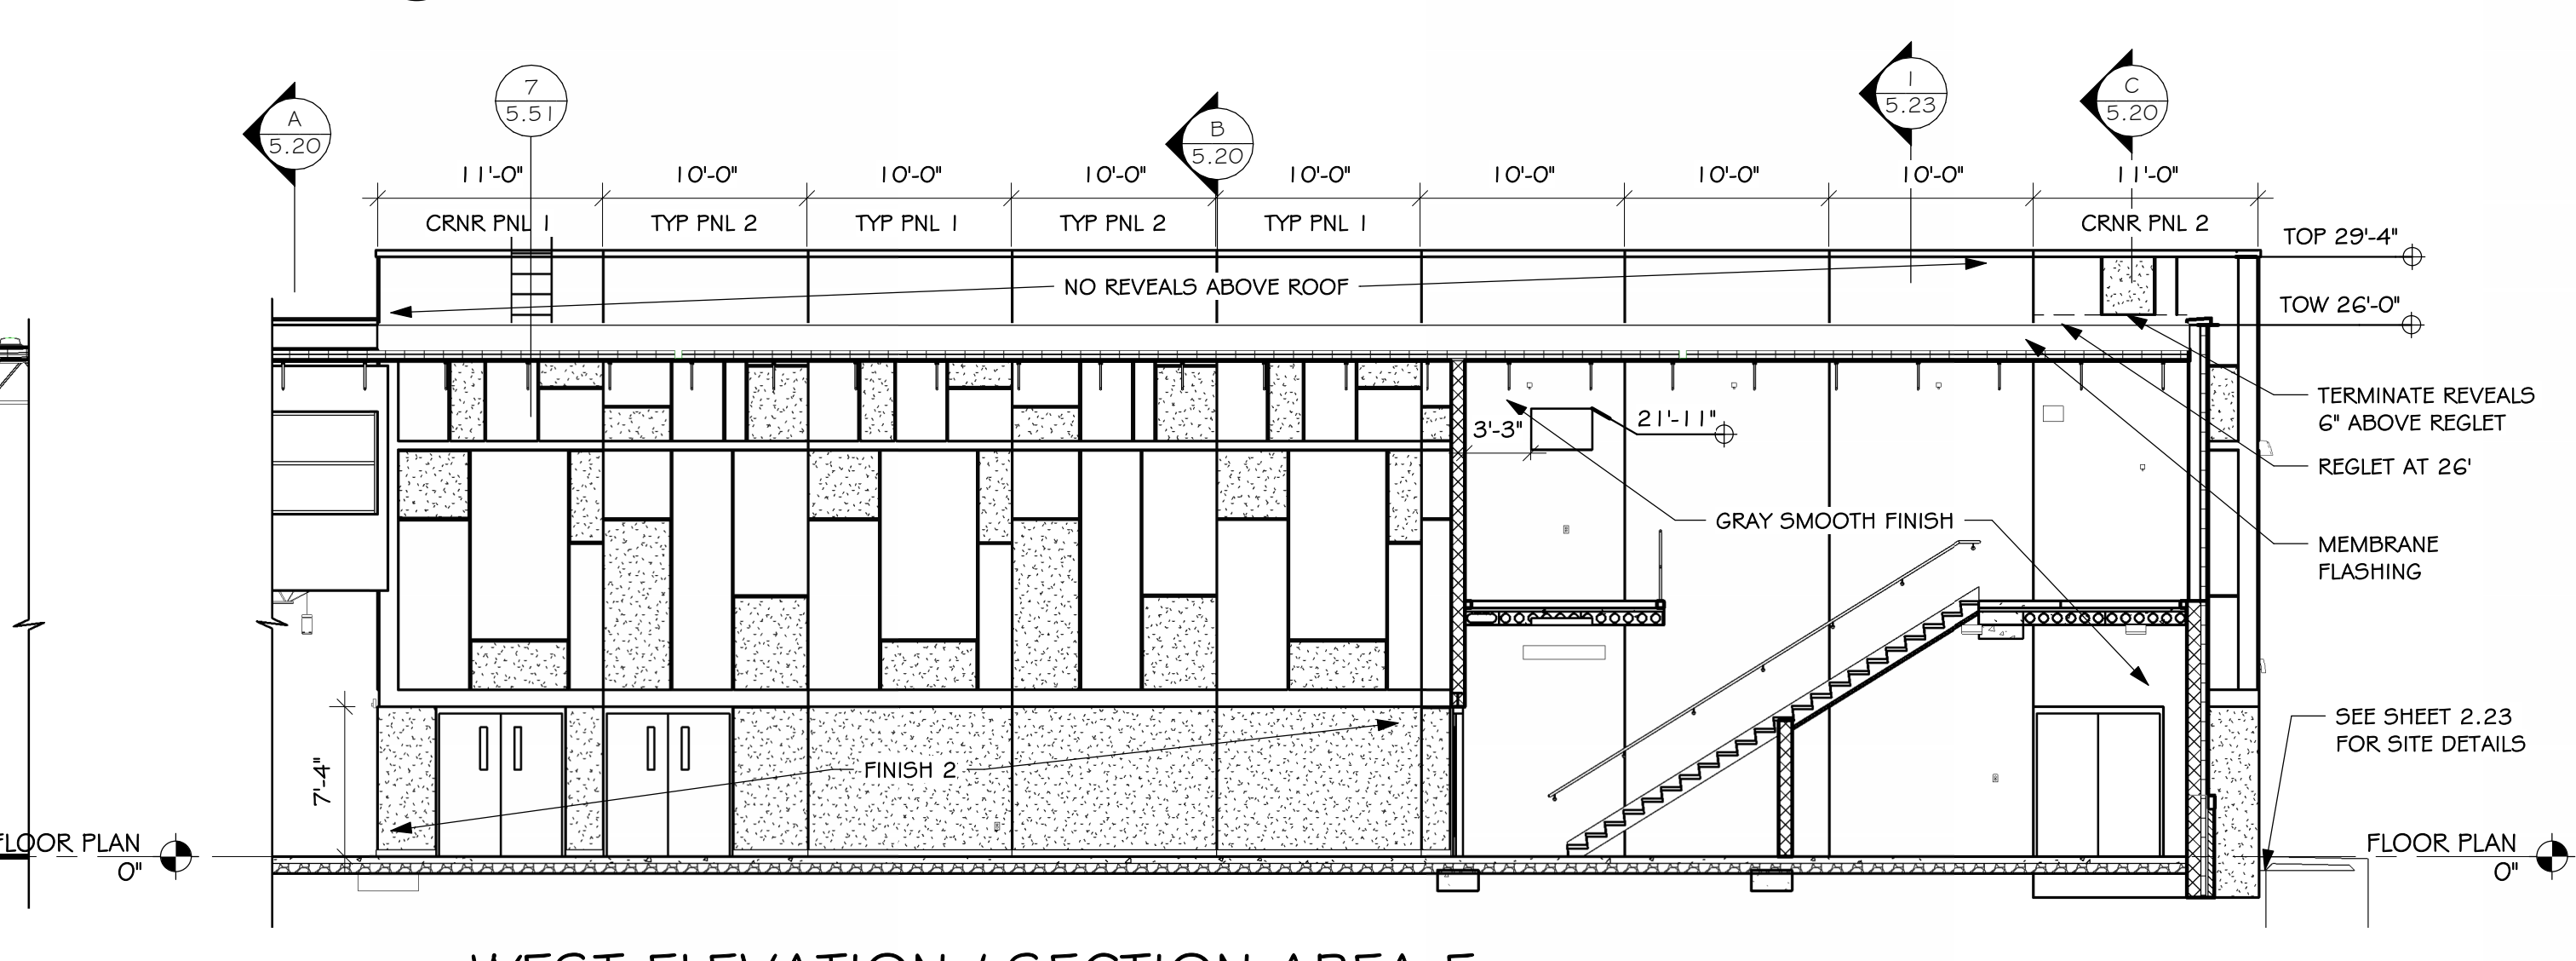

WEST ELEVATION / SECTION AREA F

SCALE: 1/8" = 1'-0"

GENERAL NOTES - EXTERIOR ELEVATIONS

A. GENERAL CONTRACTOR SHALL VERIFY ALL EXISTING CONDITIONS AND DIMENSIONS AT THE JOB SITE. REPORT DISCREPANCIES TO THE ARCHITECT.

Architecture Incorporated

415 South Main Avenue  
P.O. Box 2140  
Sioux Falls, South Dakota 57101  
Phone: (605) 339-1711

815 St Joseph Street, Suite 203  
Rapid City, South Dakota 57701  
Phone: (605) 721-1158

State of South Dakota  
REG. NO. 3734  
JASTHAM  
12-21-2023  
Registered Architect

Project

number 0215.2902.22

date DECEMBER 21, 2023

revision

drawn SWP checked SRJ


DATE DESCRIPTION

1/11/2024 ADDENDUM #2


5.10




1/10/2024 4:23:51 PM

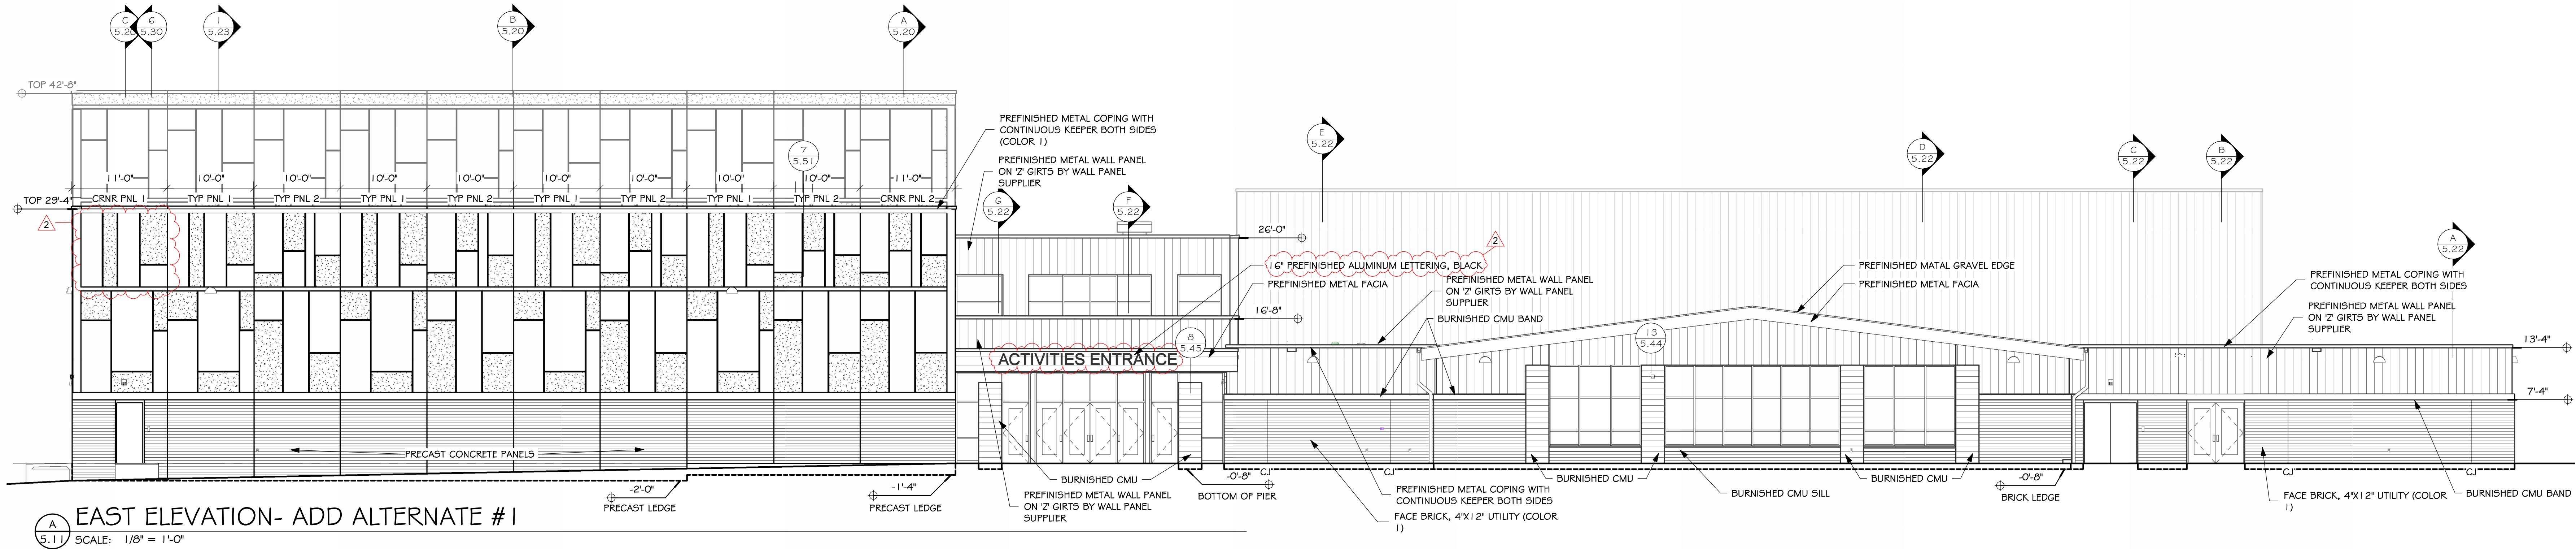


**A** EAST ELEVATION- ADD ALTERNATE #1  
SCALE: 1/8" = 1'-0"

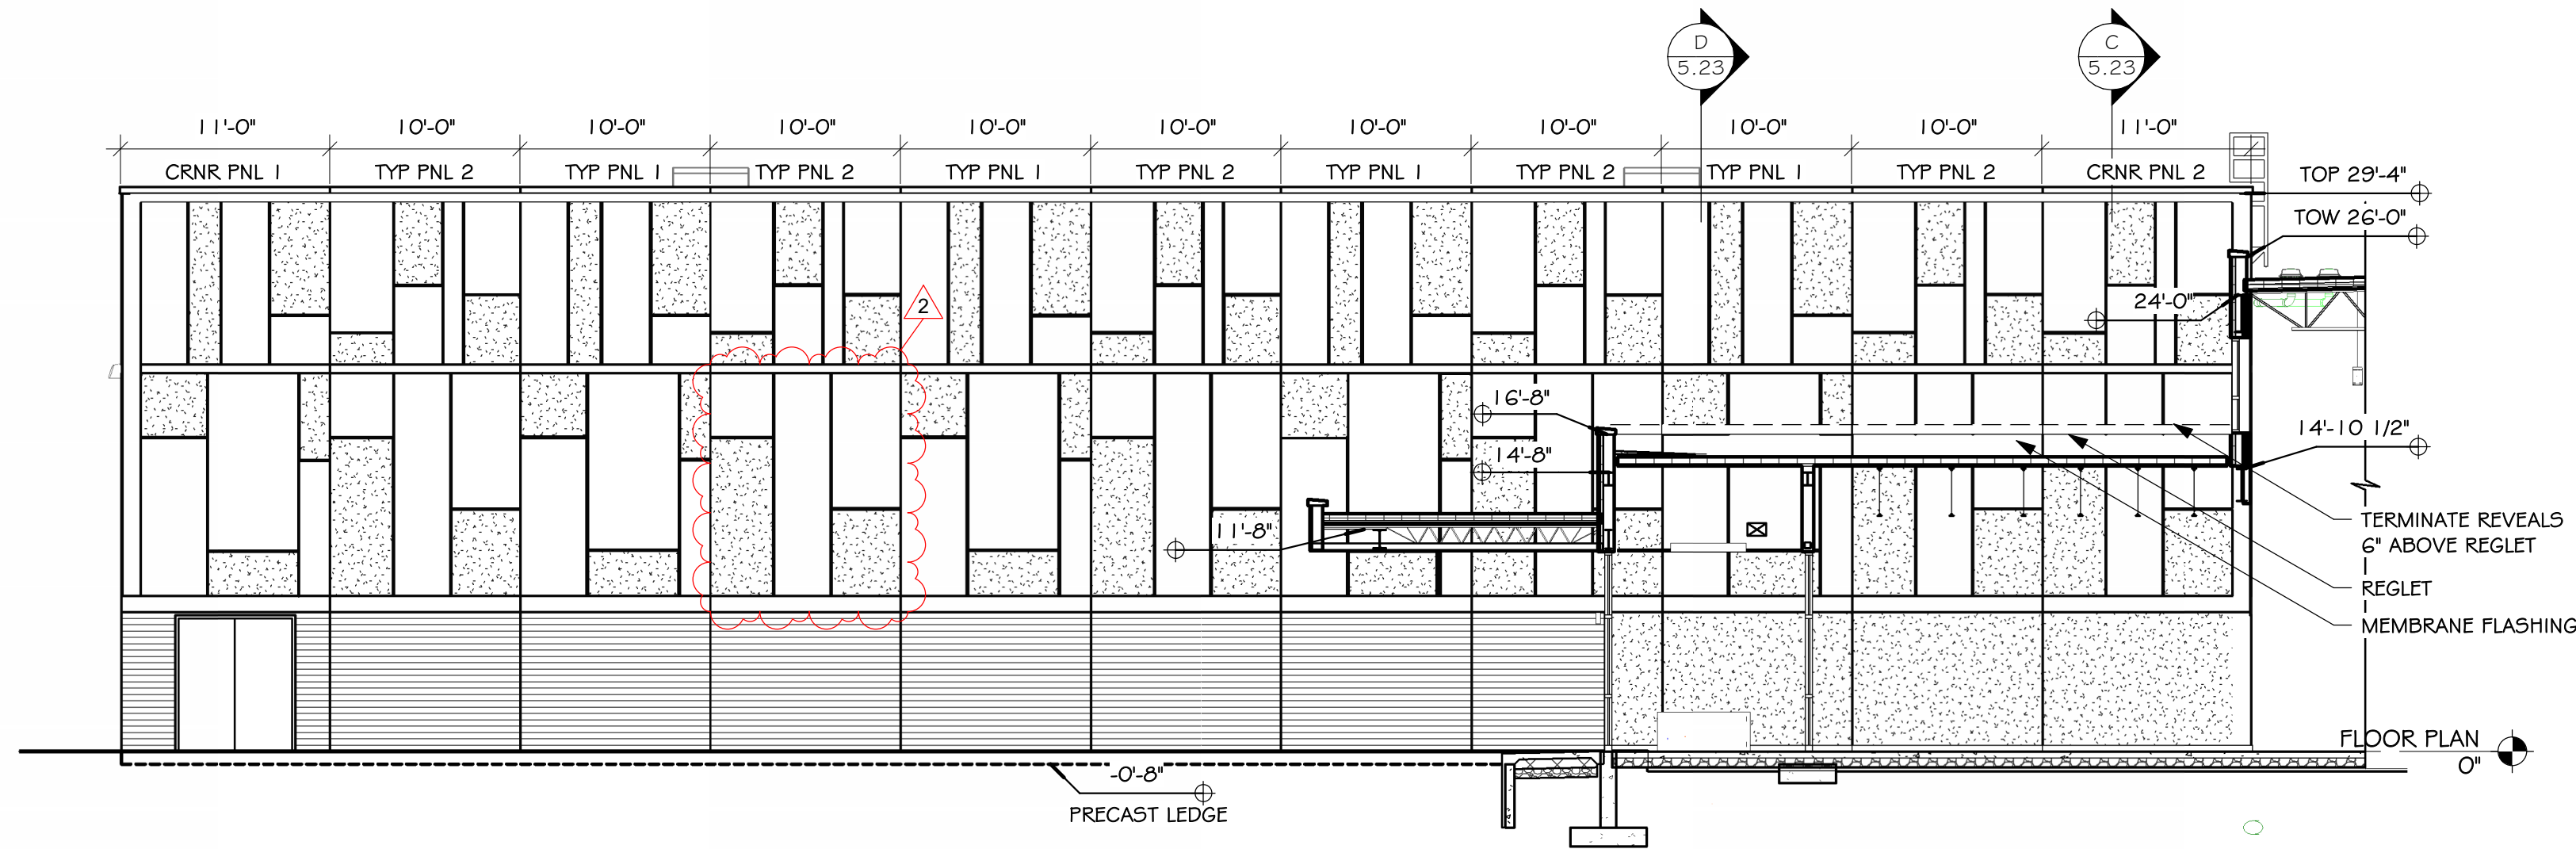

**B** NORTH ELEVATION- ADD ALTERNATE #1  
SCALE: 1/8" = 1'-0"

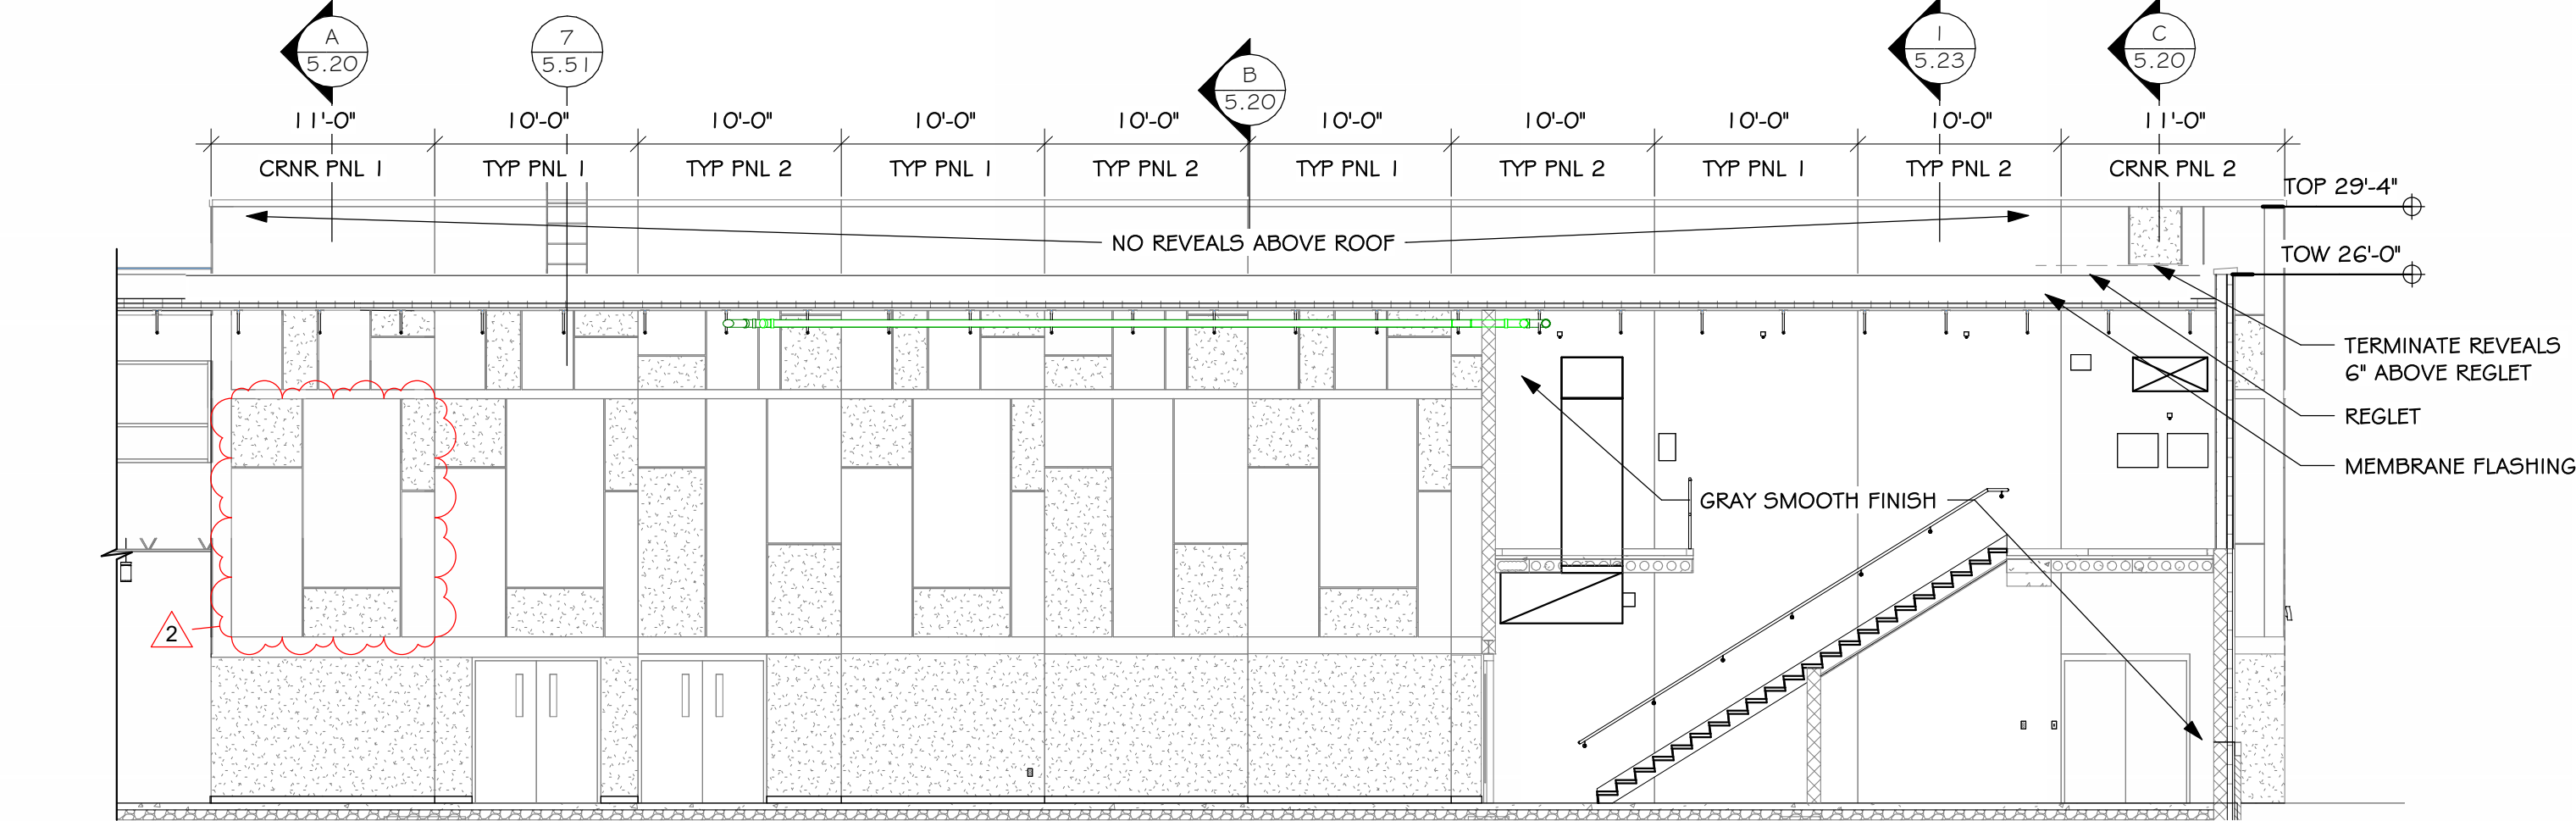

**C** WEST ELEVATION- ADD ALTERNATE #1  
SCALE: 1/8" = 1'-0"

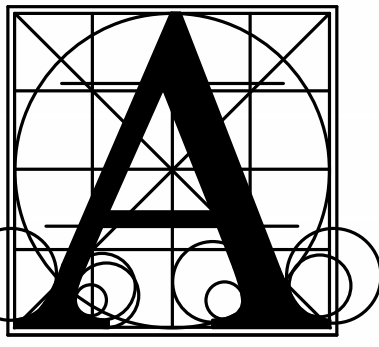

Architecture  
Incorporated

415 South Main Avenue  
P.O. Box 2140  
Sioux Falls, South Dakota 57101  
Phone: (605) 339-1711

815 St Joseph Street, Suite 203  
Rapid City, South Dakota 57701  
Phone: (605) 721-1158




Project  
**LENNOX HIGH SCHOOL ADDITION**  
sheet contents  
**EXTERIOR ELEVATIONS - AREA F - ADD ALTERNATE**

number 0215.2902.22  
date DECEMBER 21, 2023  
revision  
drawn SWP checked SRJ

DATE	DESCRIPTION
1/10/2024	ADDENDUM #2

5.11



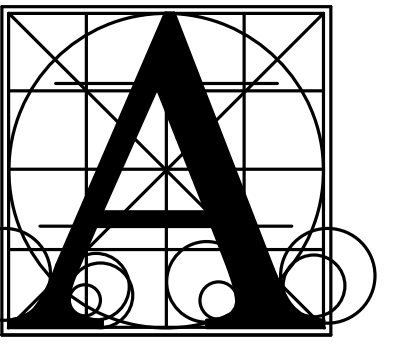

Architecture  
Incorporated

415 South Main Avenue  
P.O. Box 2140  
Sioux Falls, South Dakota 57101  
Phone: (605) 339-1711

815 St Joseph Street, Suite 203  
Rapid City, South Dakota 57701  
Phone: (605) 721-1158



LENNOX HIGH SCHOOL ADDITION


PRECAST ELEVATIONS & DETAILS

Project

number 0215.2982.22  
date DECEMBER 21, 2023  
revision  
drawn SWP checked SRJ

DATE DESCRIPTION  
1/18/2024 ADDENDUM #2

5.13

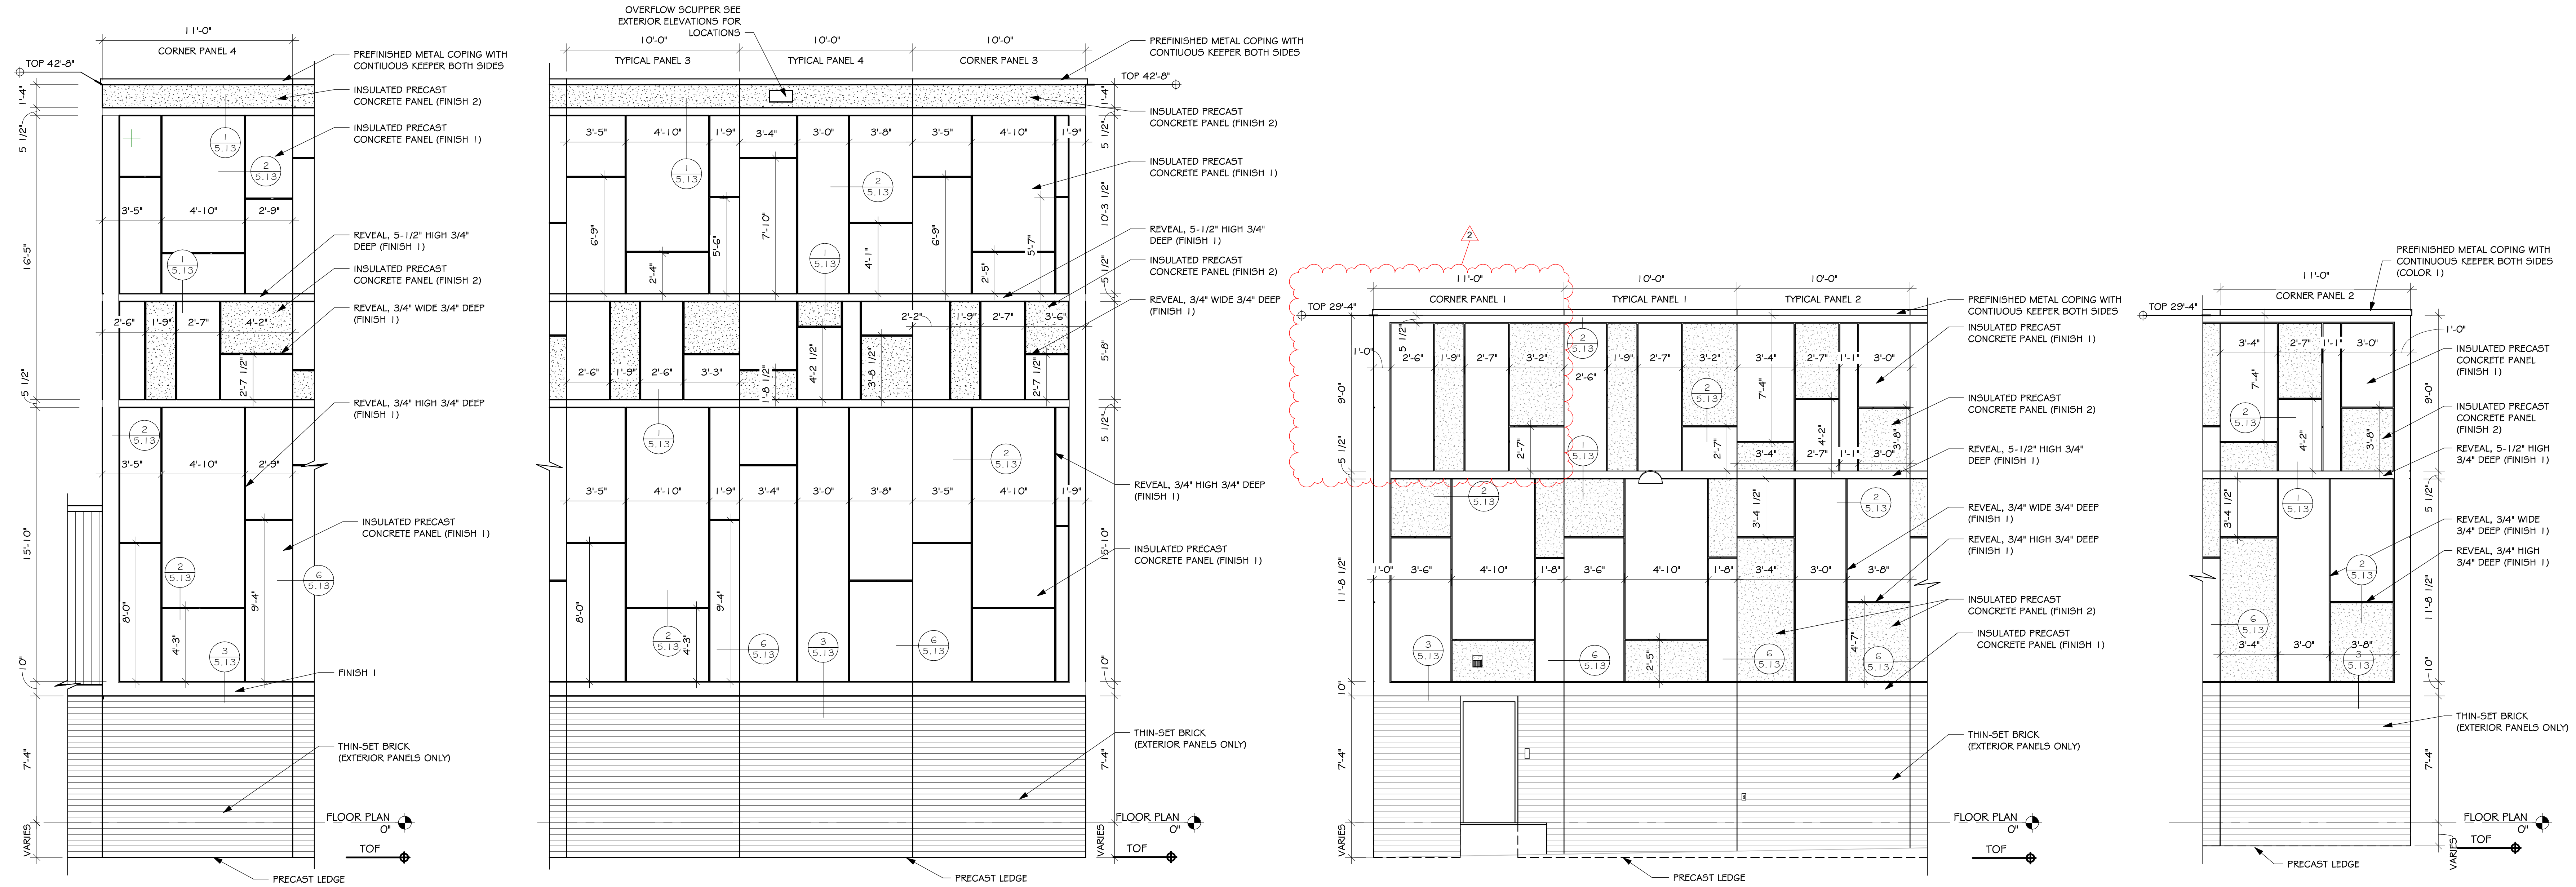


A PRECAST WALL ELEVATION  
SCALE: 1/4" = 1'-0"


B PRECAST WALL ELEVATION  
SCALE: 1/4" = 1'-0"

C PRECAST WALL ELEVATION  
SCALE: 1/4" = 1'-0"


D PRECAST WALL ELEVATION  
SCALE: 1/4" = 1'-0"

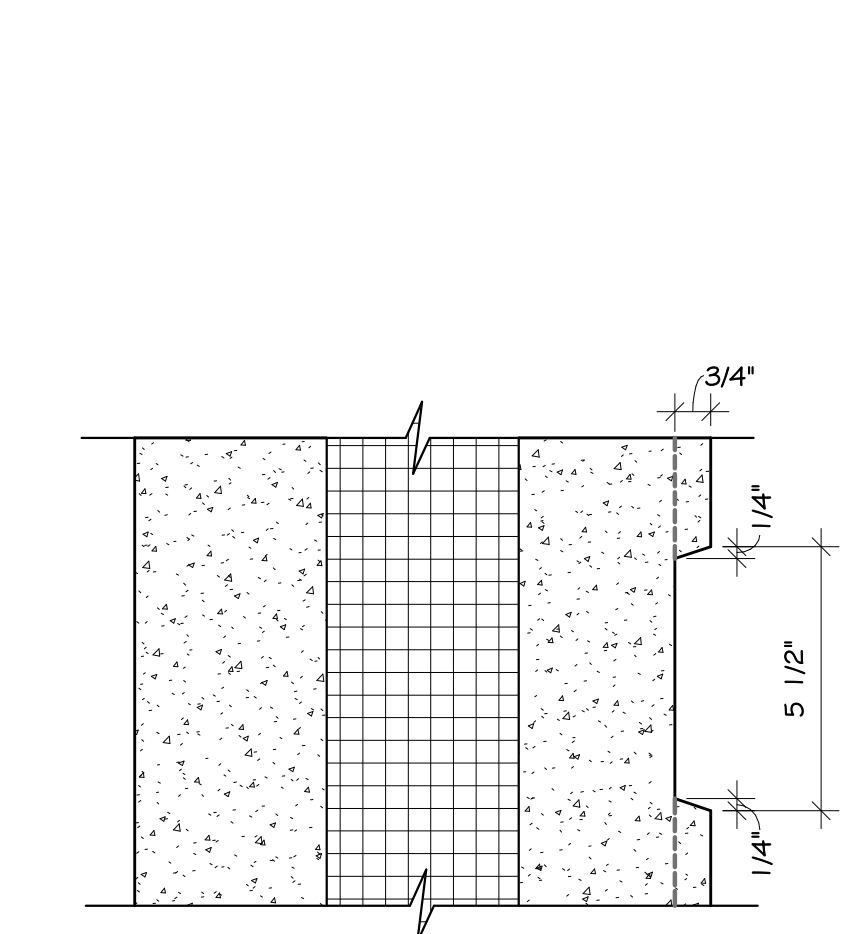


1 PRECAST - REVEAL  
SCALE: 3" = 1'-0"

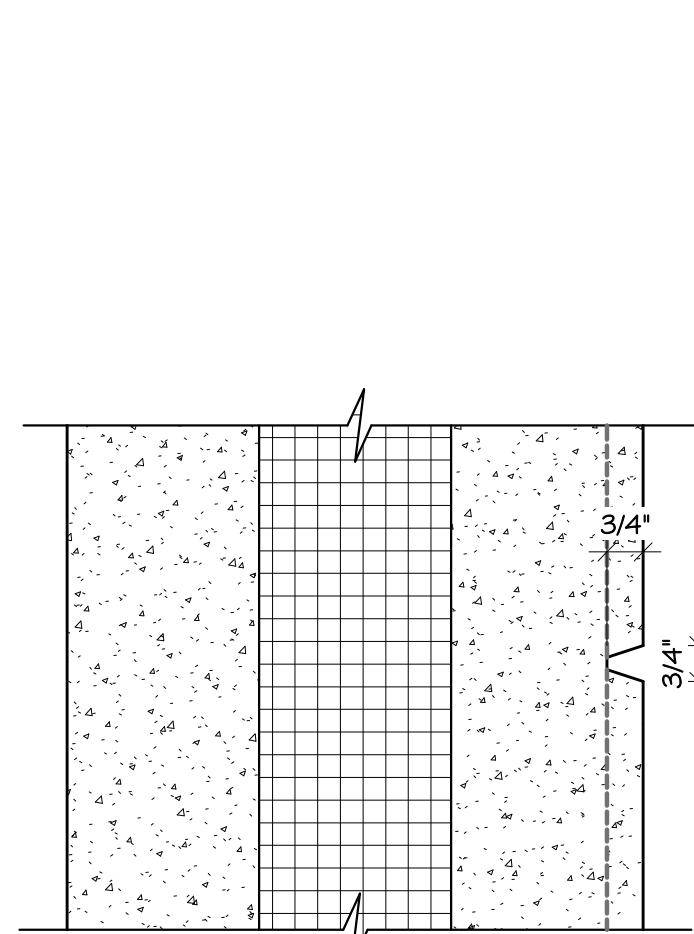


2 PRECAST - REVEAL  
SCALE: 3" = 1'-0"

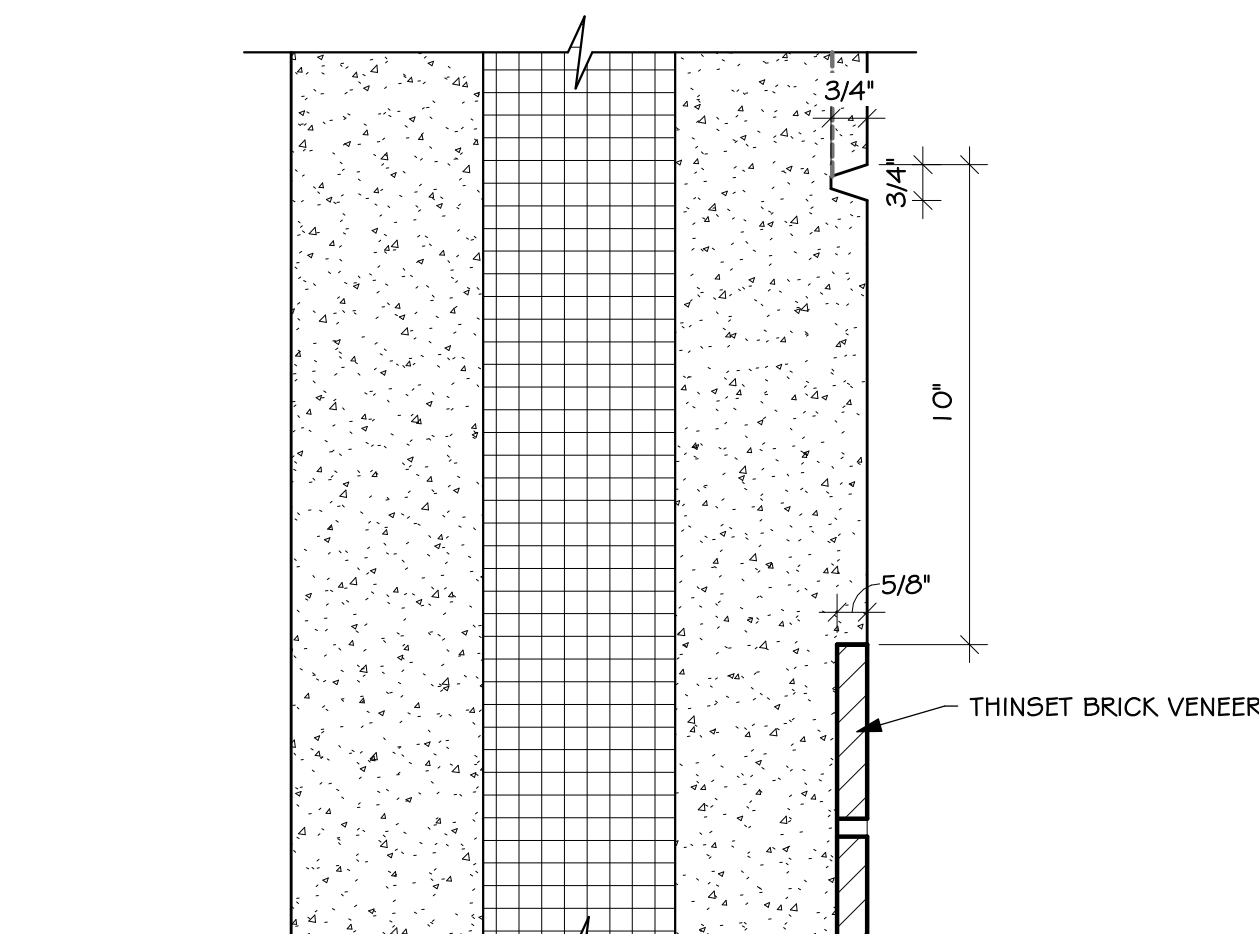


3 PRECAST - REVEAL  
SCALE: 3" = 1'-0"

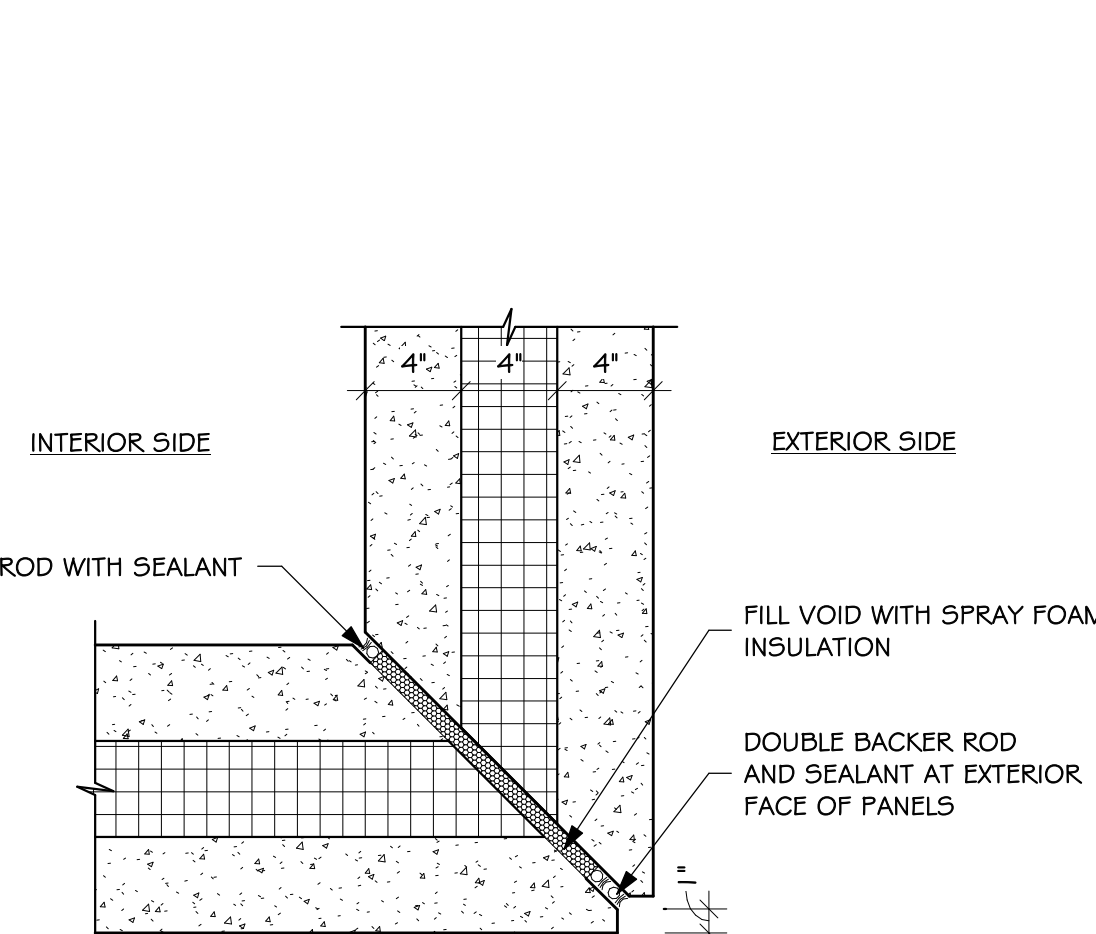


4 PRECAST - CORNER MITER - TYP  
SCALE: 1 1/2" = 1'-0"

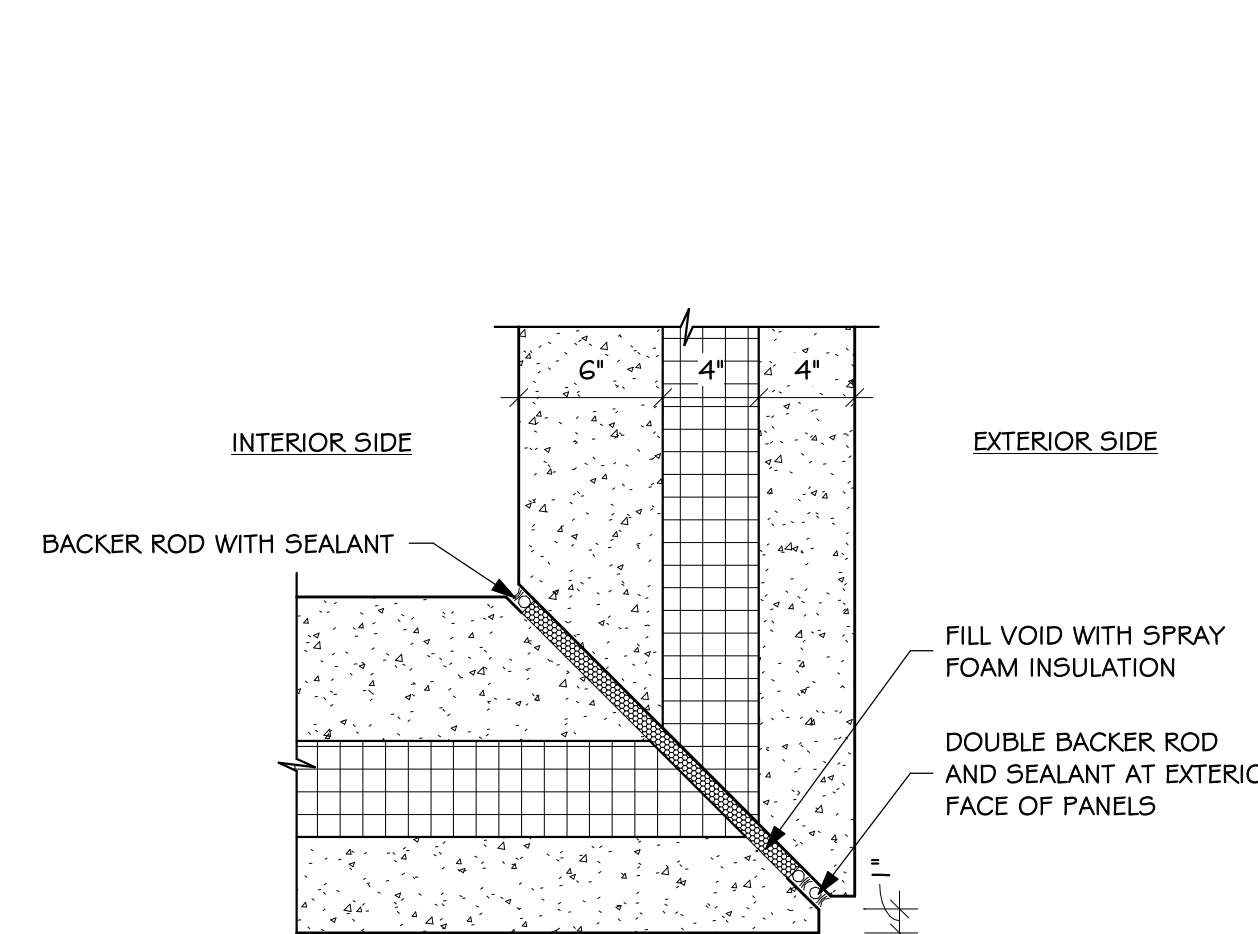


5 PRECAST - CORNER MITER 14" - TYP  
SCALE: 1 1/2" = 1'-0"

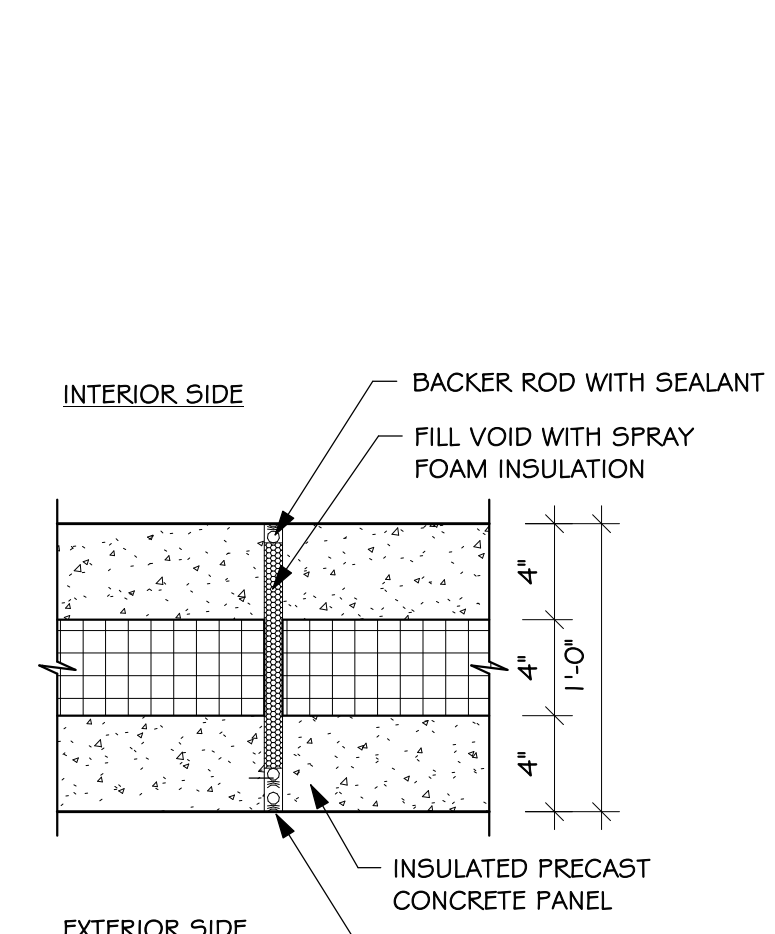


6 PRECAST - JOINT - PLAN  
SCALE: 1 1/2" = 1'-0"

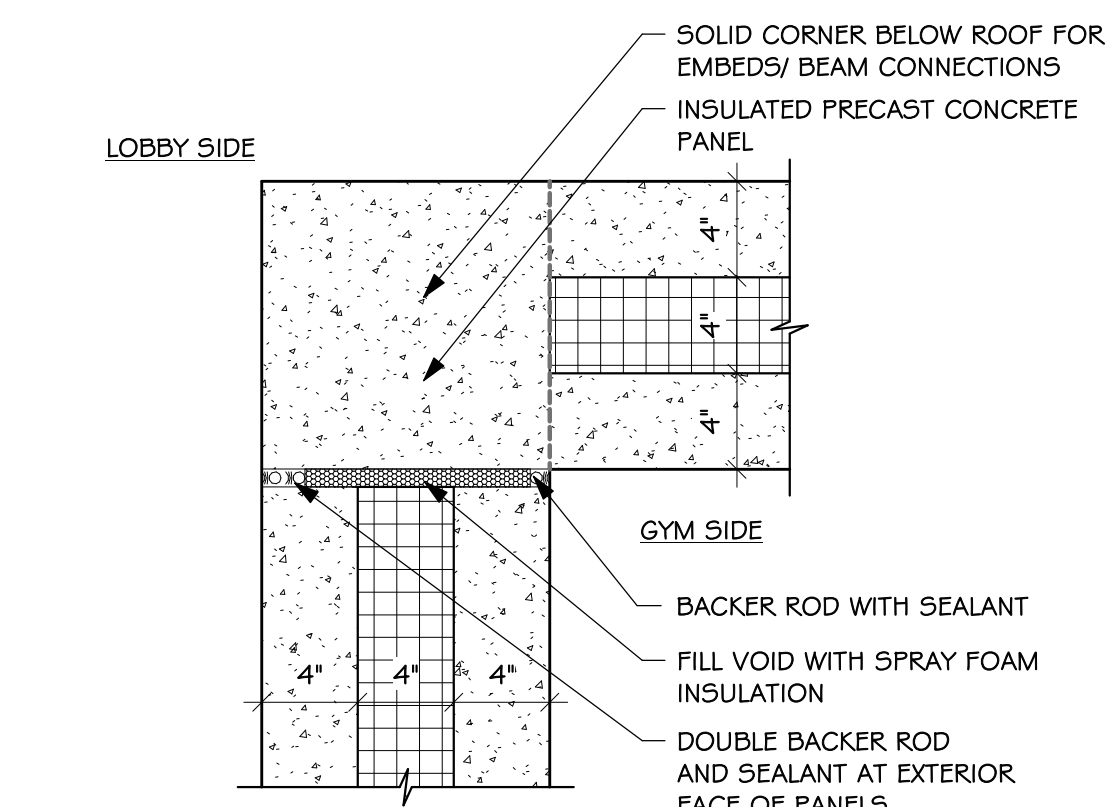


7 PRECAST - CORNER - LOW  
SCALE: 1 1/2" = 1'-0"

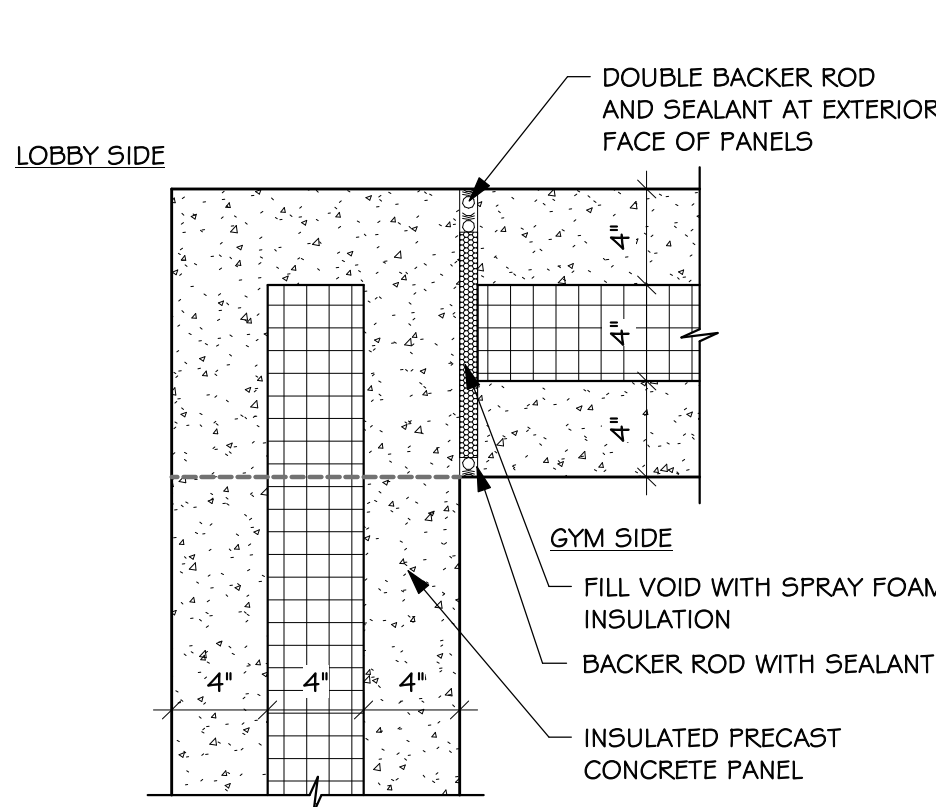

8 PRECAST - CORNER - HIGH  
SCALE: 1 1/2" = 1'-0"

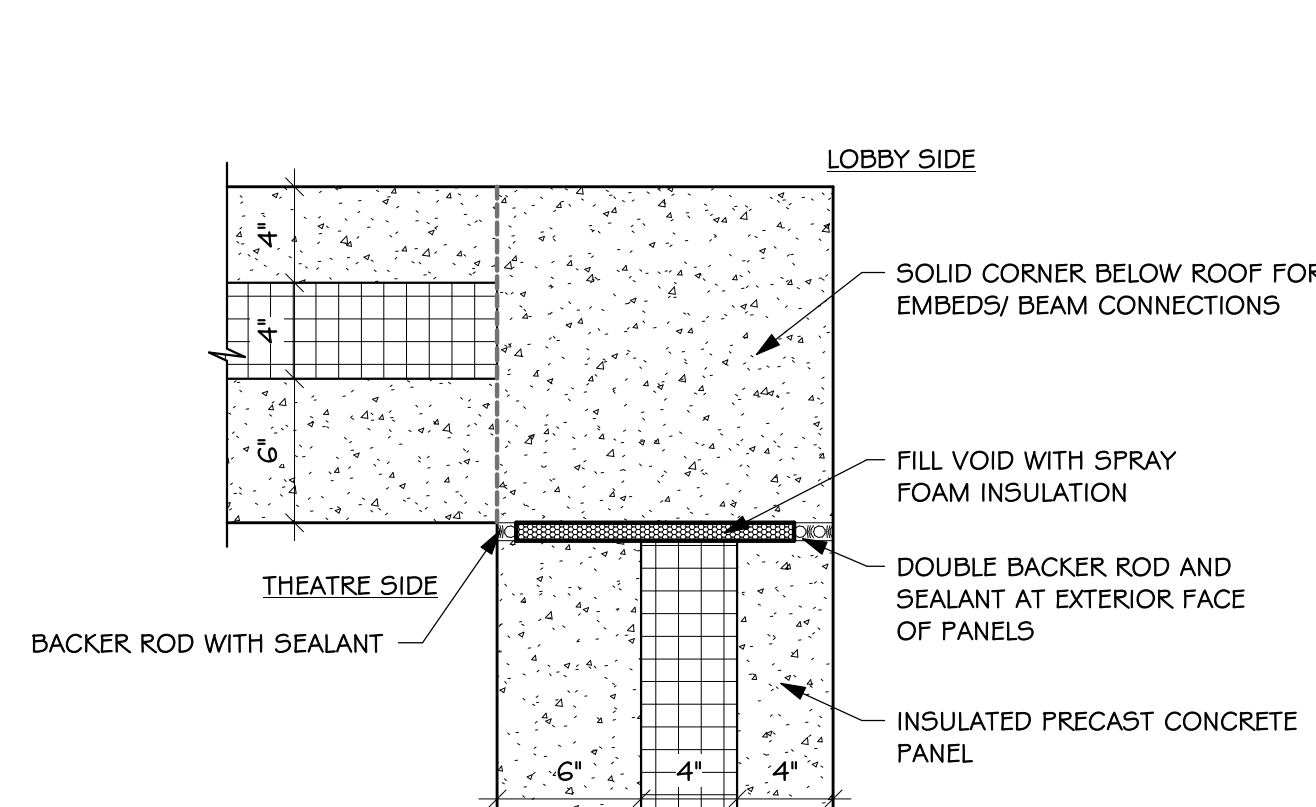

9 PRECAST - CORNER - LOW  
SCALE: 1 1/2" = 1'-0"

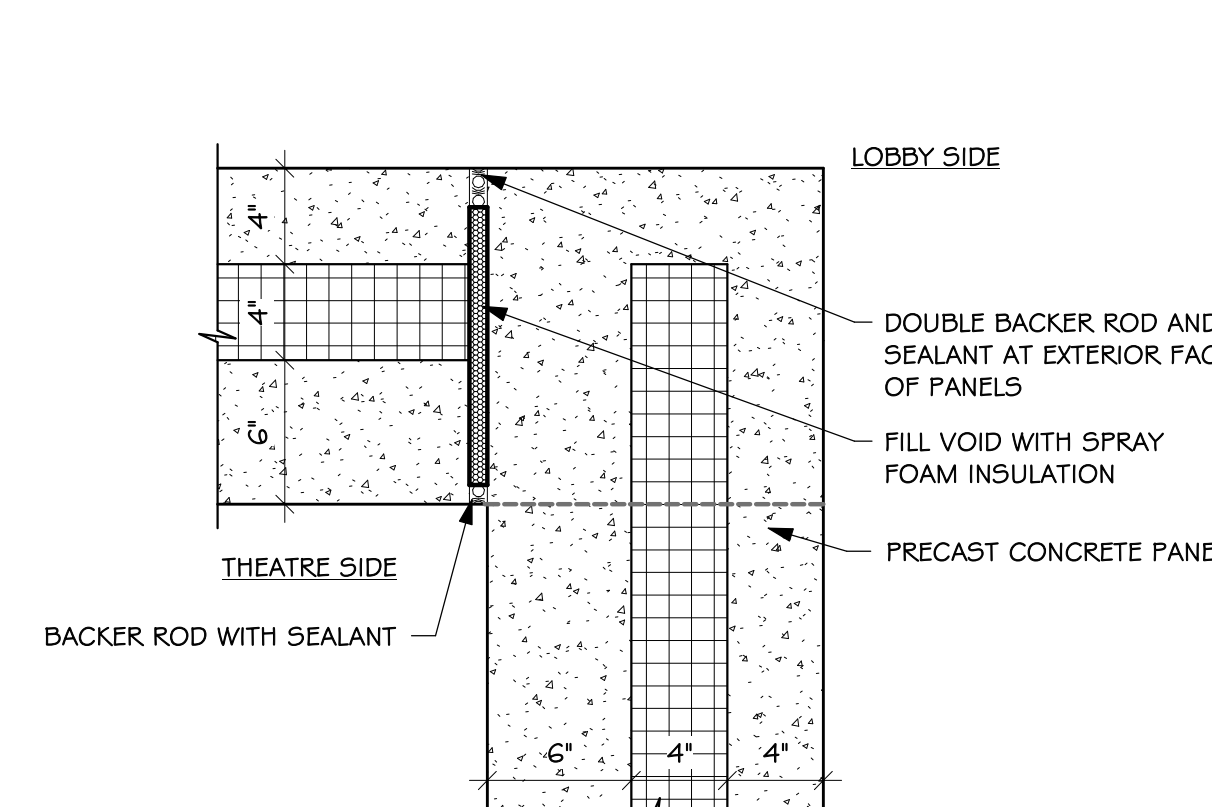


10 PRECAST - CORNER - HIGH  
SCALE: 1 1/2" = 1'-0"









1/17/2024 3:10:36 PM

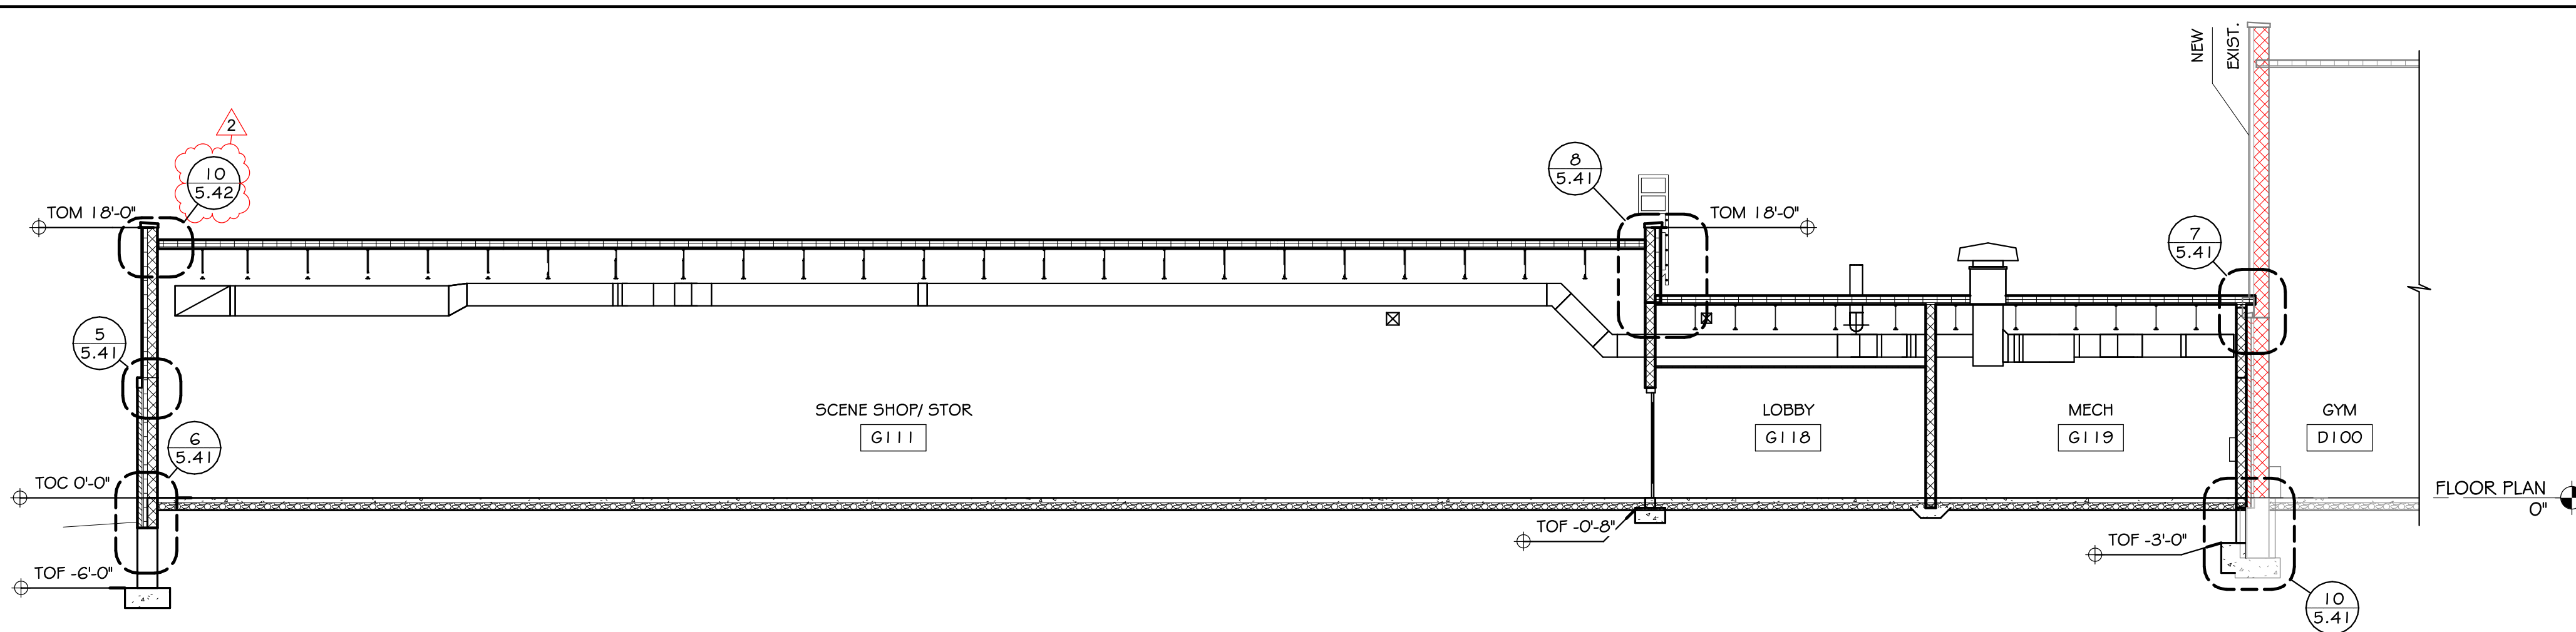


**A** BUILDING SECTION - AREA G  
SCALE: 1/8" = 1'-0"

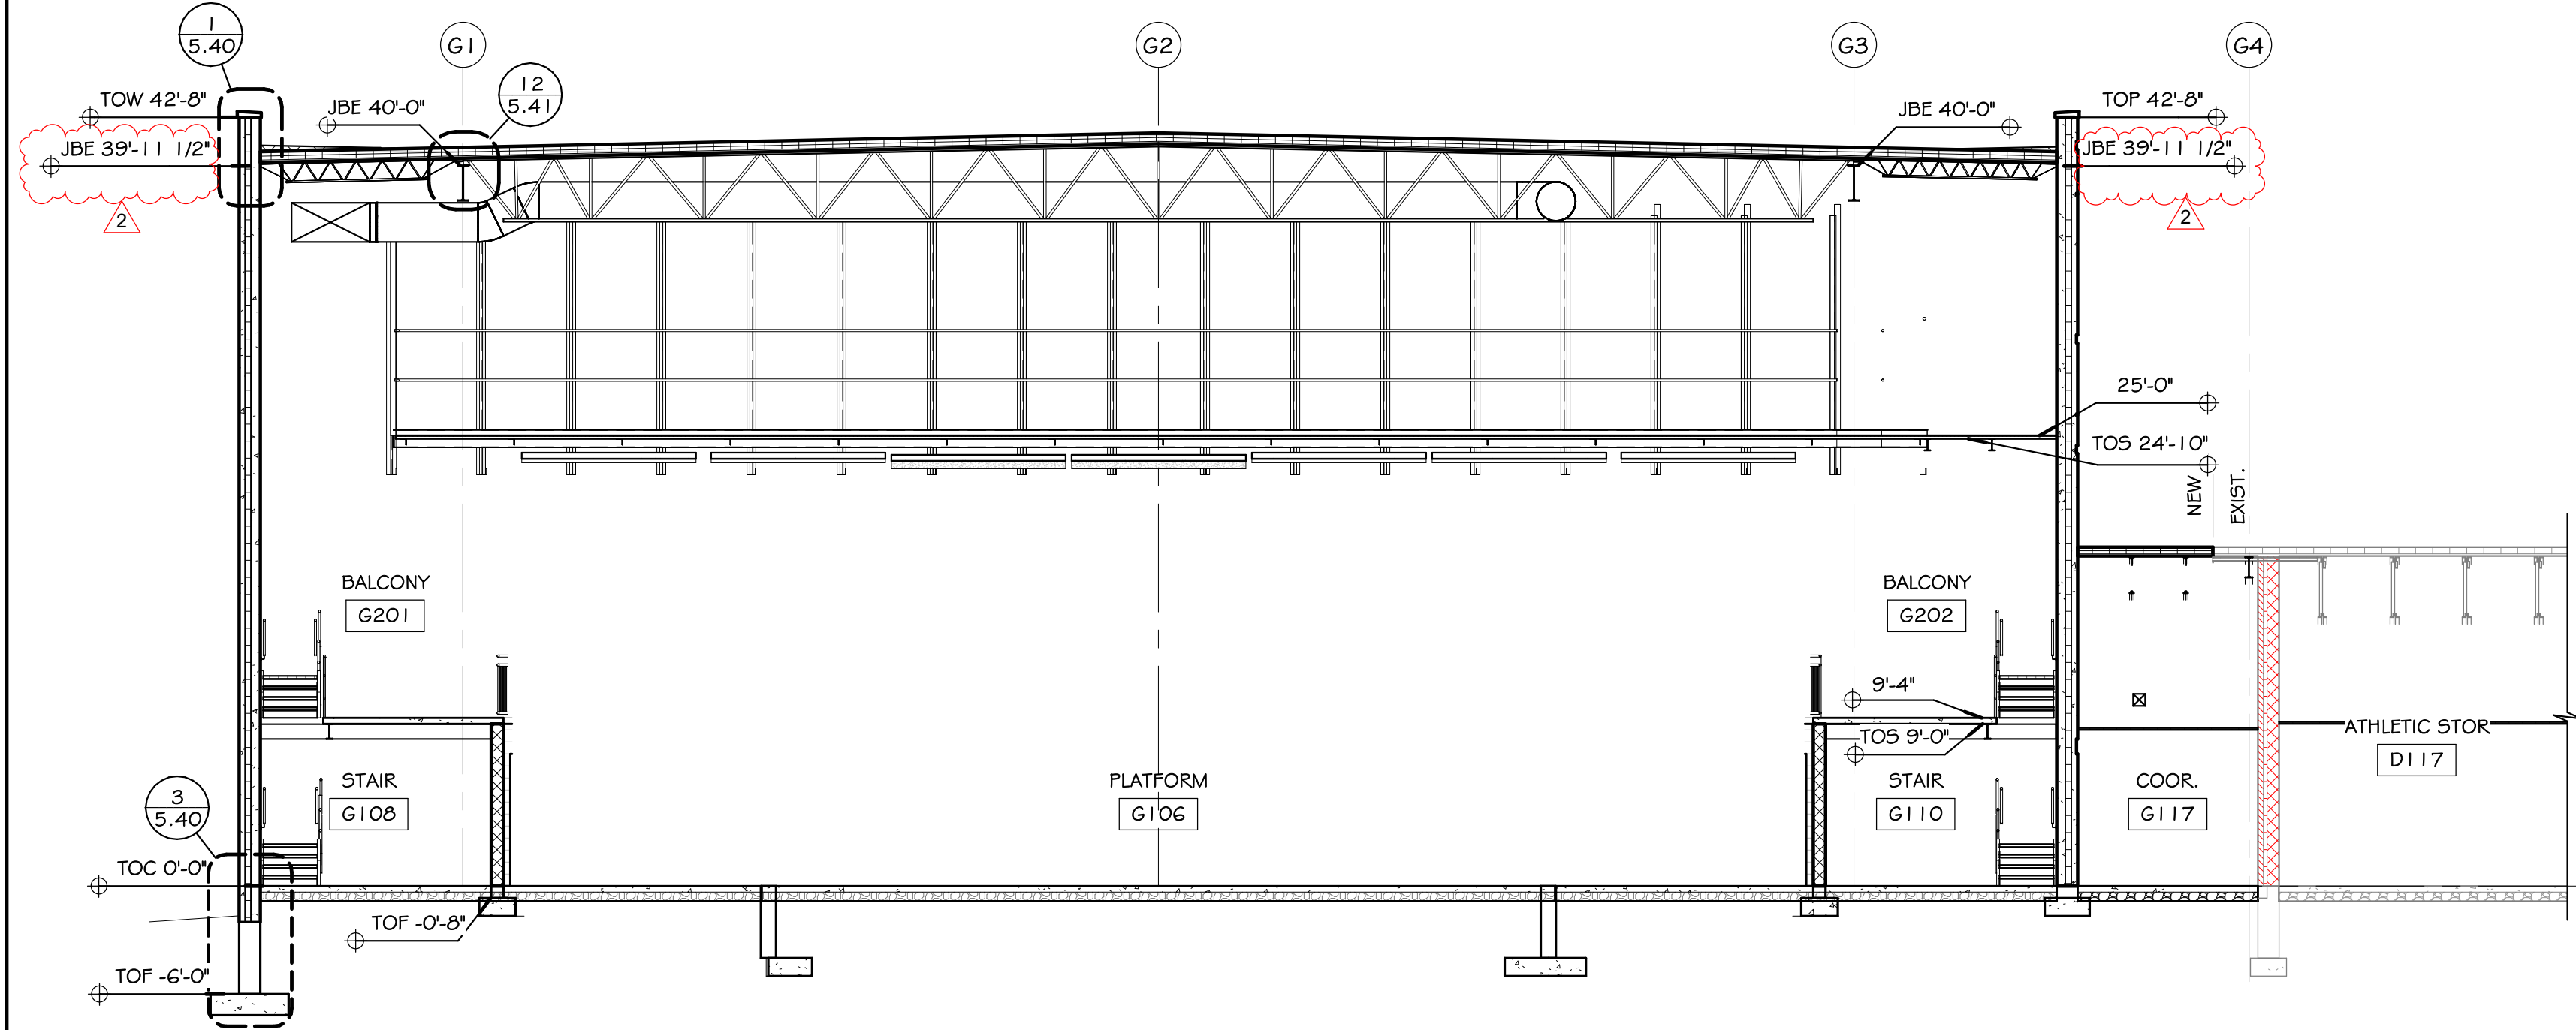


**B** BUILDING SECTION - AREA G  
SCALE: 1/8" = 1'-0"

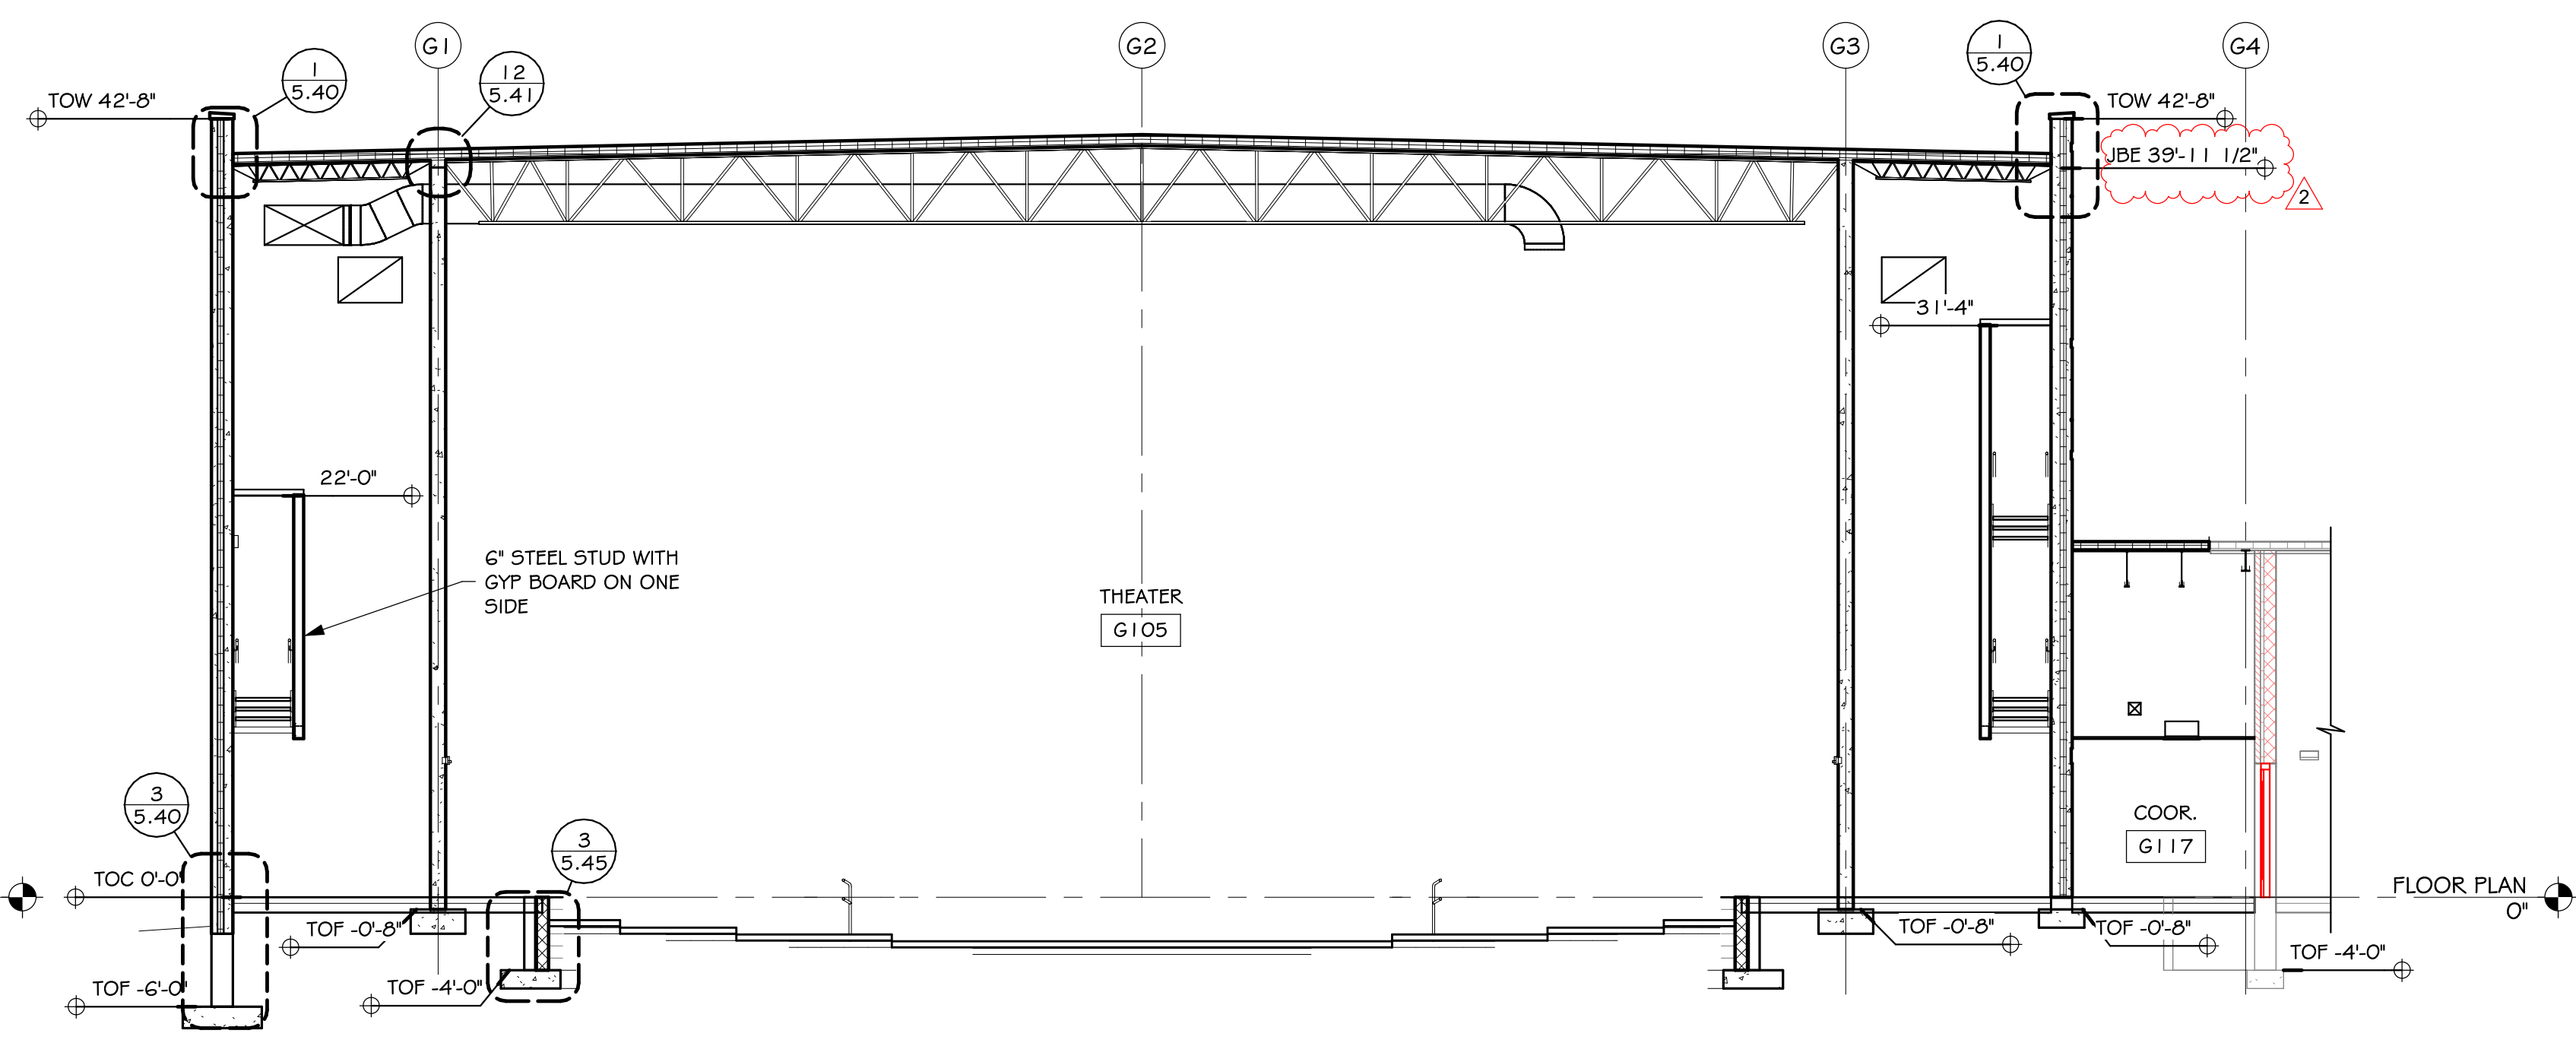


**C** BUILDING SECTION - AREA G  
SCALE: 1/8" = 1'-0"

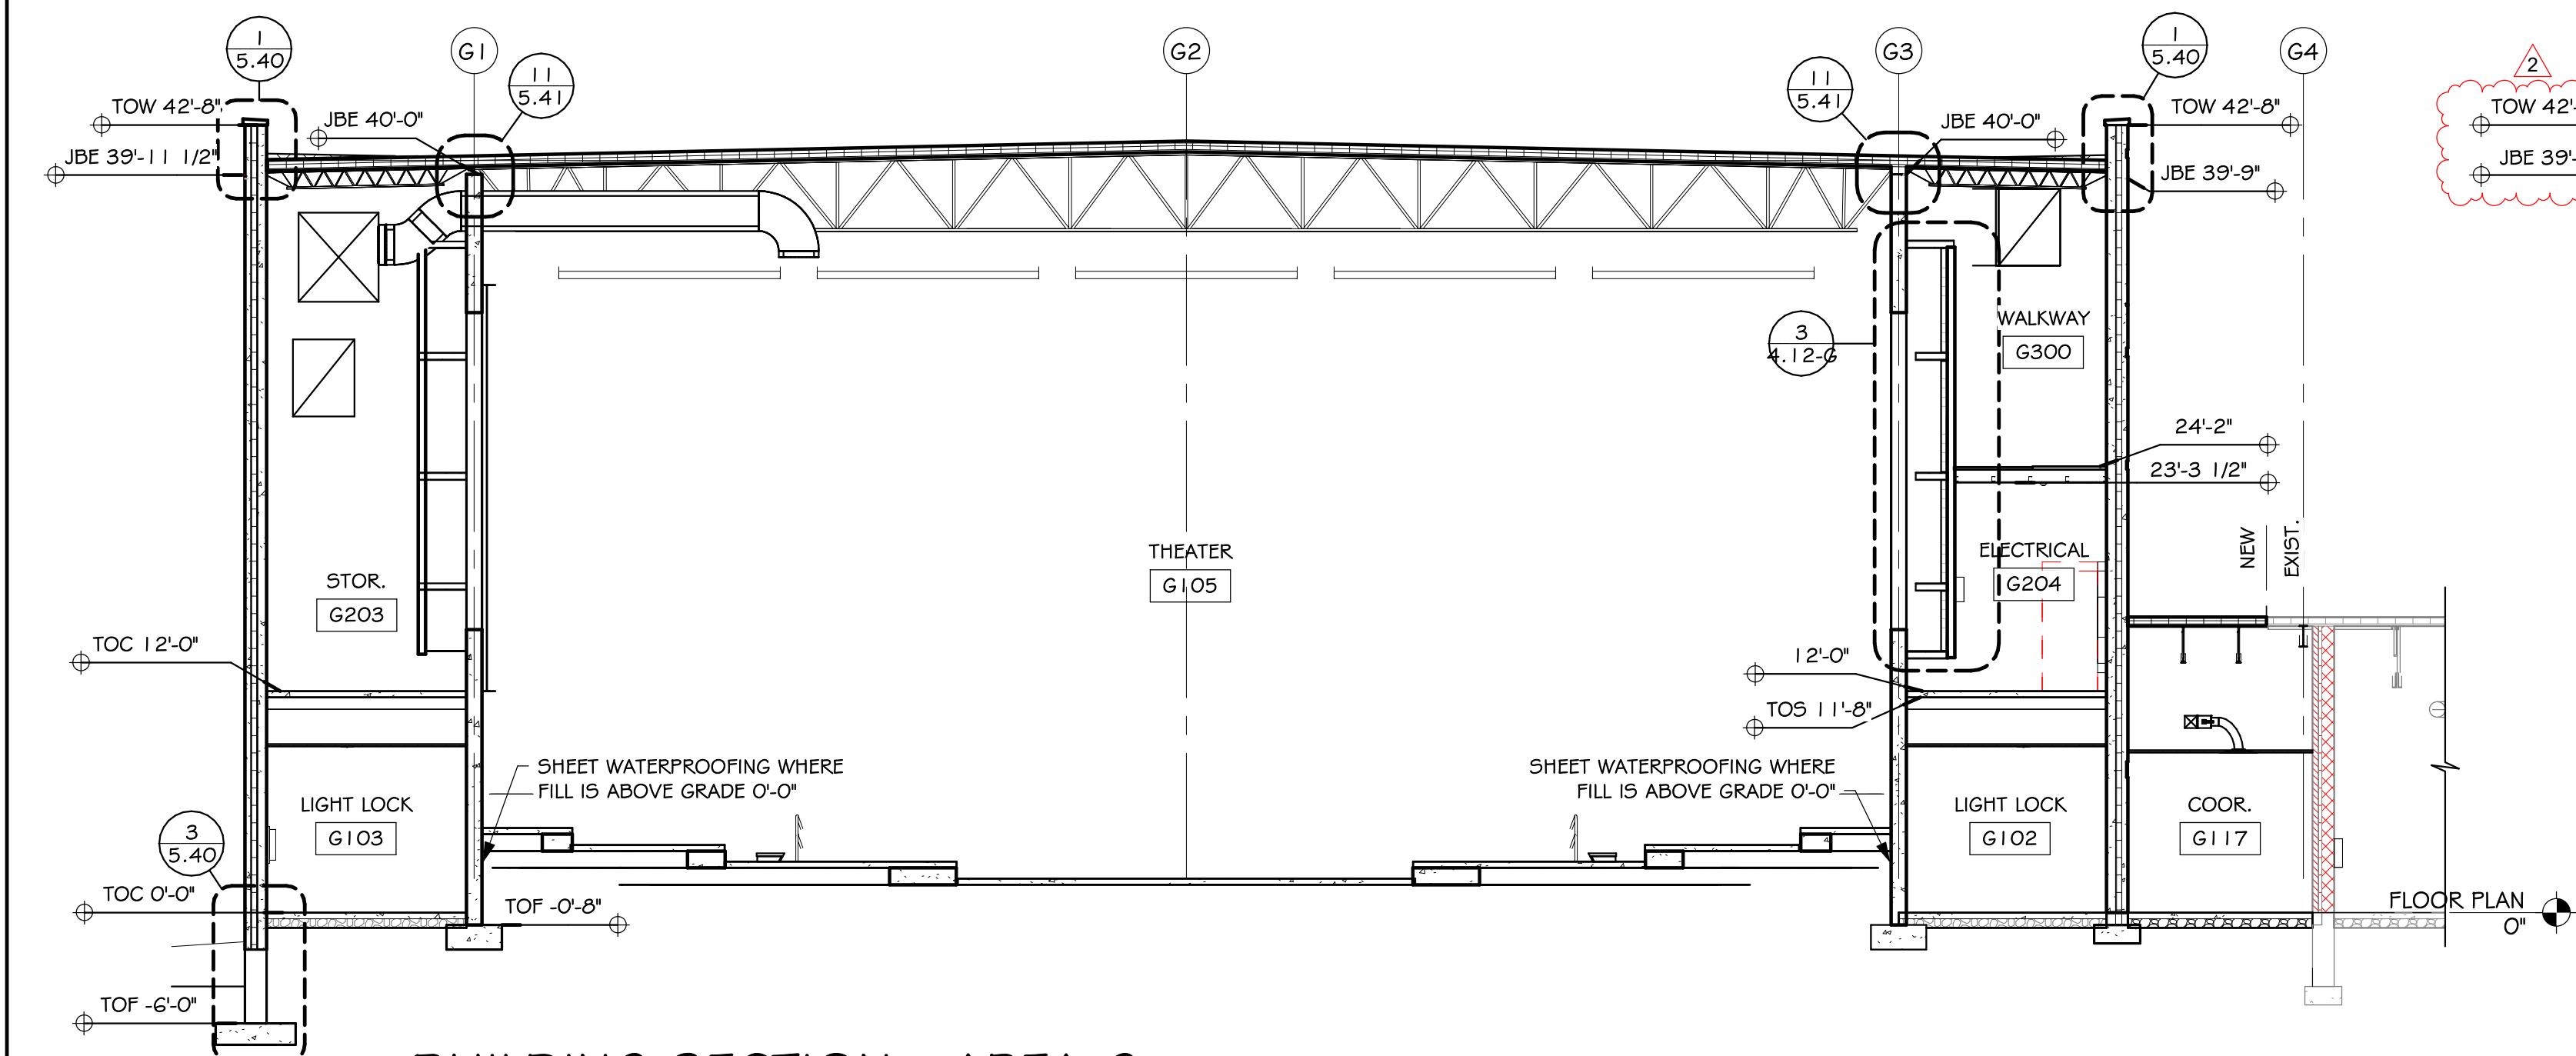


**D** BUILDING SECTION - AREA G  
SCALE: 1/8" = 1'-0"

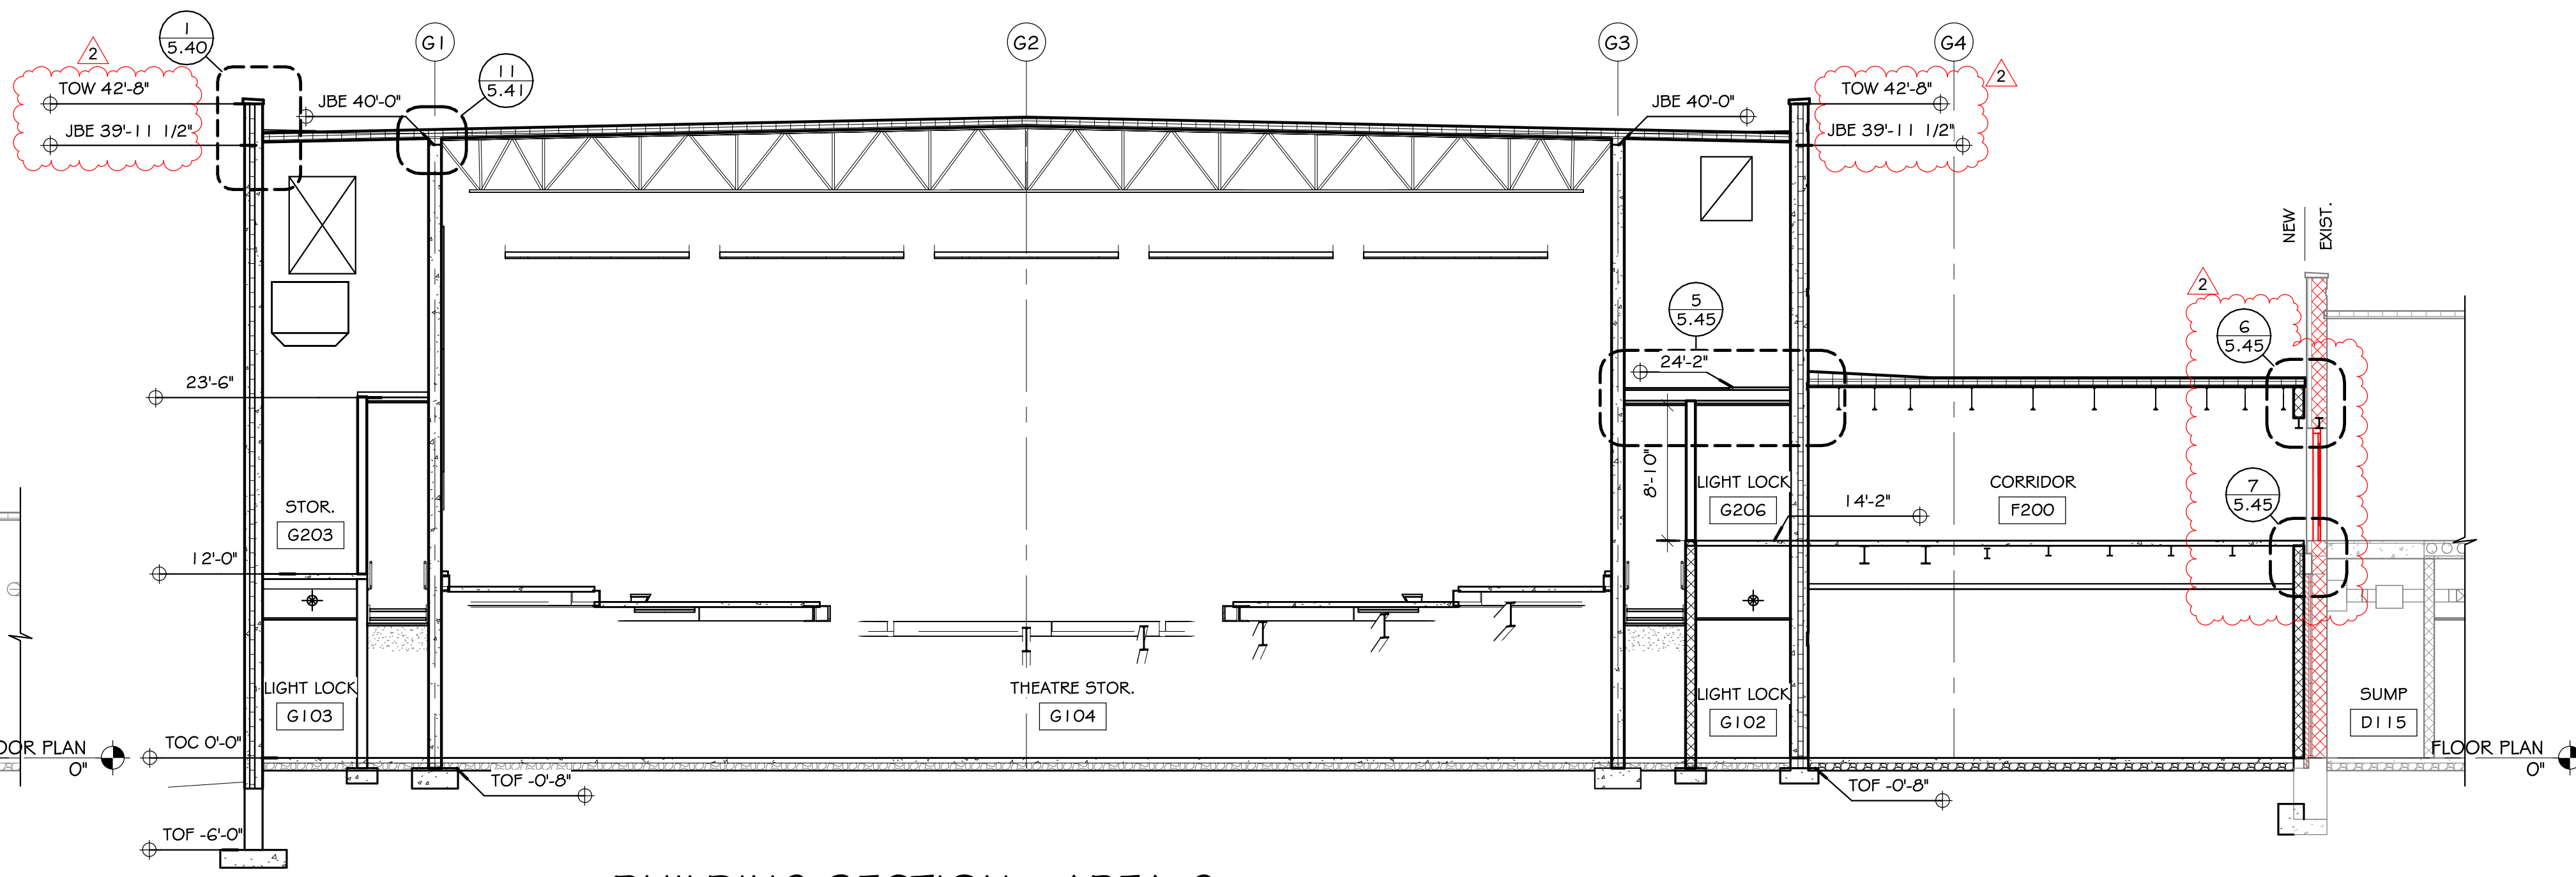

**E** BUILDING SECTION - AREA G  
SCALE: 1/8" = 1'-0"

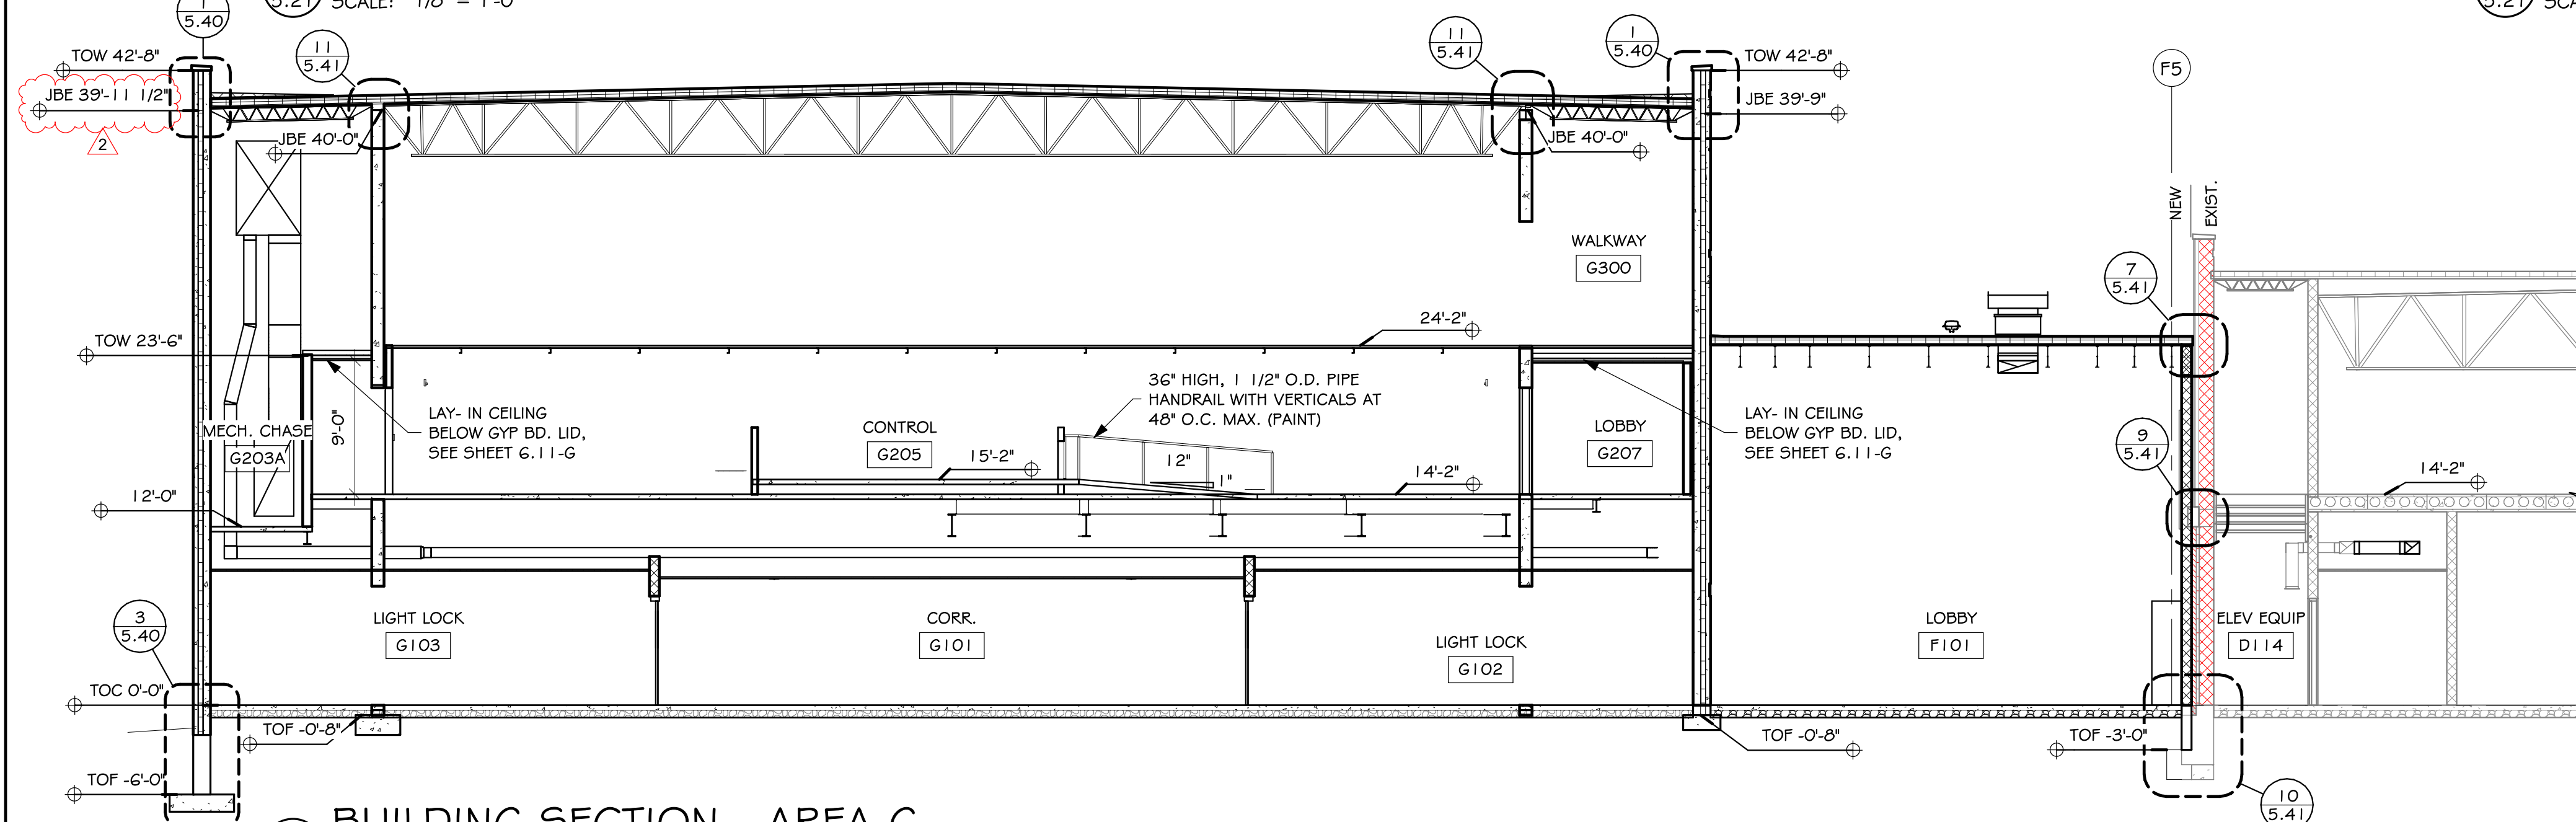


**F** BUILDING SECTION - AREA G  
SCALE: 1/8" = 1'-0"

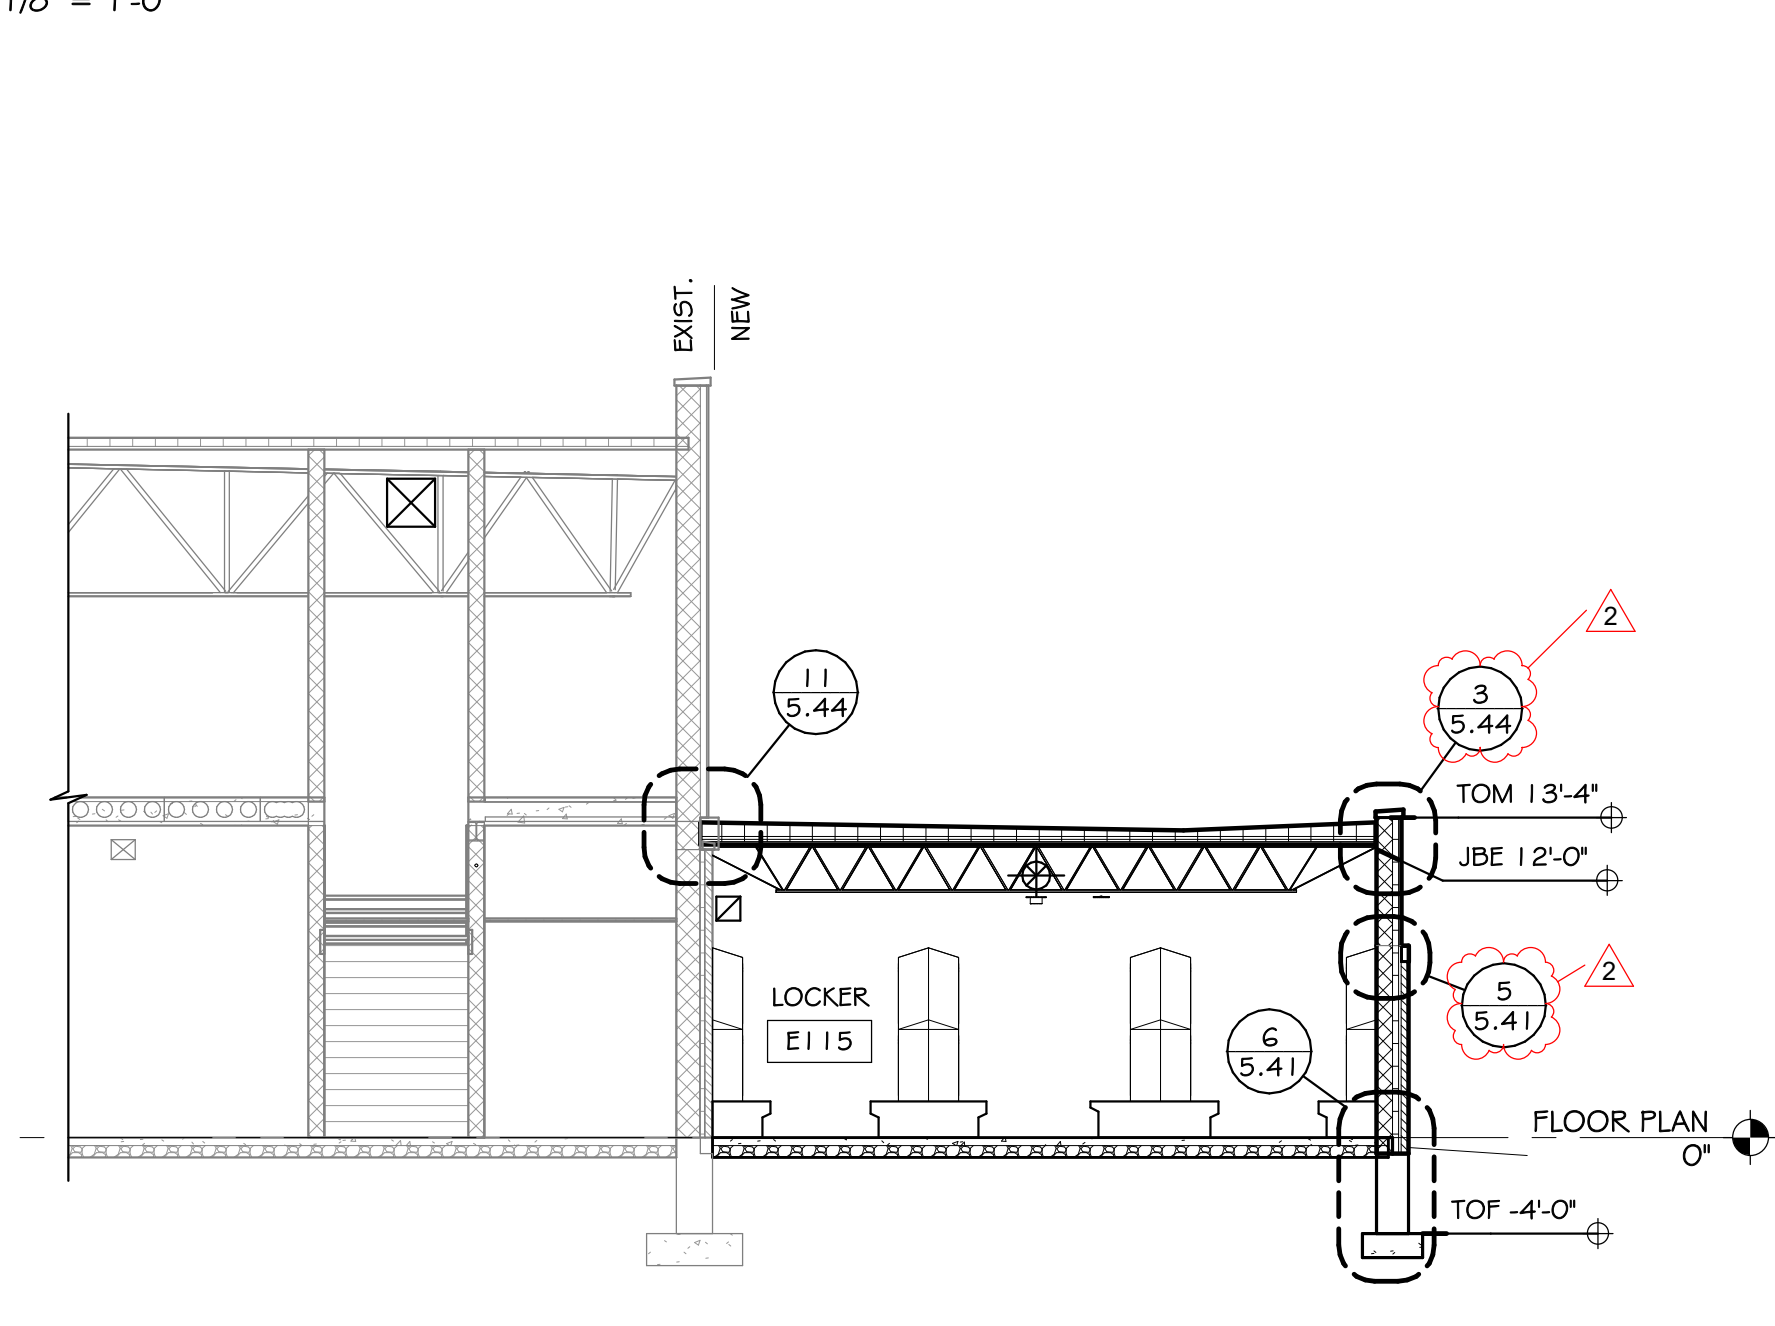

**BUILDING SECTIONS**

a. GENERAL CONTRACTOR SHALL VERIFY ALL EXISTING CONDITIONS AND DIMENSIONS AT THE JOB SITE. REPORT DISCREPANCIES TO THE ARCHITECT.

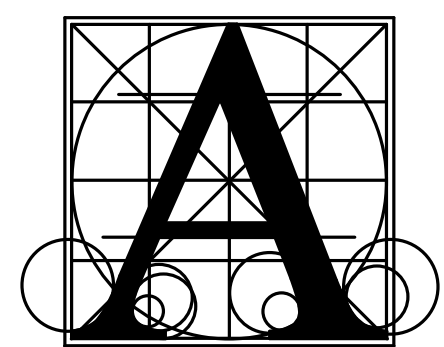

**Architecture Incorporated**  
415 South Main Avenue  
P.O. Box 2140  
Sioux Falls, South Dakota 57101  
Phone: (605) 339-1711

815 St. Joseph Street, Suite 203  
Rapid City, South Dakota 57701  
Phone: (605) 721-1158




**LENNOX HIGH SCHOOL ADDITION**

**BUILDING SECTIONS**

Project	number	0215.2982.22
	date	DECEMBER 21, 2023
	revision	
	drawn	SWP
	checked	SRJ
	DATE	1/18/2024
	DESCRIPTION	ADDENDUM #2



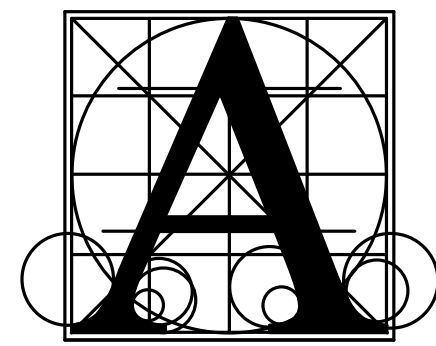

Architecture  
Incorporated

415 South Main Avenue  
P.O. Box 2140  
Sioux Falls, South Dakota 57101  
Phone: (605) 339-1711

815 St. Joseph Street, Suite 203  
Rapid City, South Dakota 57701  
Phone: (605) 721-1158



LENNOX HIGH SCHOOL ADDITION

BUILDING SECTIONS


number 0215.2902.22  
date DECEMBER 21, 2023  
revision  
drawn SWP checked SRJ

DATE 1/18/2024 DESCRIPTION ADDENDUM #2


5.22

BUILDING SECTIONS


a. GENERAL CONTRACTOR SHALL VERIFY ALL EXISTING CONDITIONS AND DIMENSIONS AT THE JOB SITE. REPORT DISCREPANCIES TO THE ARCHITECT.

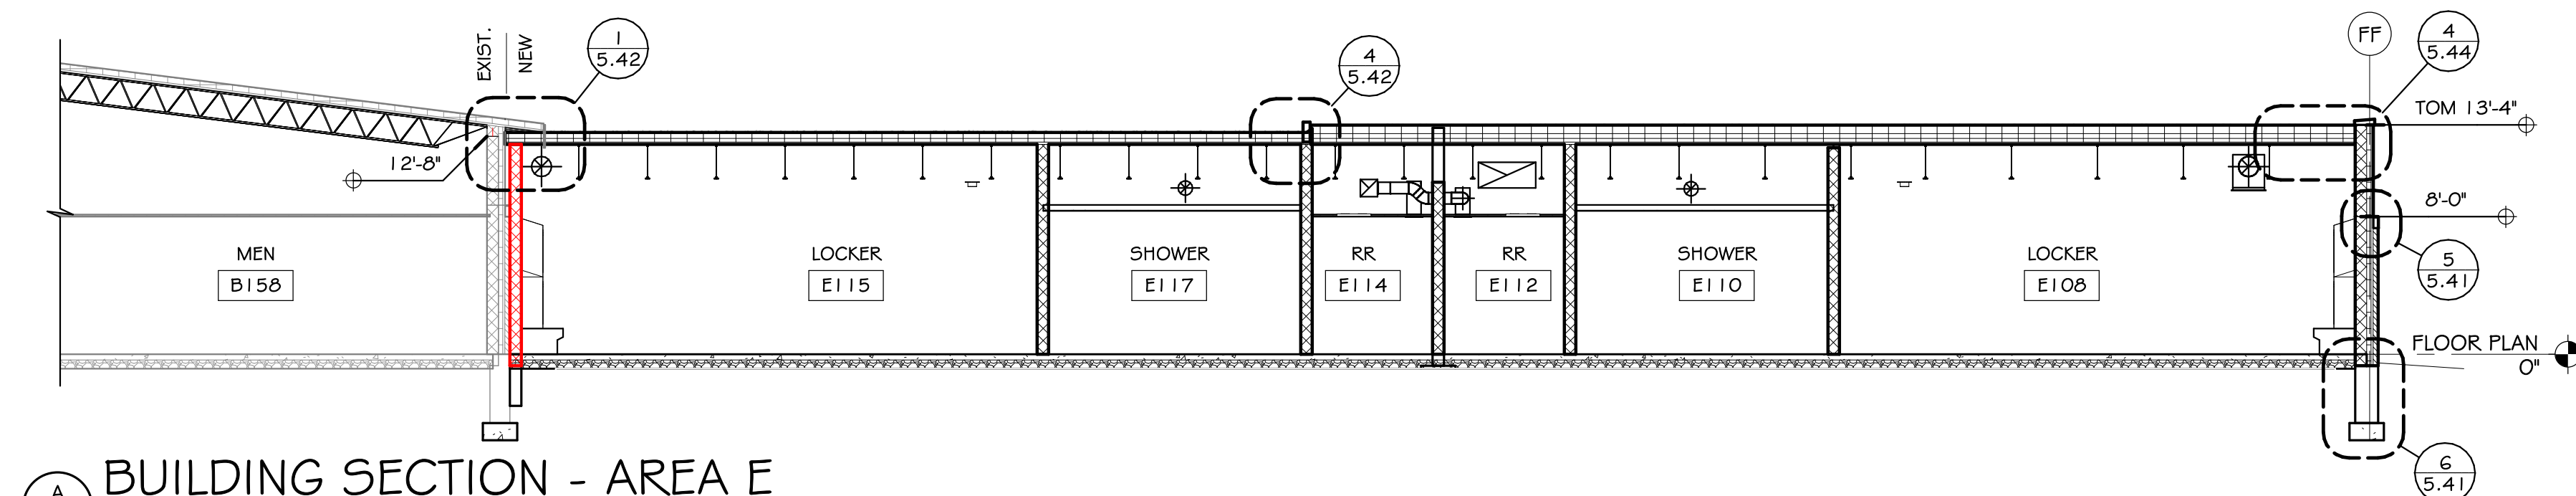


A BUILDING SECTION - AREA E  
5.22 SCALE: 1/8" = 1'-0"

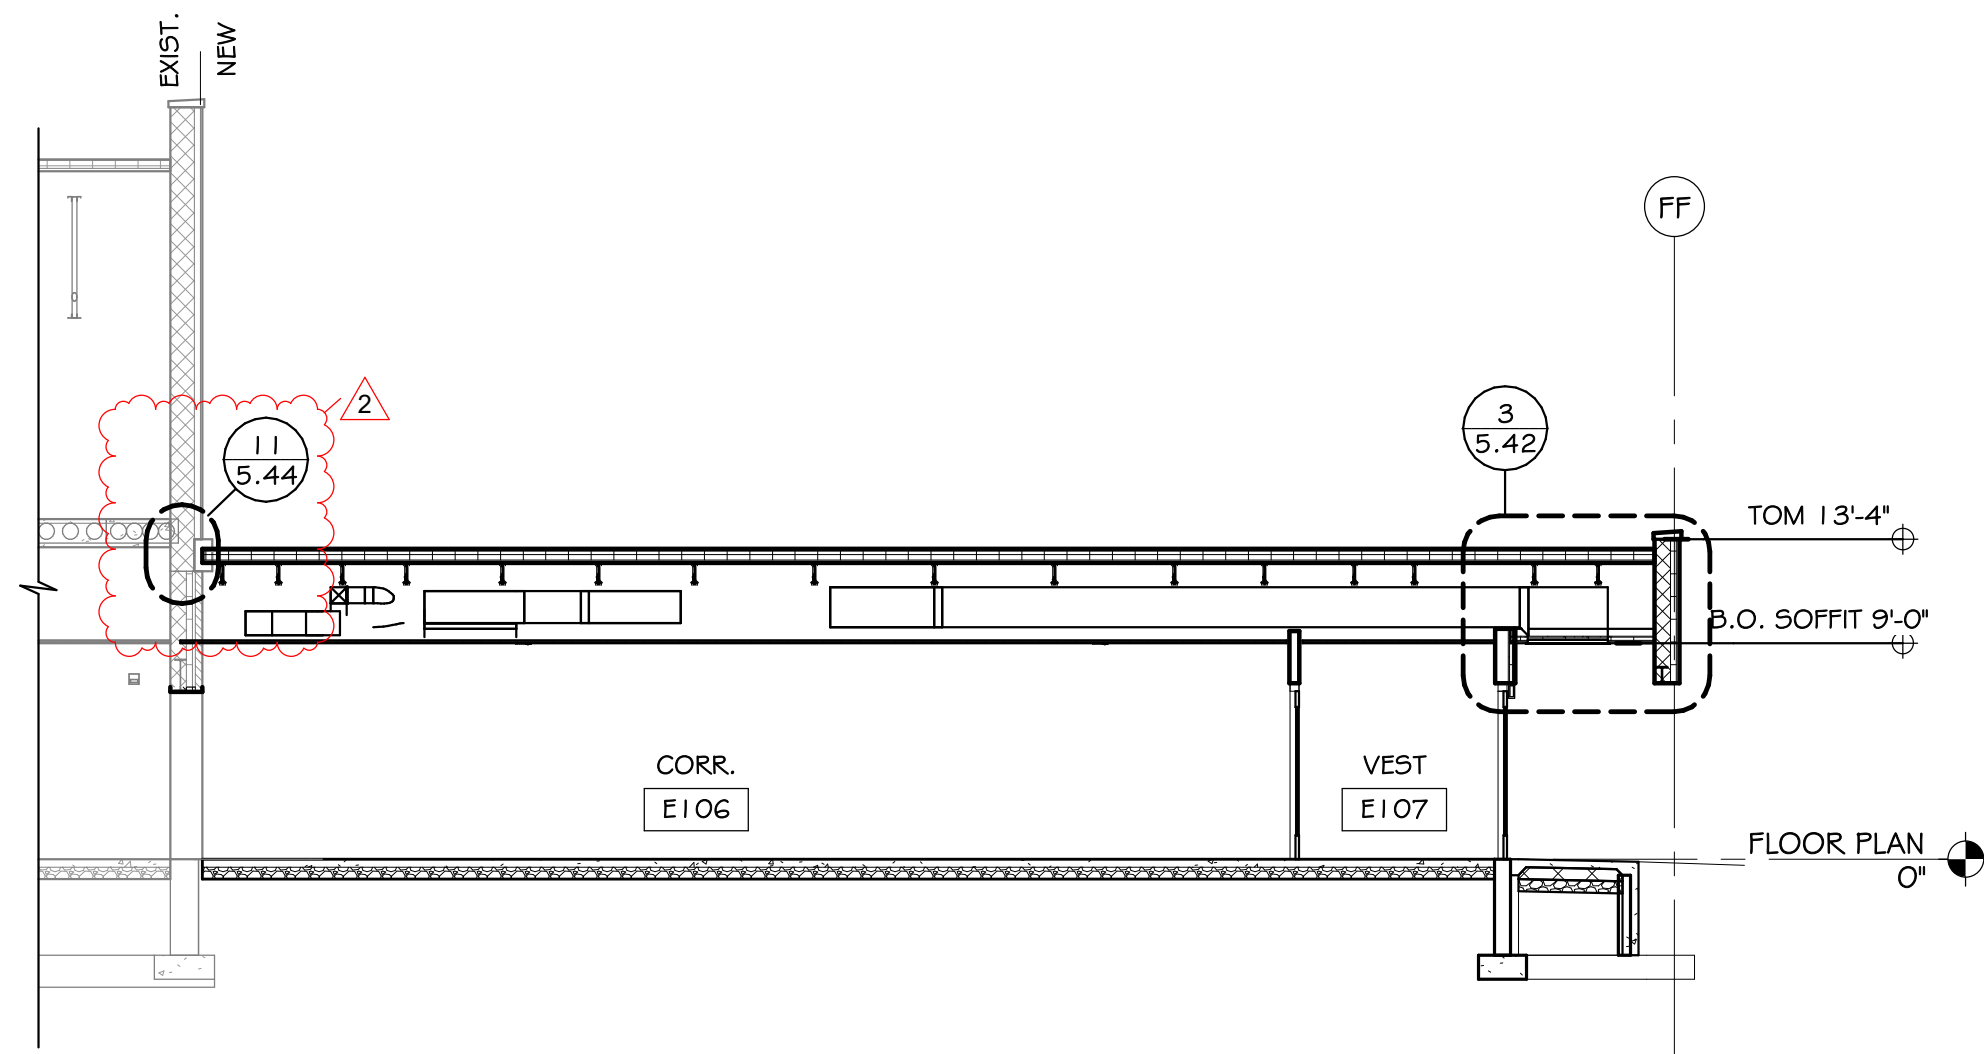


B BUILDING SECTION - AREA E  
5.22 SCALE: 1/8" = 1'-0"

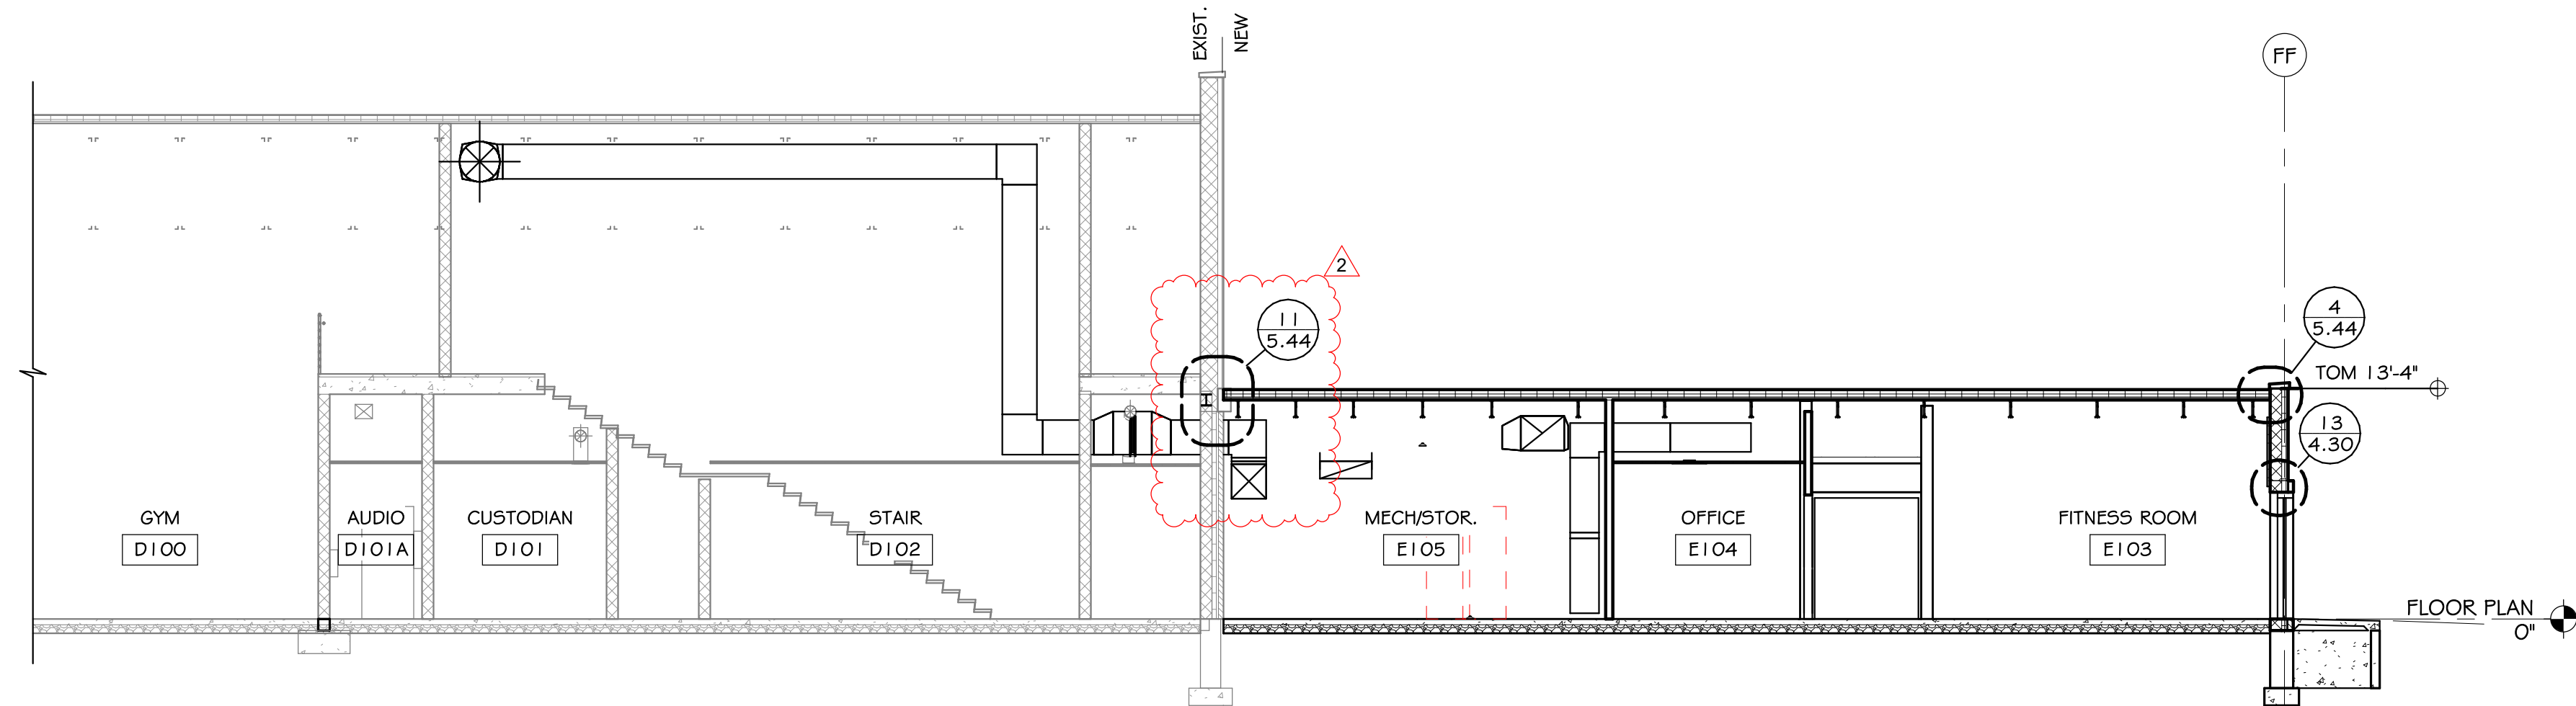


C BUILDING SECTION - AREA D & E  
5.22 SCALE: 1/8" = 1'-0"

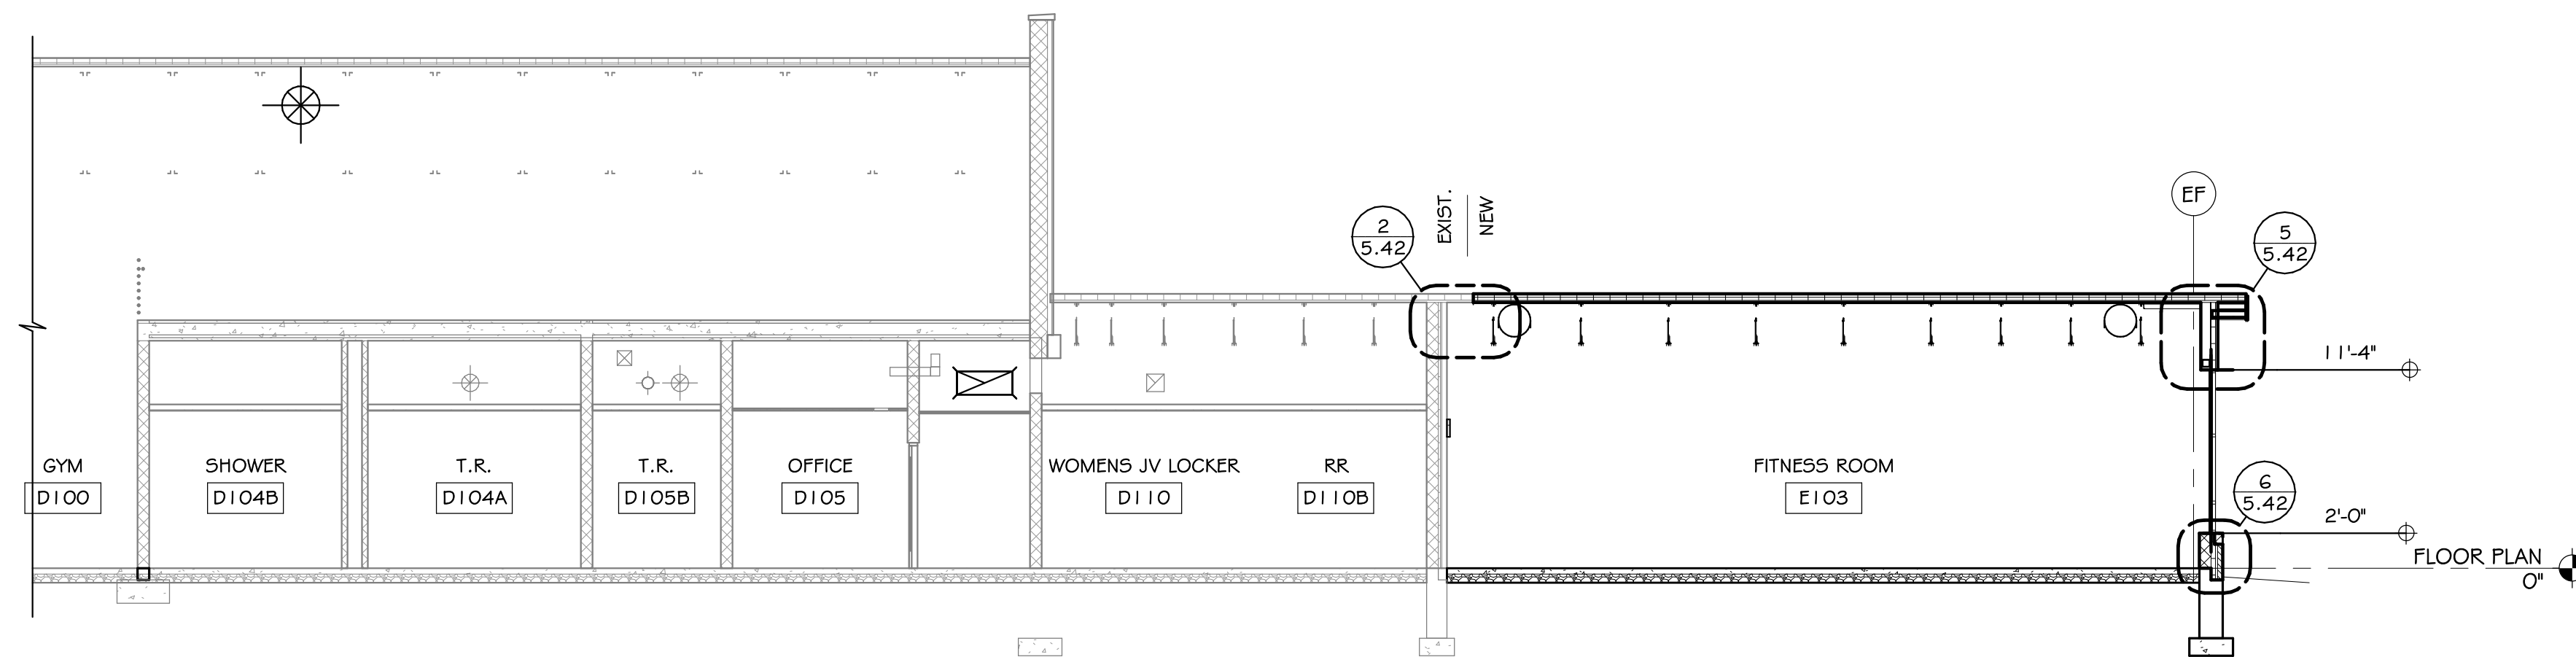


D BUILDING SECTION - AREA D & E  
5.22 SCALE: 1/8" = 1'-0"

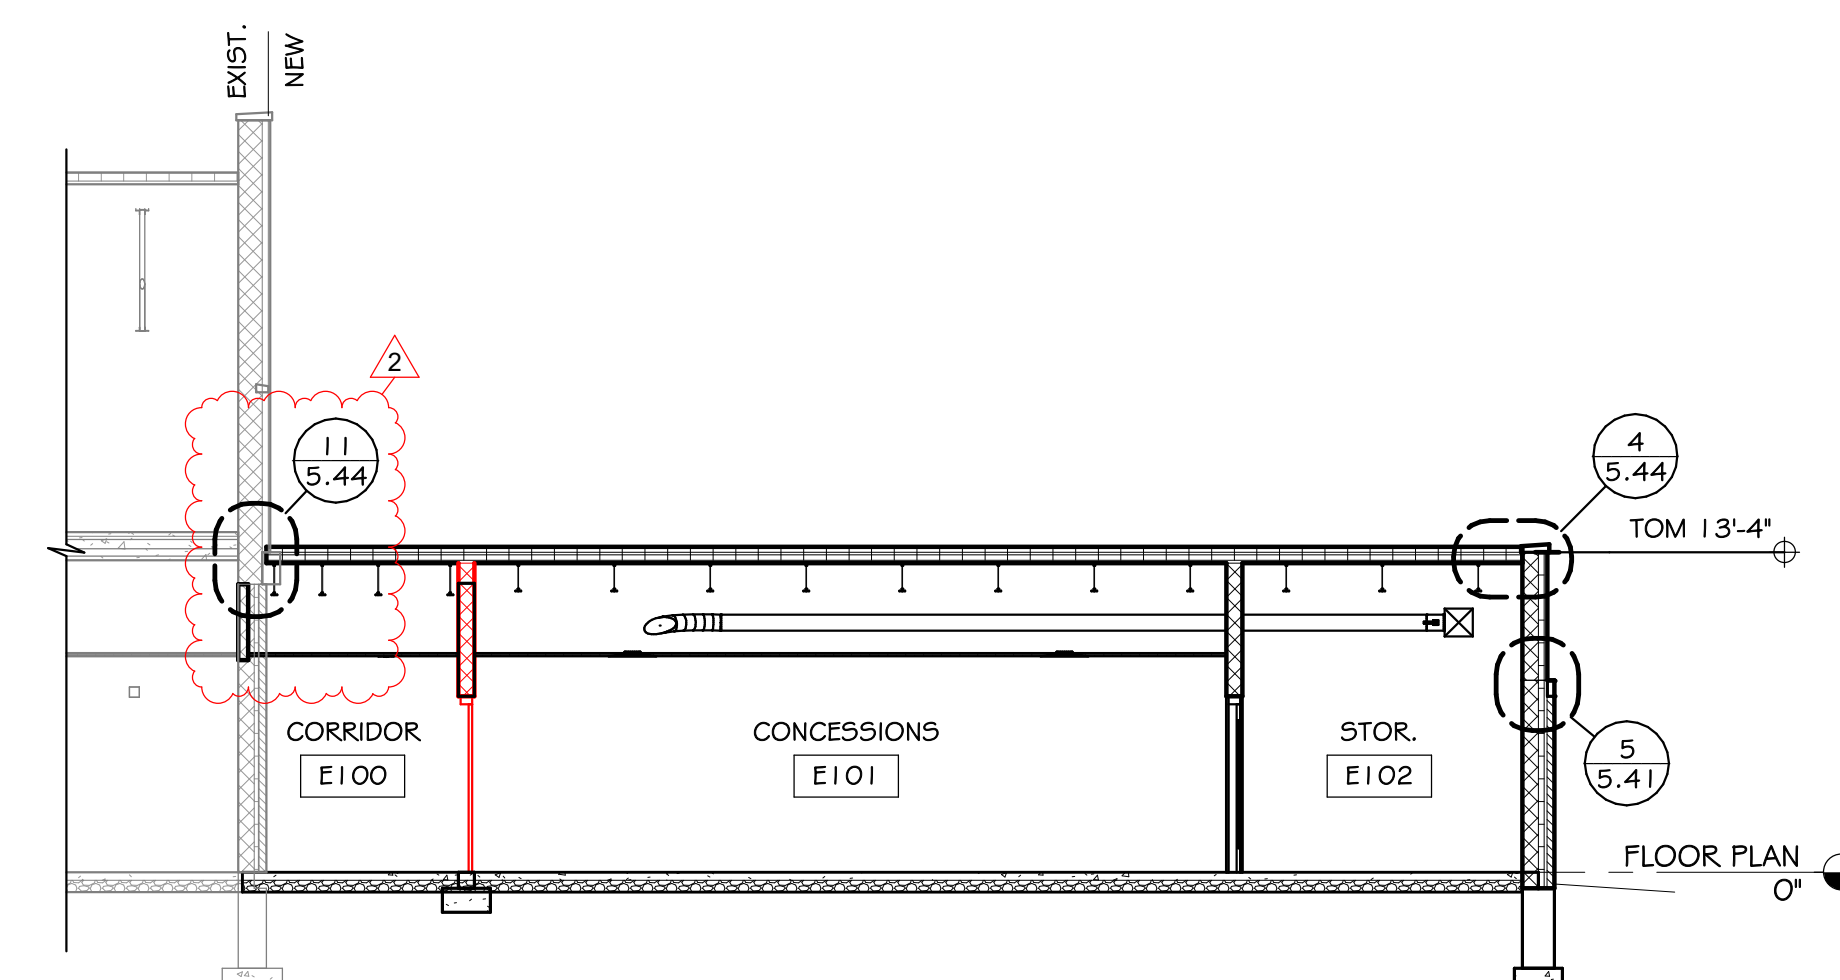

E BUILDING SECTION - AREA E  
5.22 SCALE: 1/8" = 1'-0"

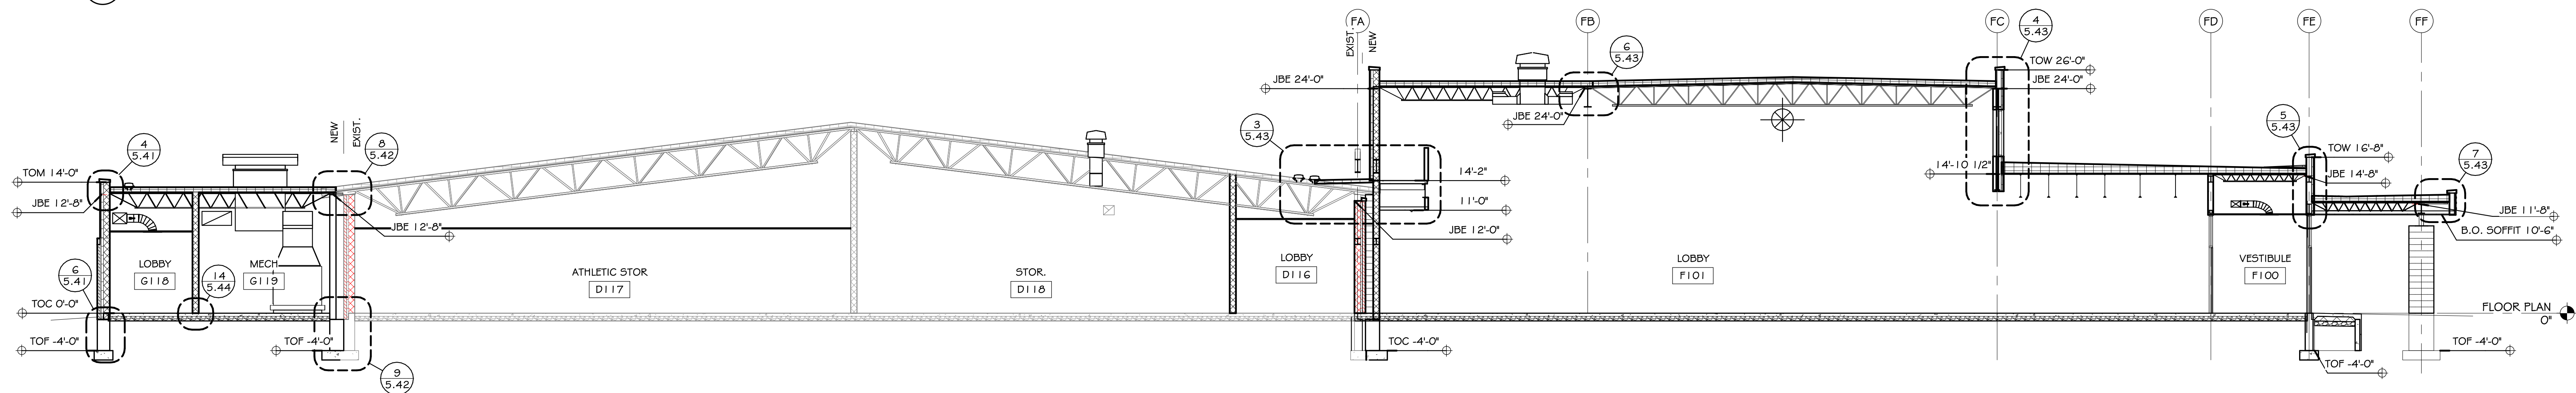


F BUILDING SECTION - ARE D & F  
5.22 SCALE: 1/8" = 1'-0"

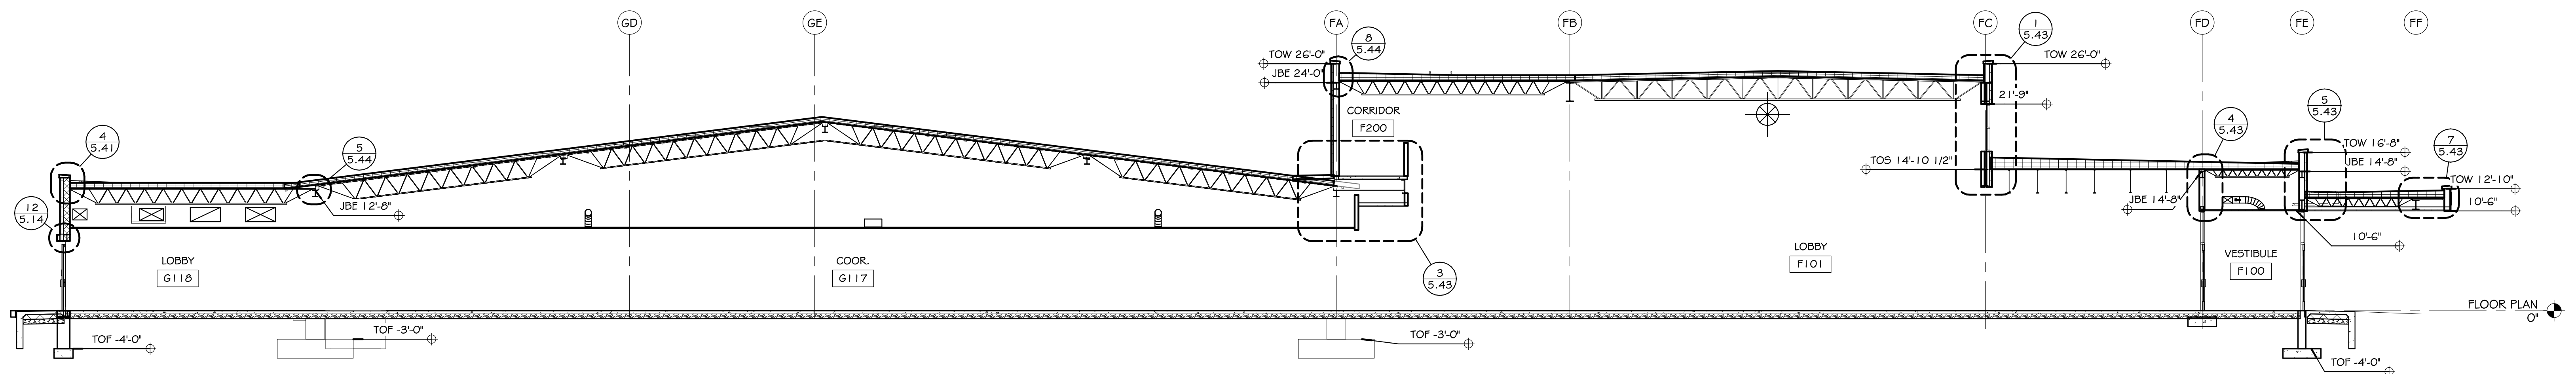


G BUILDING SECTION - AREA F  
5.22 SCALE: 1/8" = 1'-0"




1/18/2024 5:11:40 PM

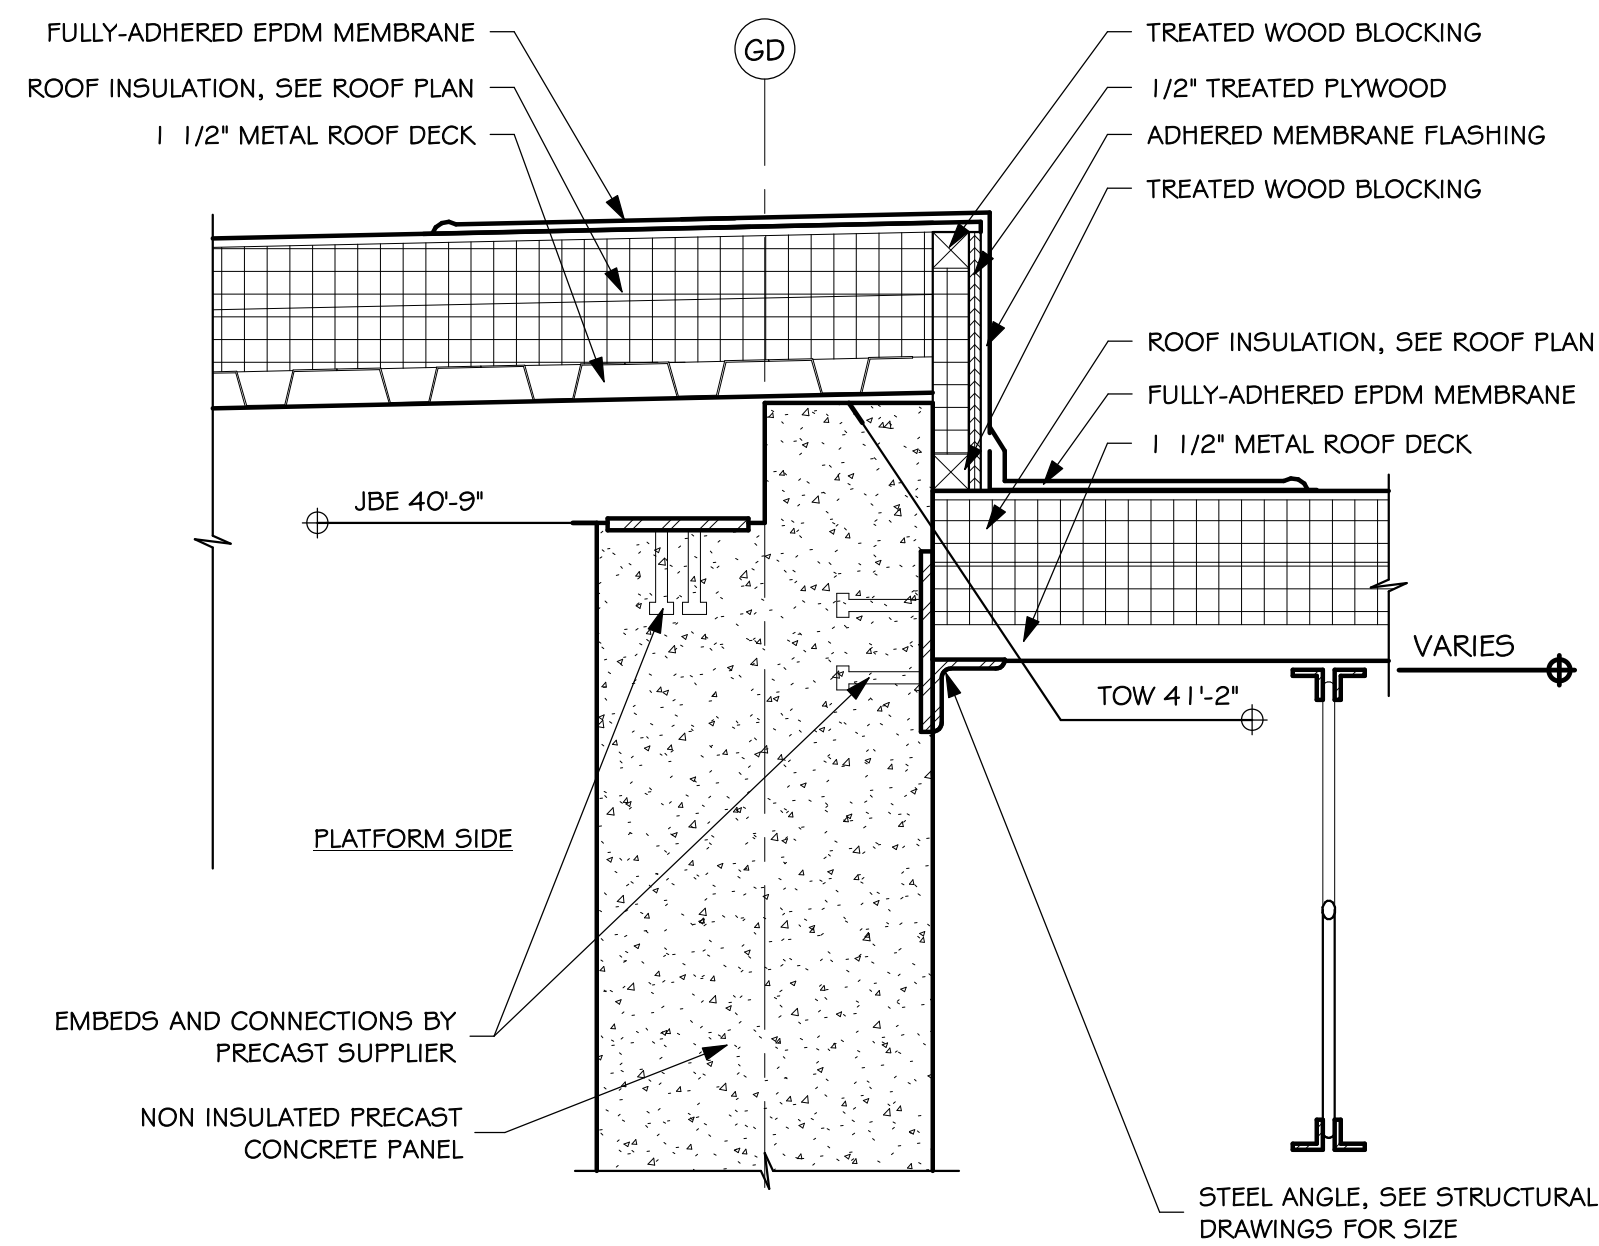


1  
5.41  
DETAIL - AREA G  
SCALE: 1 1/2" = 1'-0"

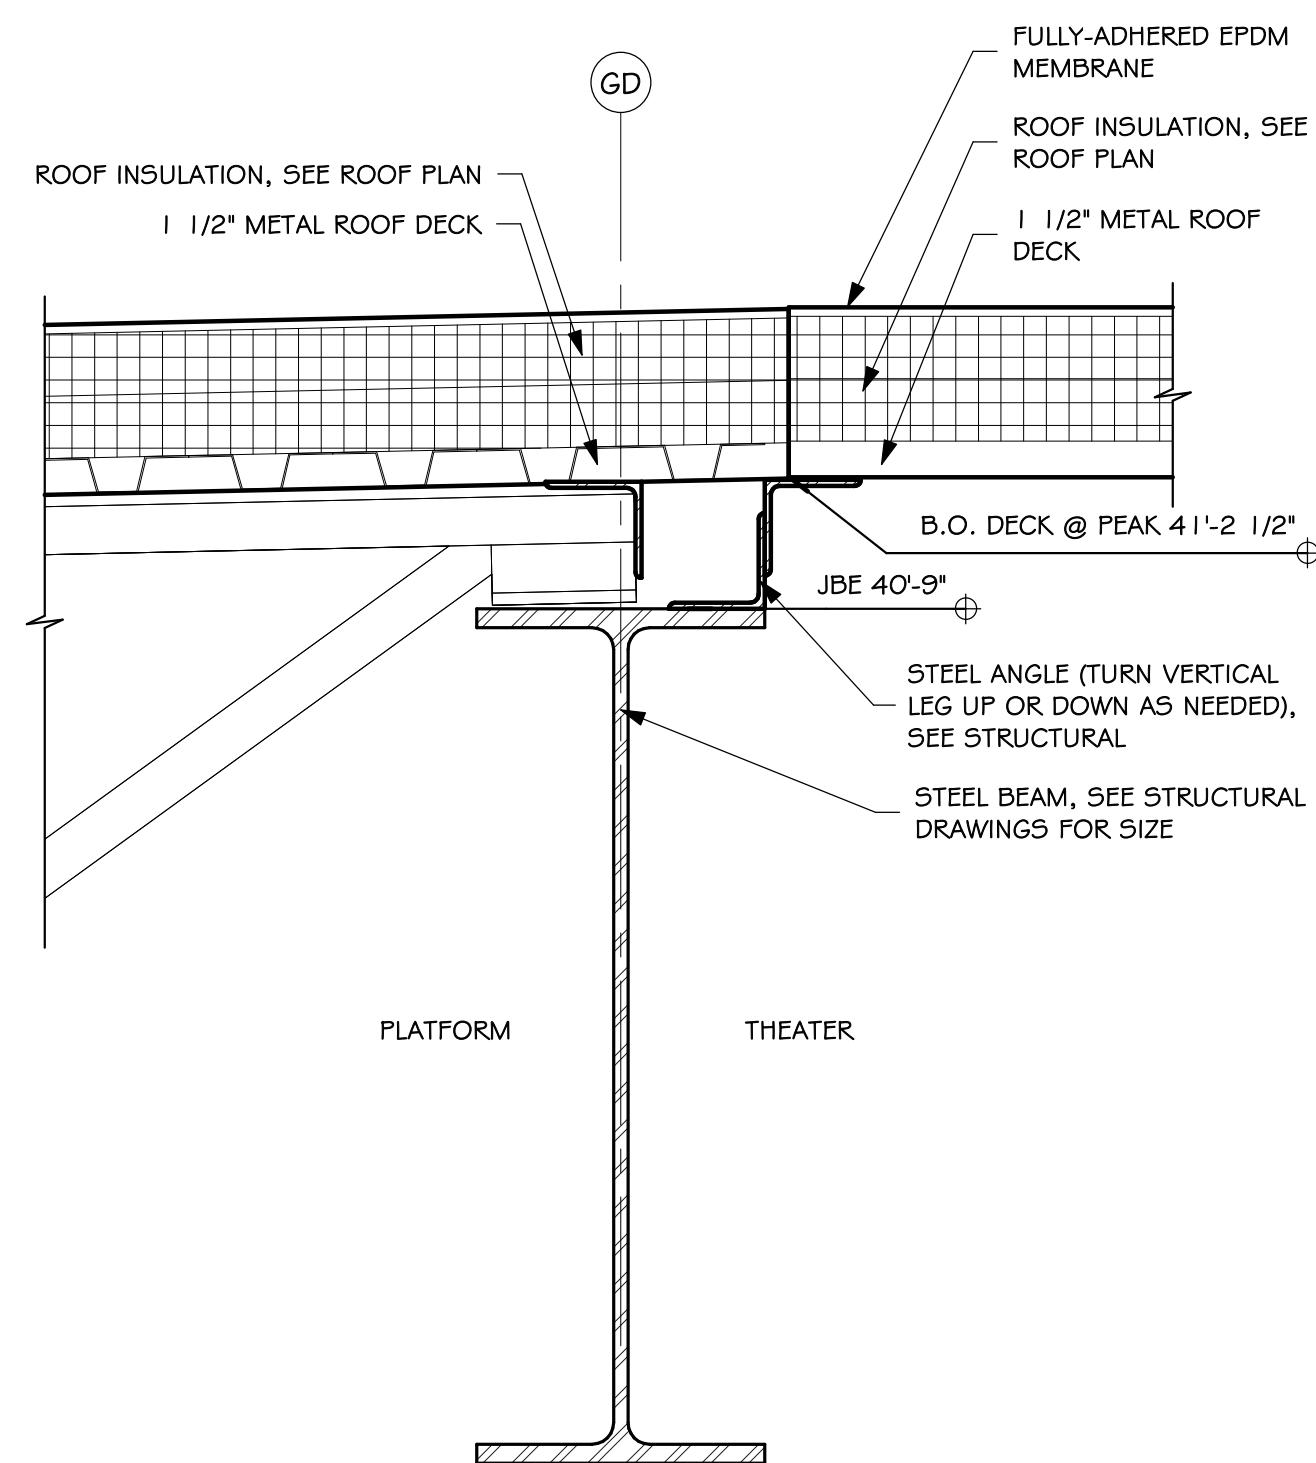


2  
5.41  
DETAIL - AREA G  
SCALE: 1 1/2" = 1'-0"

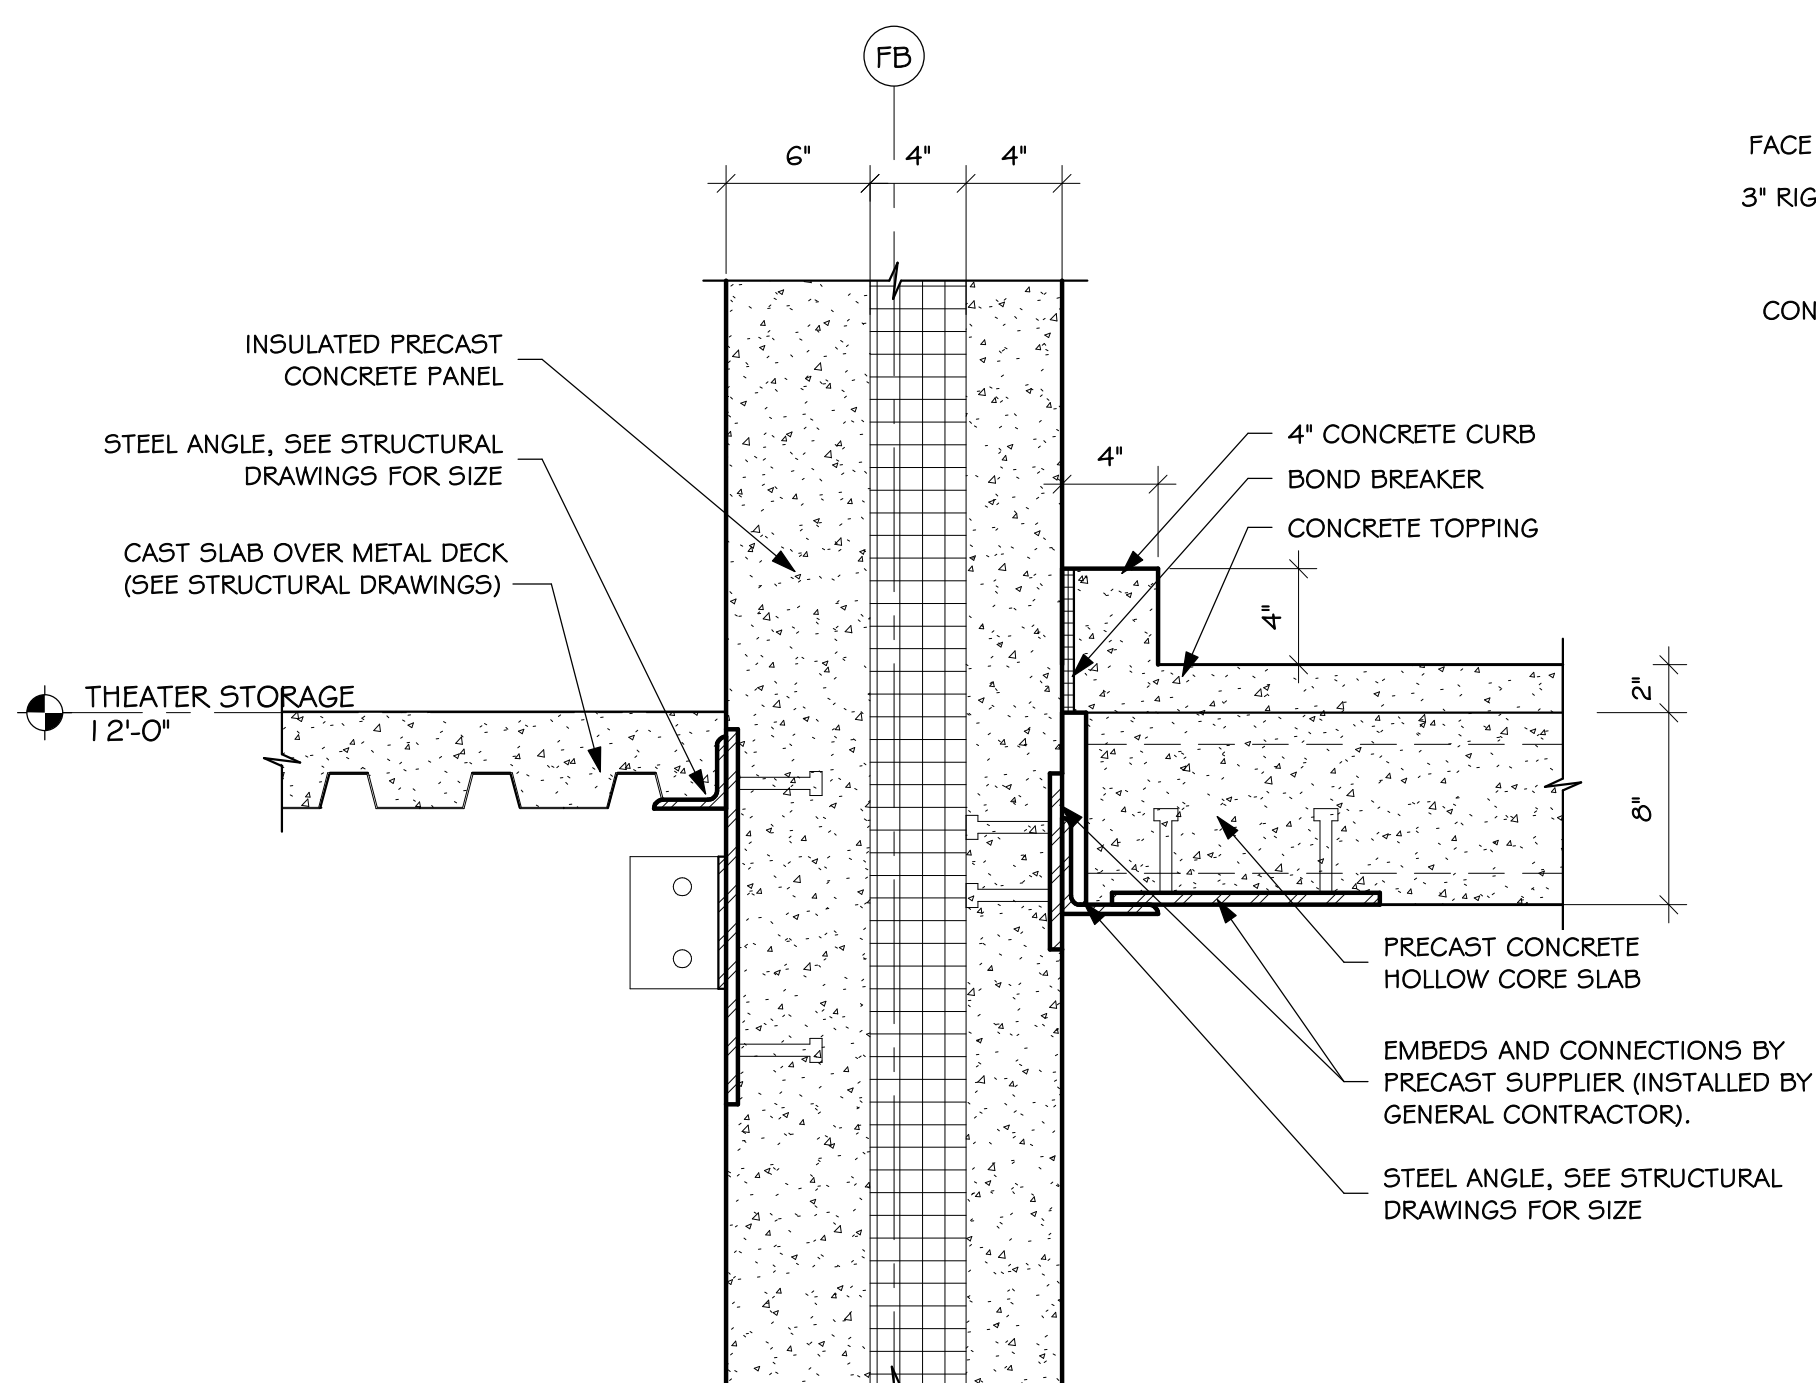


3  
5.41  
DETAIL - AREA G  
SCALE: 1 1/2" = 1'-0"

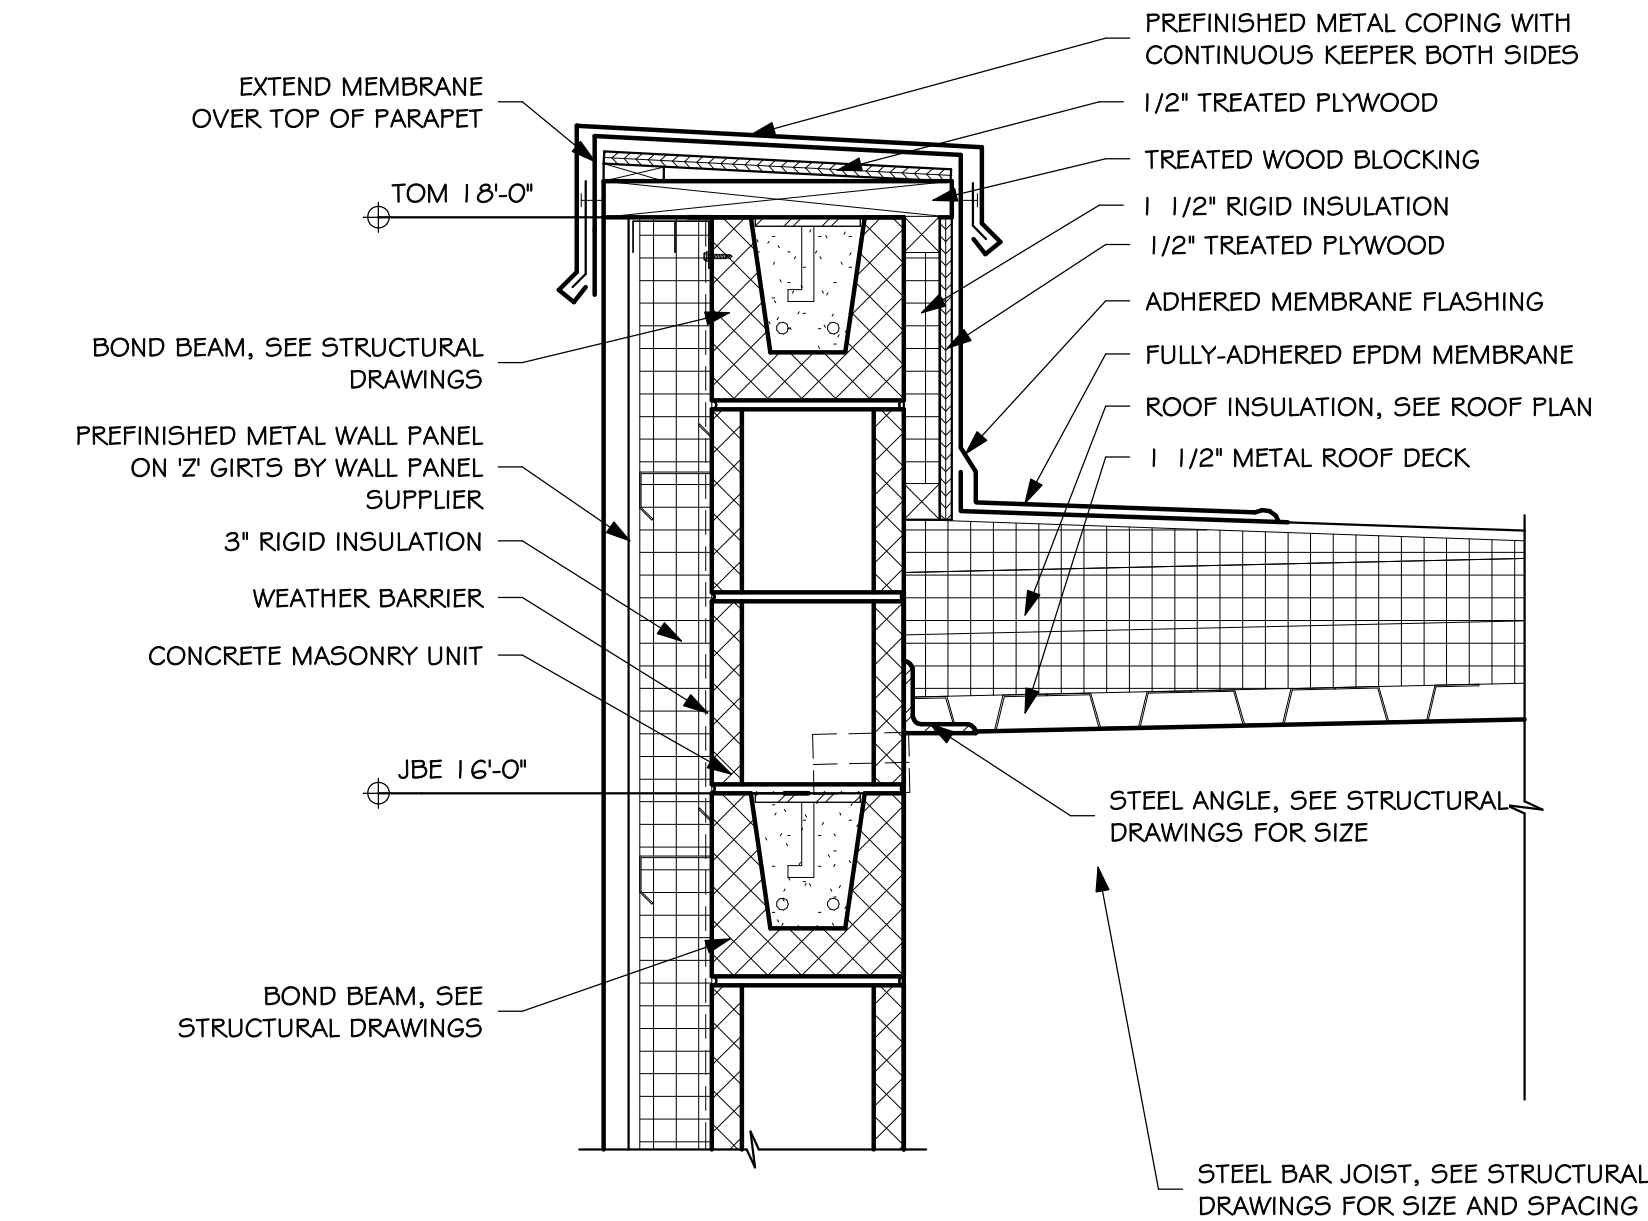


4  
5.41  
DETAIL - AREA G  
SCALE: 1 1/2" = 1'-0"

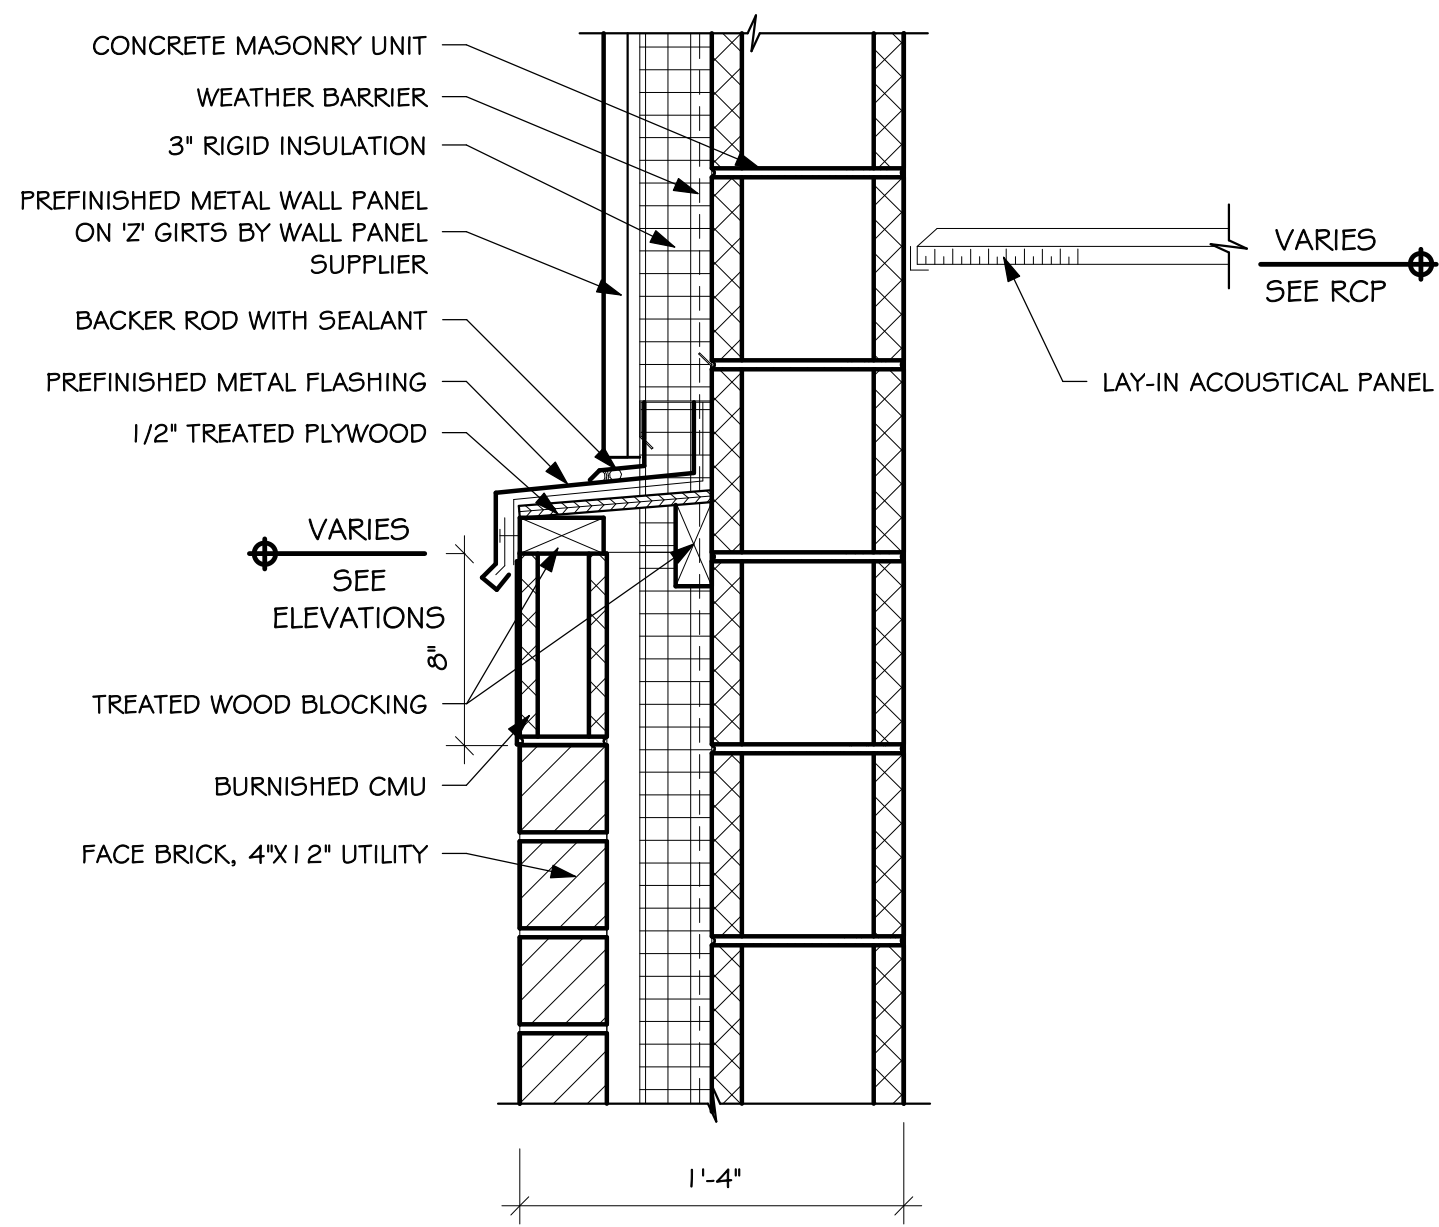


5  
5.41  
DETAIL - TYPICAL  
SCALE: 1 1/2" = 1'-0"

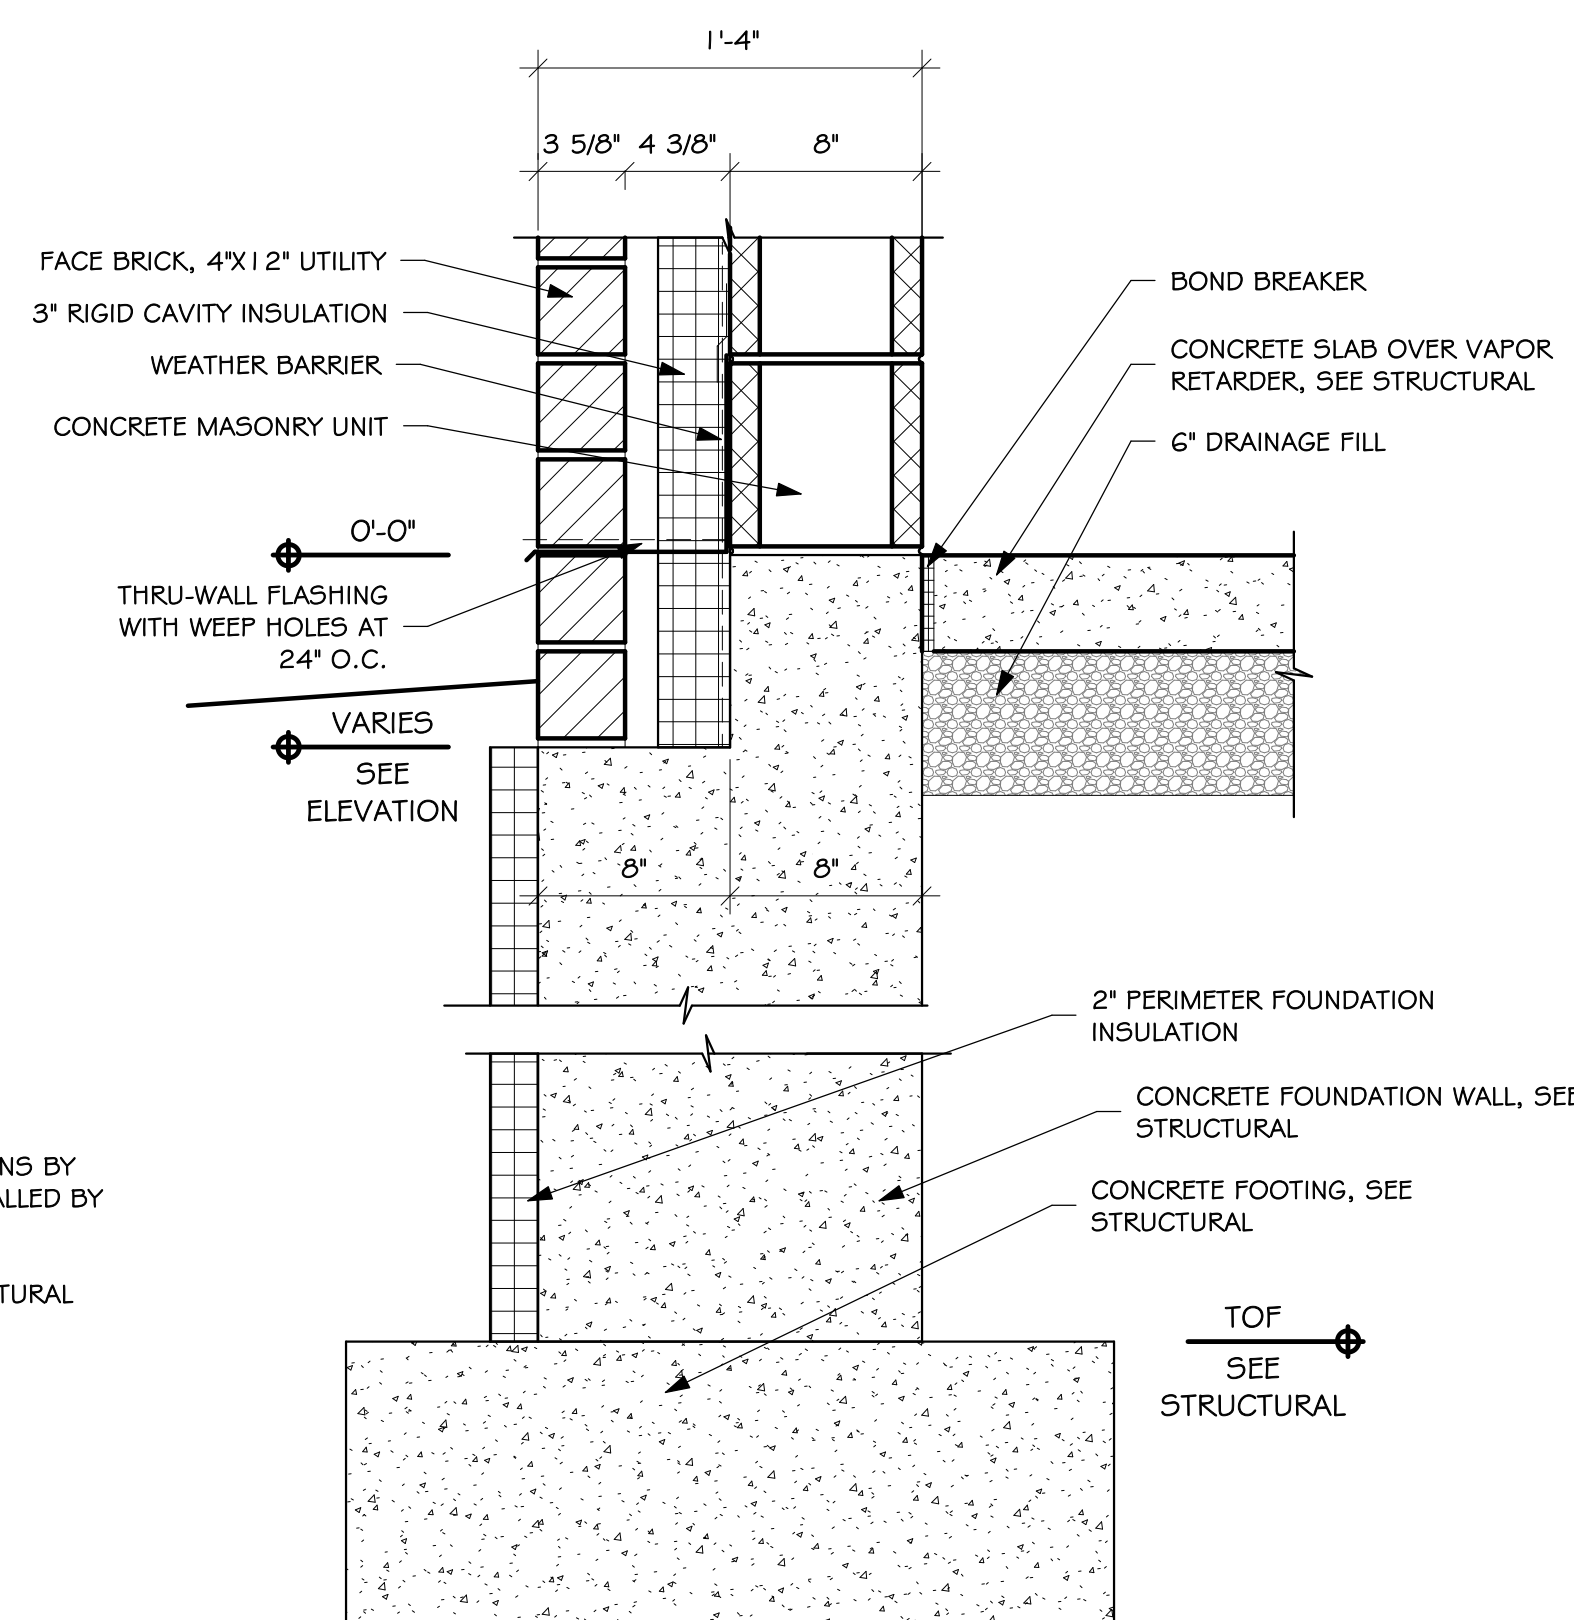


6  
5.41  
DETAIL - TYPICAL  
SCALE: 1 1/2" = 1'-0"

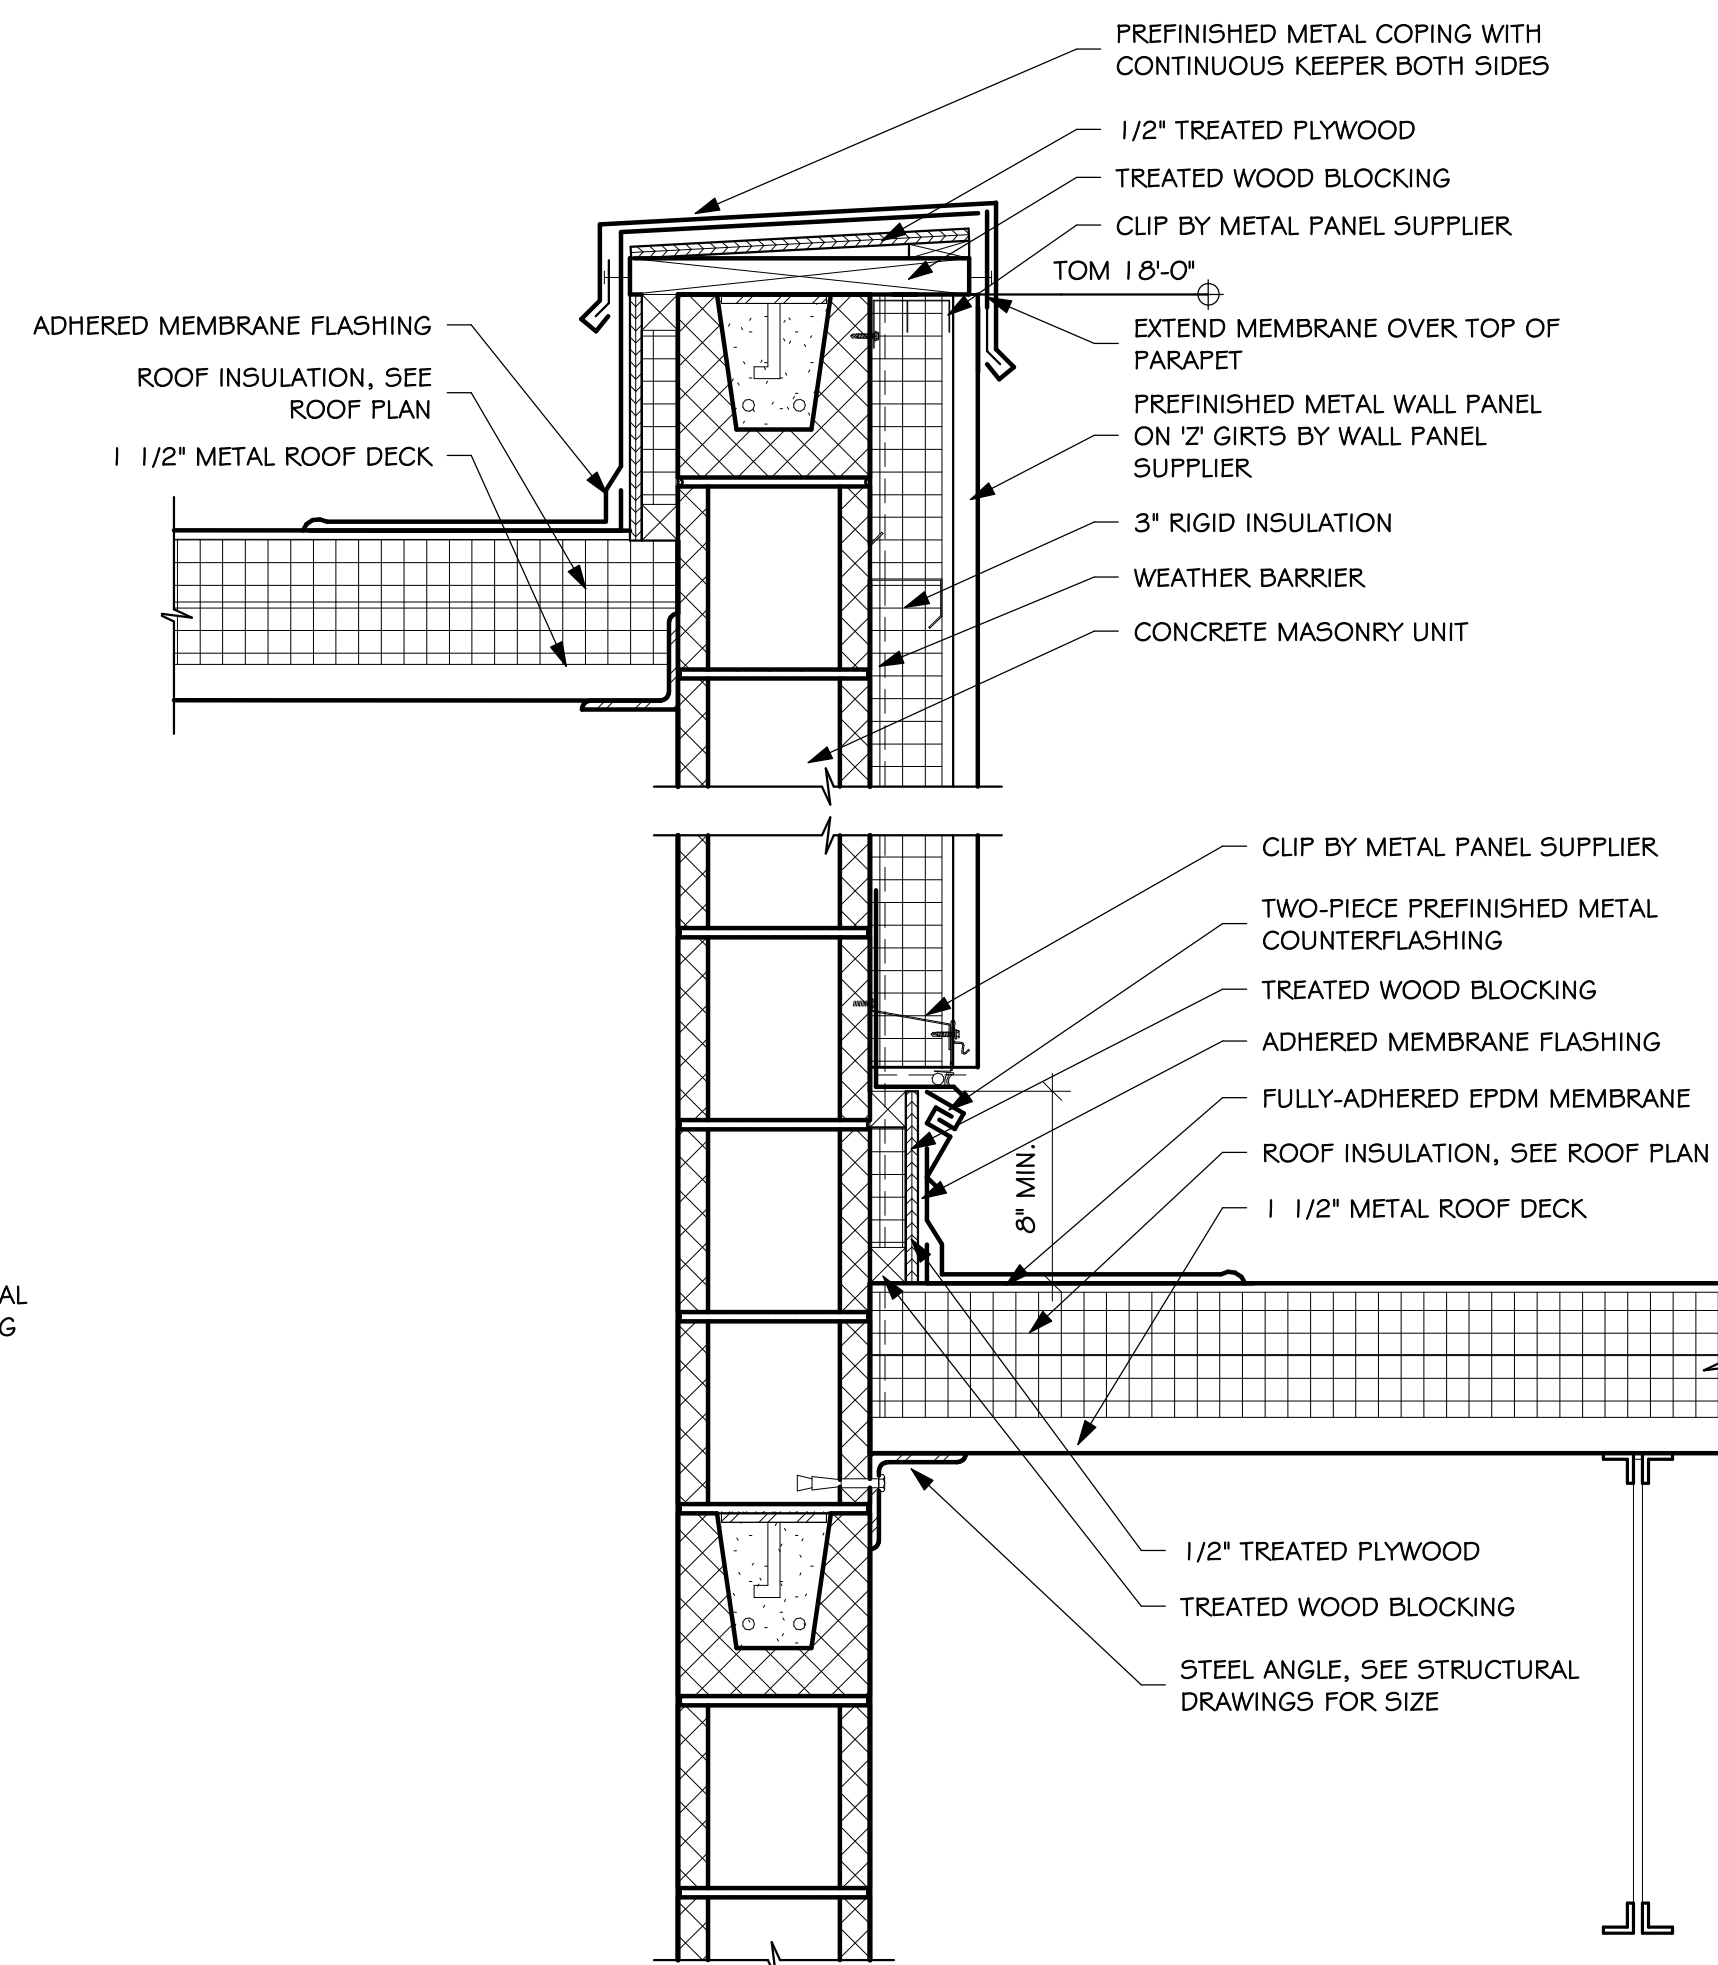


7  
5.41  
DETAIL - AREA G  
SCALE: 1 1/2" = 1'-0"

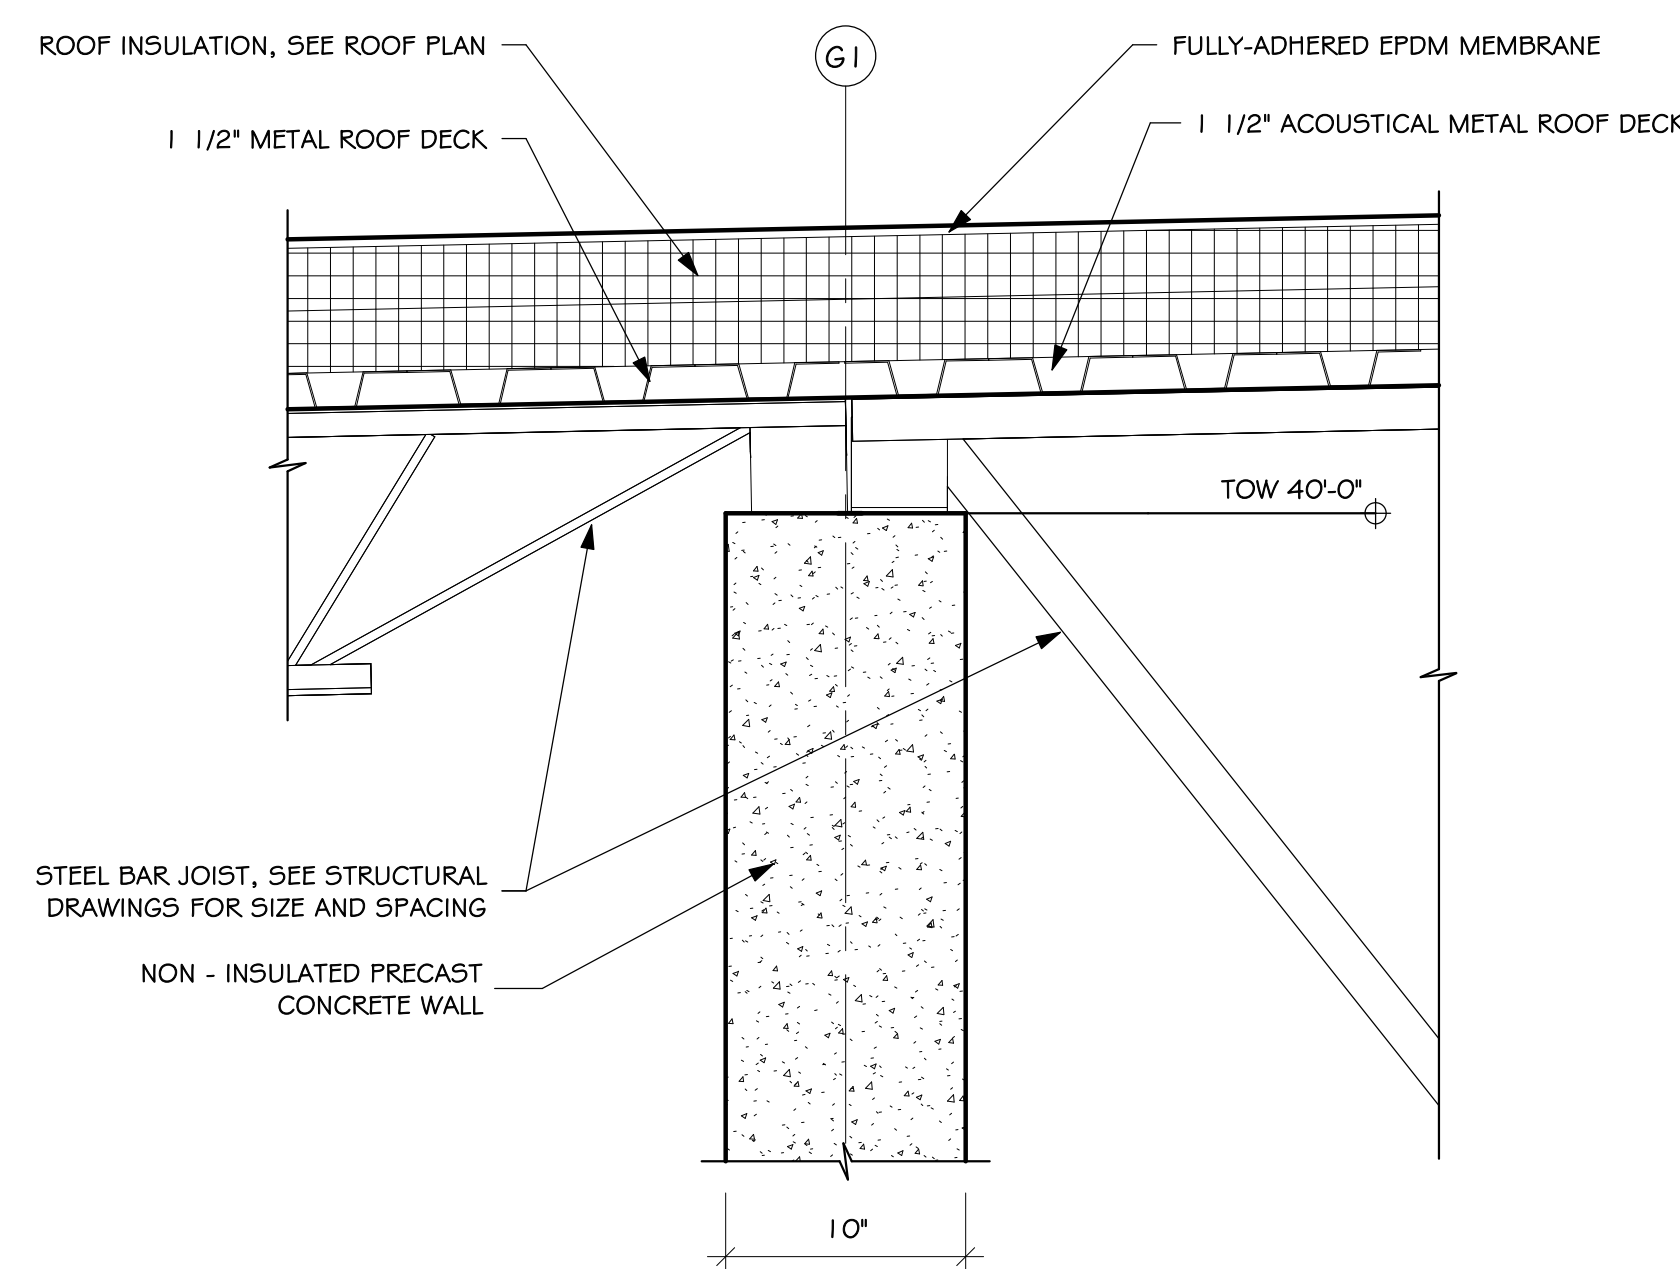


8  
5.41  
DETAIL - AREA G  
SCALE: 1 1/2" = 1'-0"

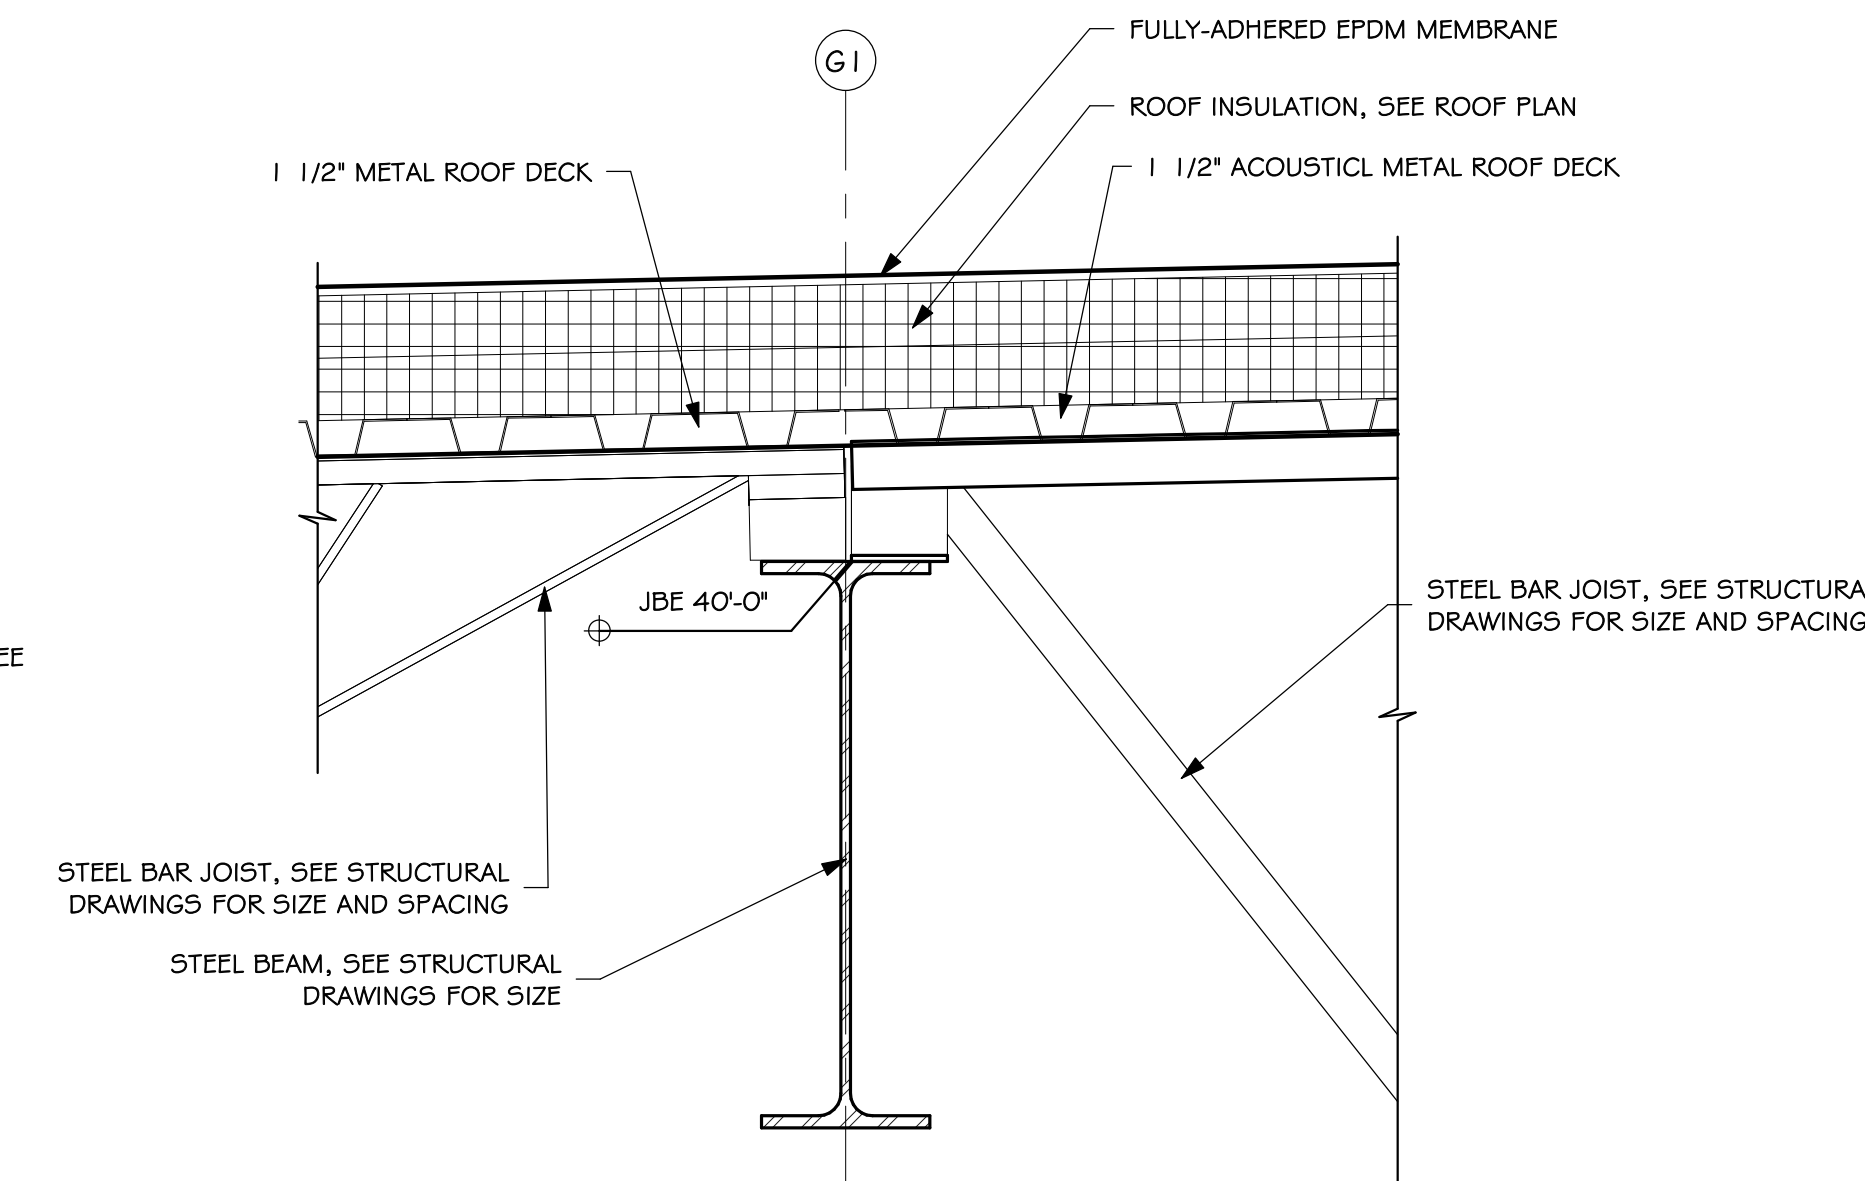


9  
5.41  
DETAIL - AREA G  
SCALE: 1 1/2" = 1'-0"

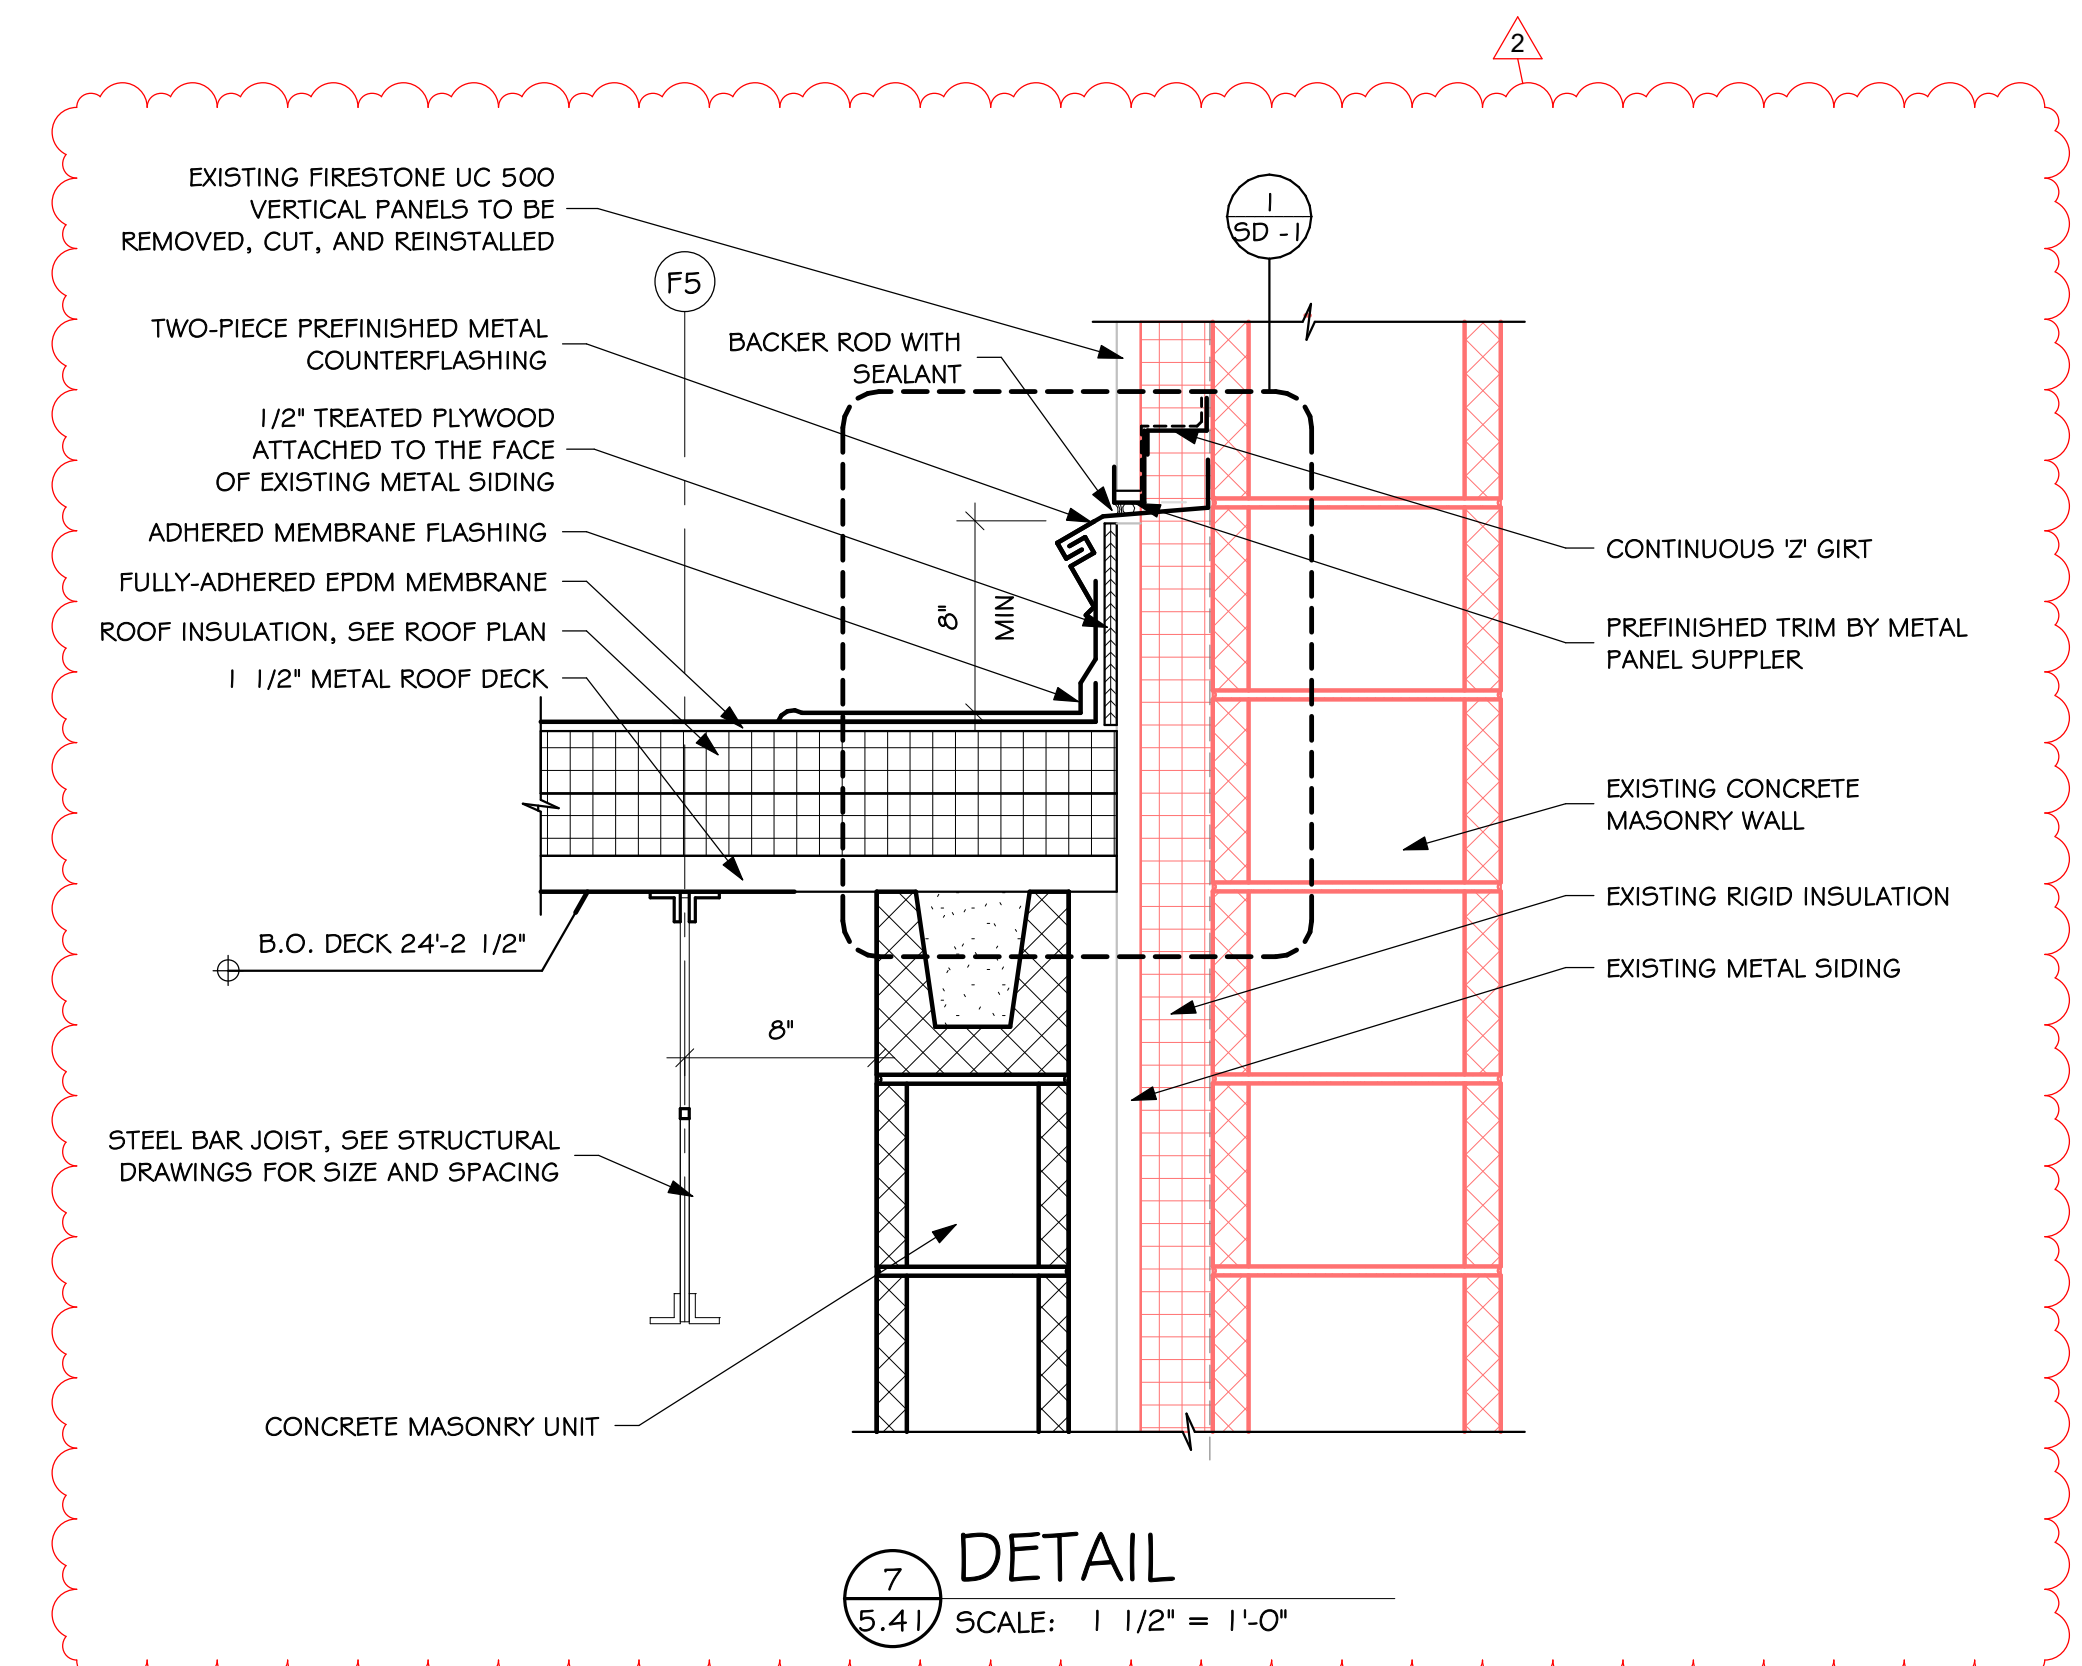


10  
5.41  
DETAIL  
SCALE: 1 1/2" = 1'-0"

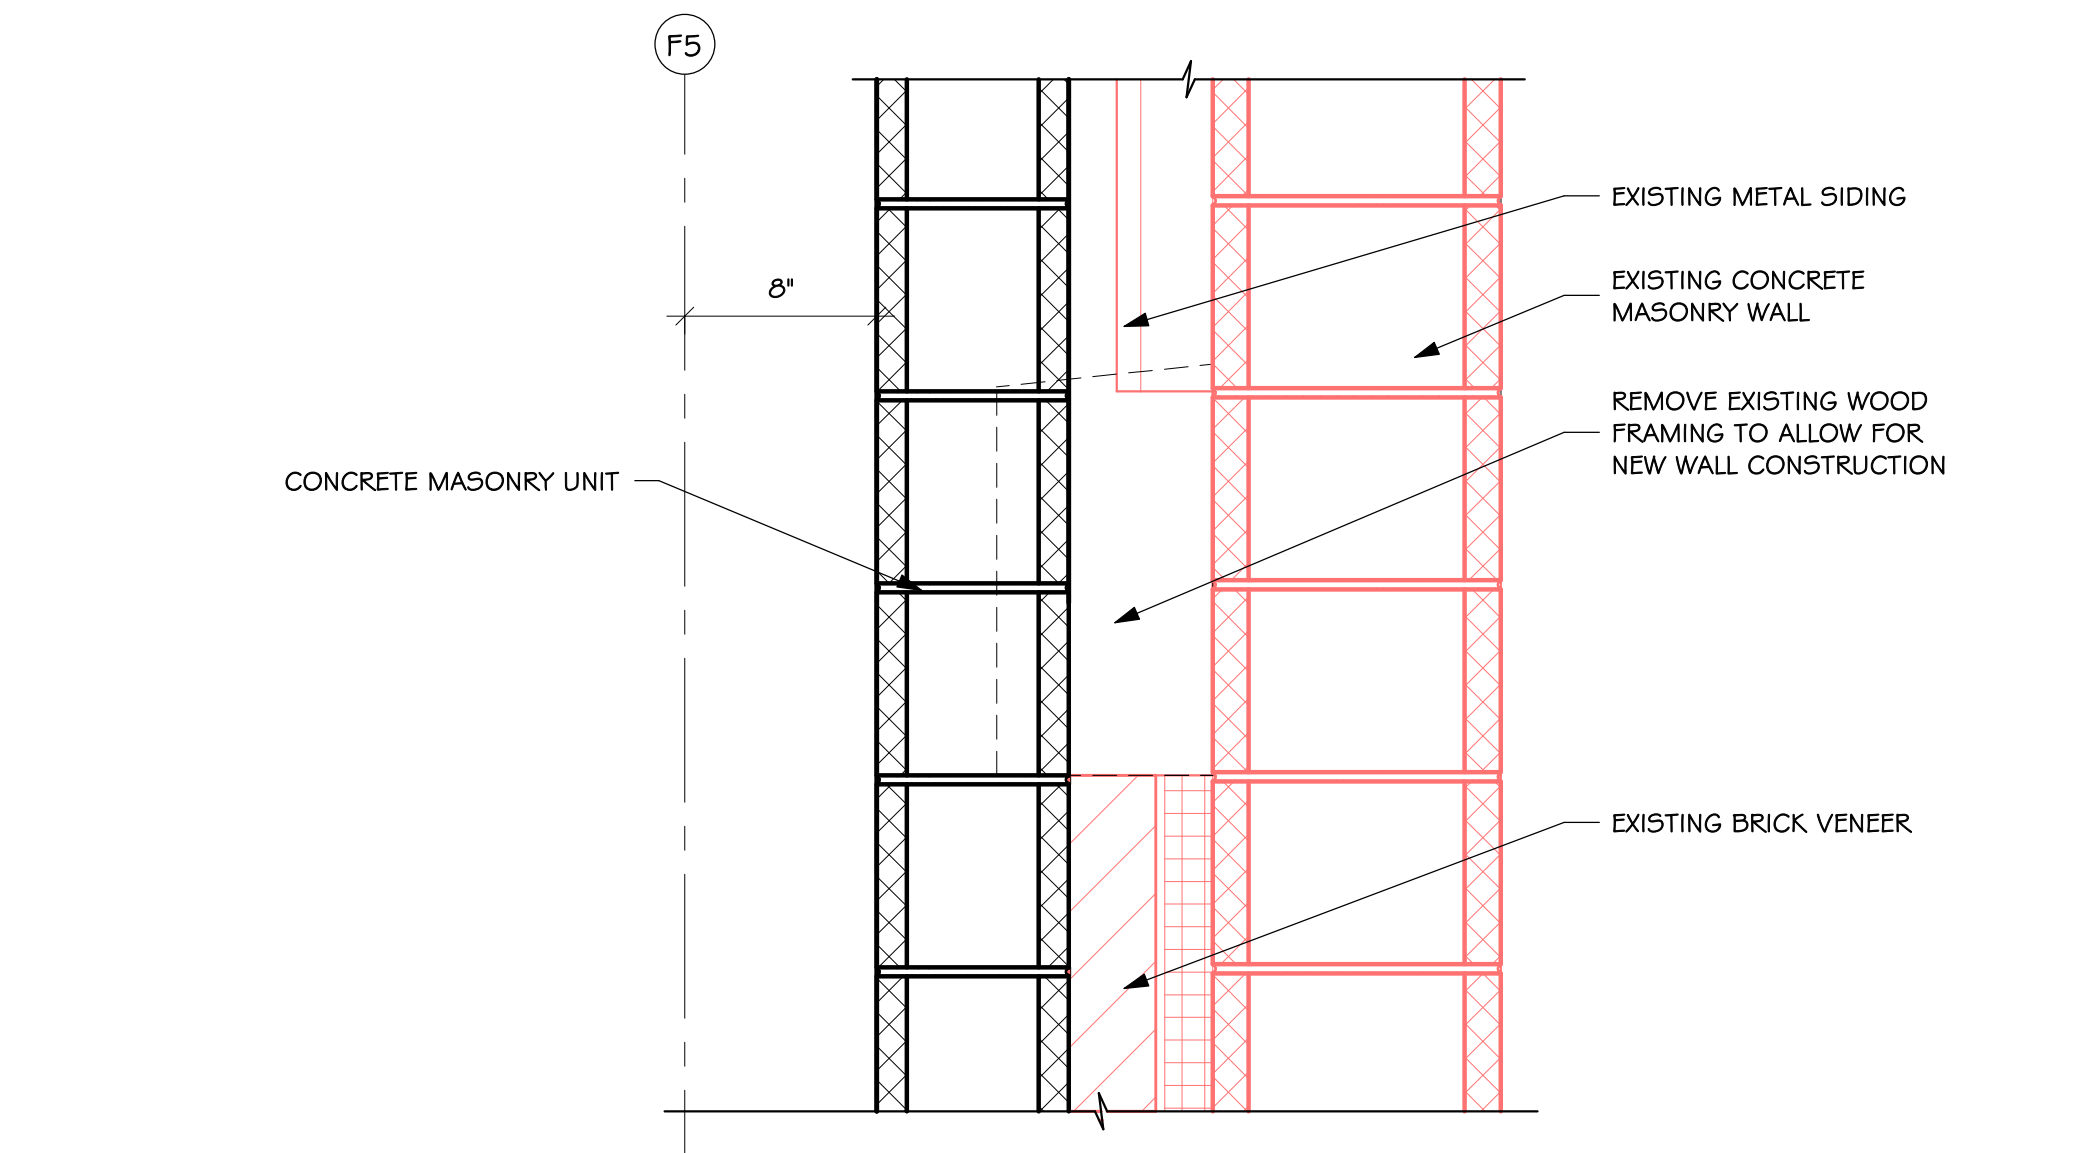


11  
5.41  
DETAIL  
SCALE: 1 1/2" = 1'-0"

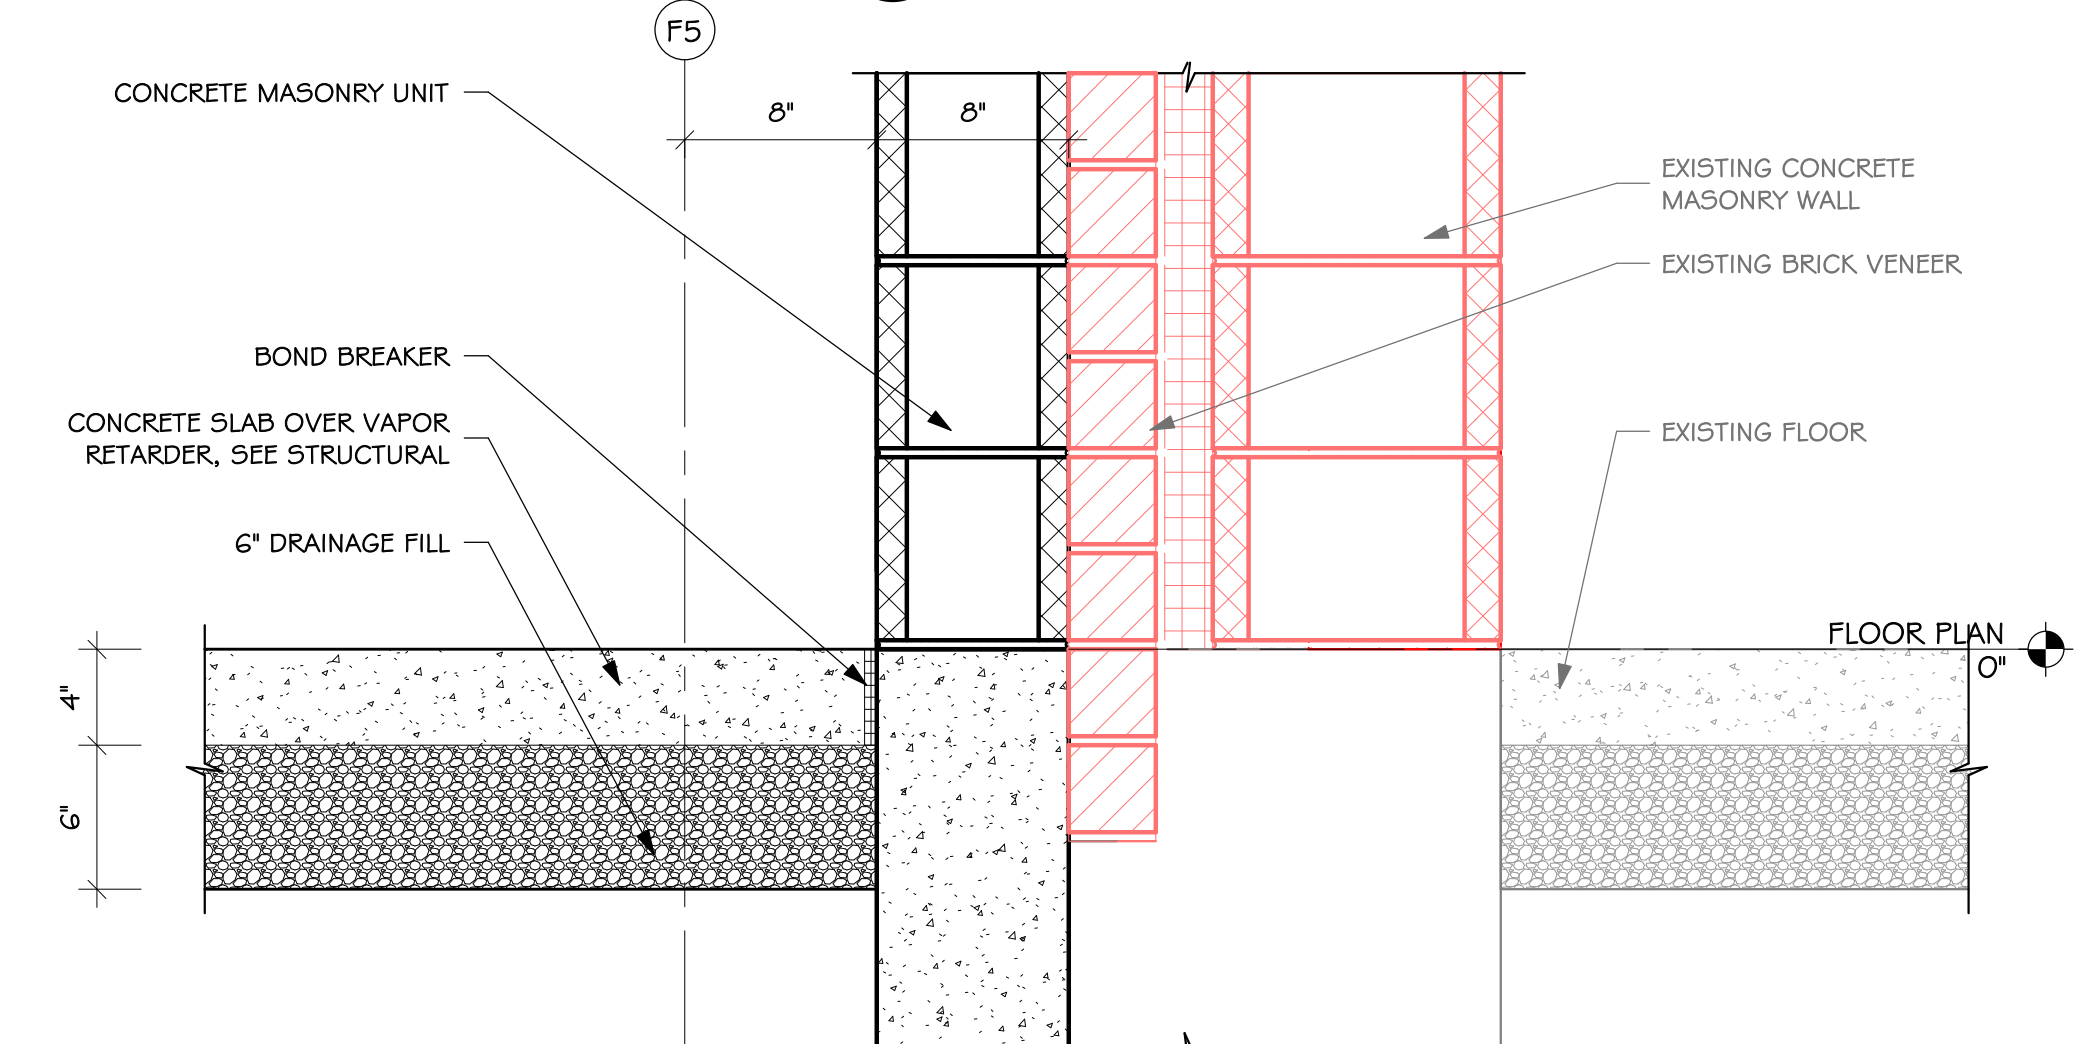

12  
5.41  
DETAIL  
SCALE: 1 1/2" = 1'-0"

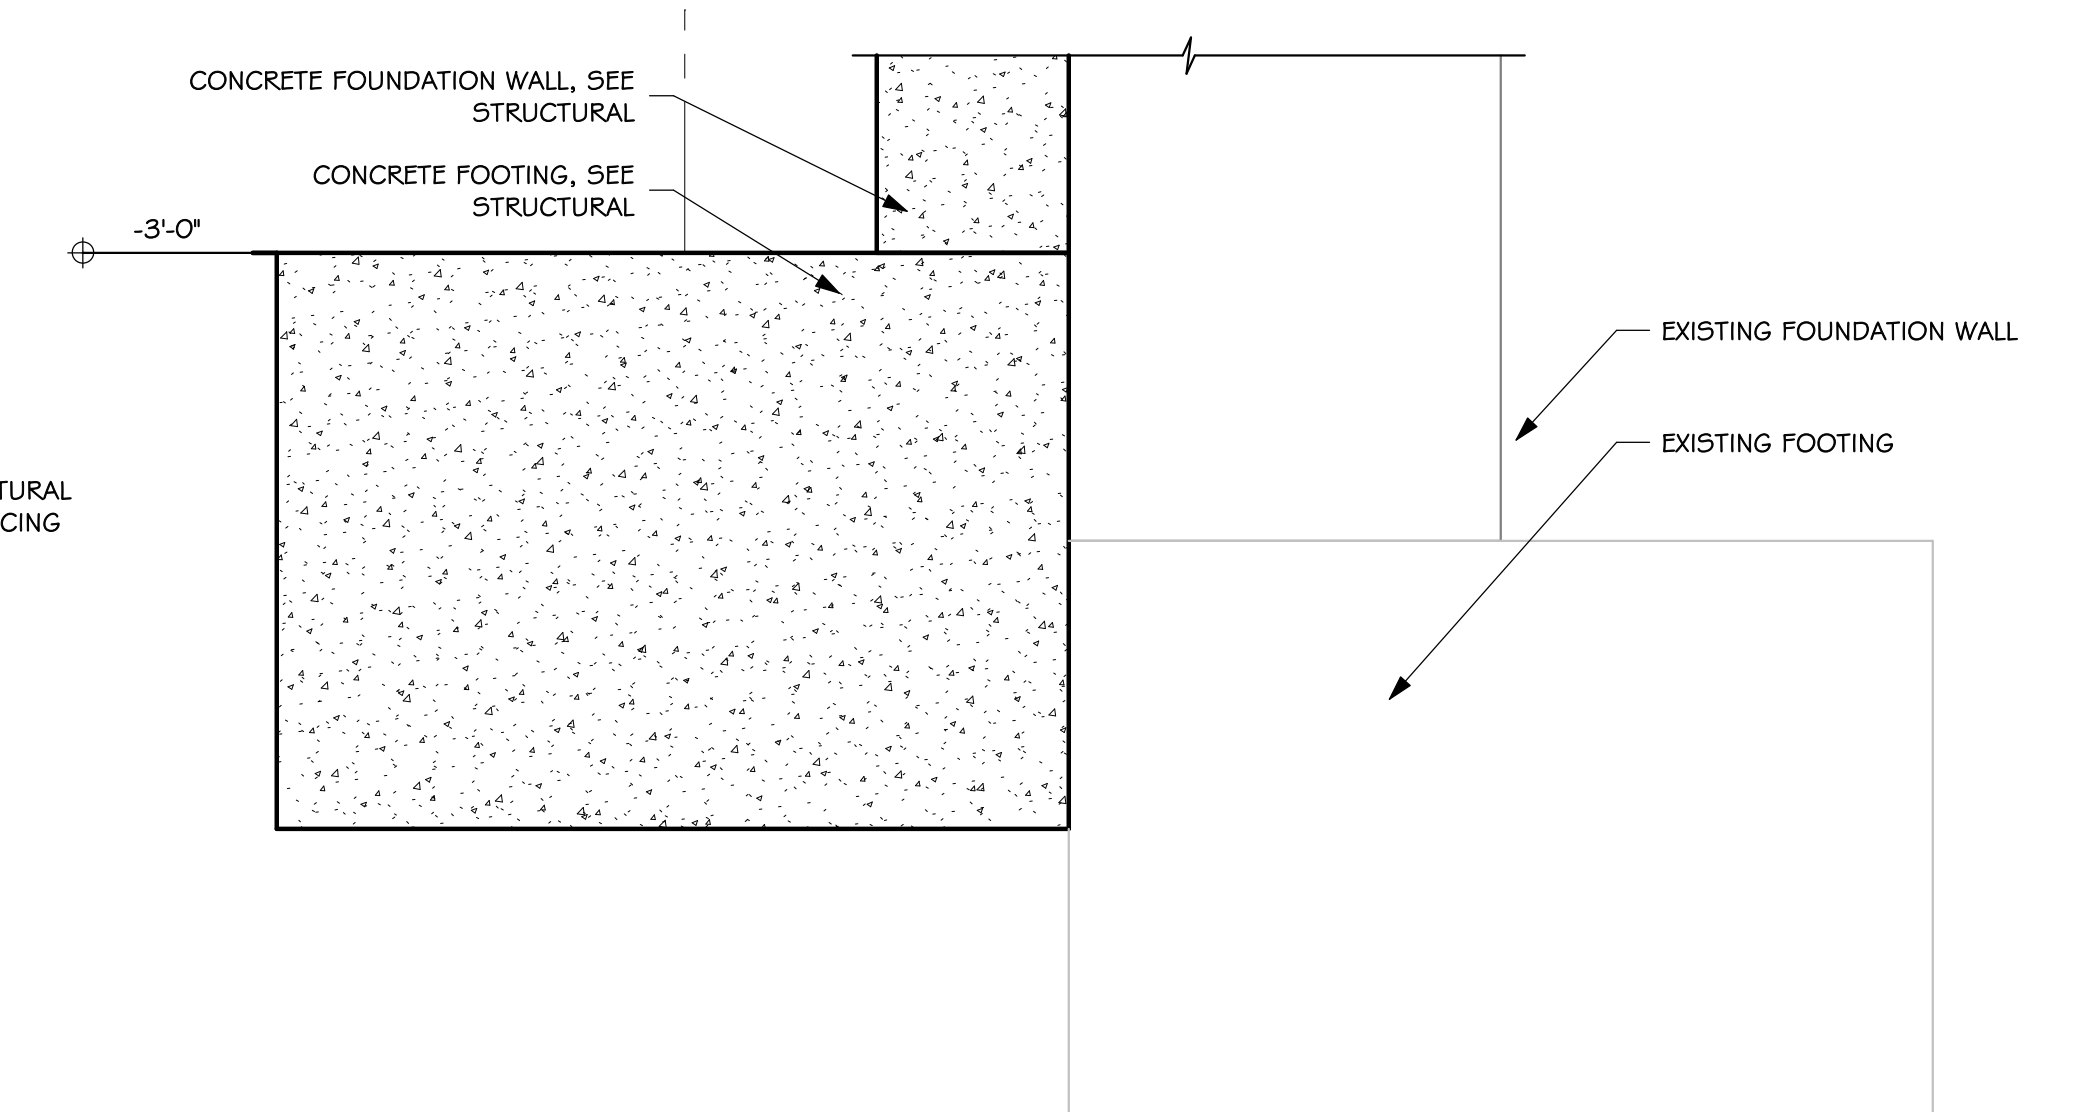


13  
5.41  
DETAIL  
SCALE: 1 1/2" = 1'-0"

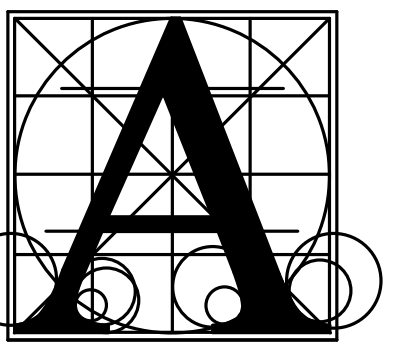

Architecture  
Incorporated

415 South Main Avenue  
P.O. Box 2140  
Sioux Falls, South Dakota 57101  
Phone: (605) 339-1711

815 St Joseph Street, Suite 203  
Rapid City, South Dakota 57701  
Phone: (605) 721-1158

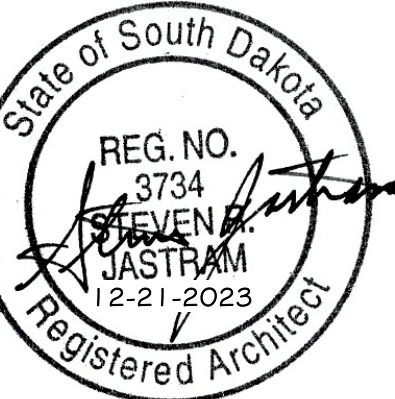

LENNOX HIGH SCHOOL ADDITION


SECTION DETAILS

number	0215.2902.22
date	DECEMBER 21, 2023
revision	
drawn	MS checked SRJ
DATE	DESCRIPTION
1/18/2024	ADDENDUM #2


5.41




1/18/2024 6:02:49 PM

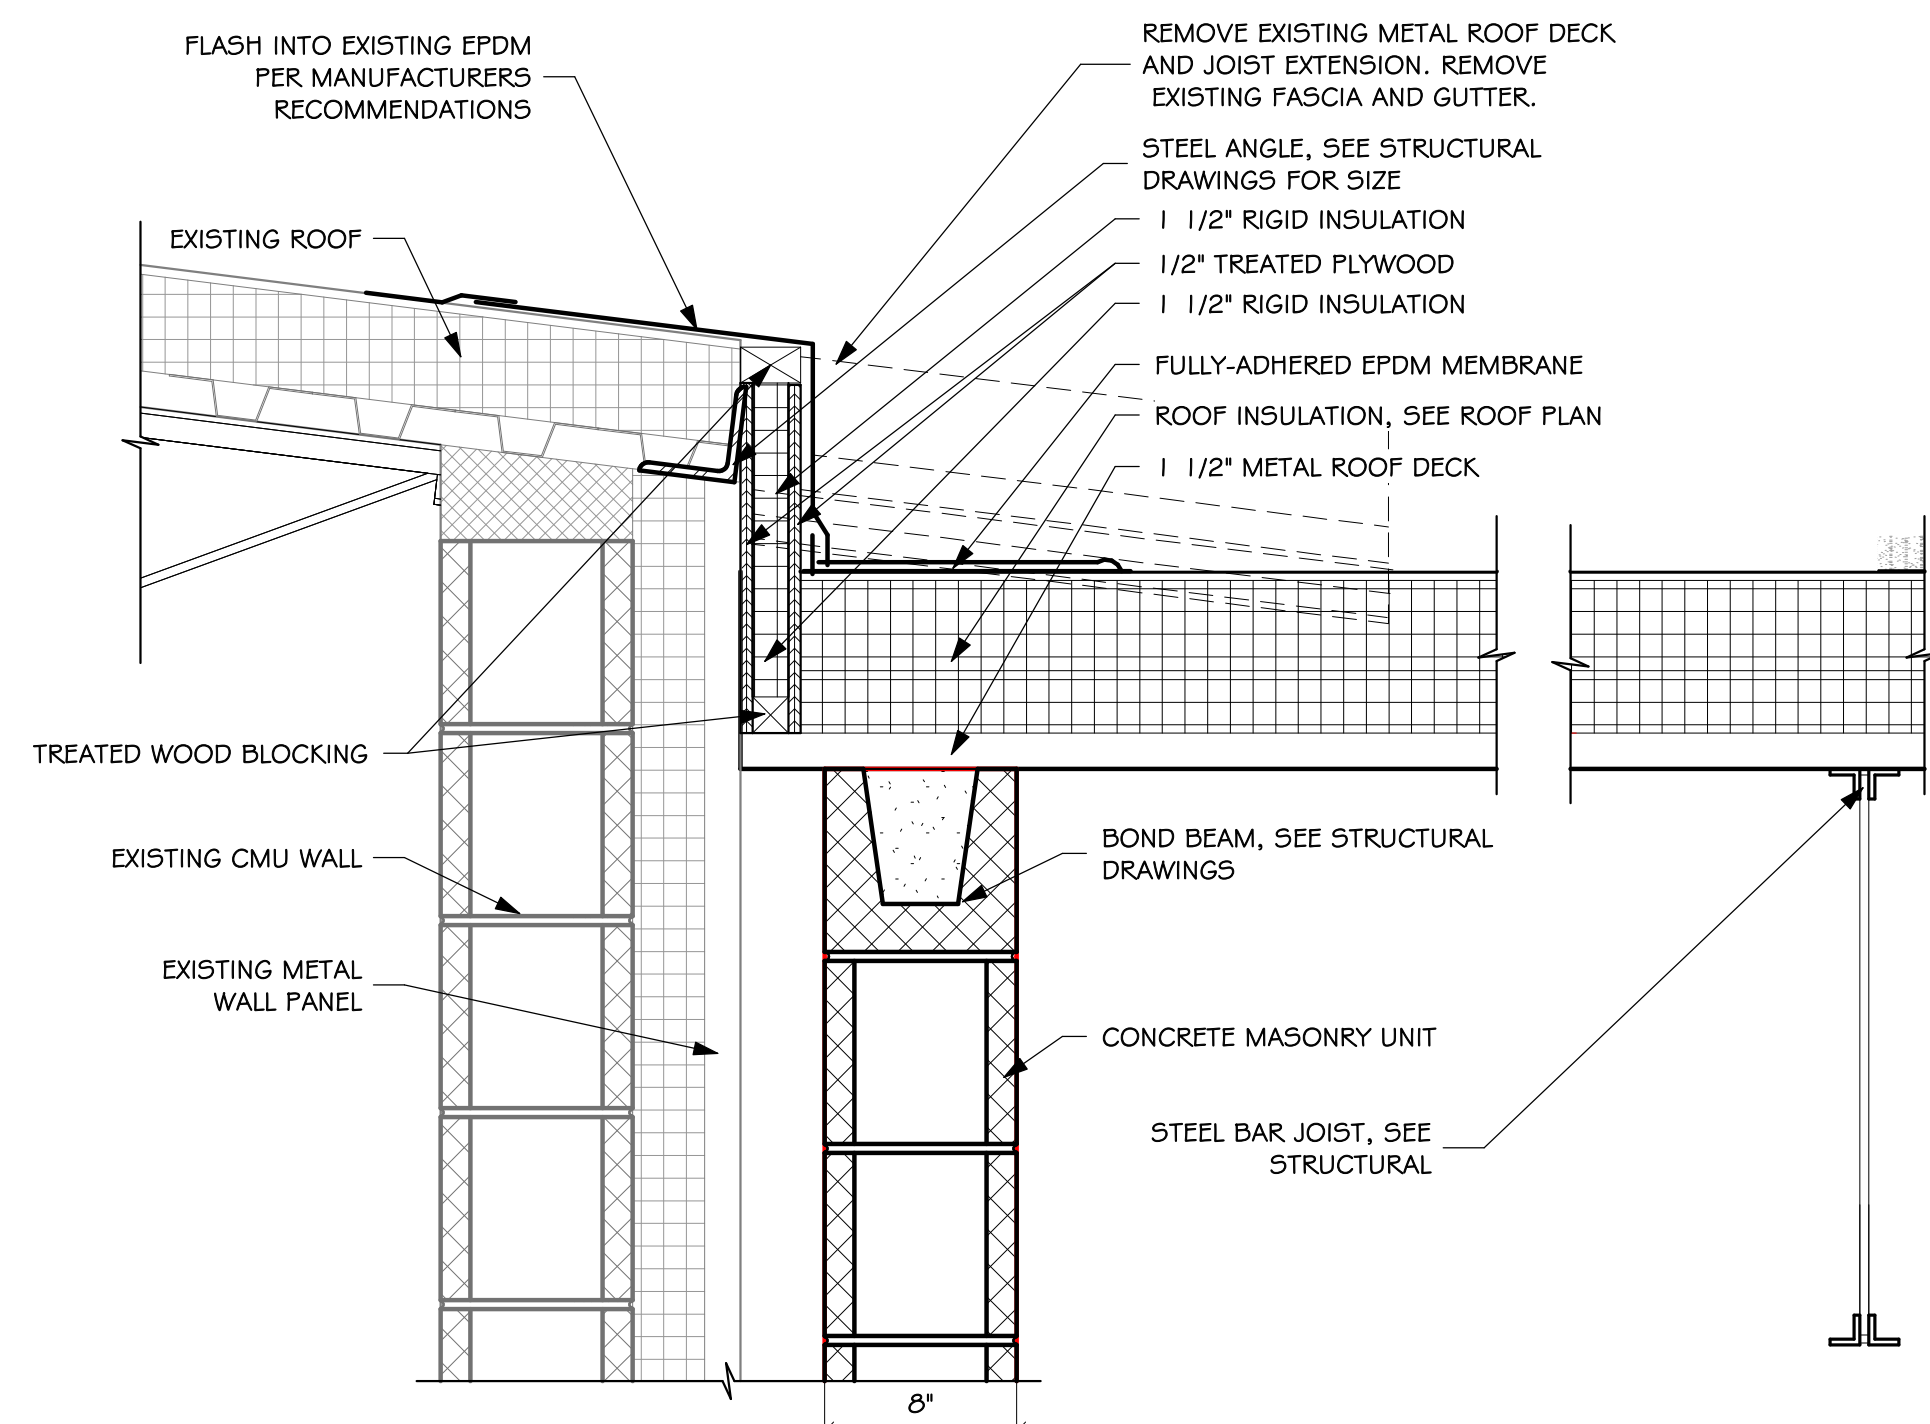


1  
5.42  
DETAIL - AREA E  
SCALE: 1 1/2" = 1'-0"

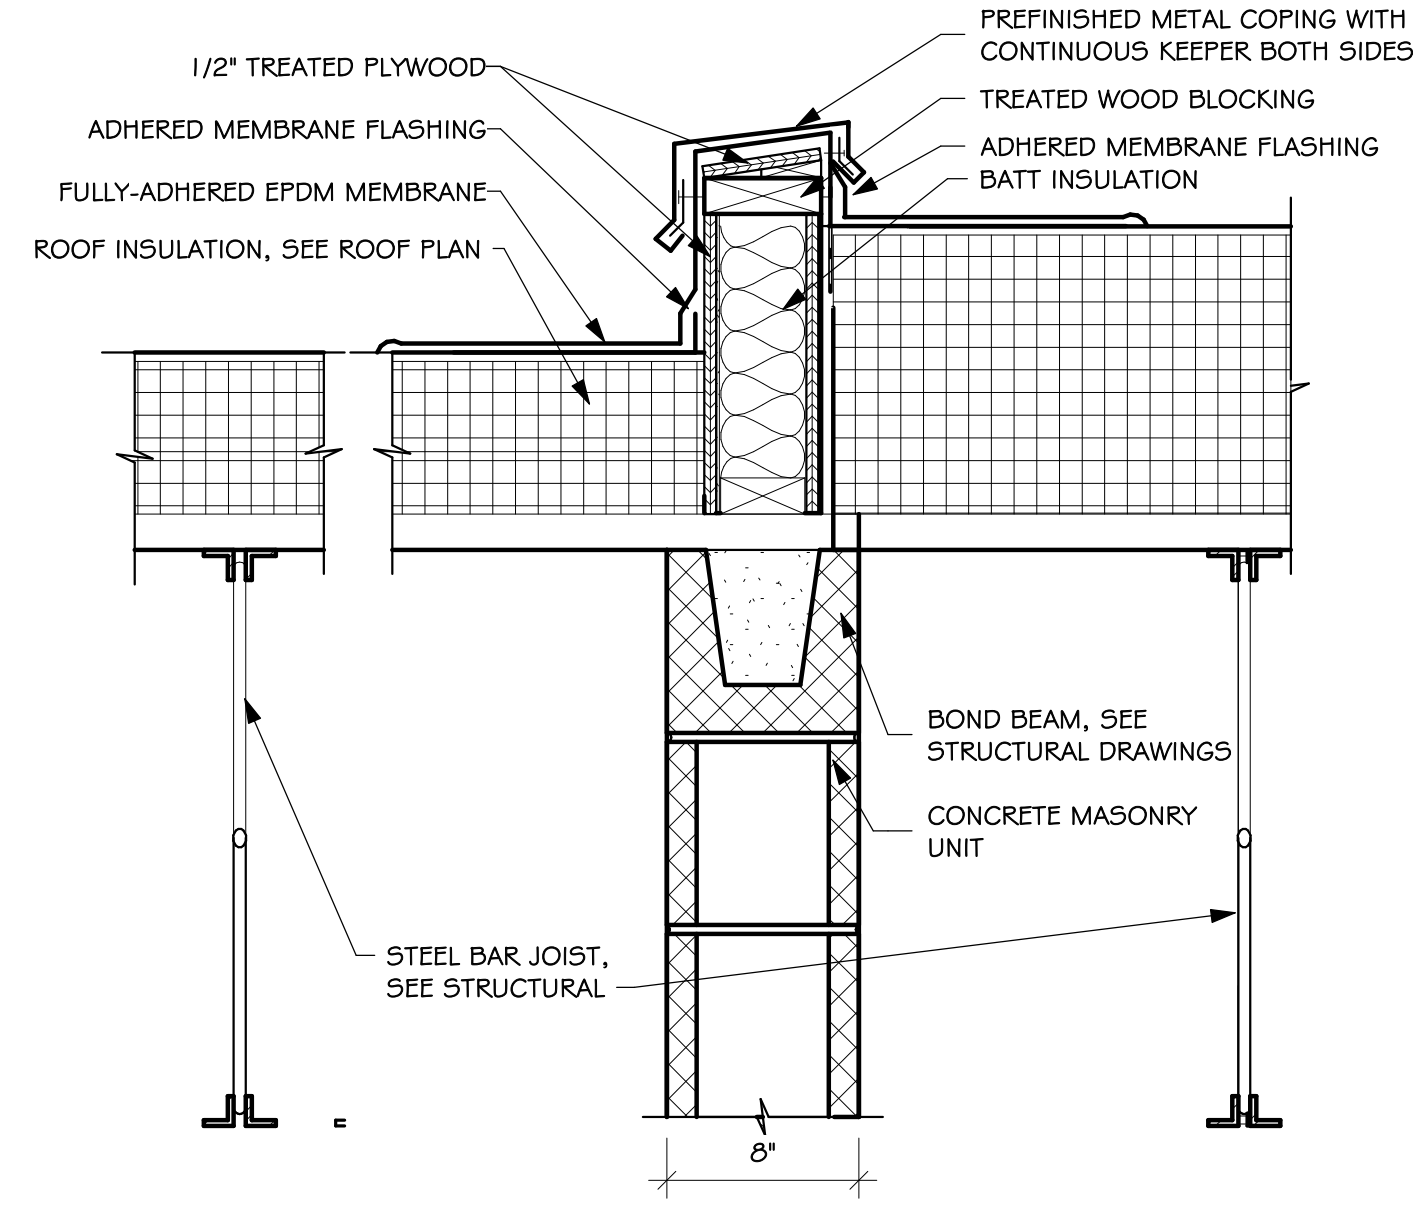


4  
5.42  
DETAIL - AREA E  
SCALE: 1 1/2" = 1'-0"

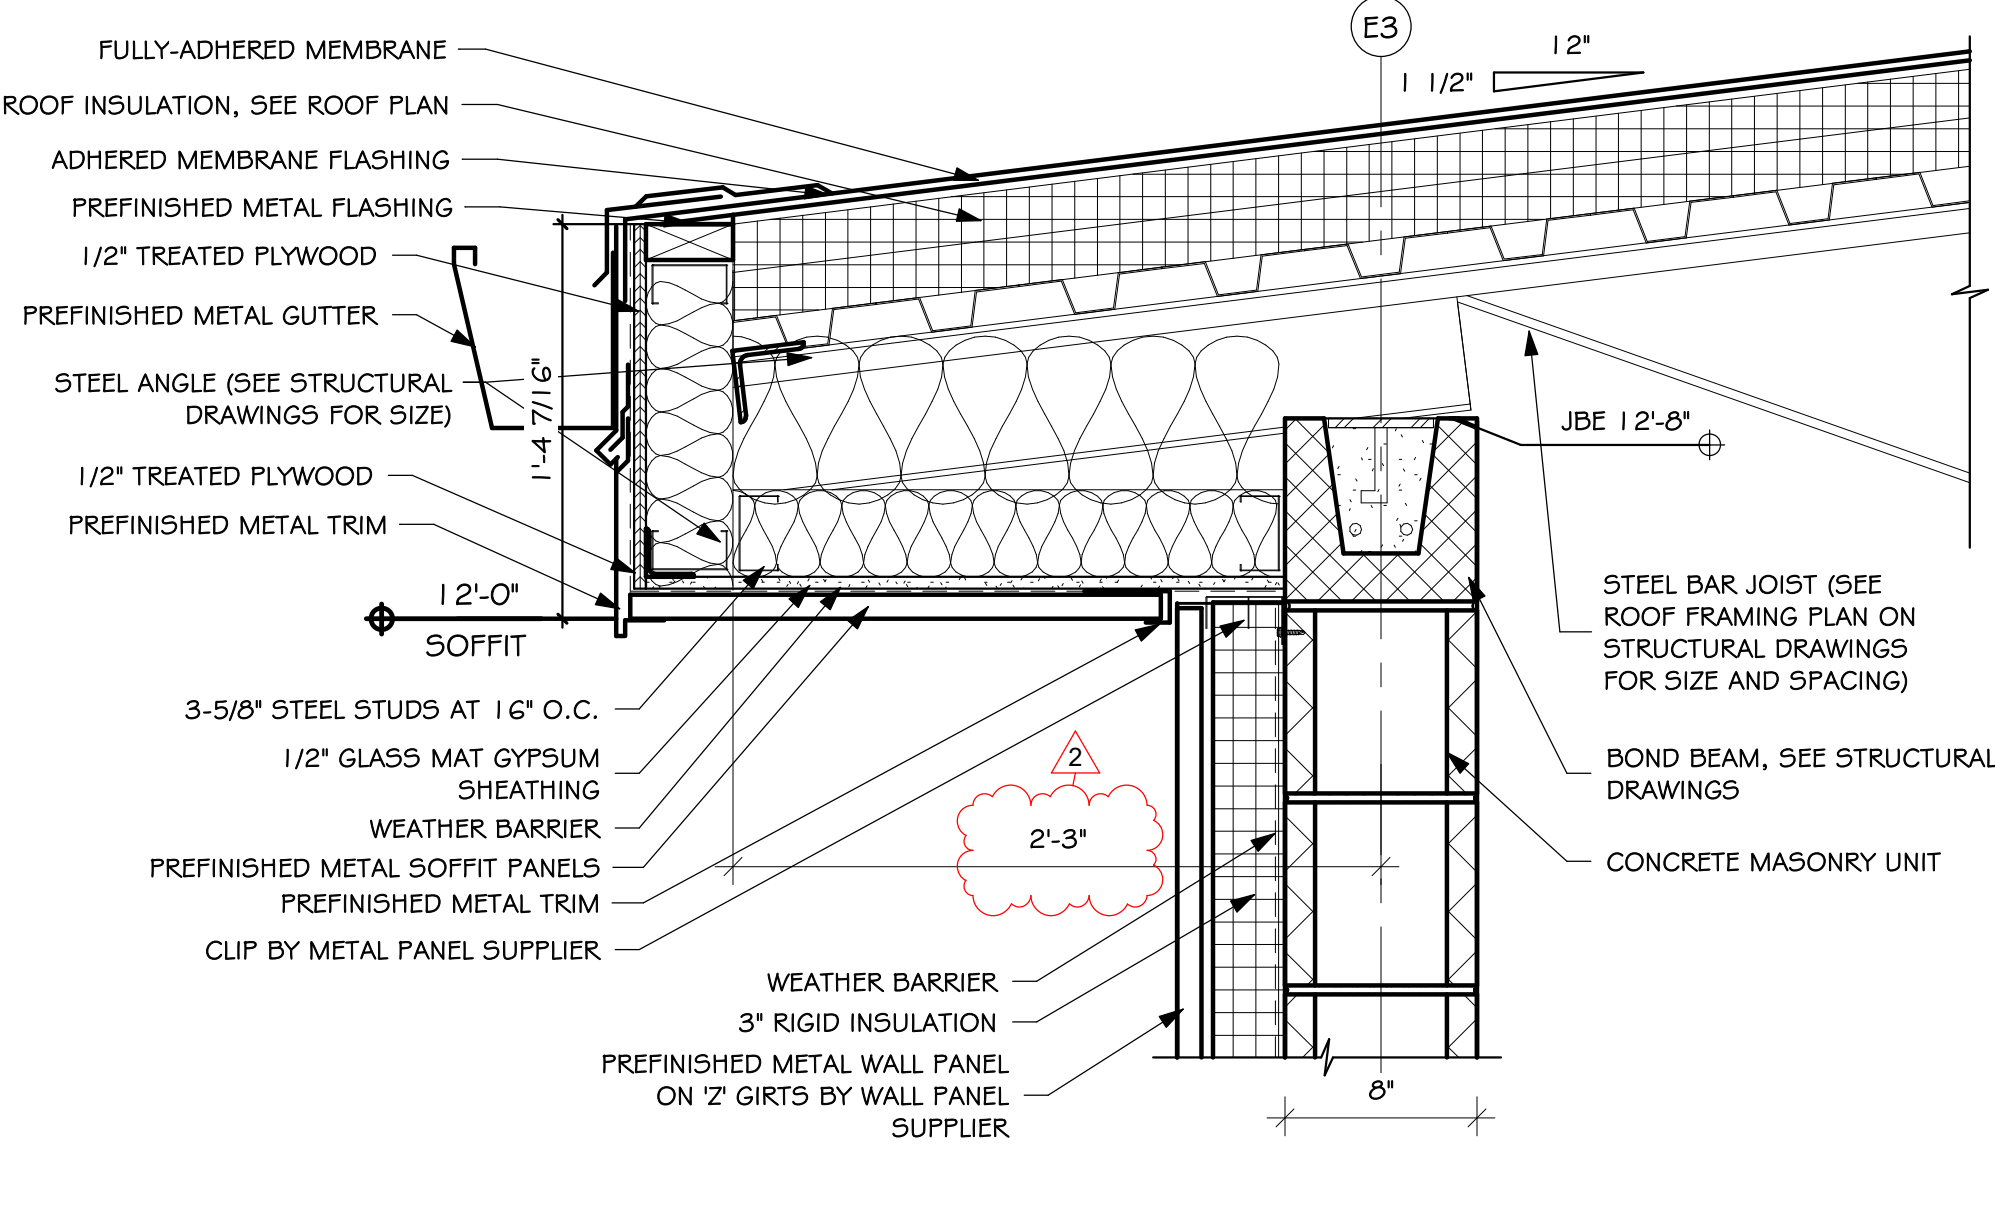


7  
5.42  
DETAIL - AREA E  
SCALE: 1 1/2" = 1'-0"

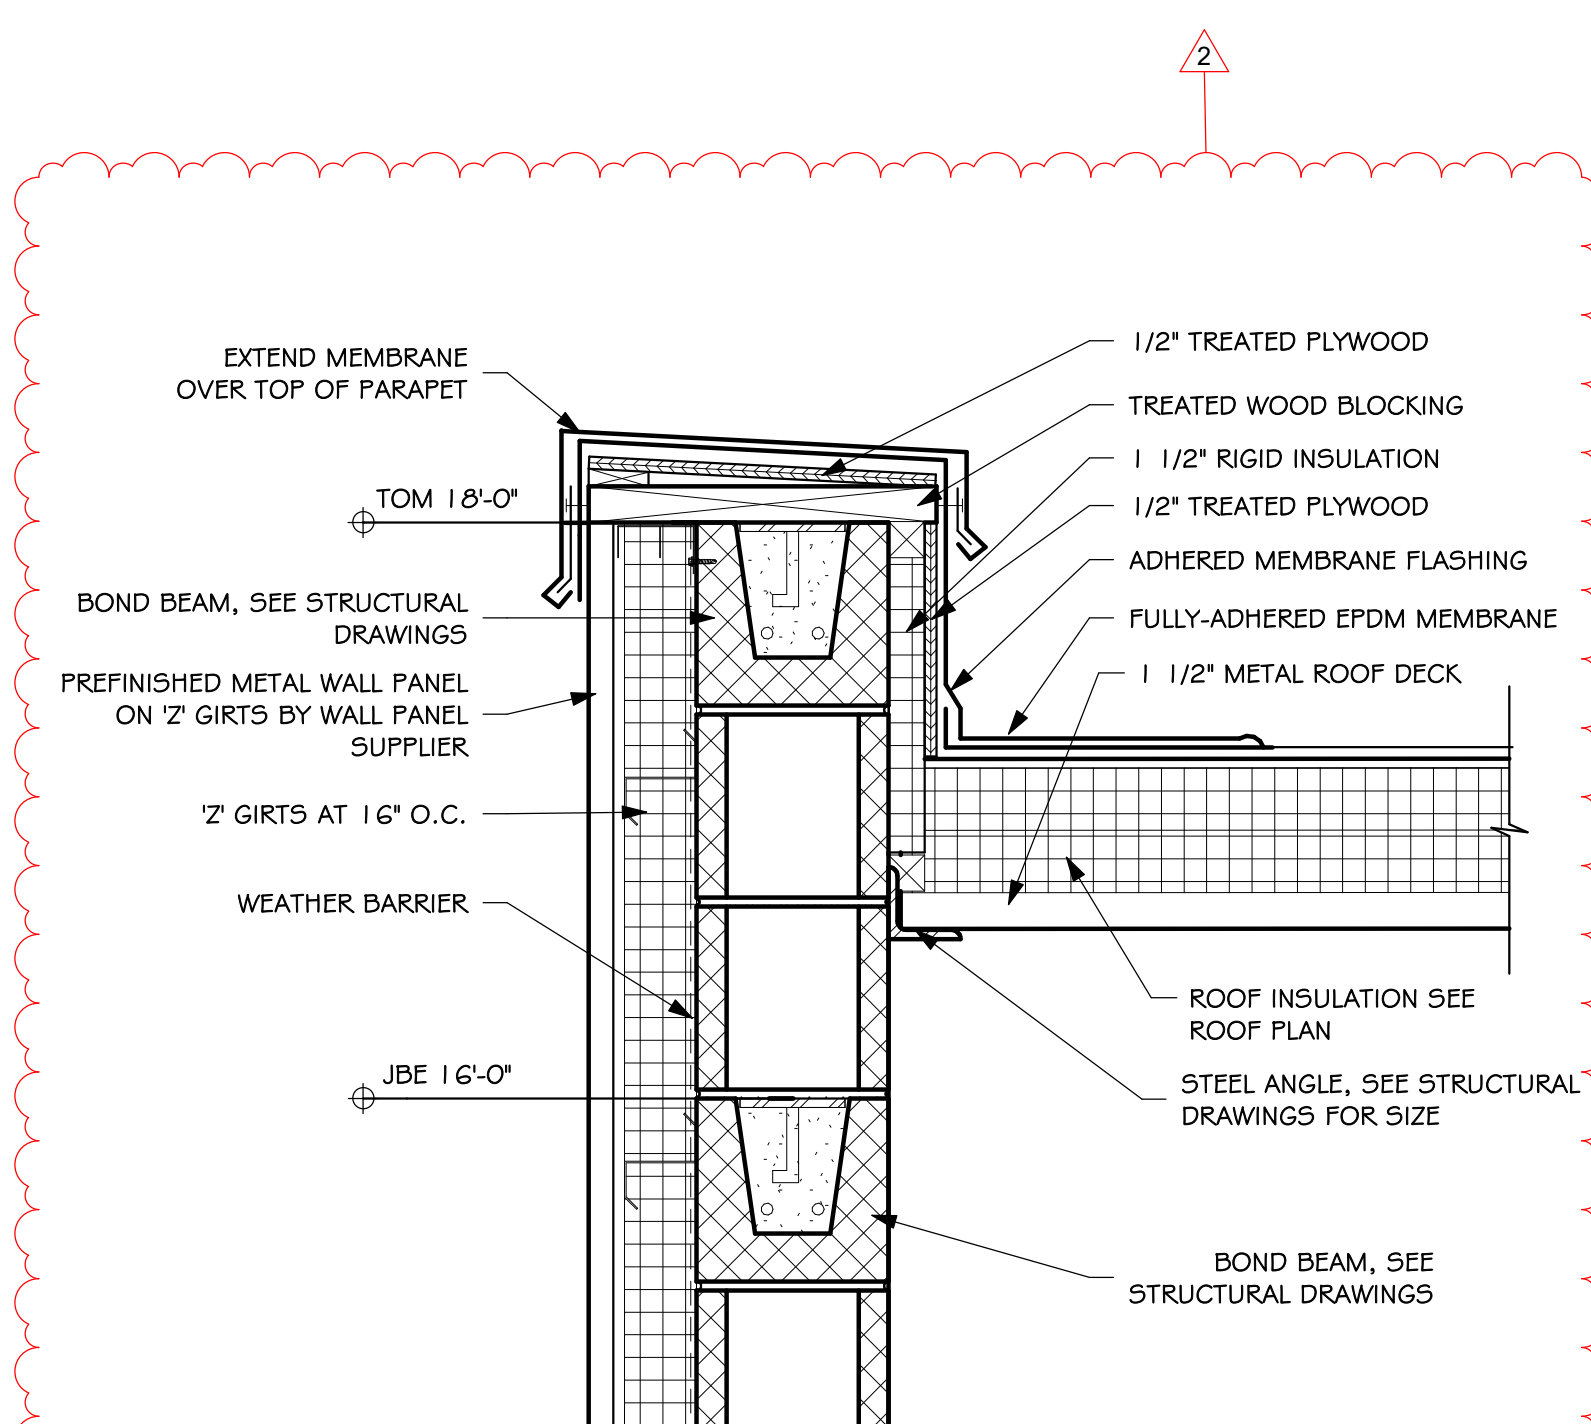


10  
5.42  
DETAIL - AREA G  
SCALE: 1 1/2" = 1'-0"

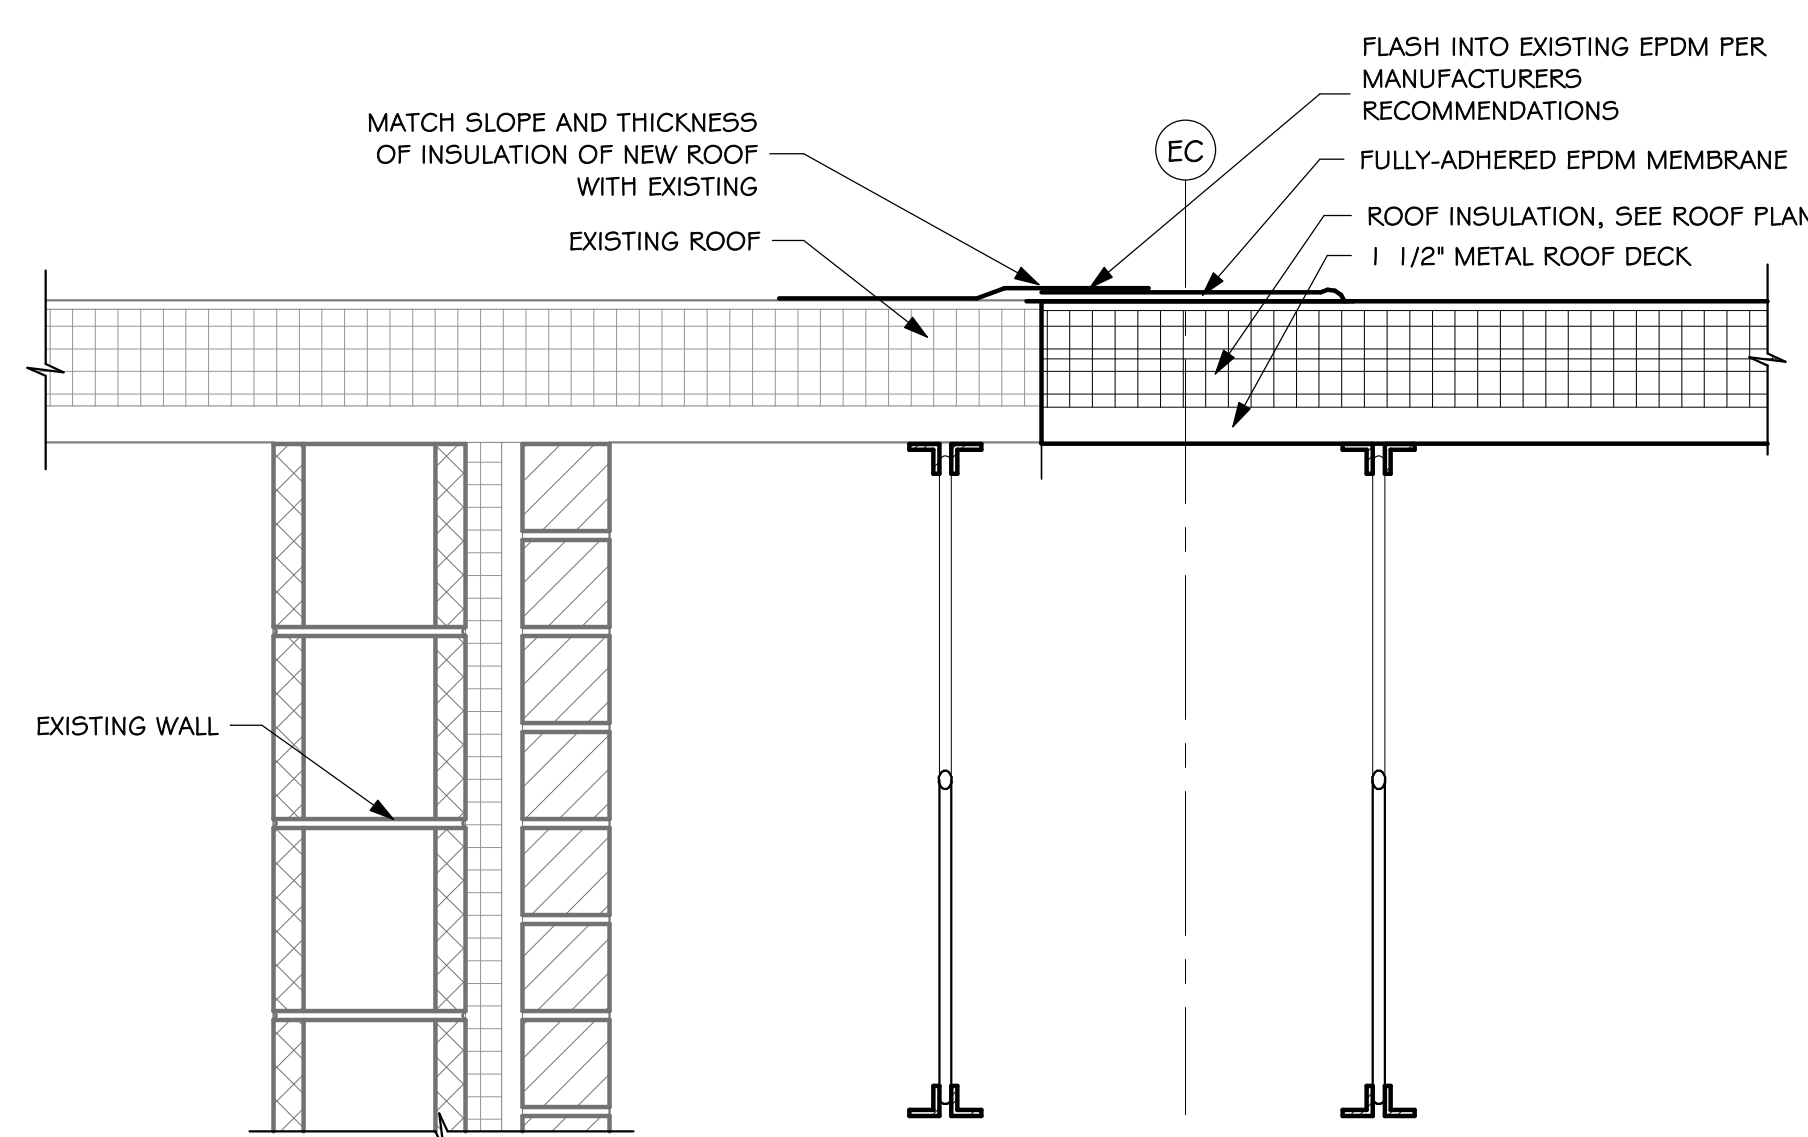


2  
5.42  
DETAIL - AREA D AND E  
SCALE: 1 1/2" = 1'-0"

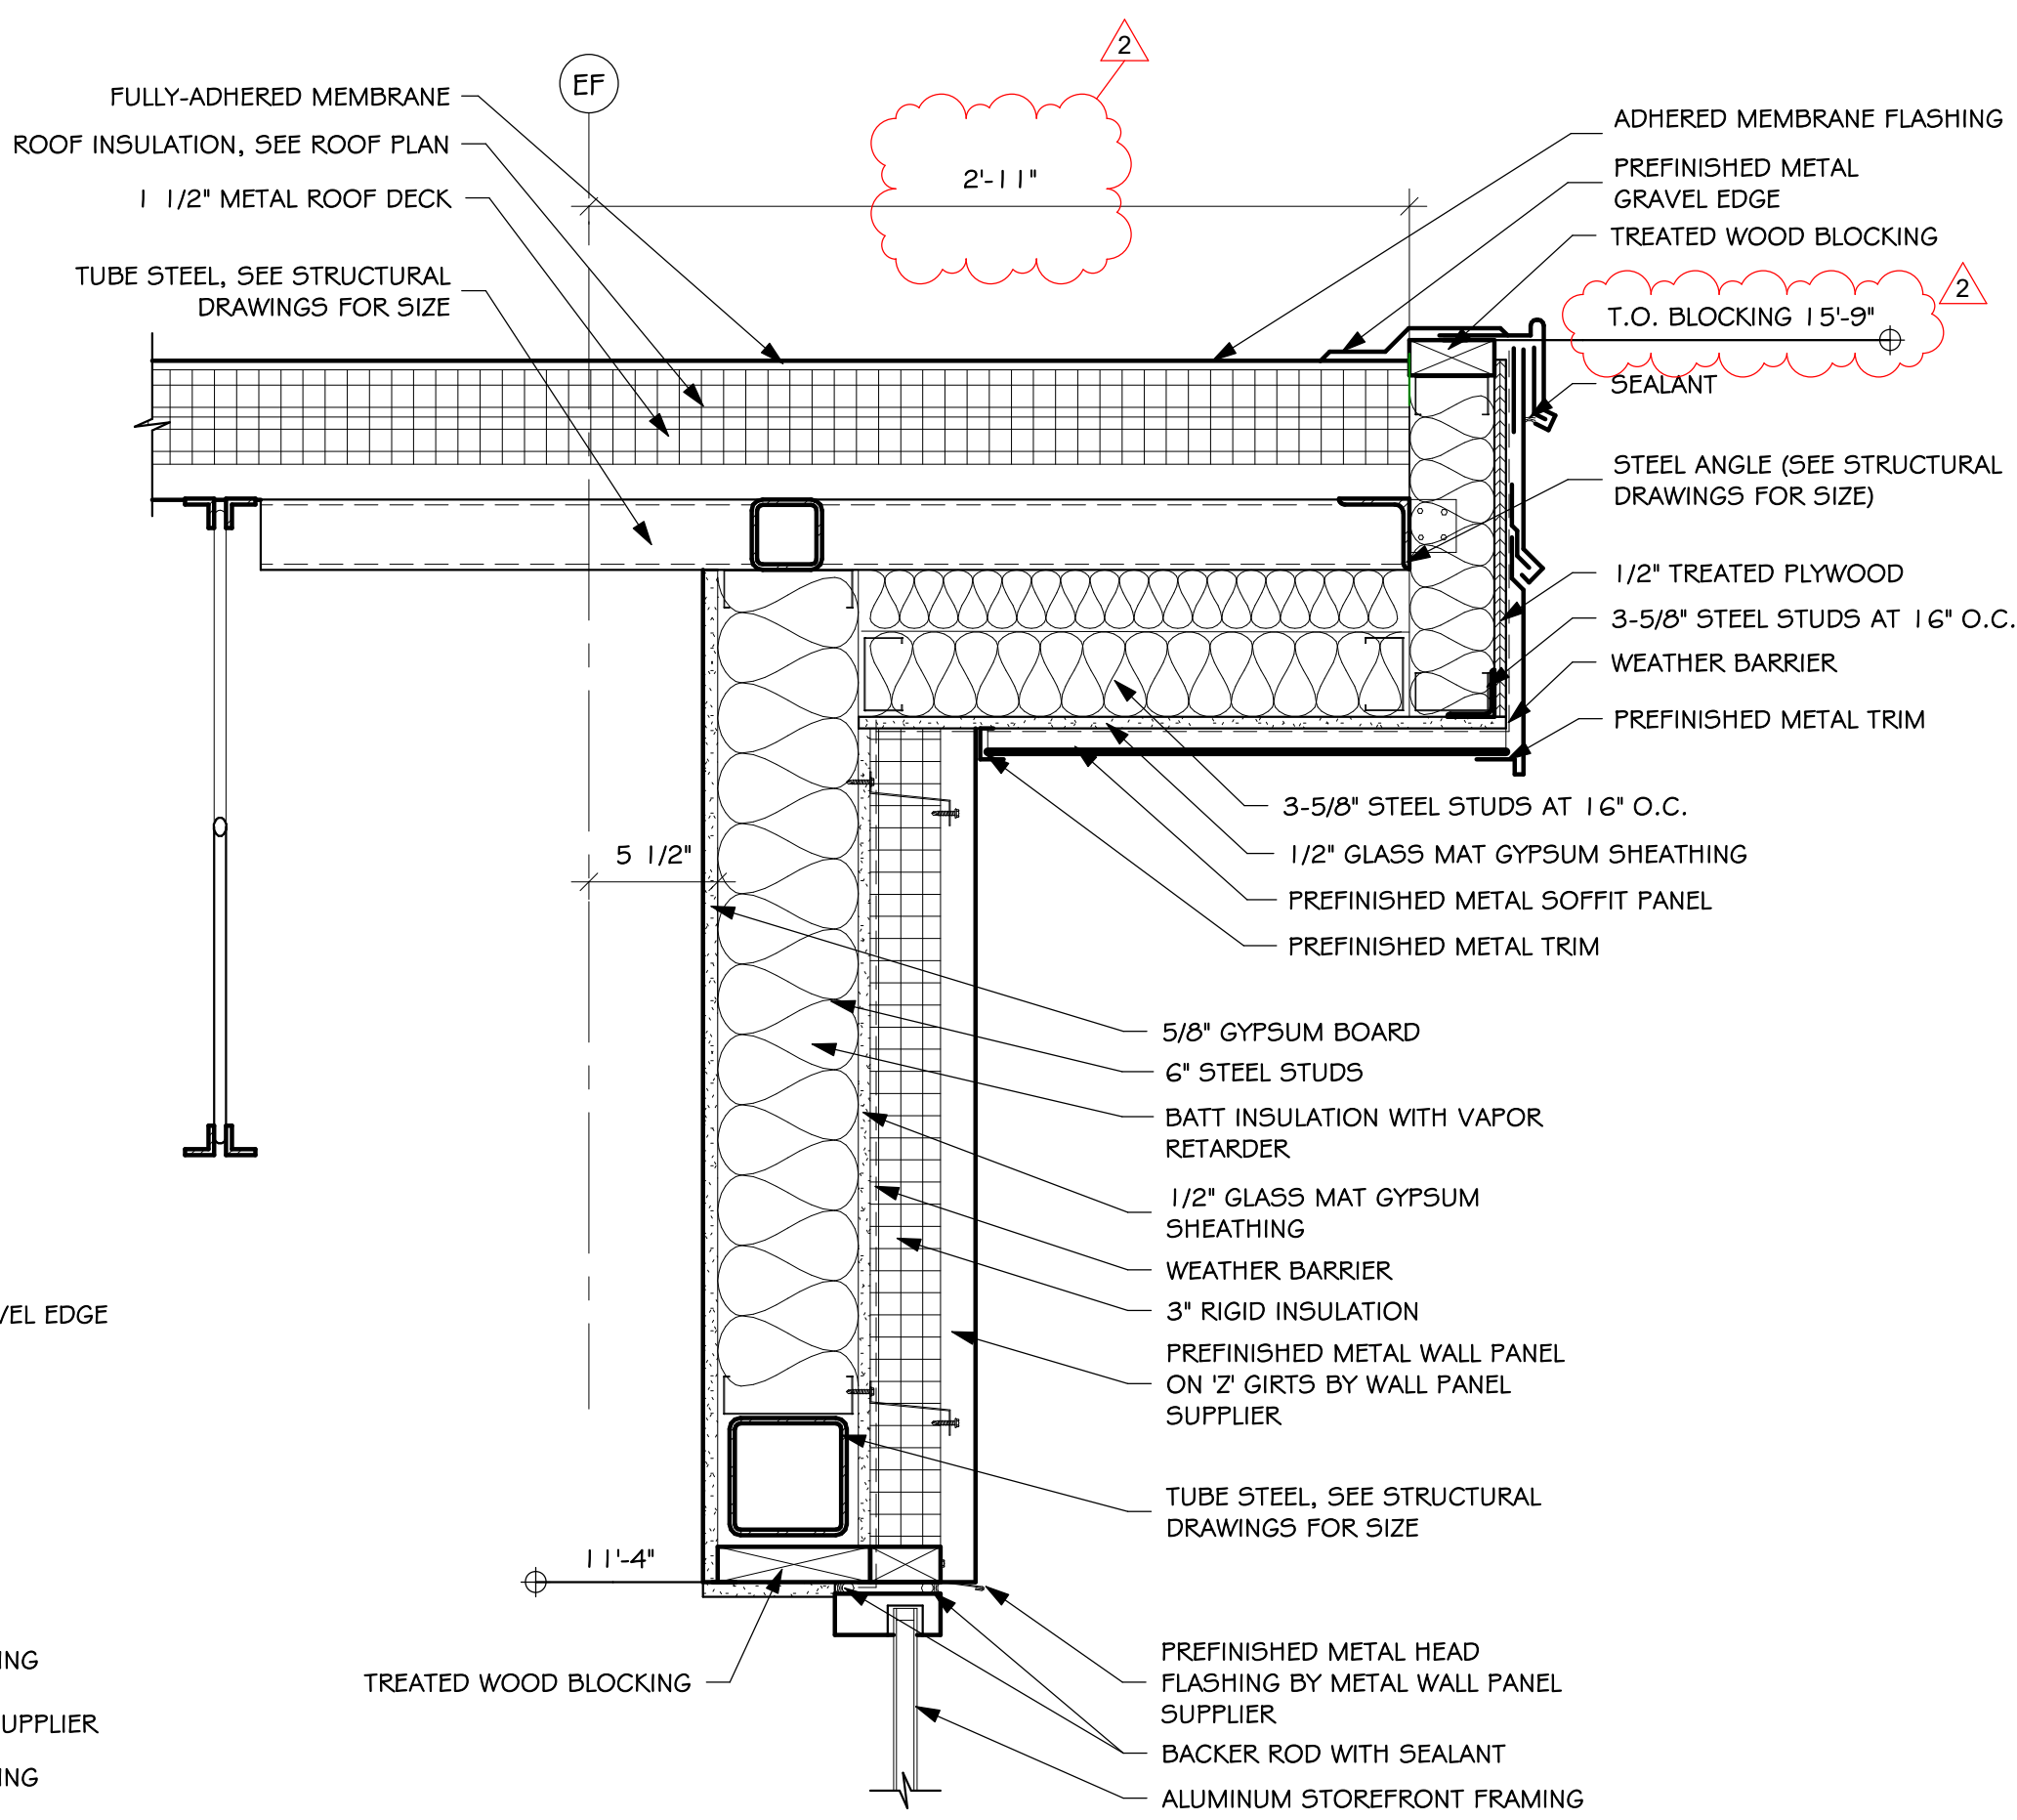


5  
5.42  
DETAIL - AREA E  
SCALE: 1 1/2" = 1'-0"

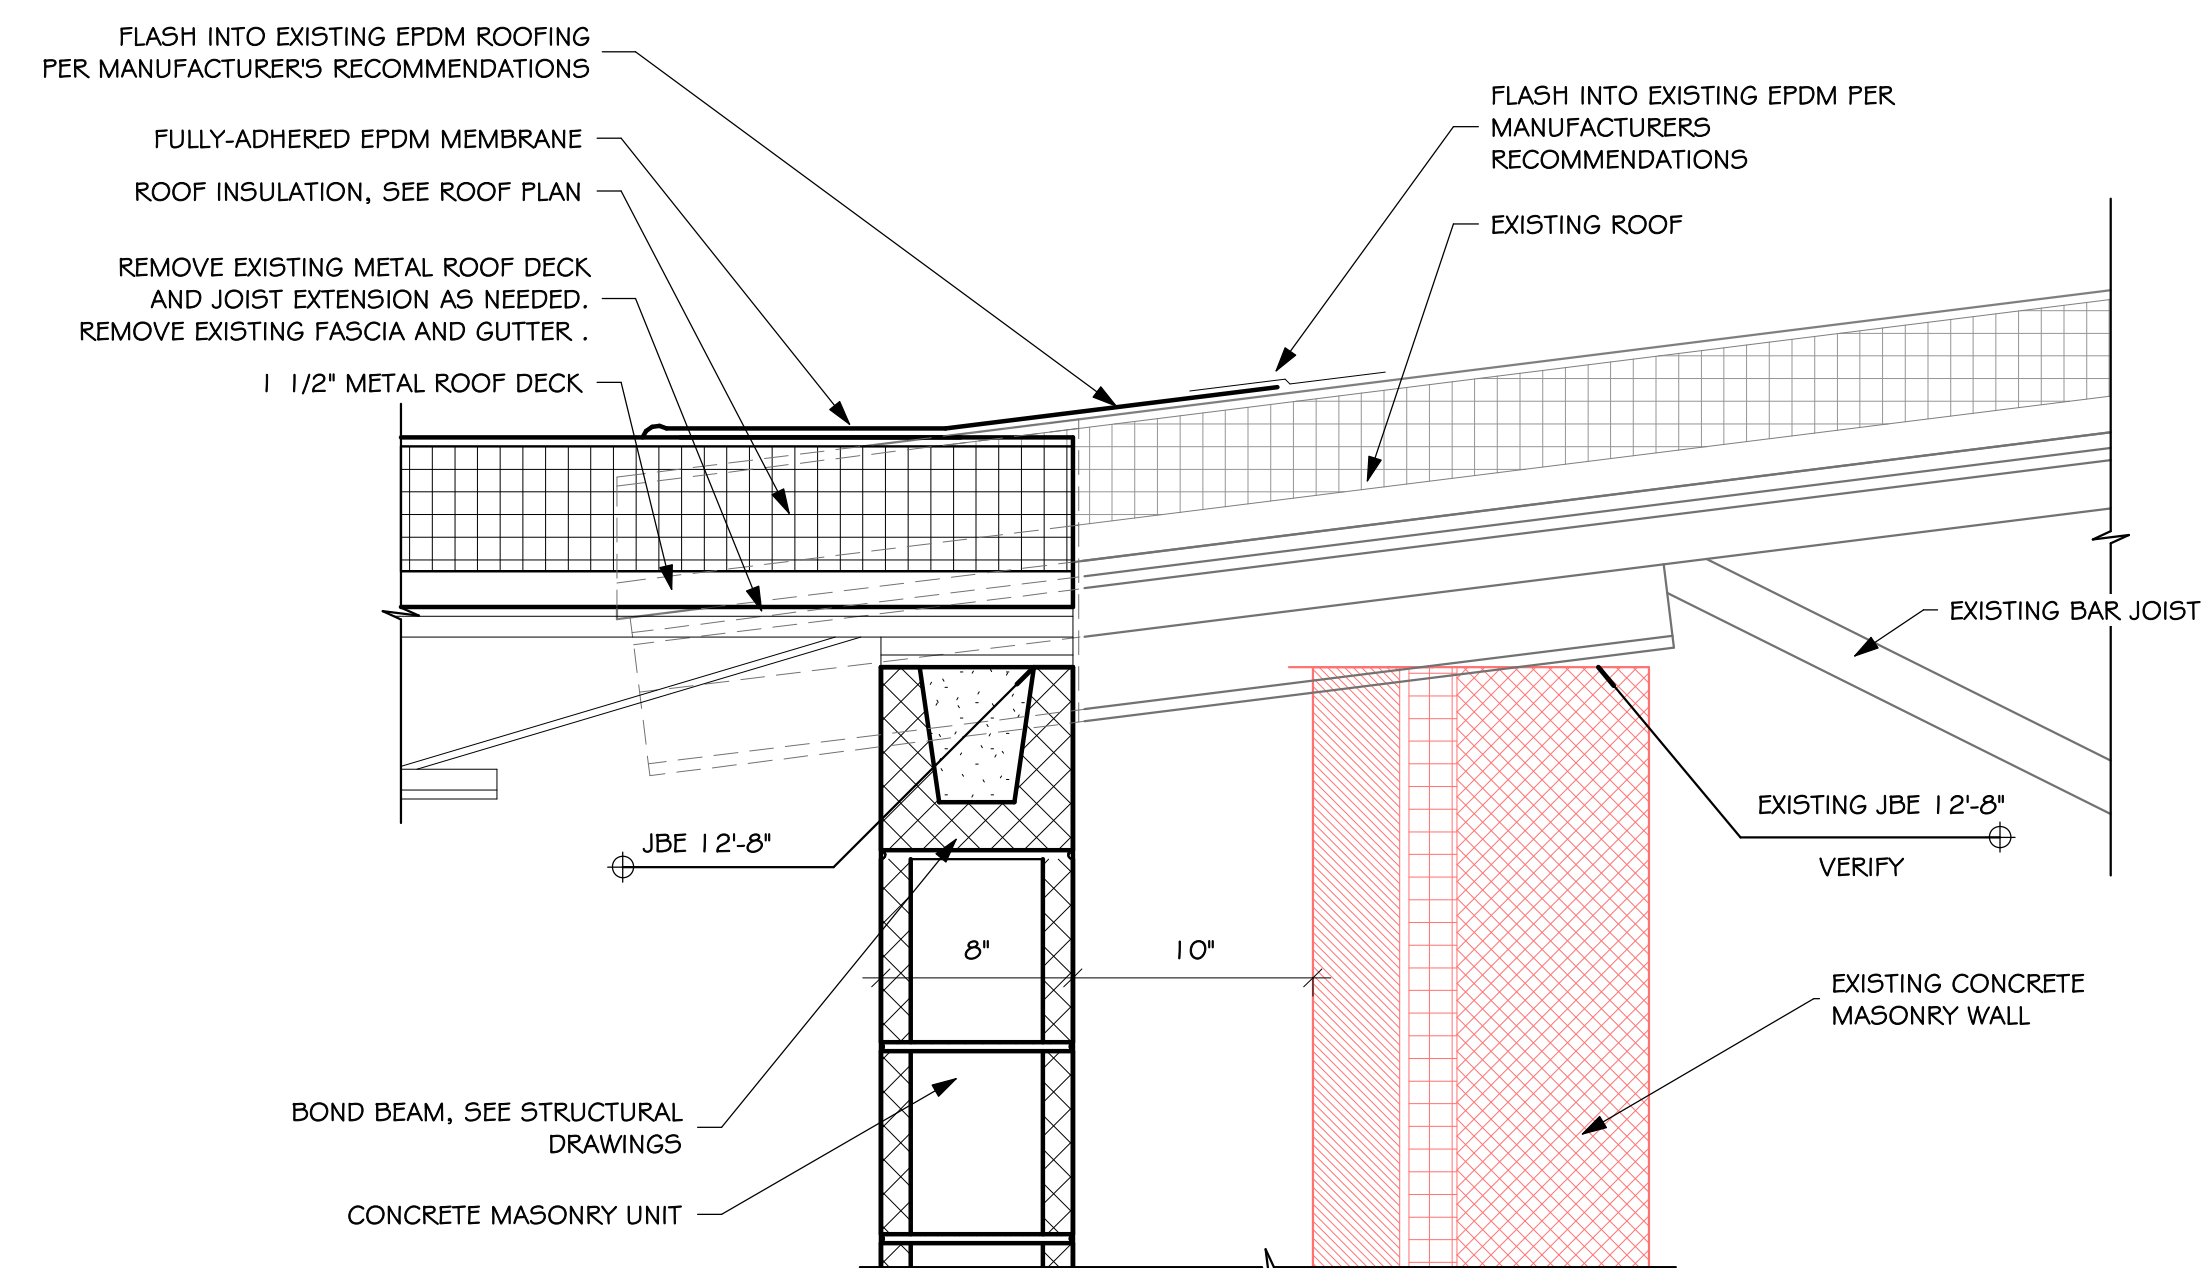


8  
5.42  
DETAIL - AREA D AND G  
SCALE: 1 1/2" = 1'-0"

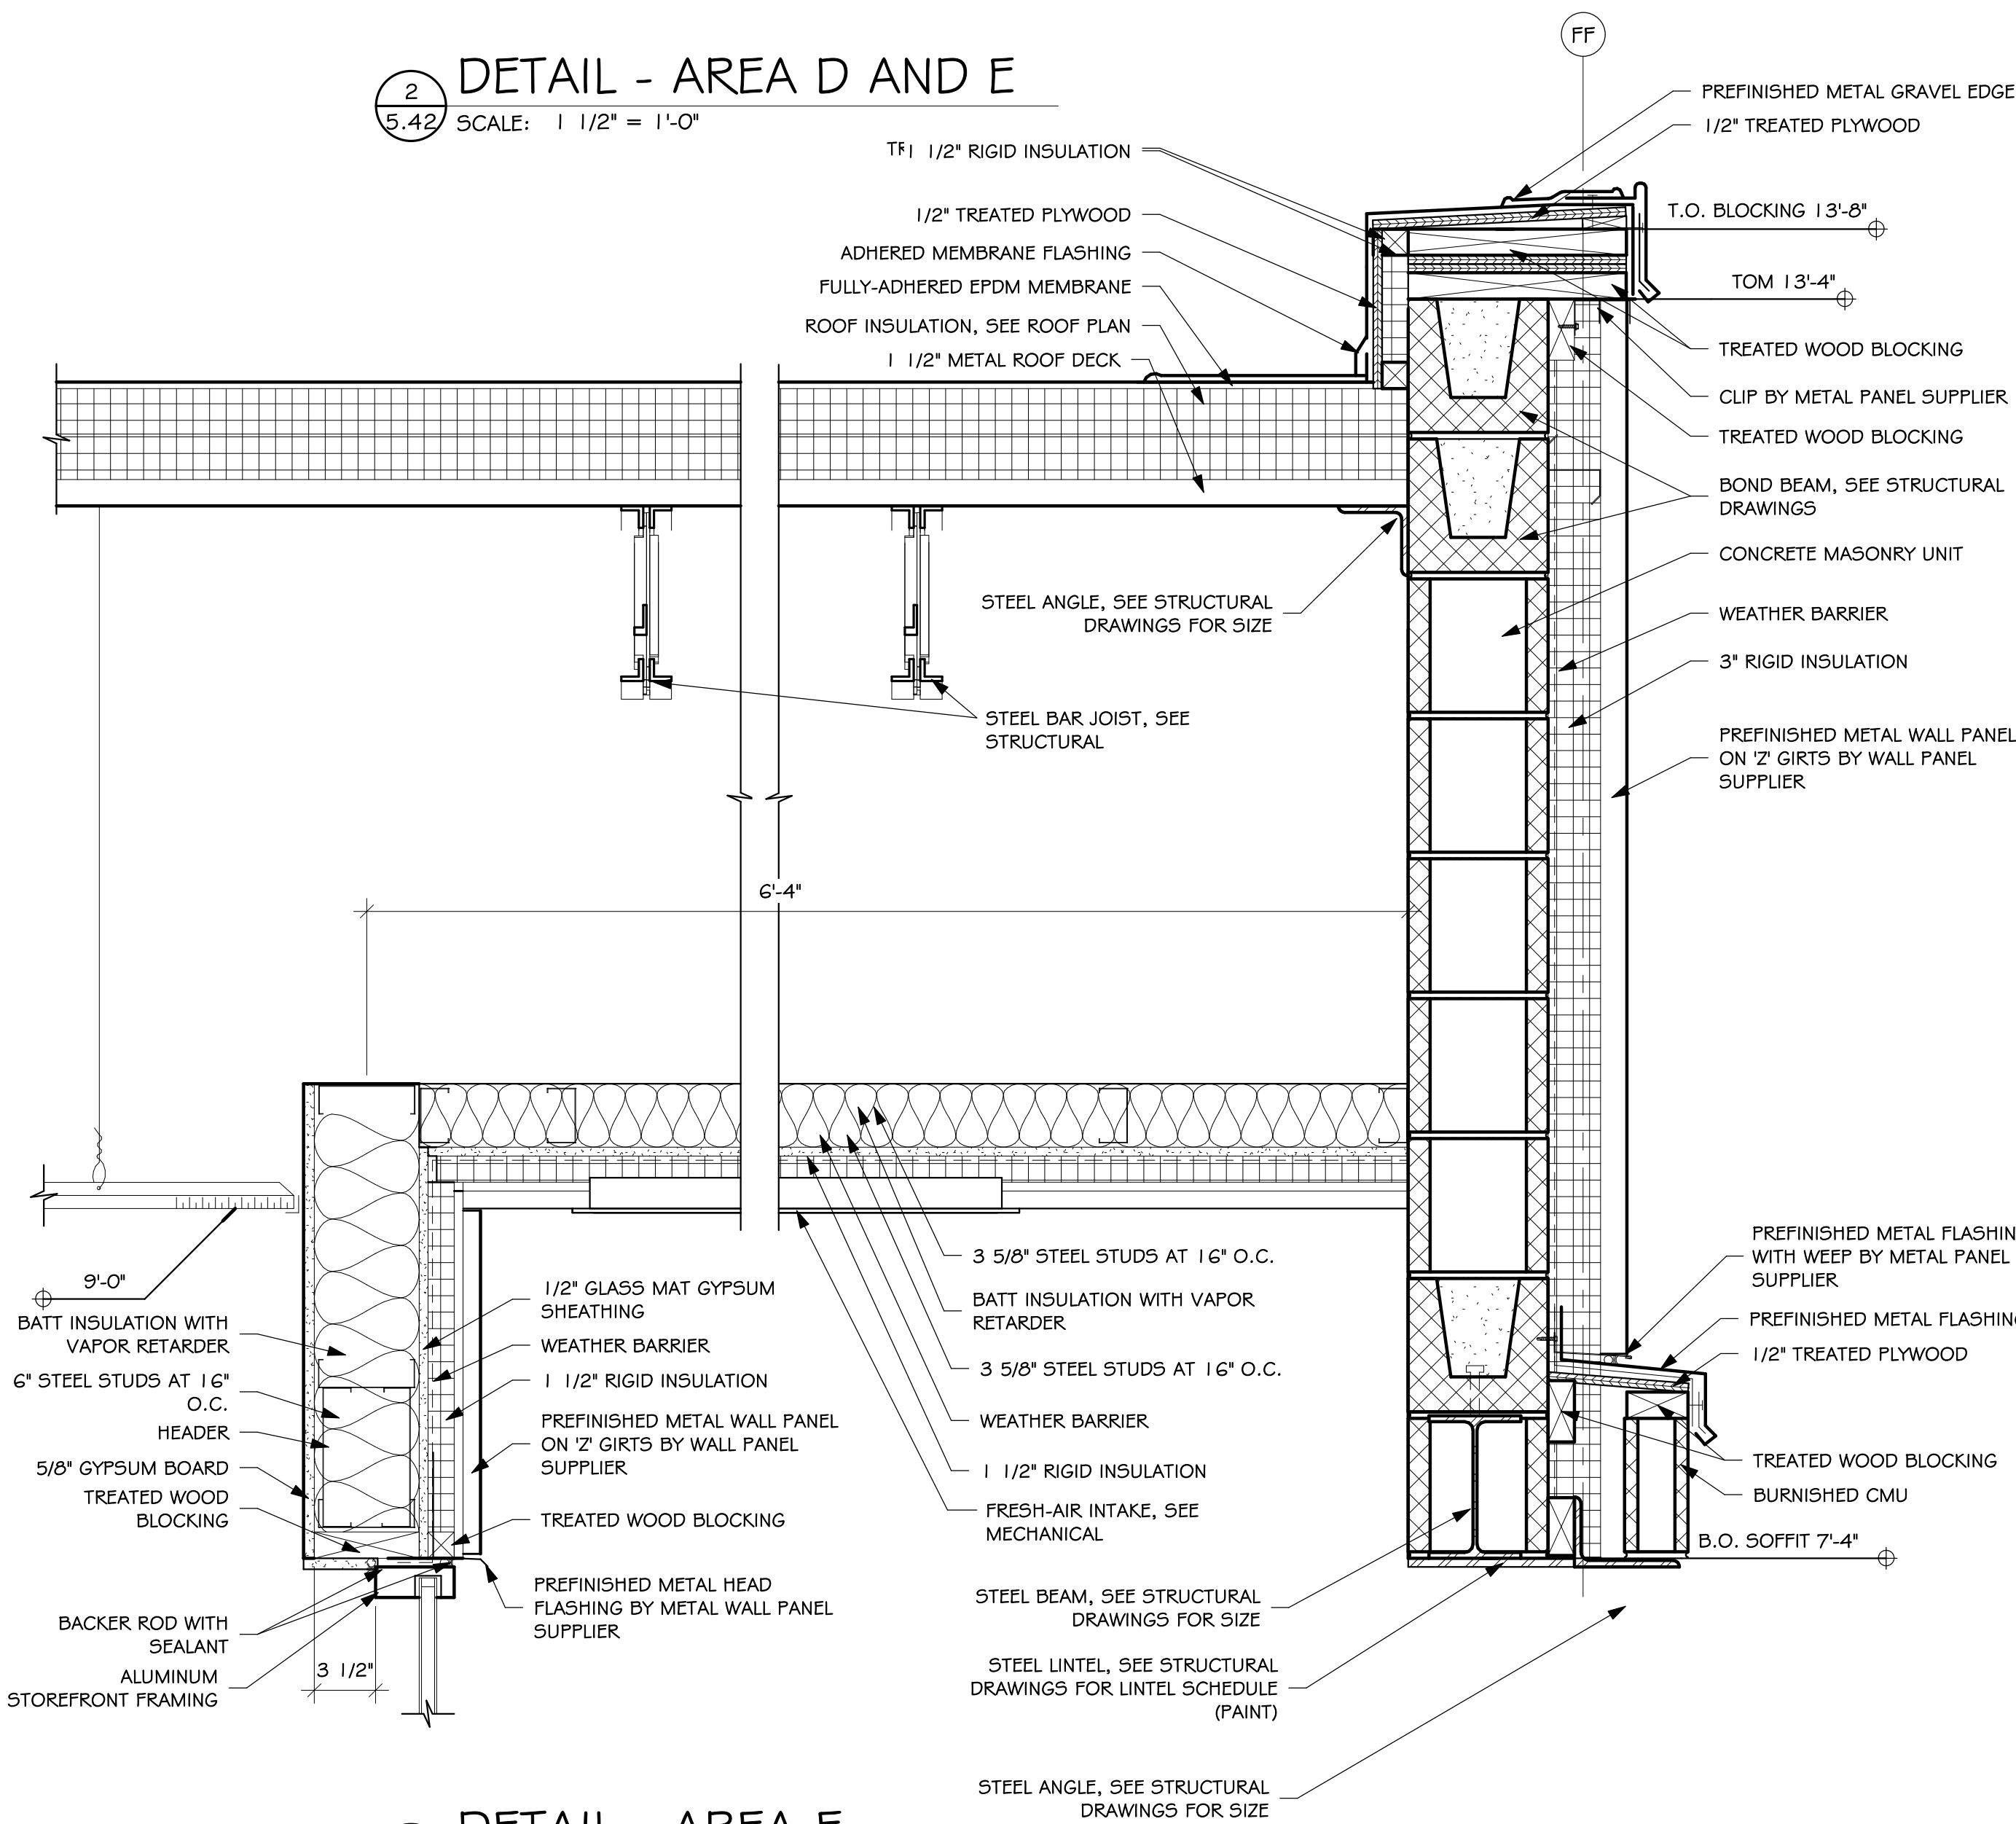


3  
5.42  
DETAIL - AREA E  
SCALE: 1 1/2" = 1'-0"

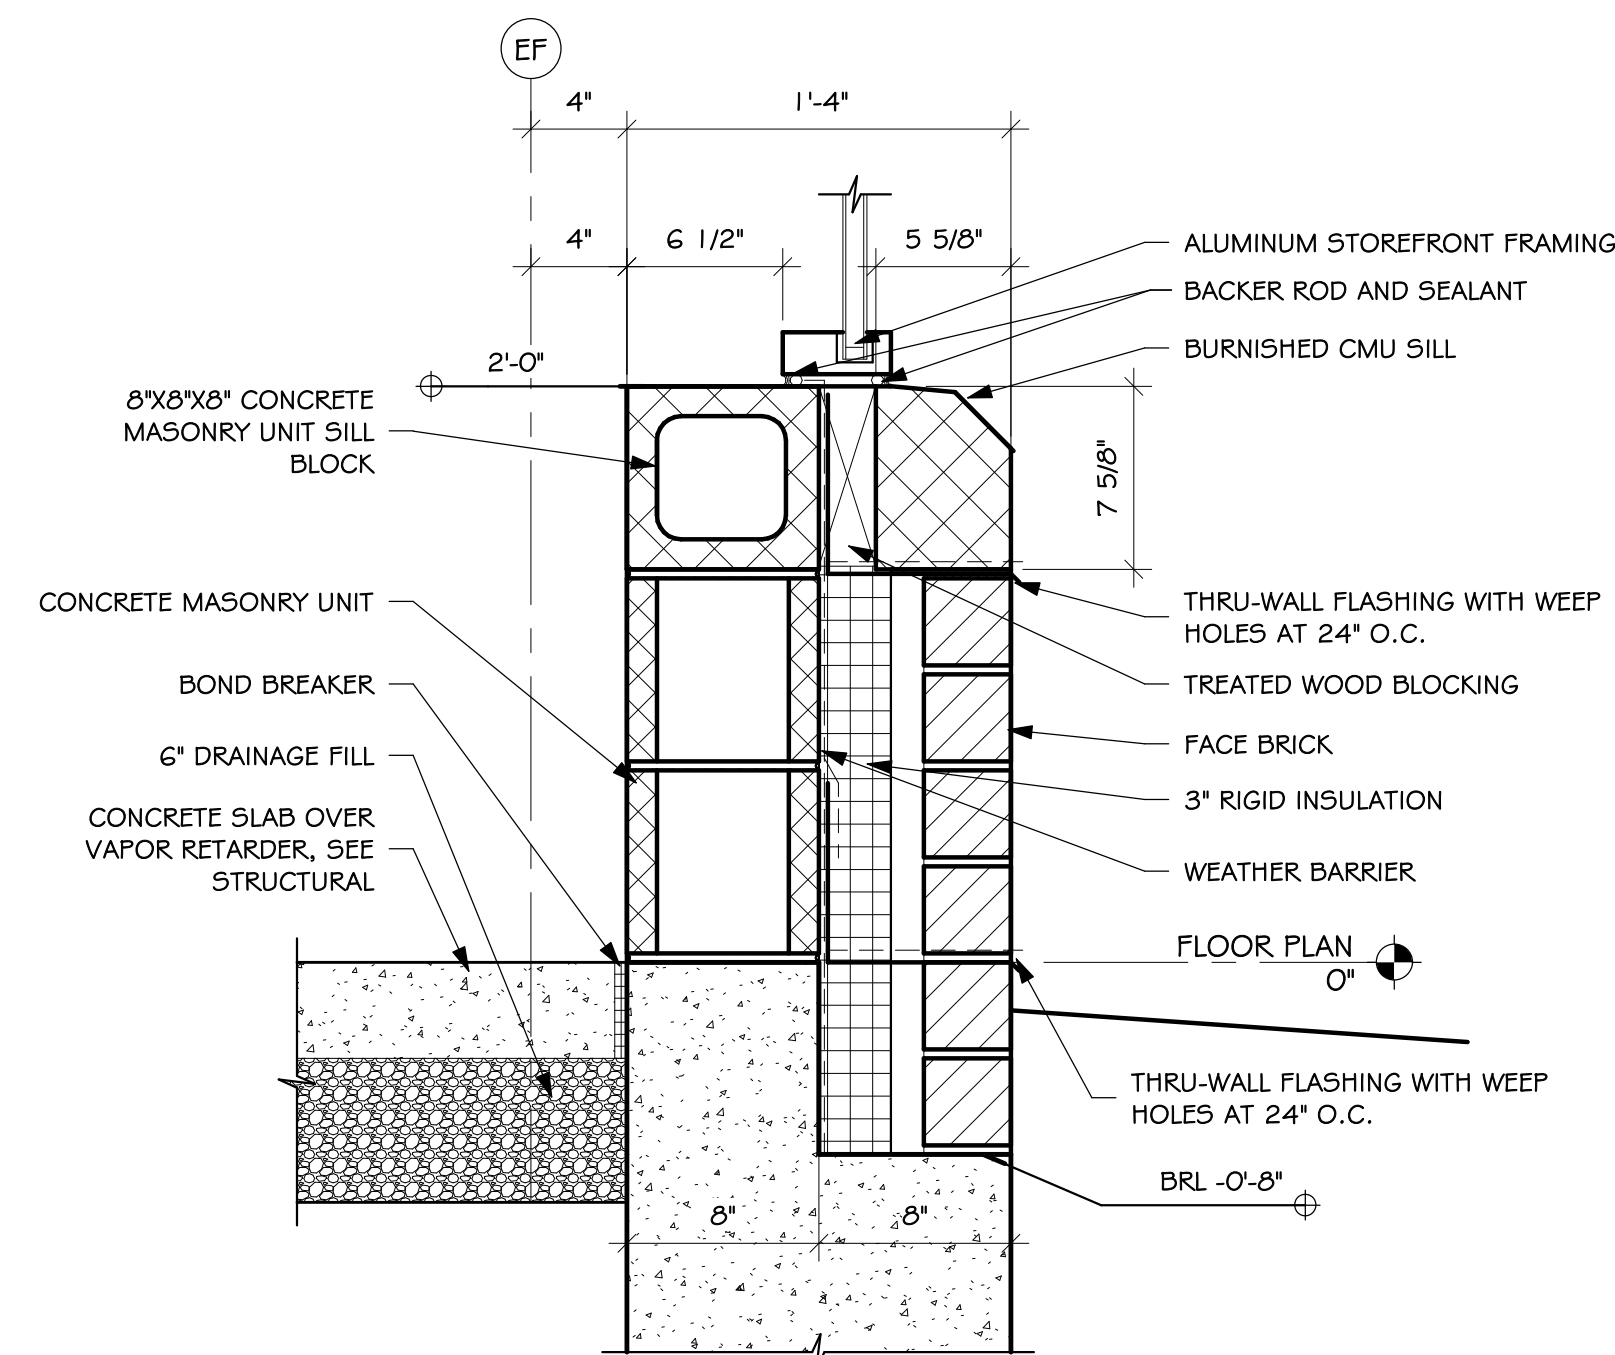

6  
5.42  
DETAIL - AREA E  
SCALE: 1 1/2" = 1'-0"

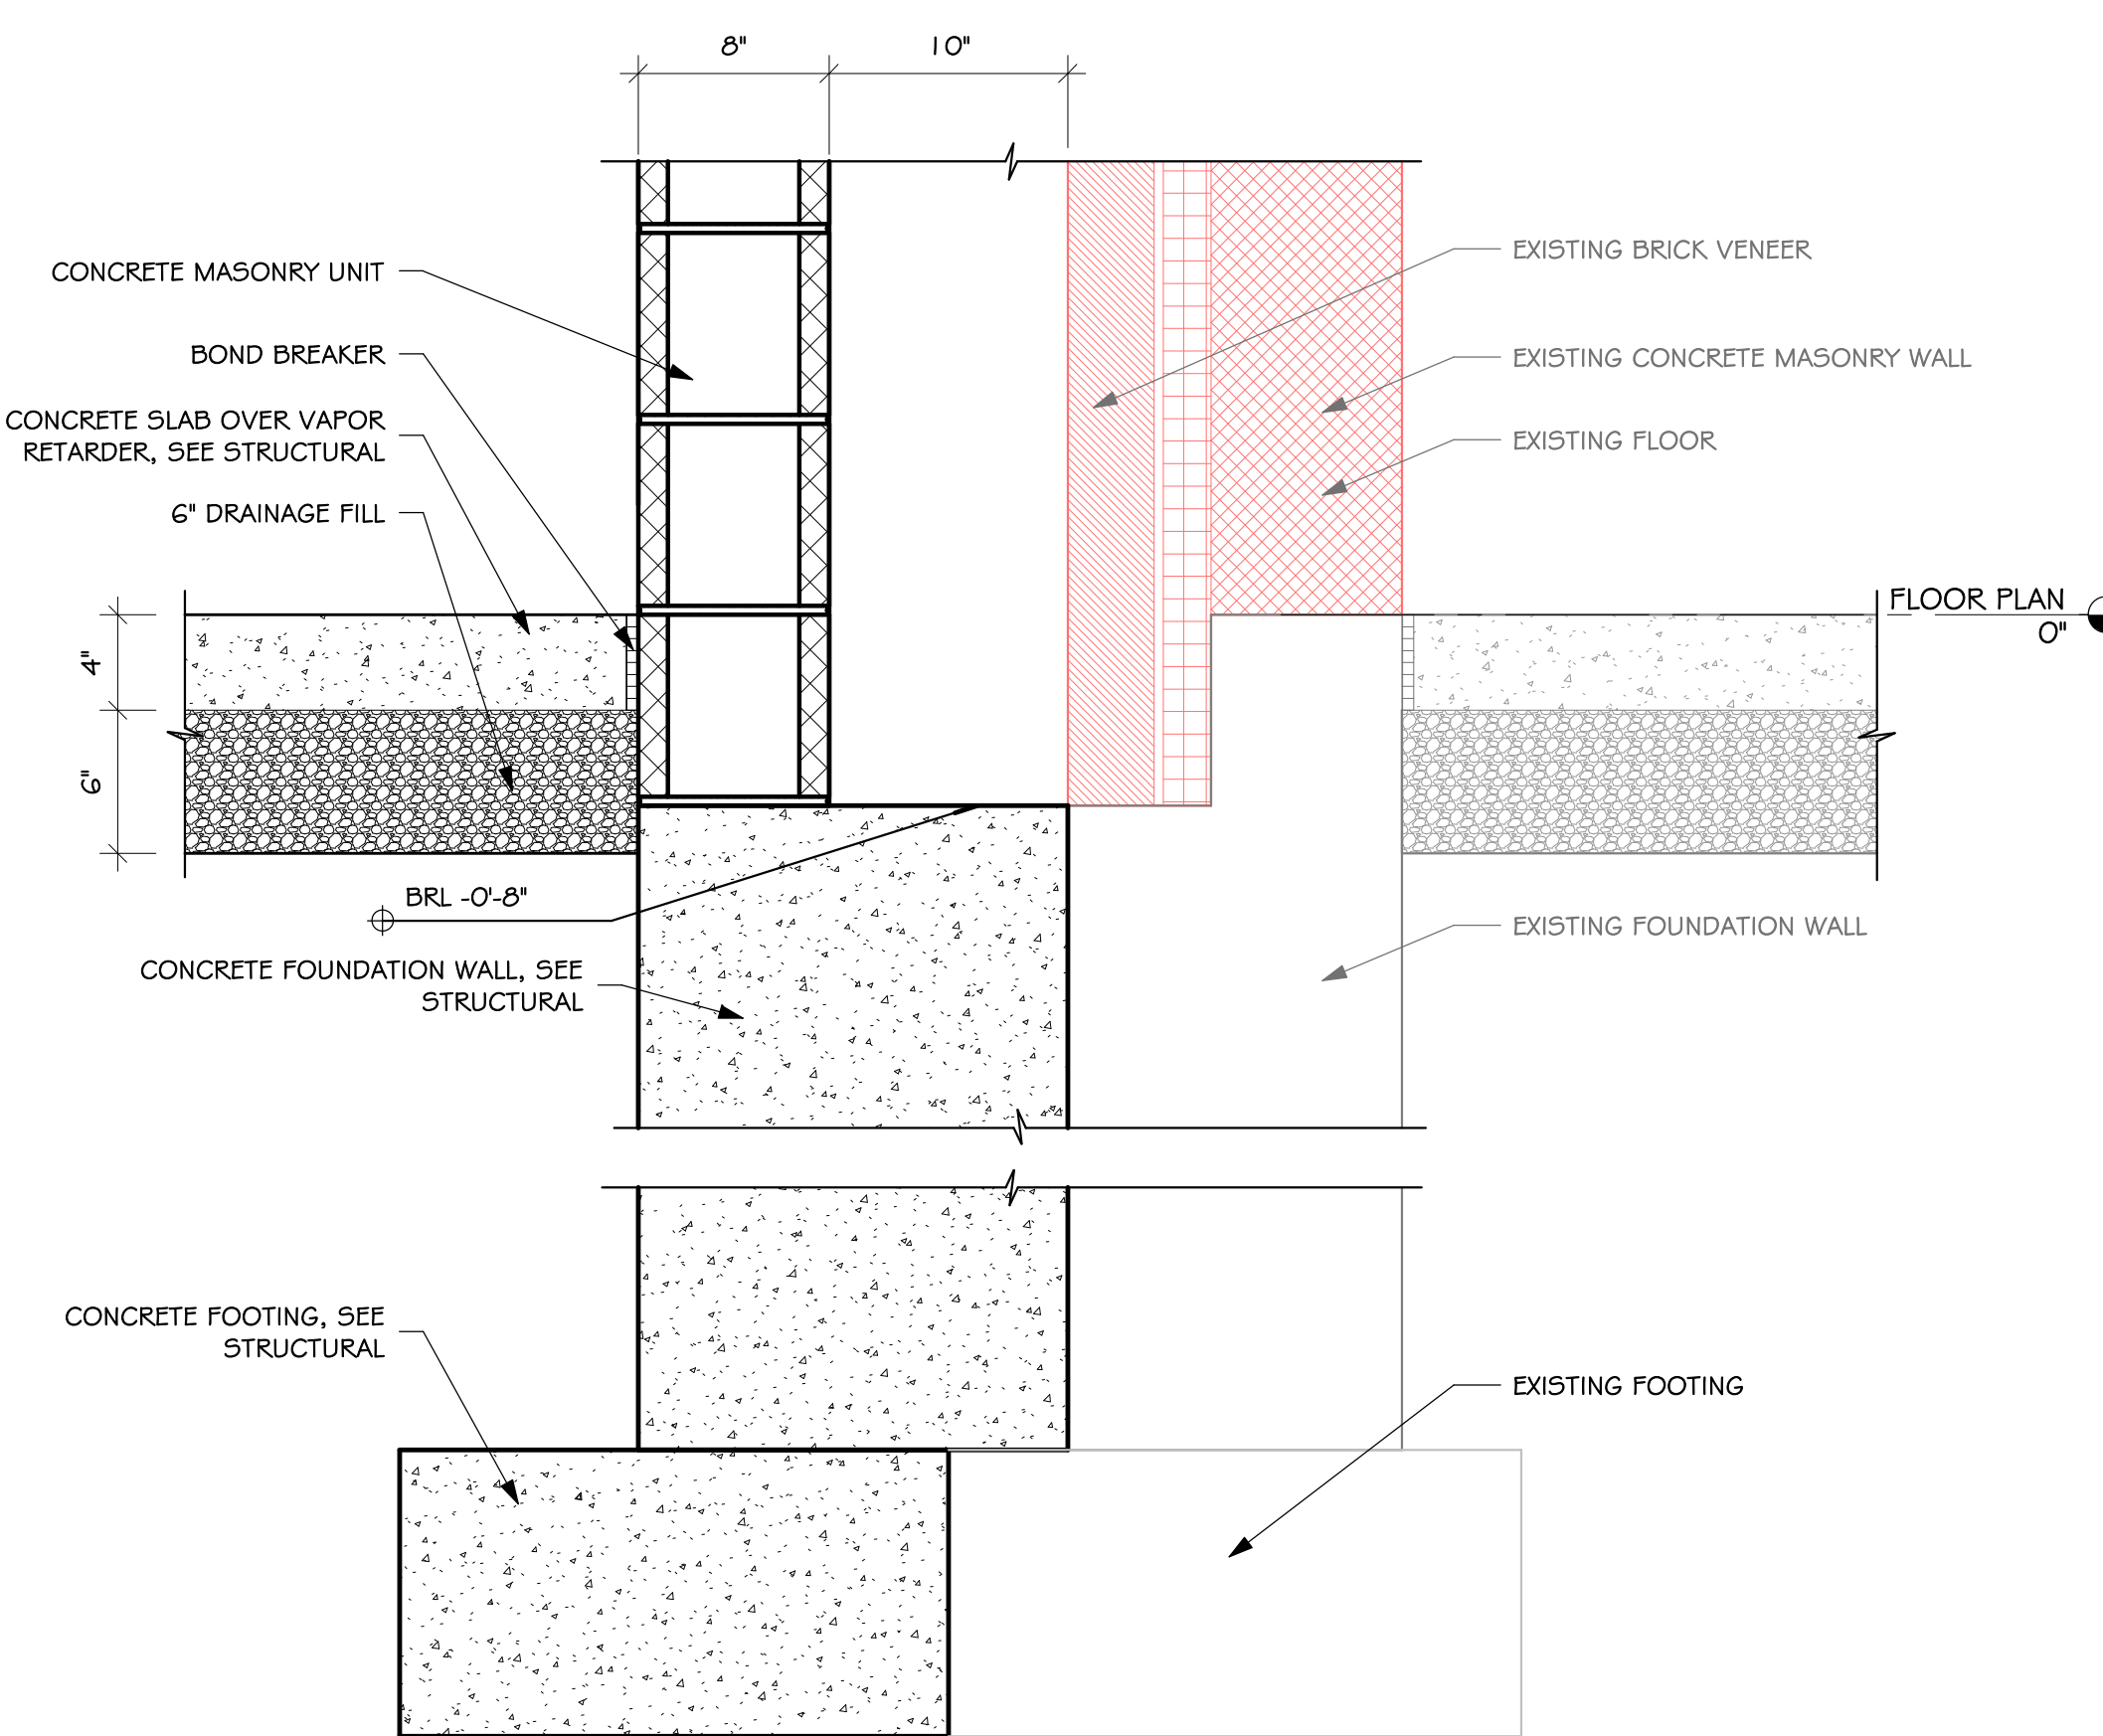

9  
5.42  
DETAIL - AREA D AND G  
SCALE: 1 1/2" = 1'-0"

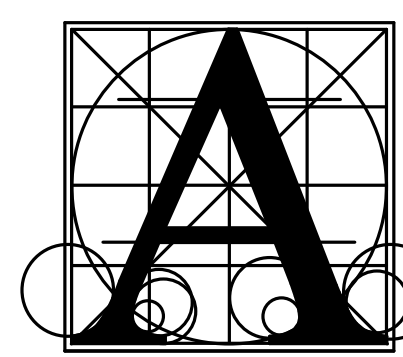

Architecture  
Incorporated

415 South Main Avenue  
P.O. Box 2140  
Sioux Falls, South Dakota 57101  
Phone: (605) 339-1711

815 St Joseph Street, Suite 203  
Rapid City, South Dakota 57701  
Phone: (605) 721-1158



LENNOX HIGH SCHOOL ADDITION

sheet contents

SECTION DETAILS




















number	0215.2902.22
date	DECEMBER 21, 2023
revision	
drawn	MS
checked	SRJ

DATE	DESCRIPTION
1/18/2024	ADDENDUM #2

5.42



1/18/2024 5:14:07 PM

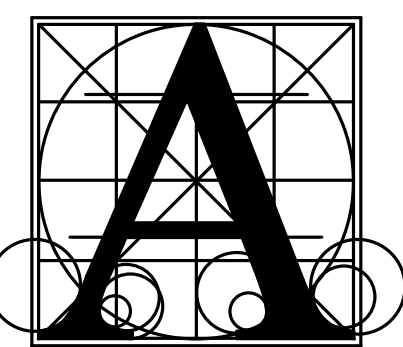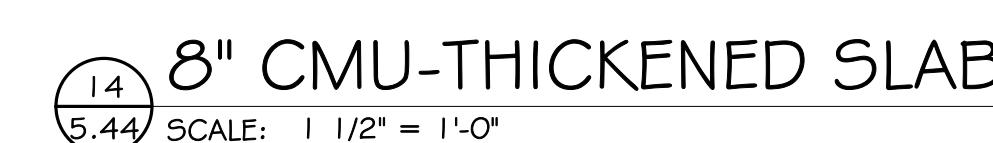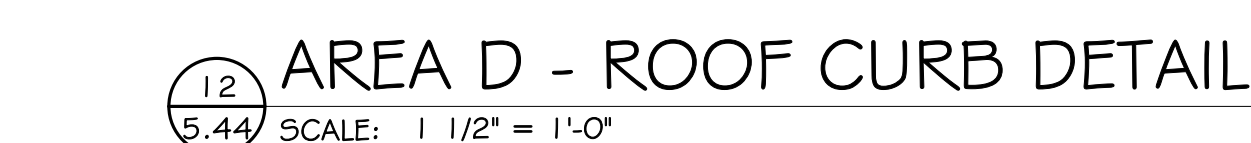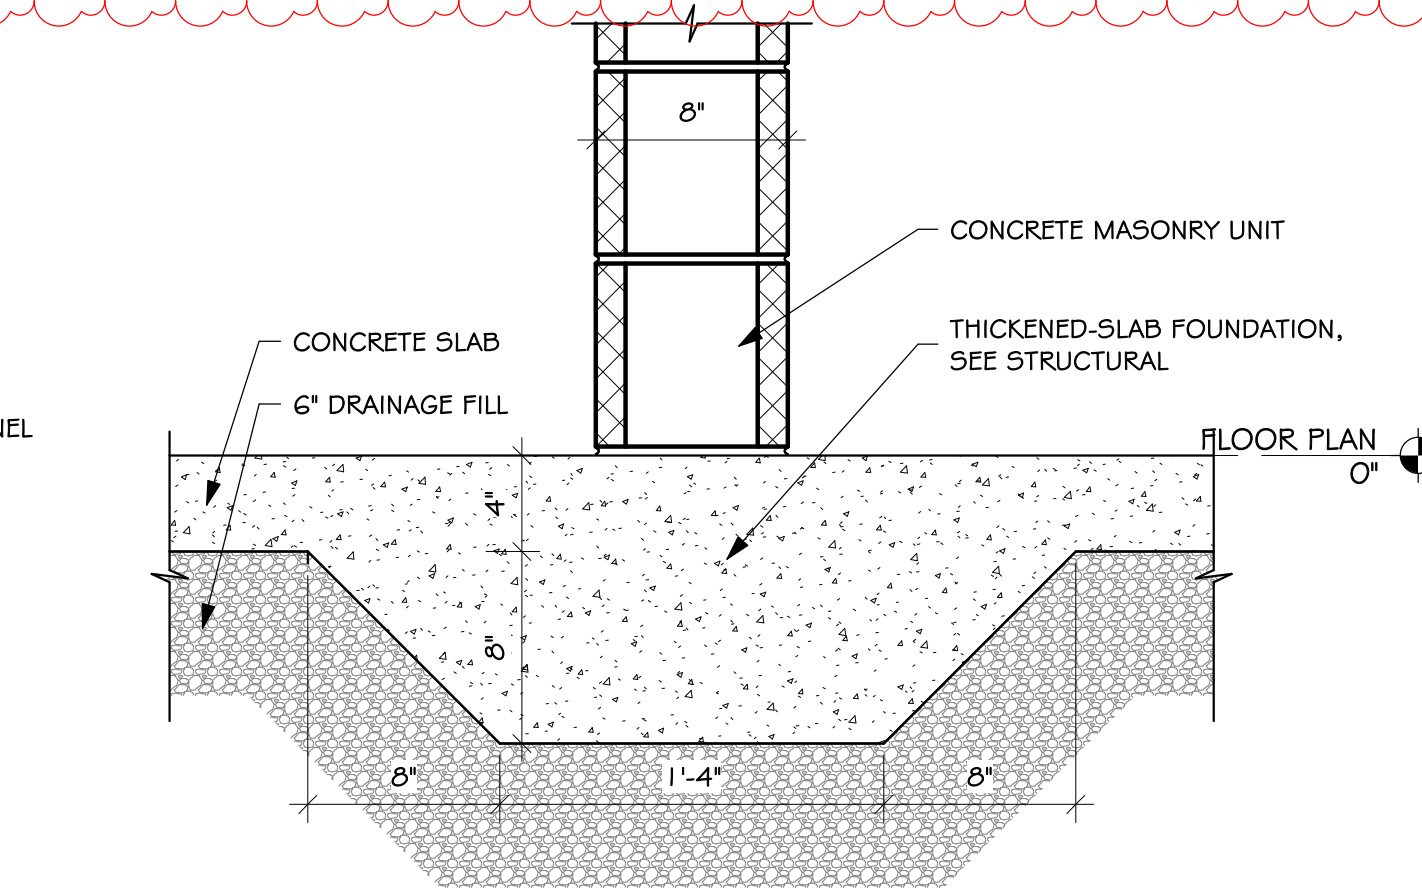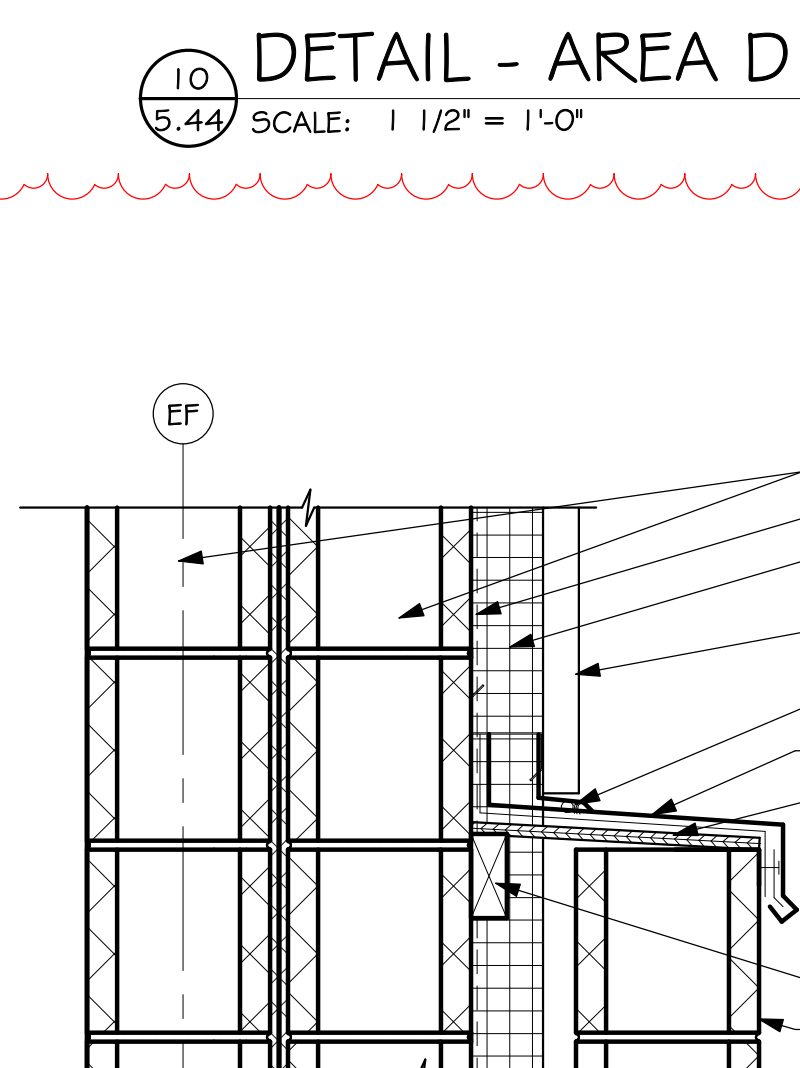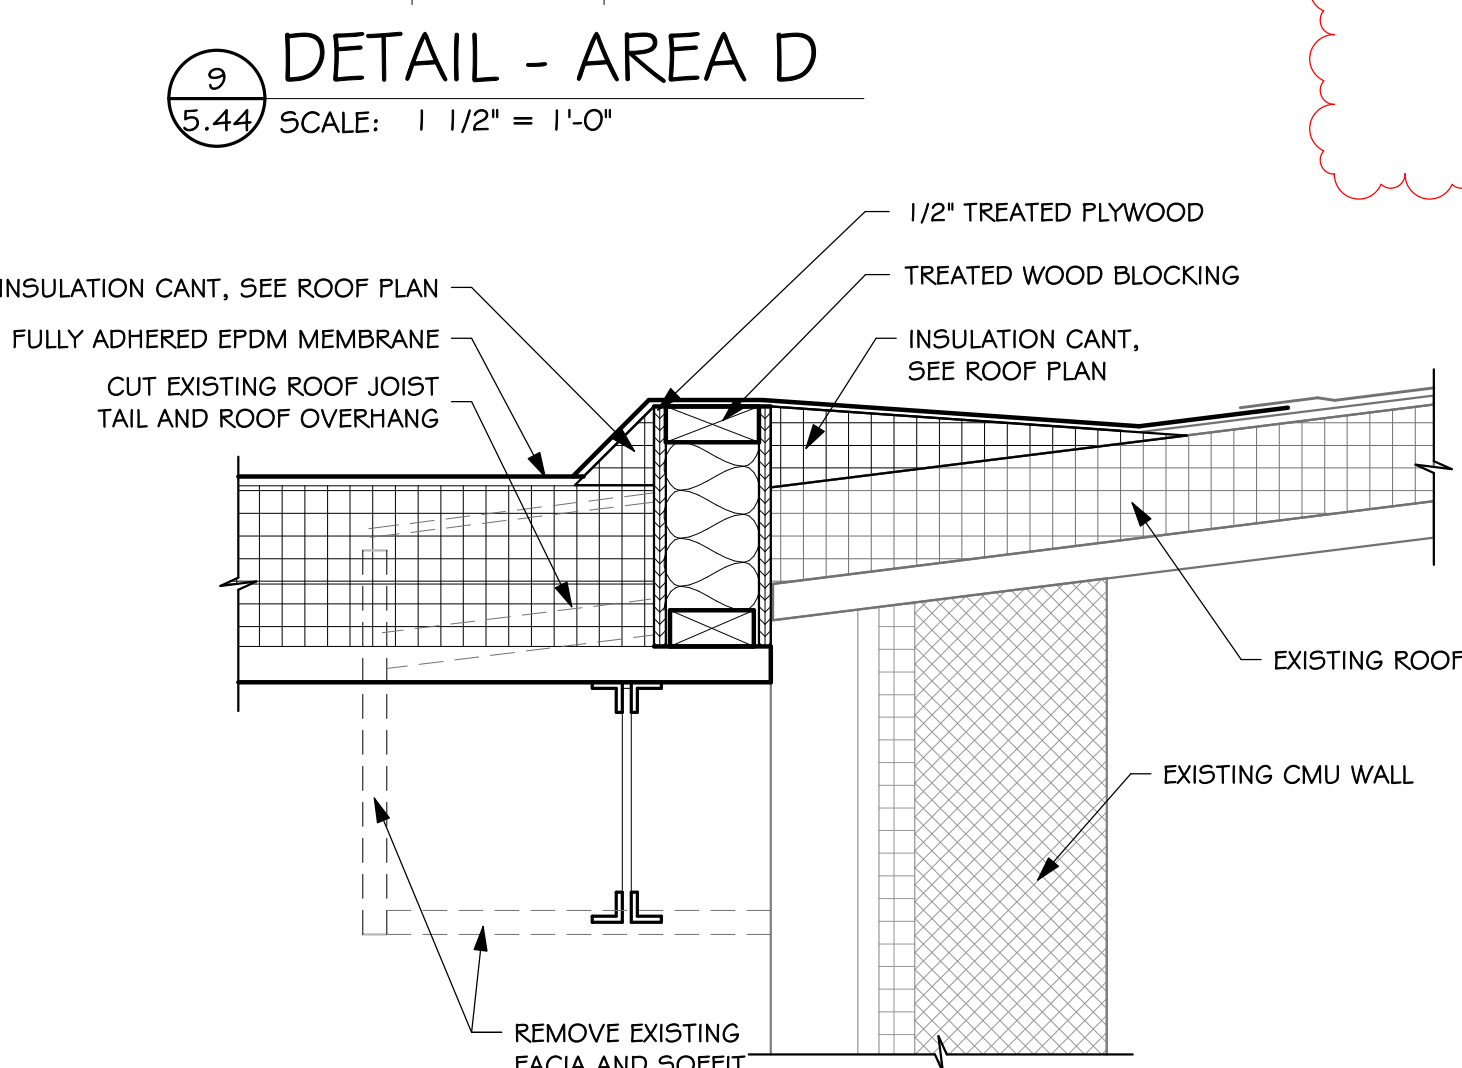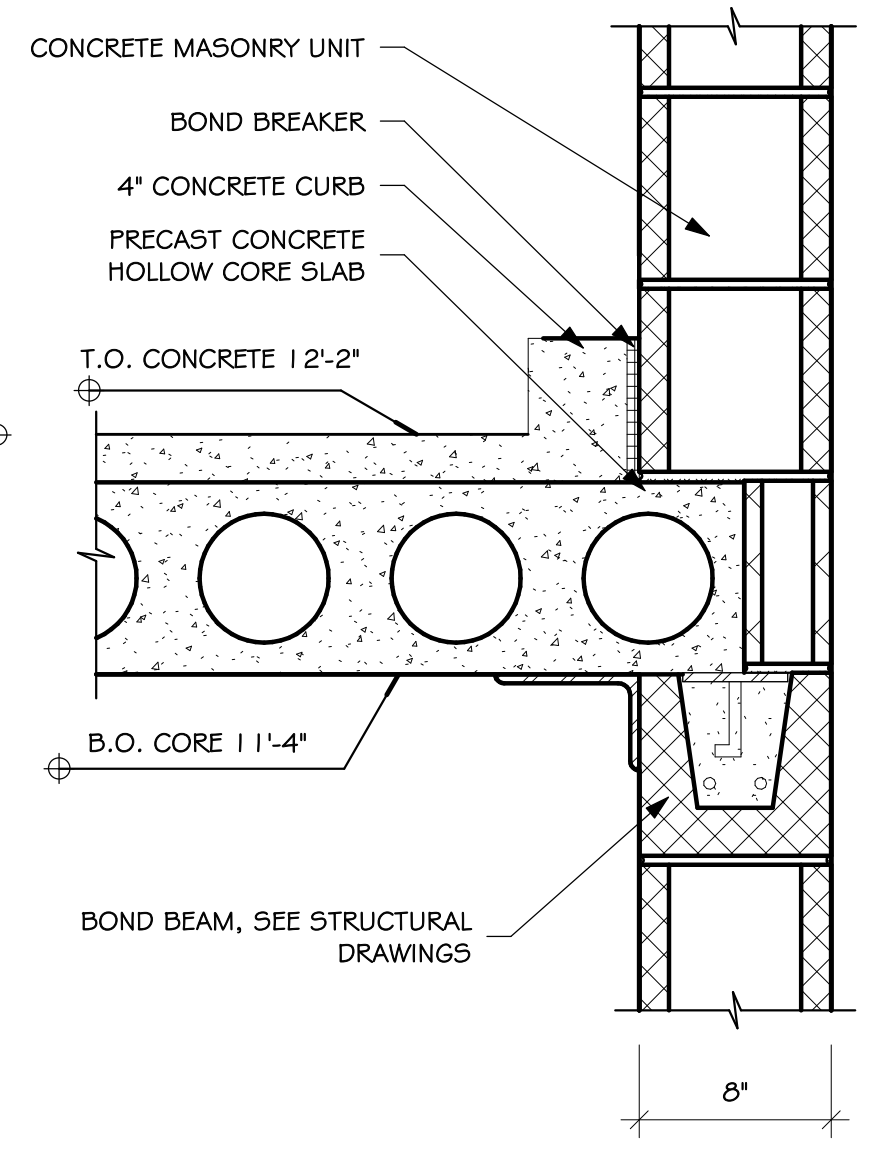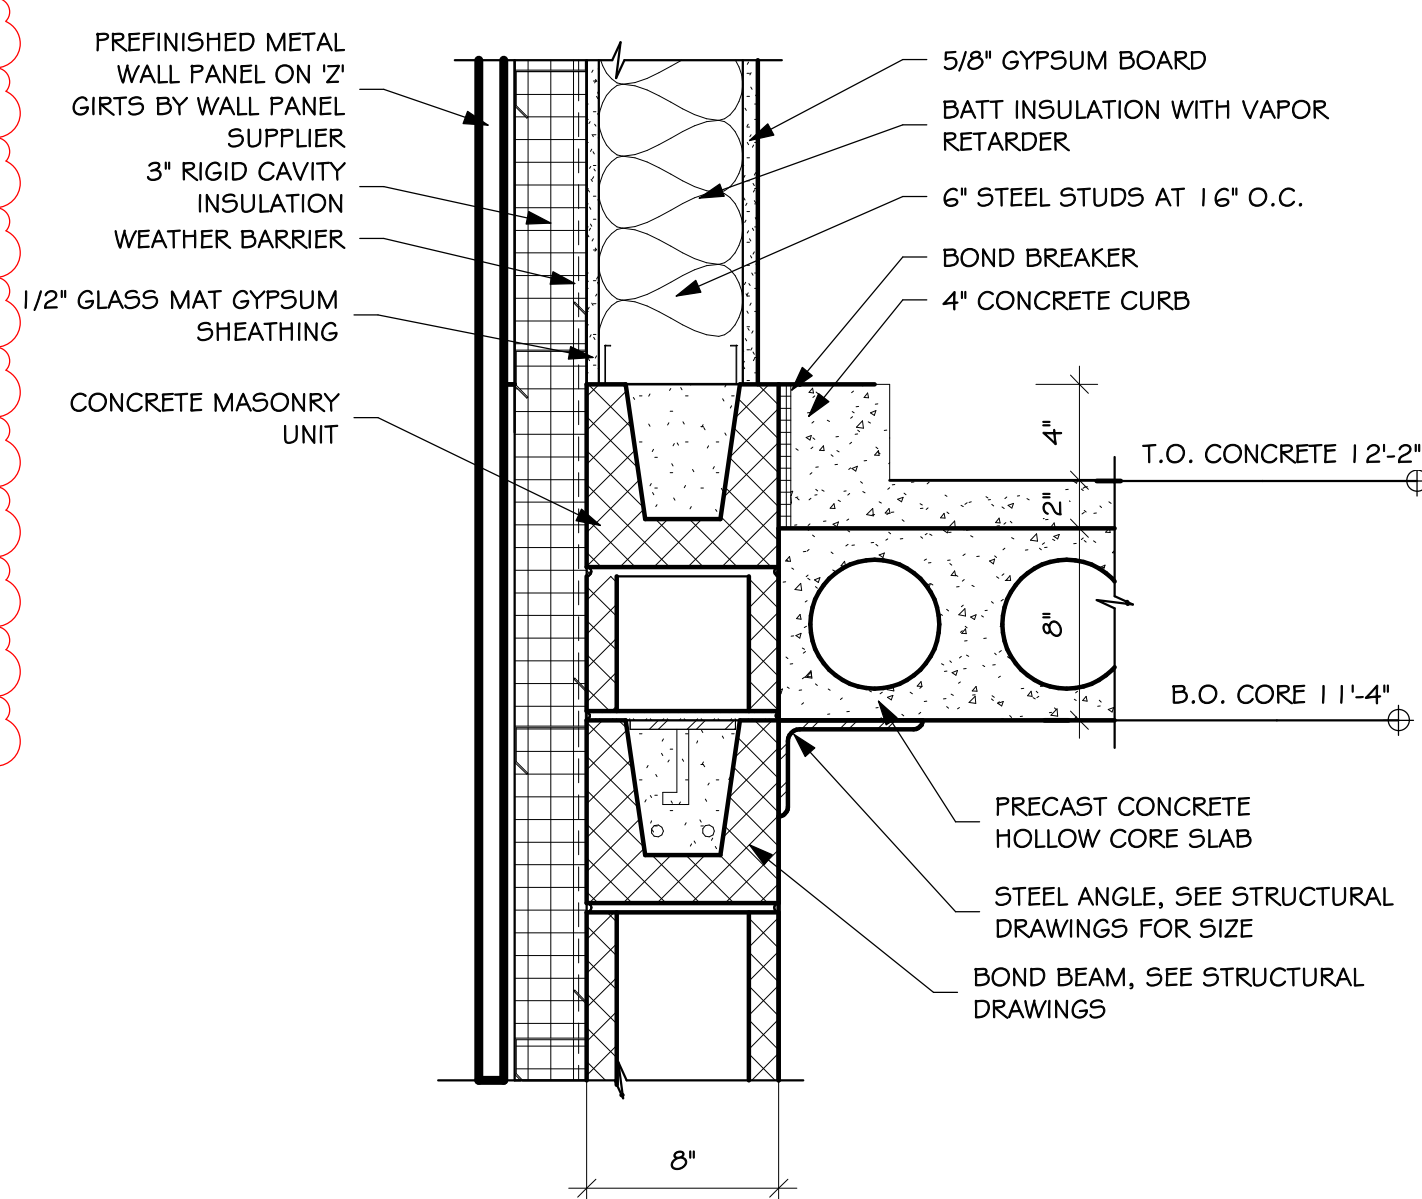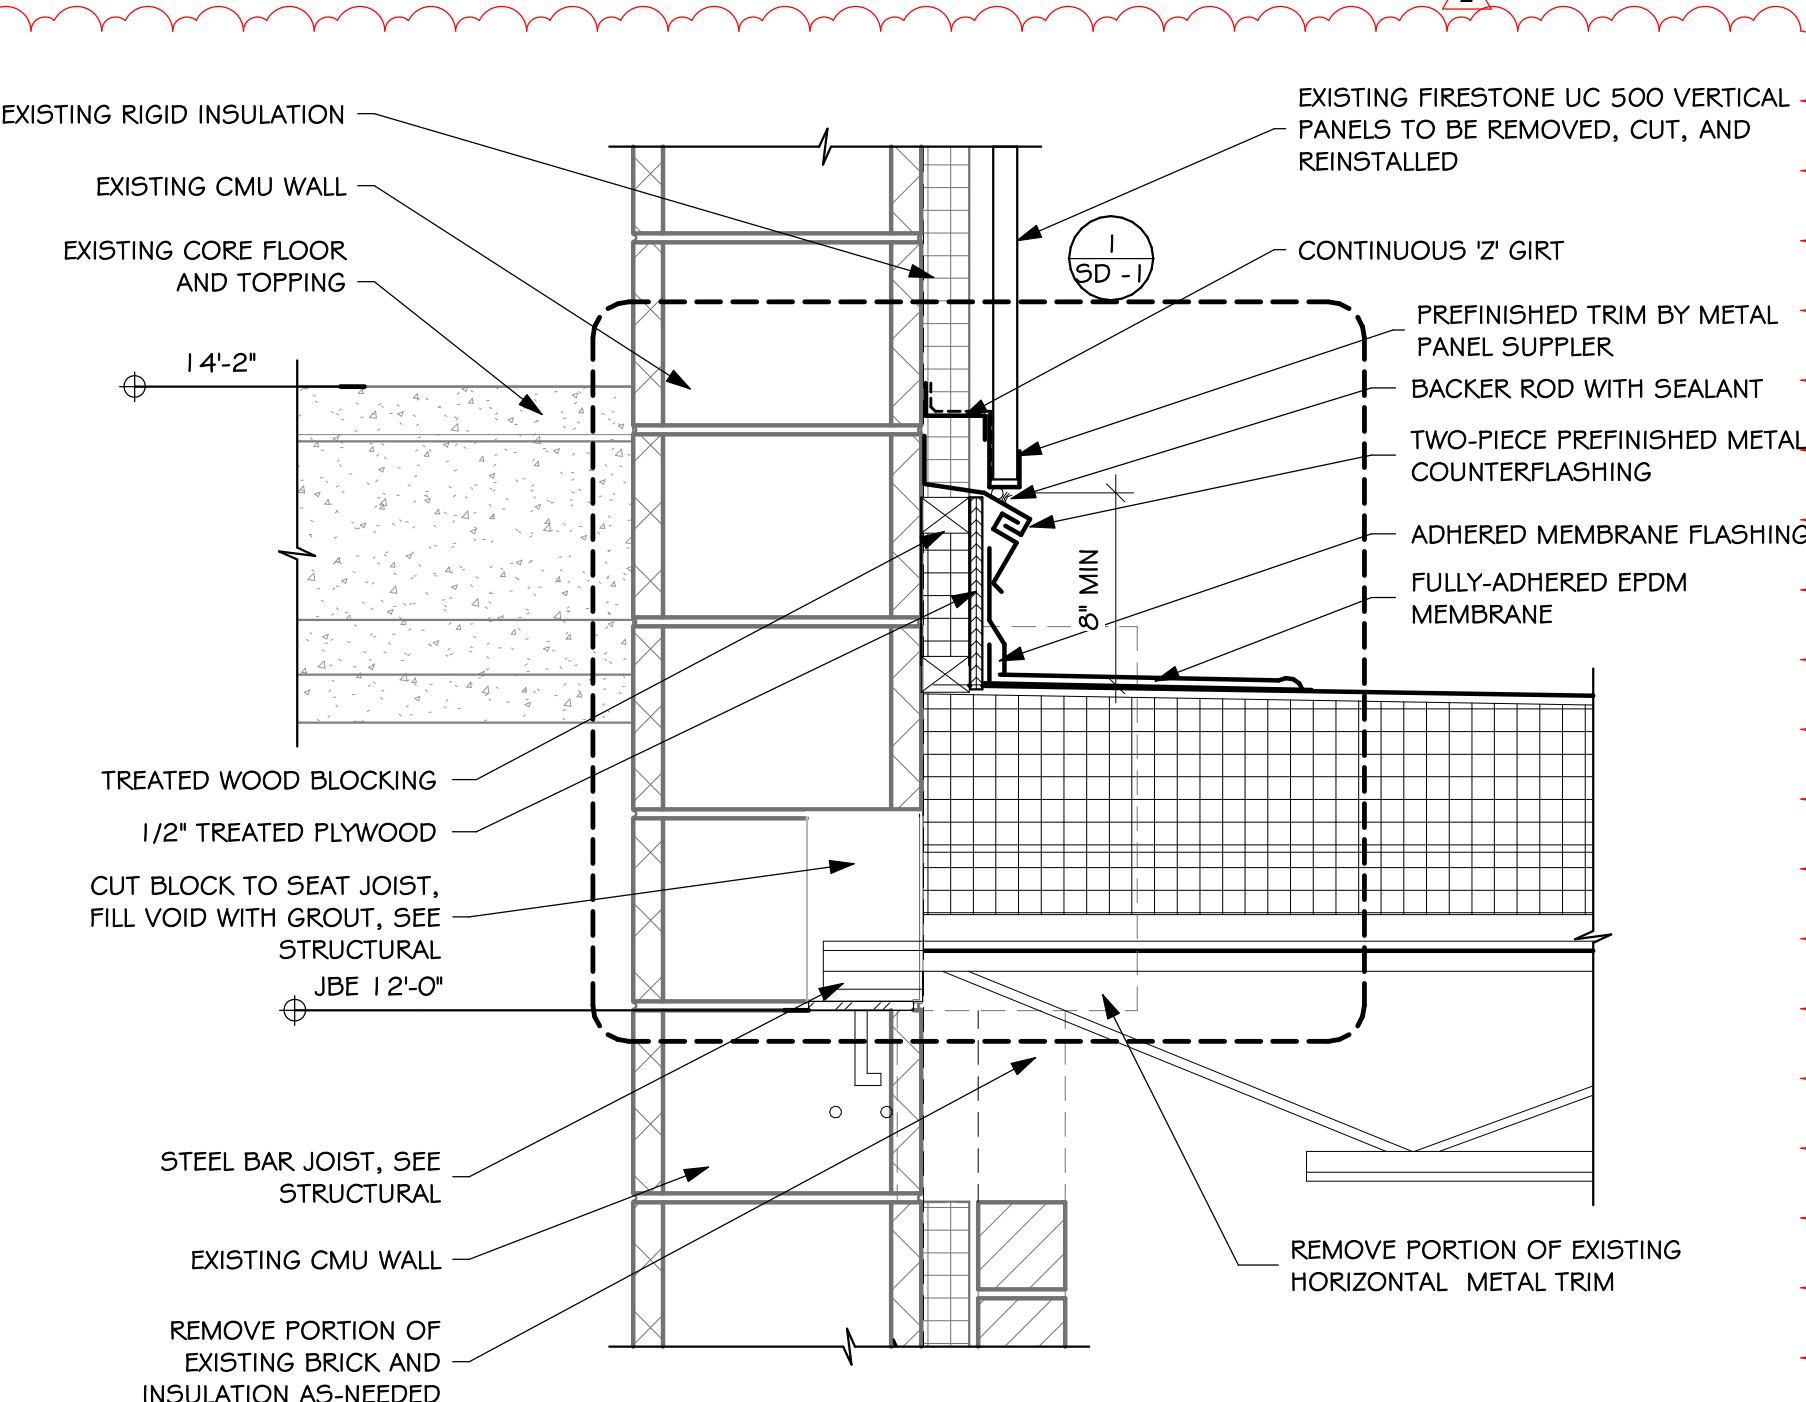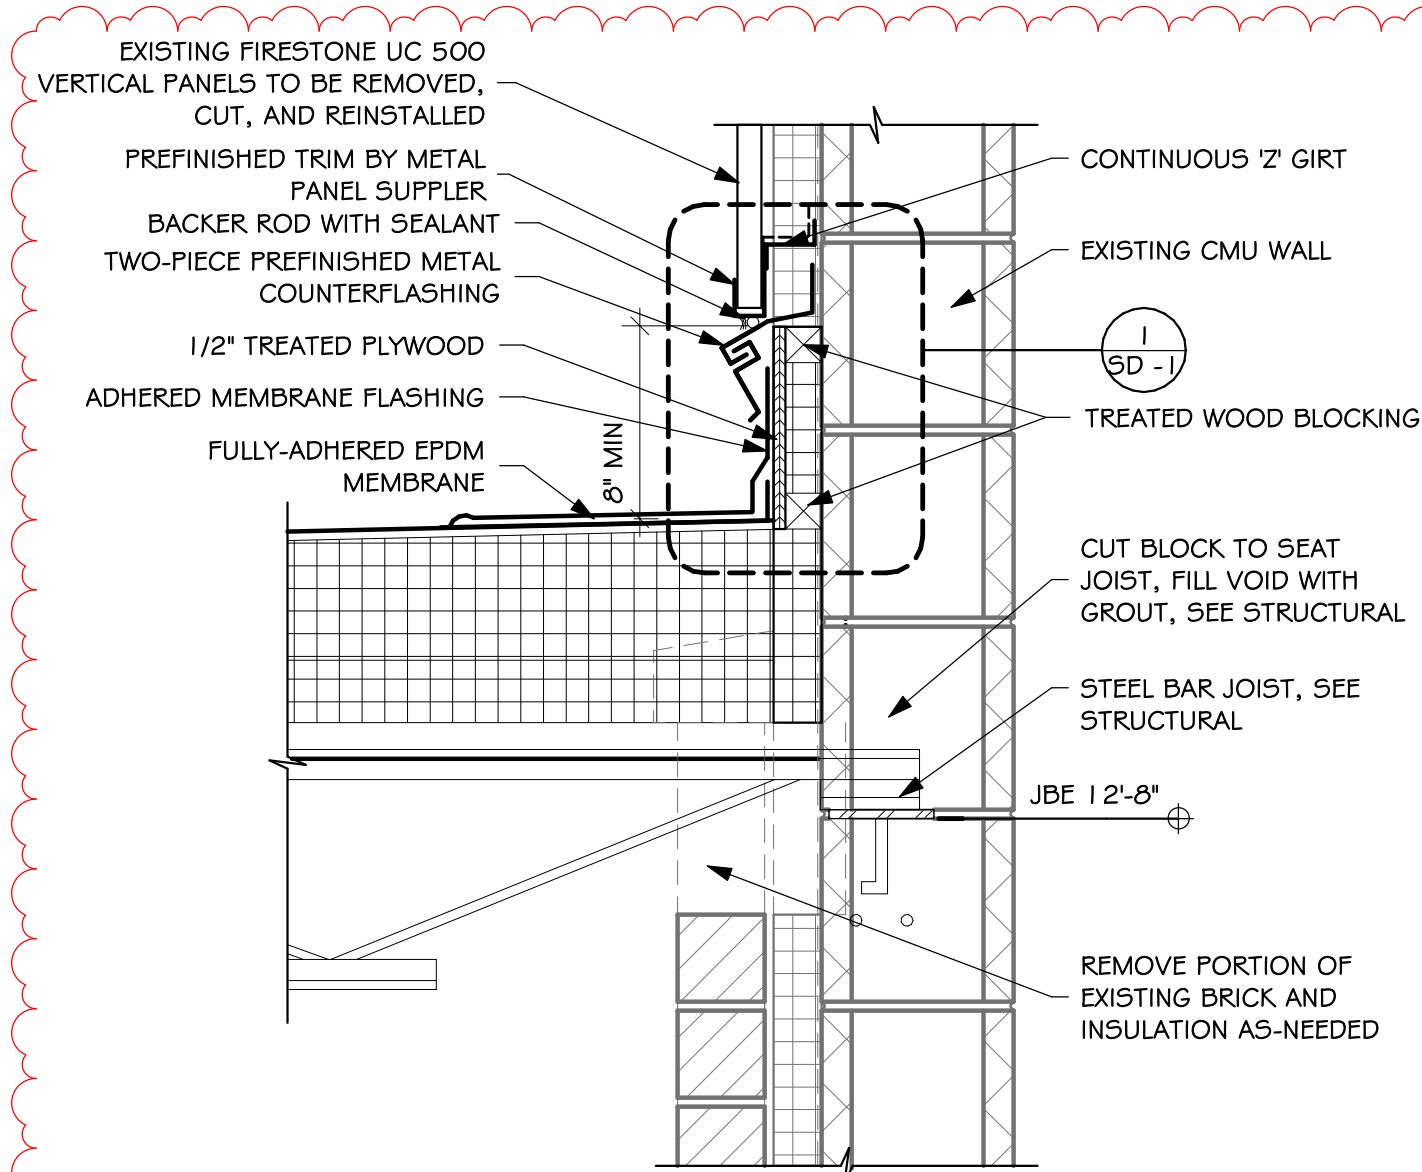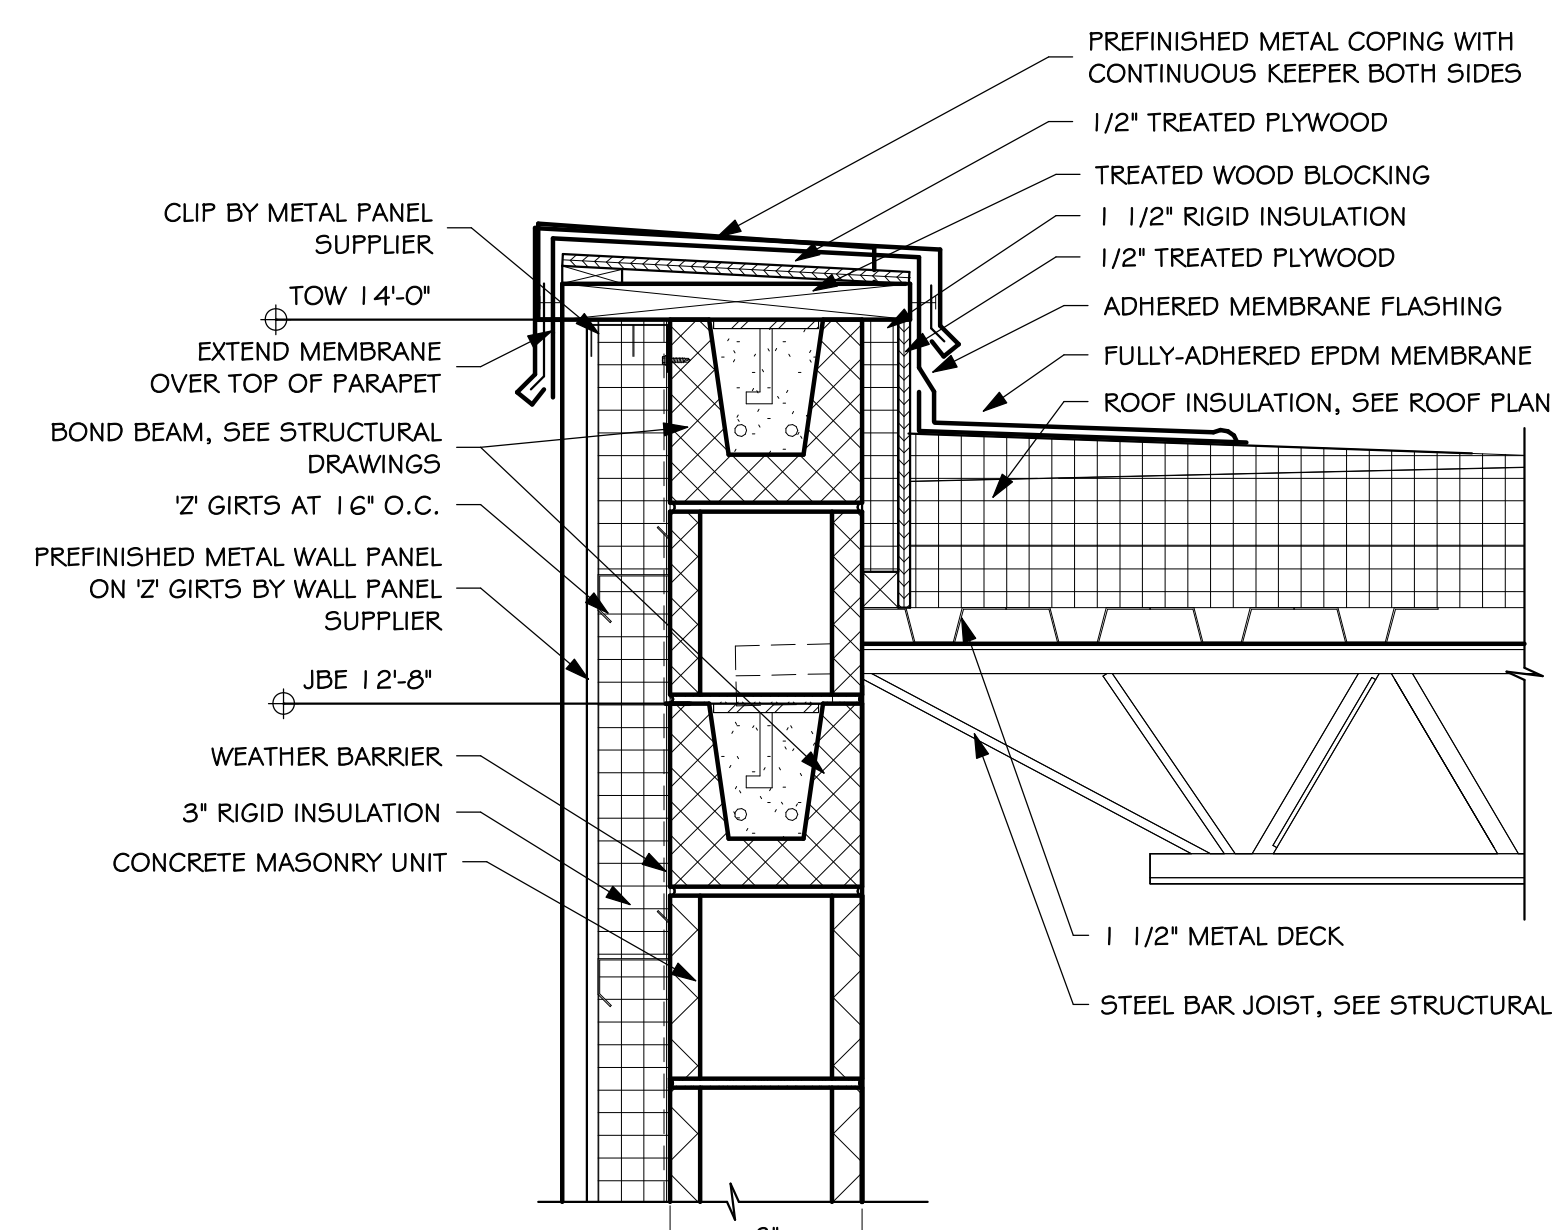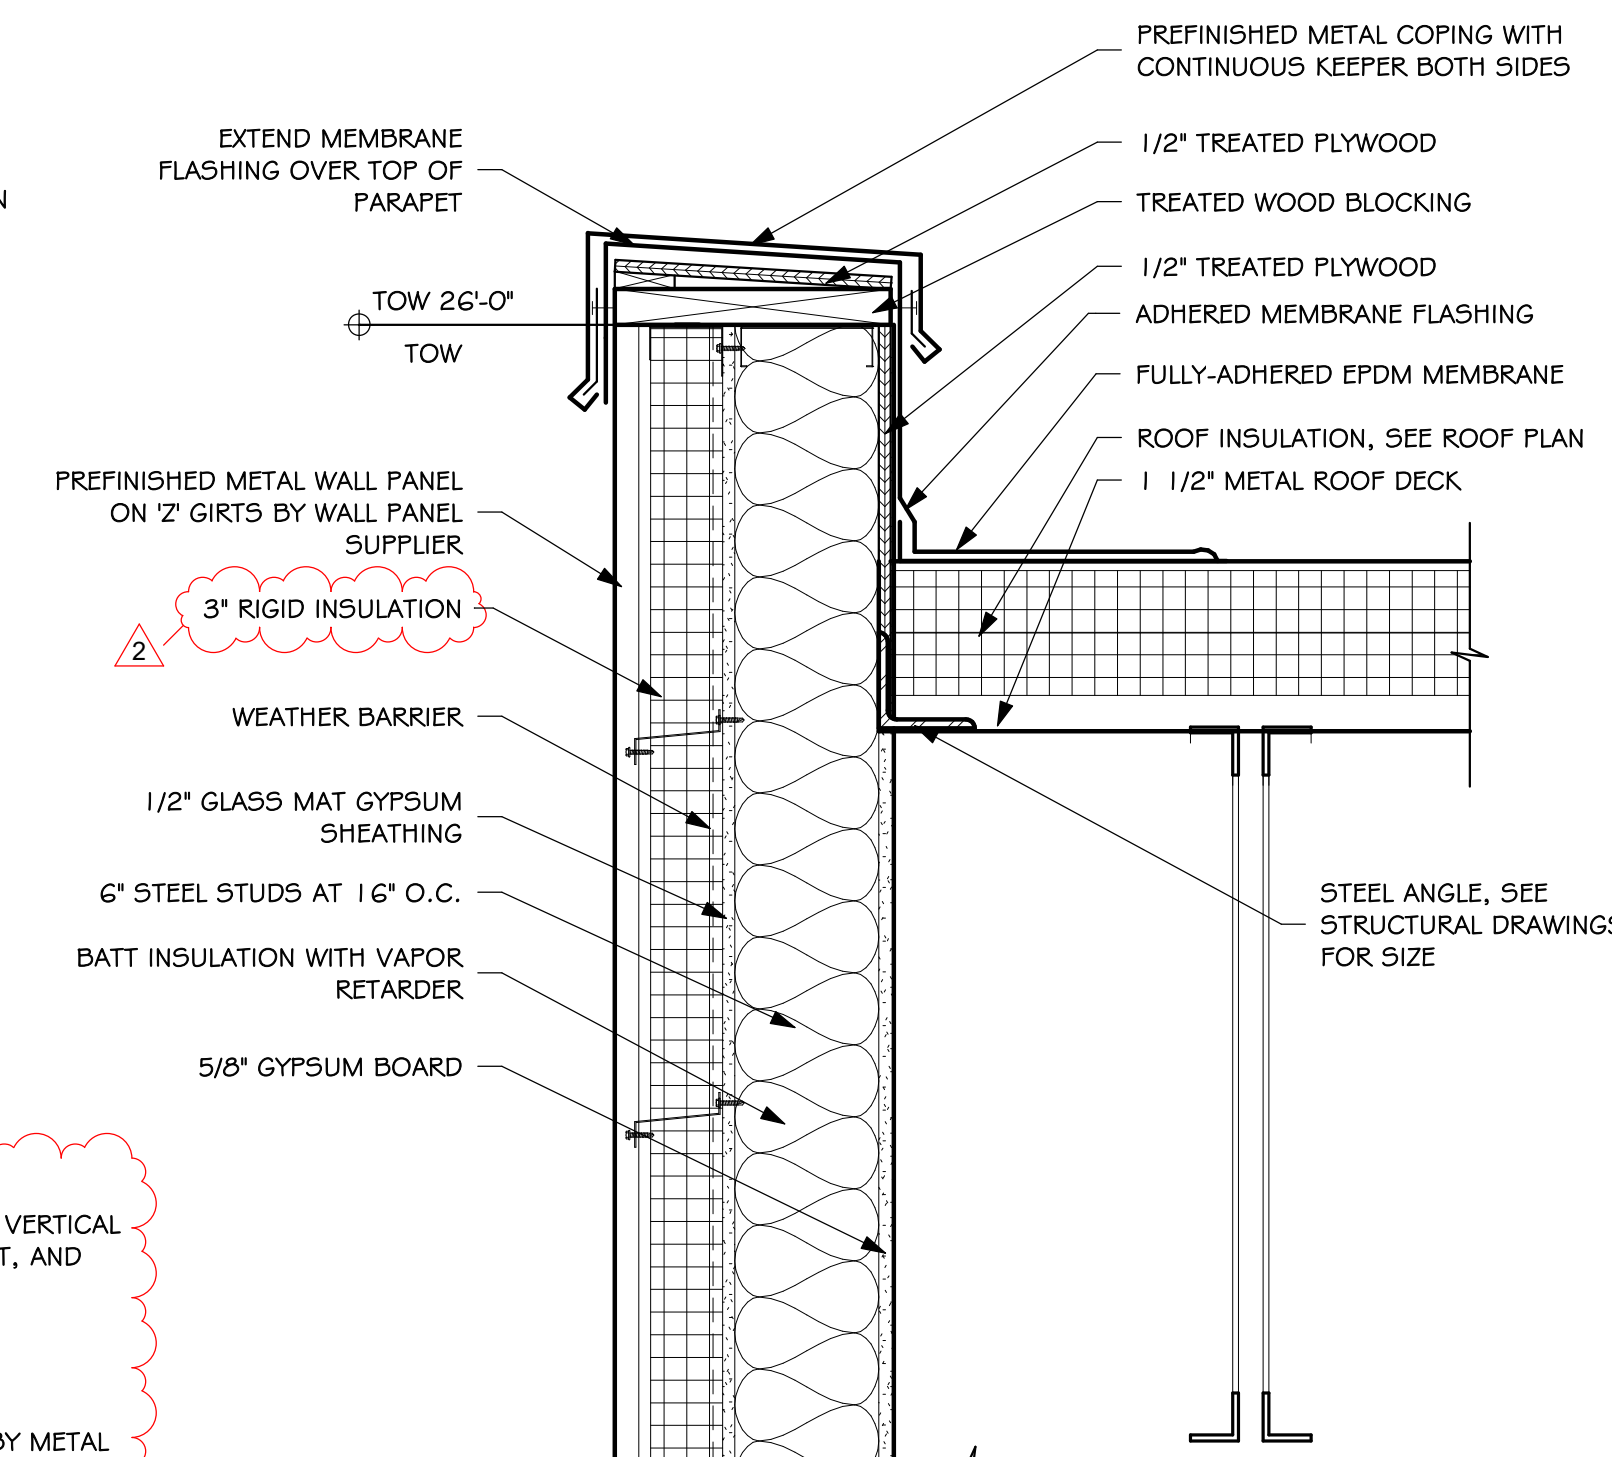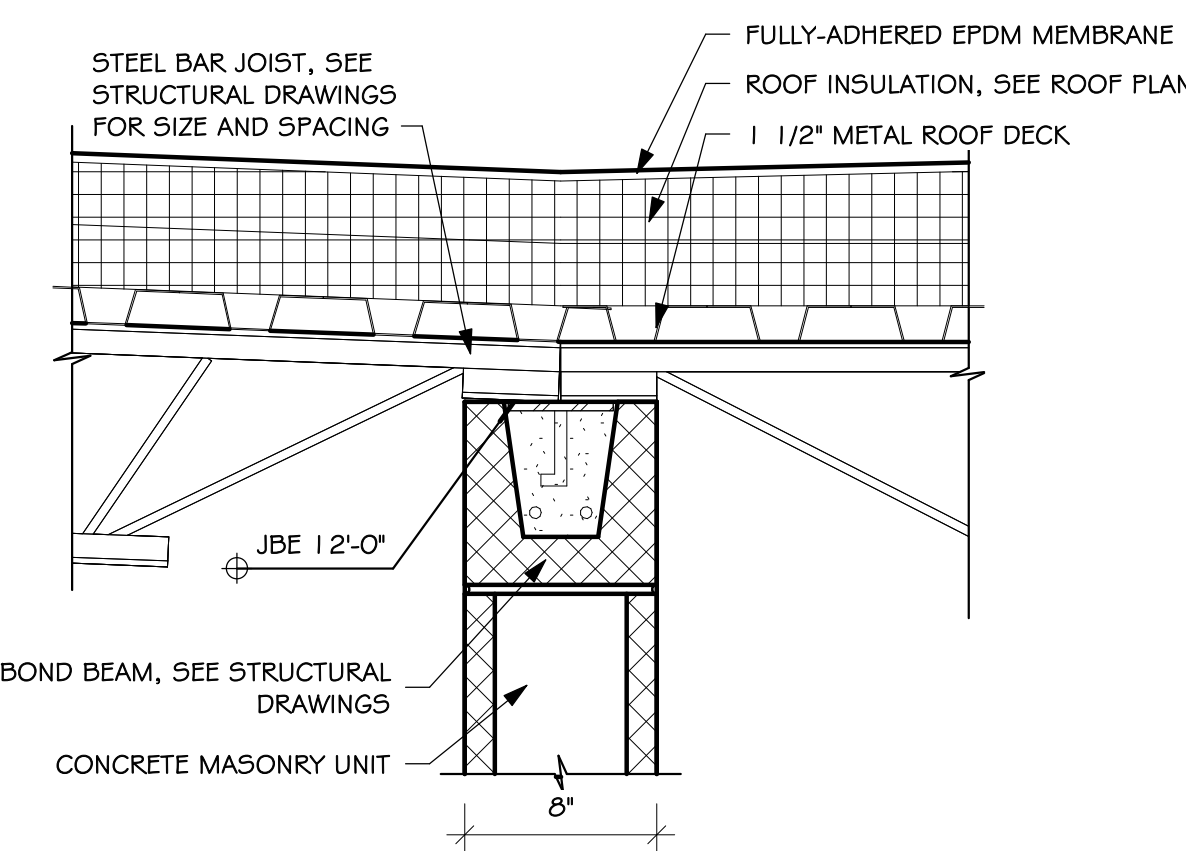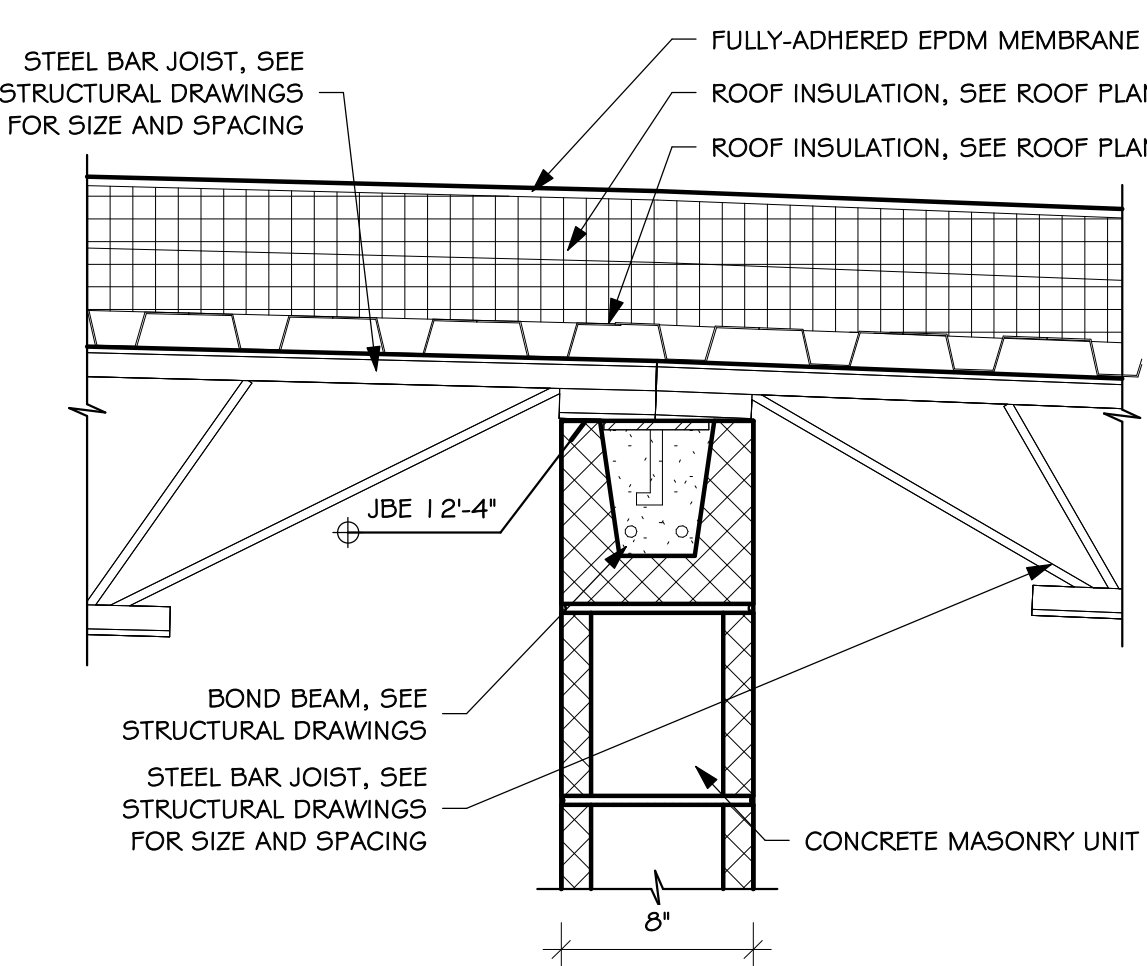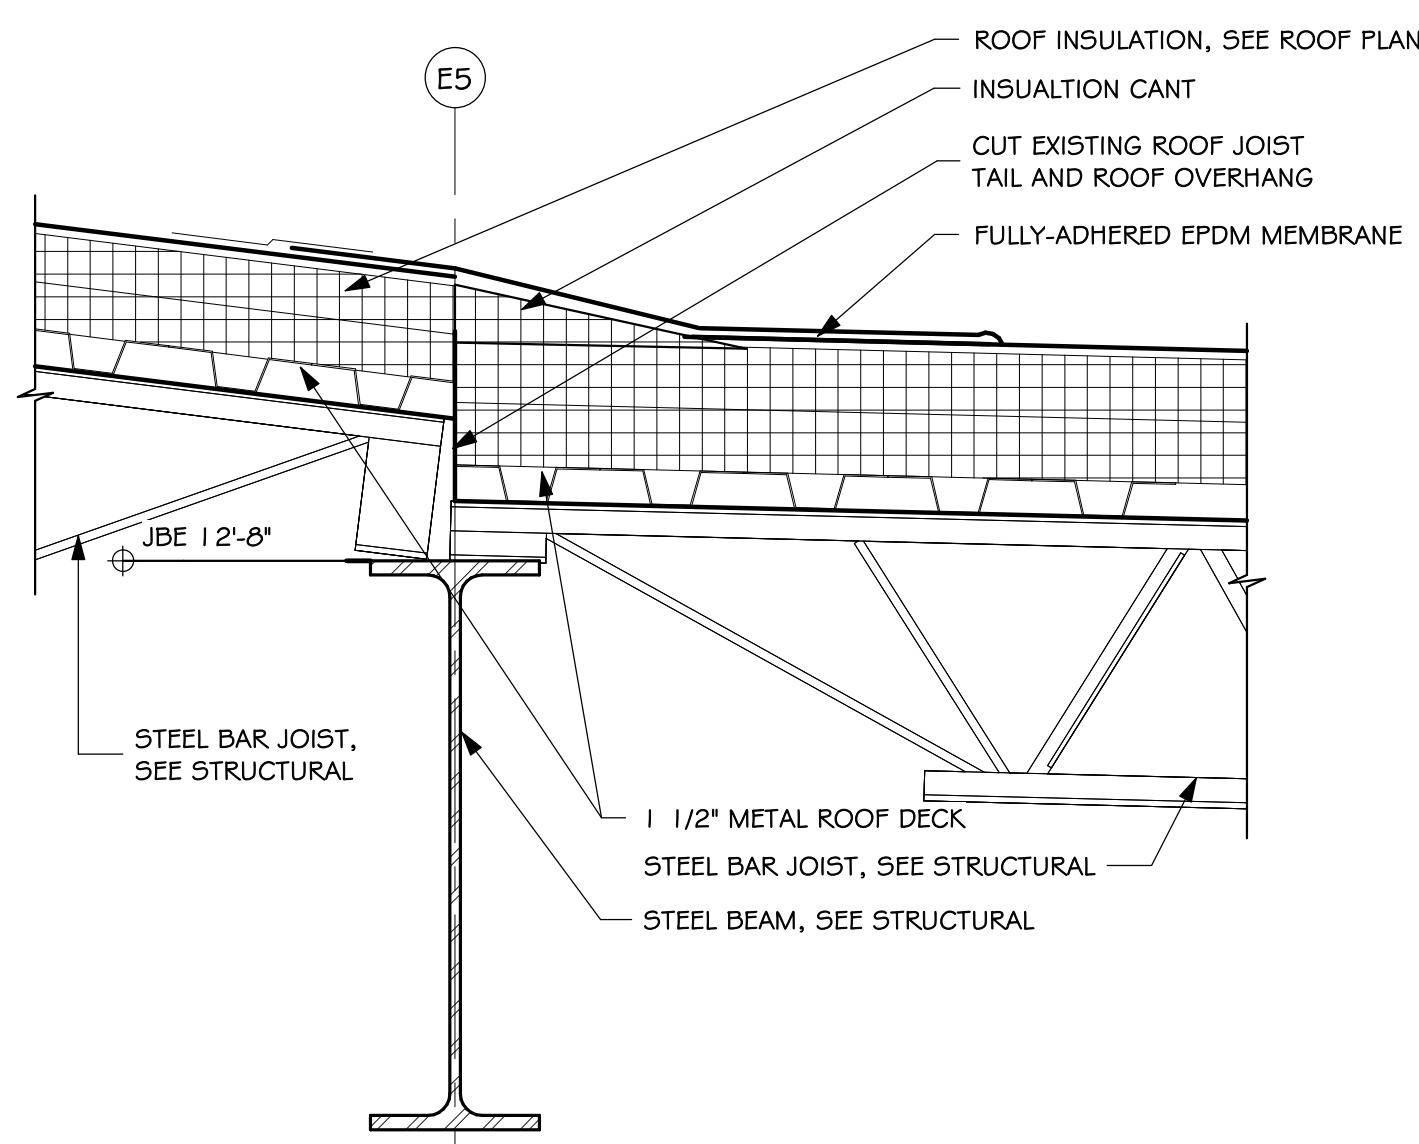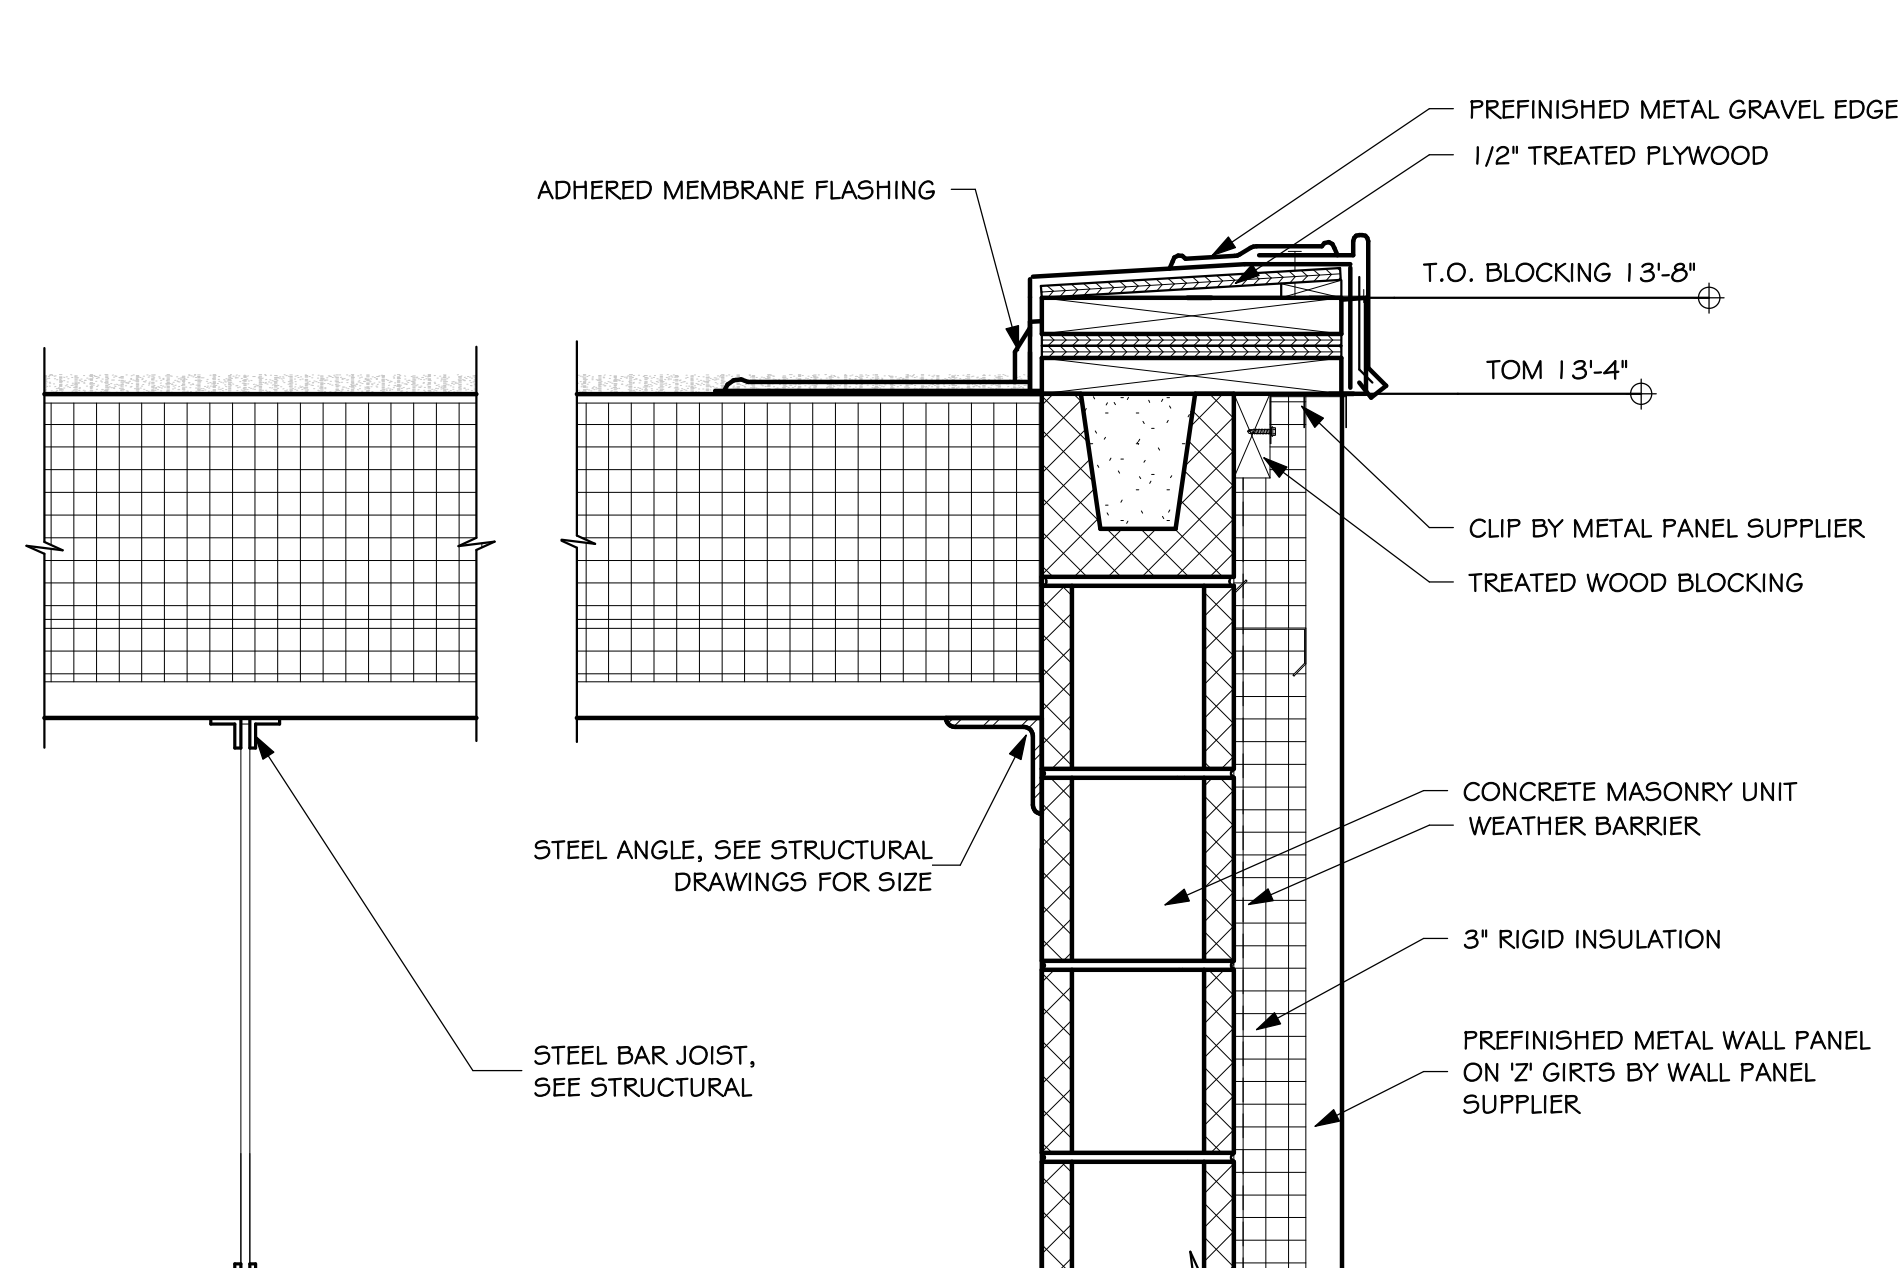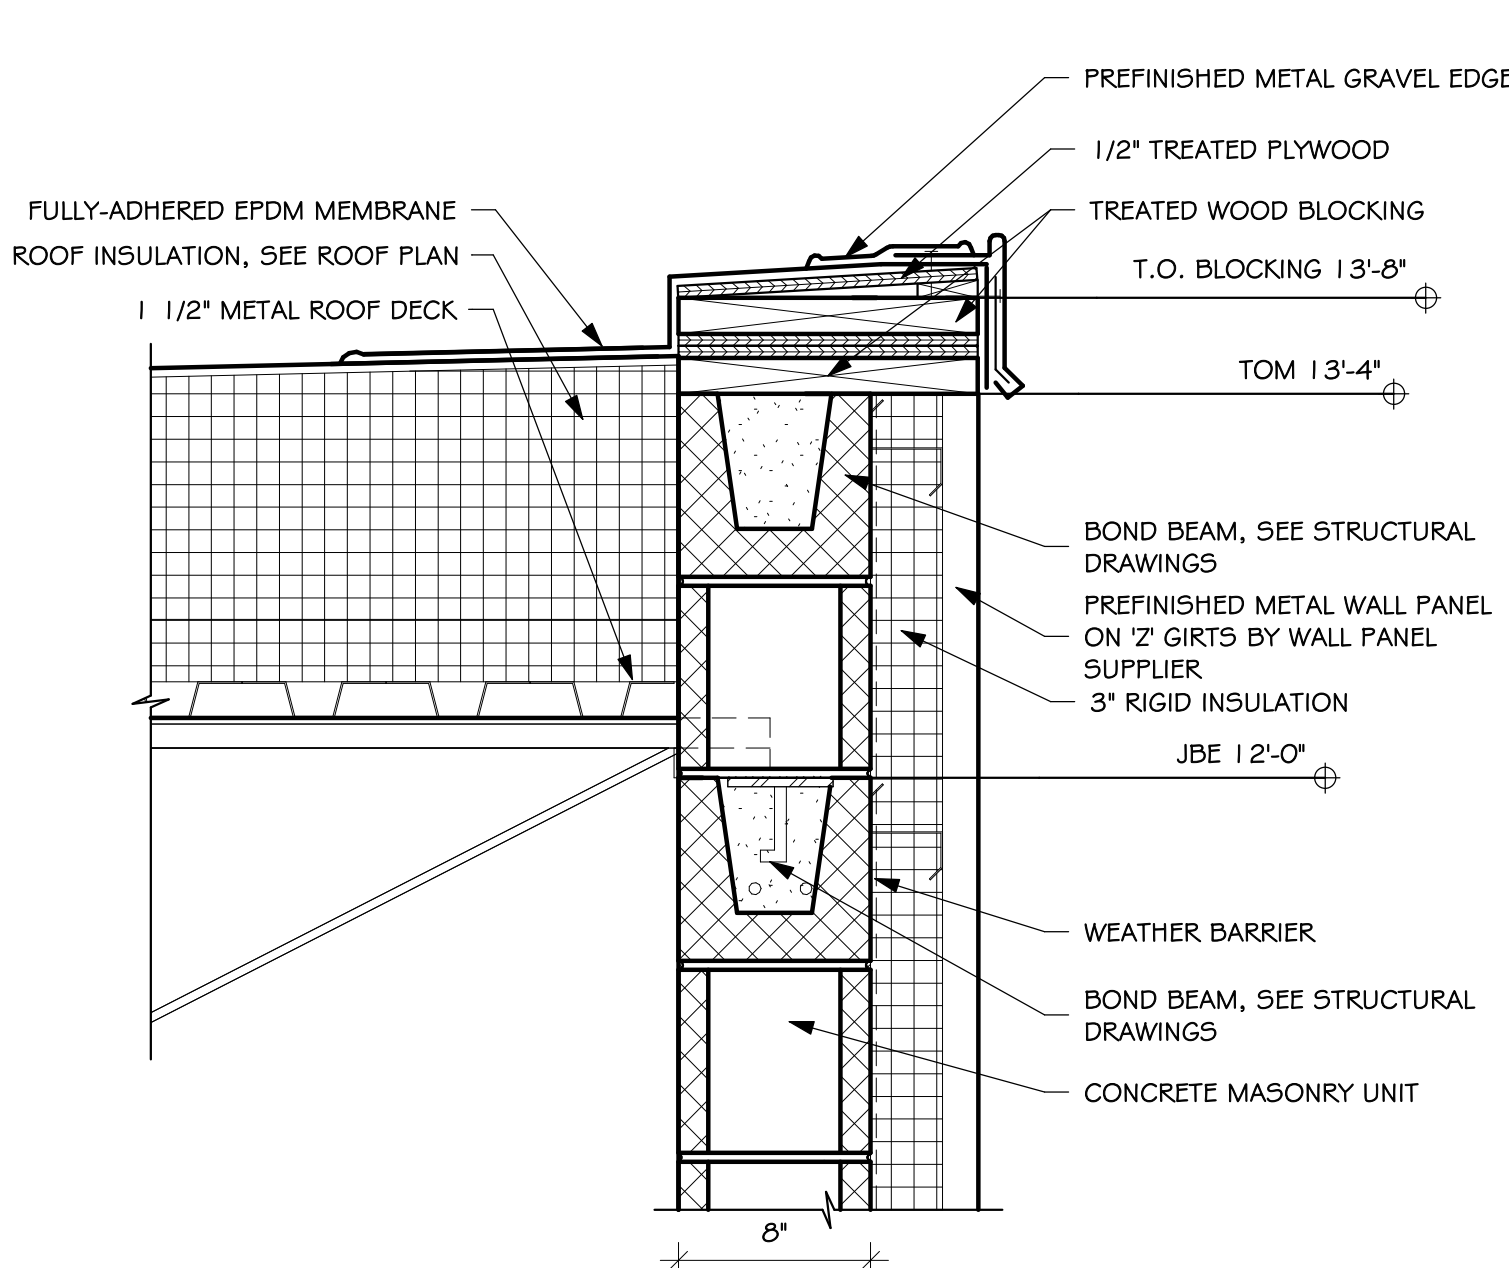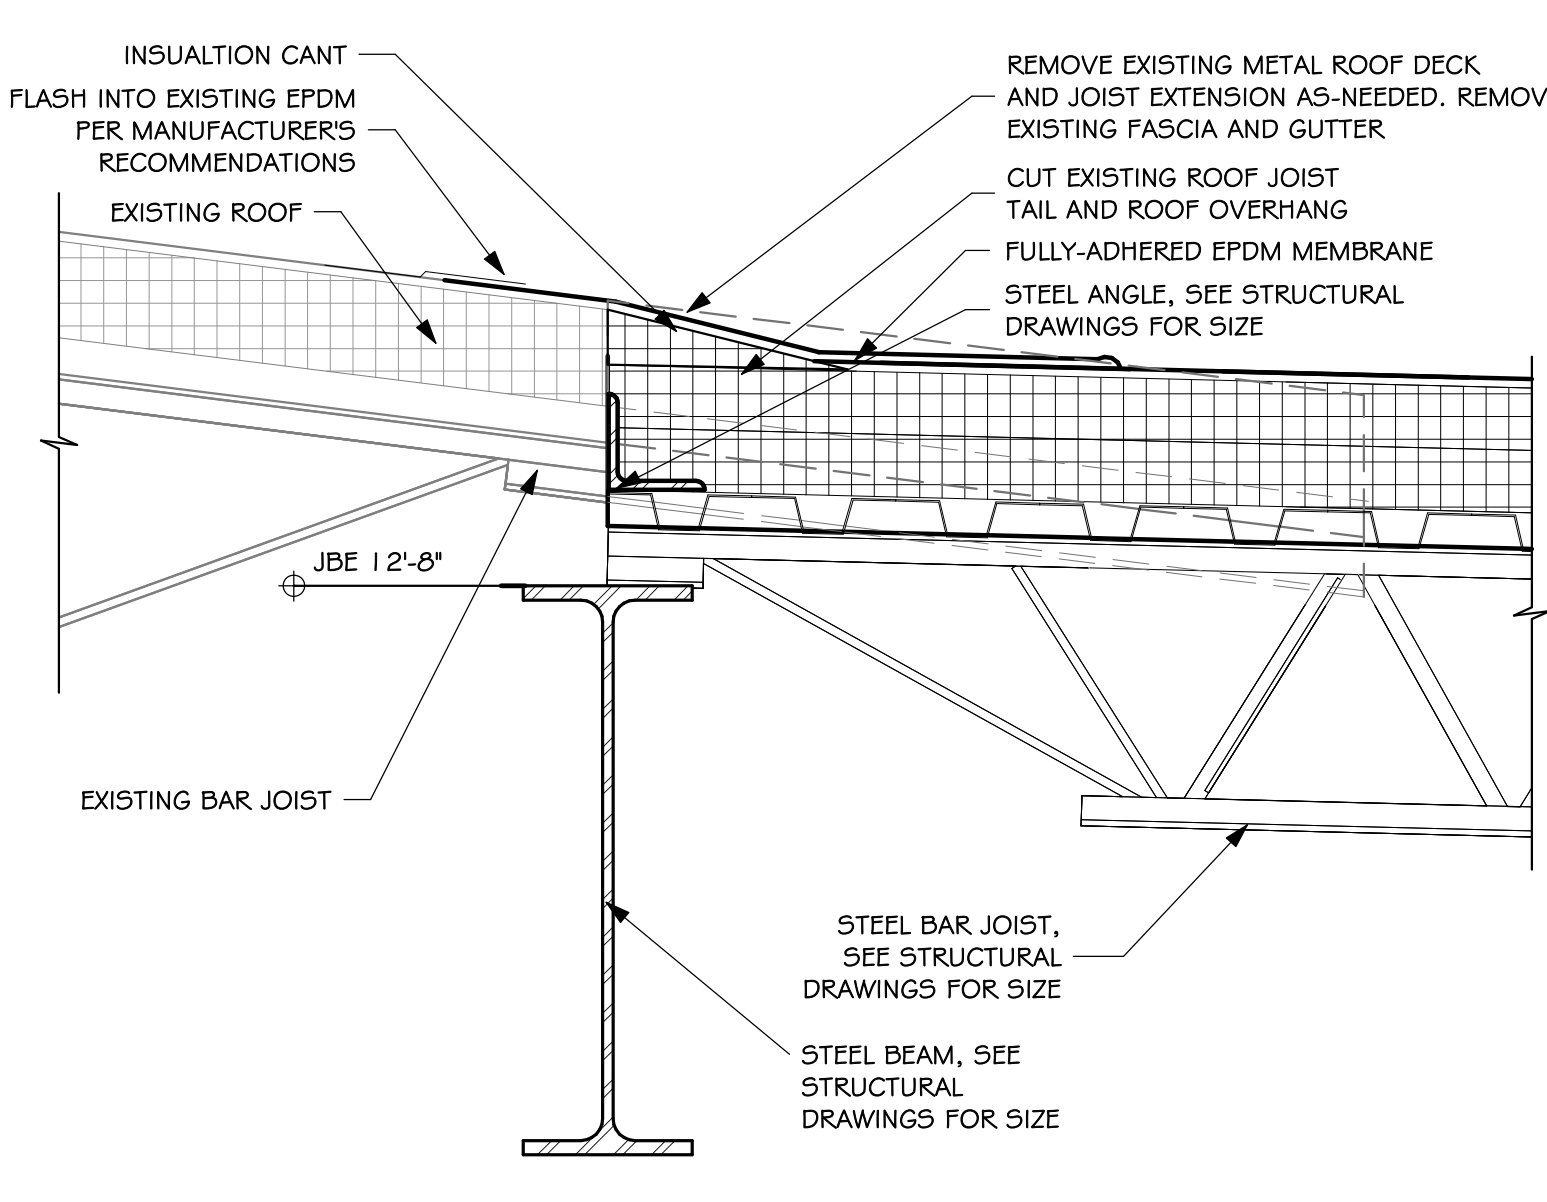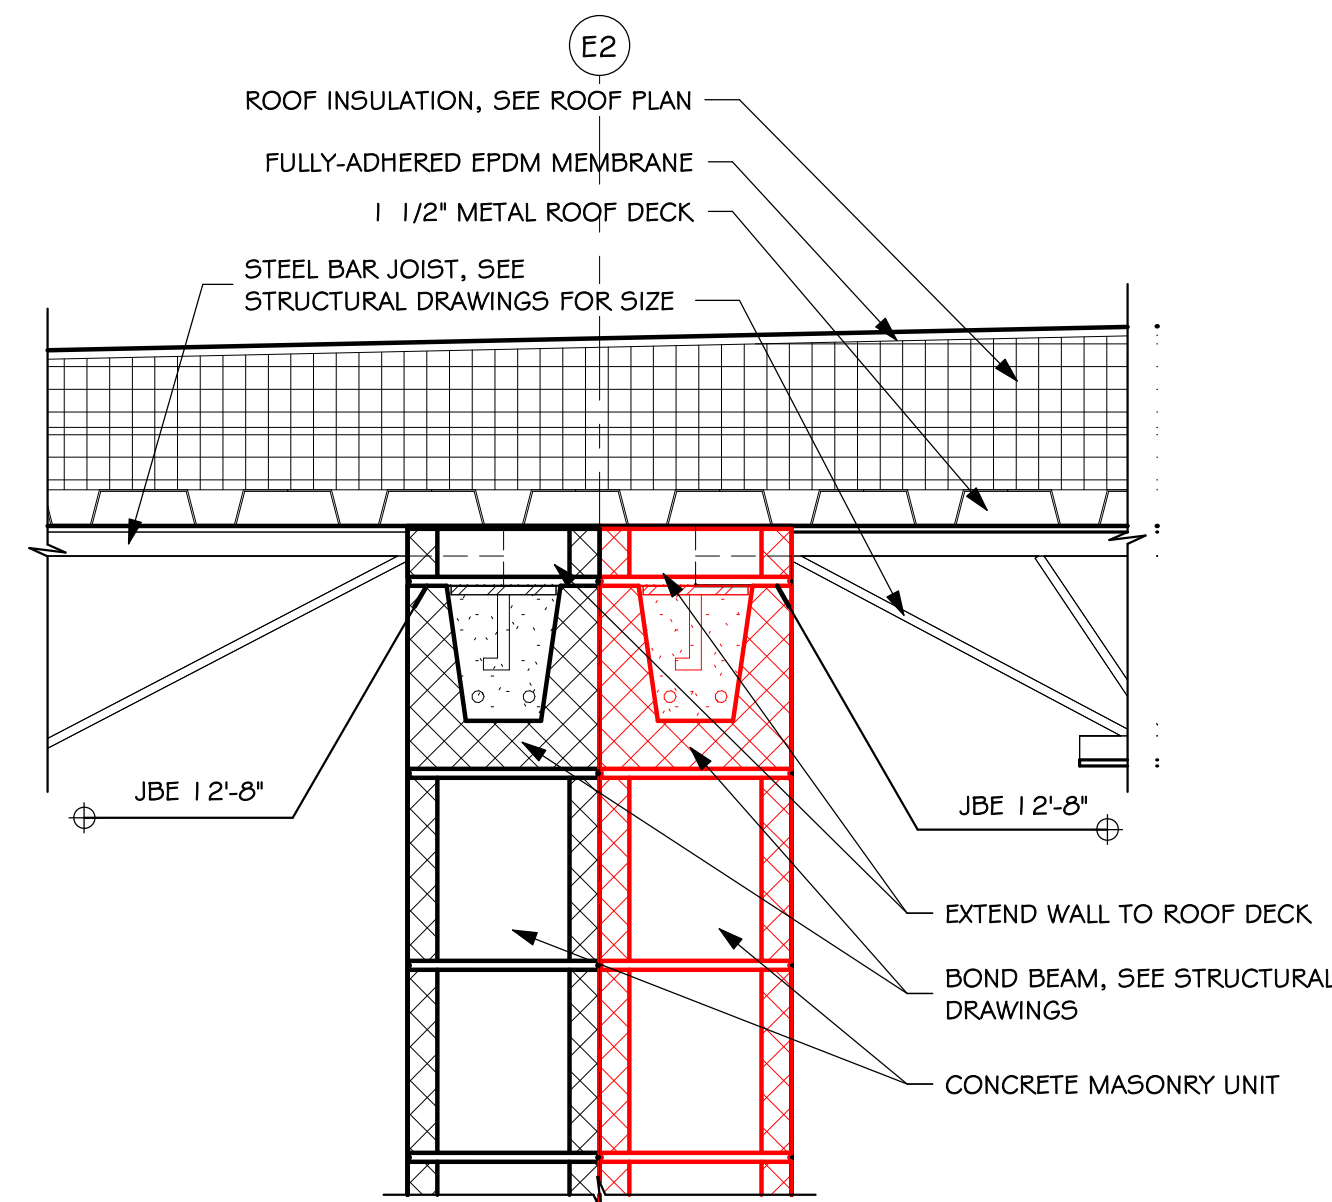

Architecture  
Incorporated

415 South Main Avenue  
P.O. Box 2140  
Sioux Falls, South Dakota 57101  
Phone: (605) 339-1711

815 St Joseph Street, Suite 203  
Rapid City, South Dakota 57701  
Phone: (605) 721-1158



LENNOX HIGH SCHOOL ADDITION


SECTION DETAILS

number	0215.2902.22
date	DECEMBER 21, 2023
revision	
drawn	MS/SWP checked SRJ

DATE	DESCRIPTION
1/11/2024	ADDENDUM #2

5.44




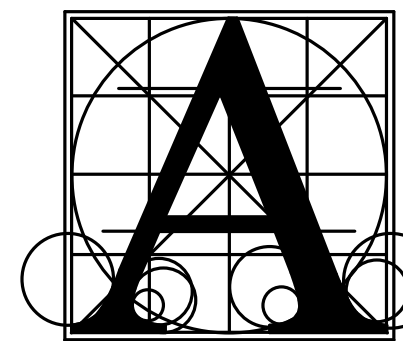

Architecture  
Incorporated

415 South Main Avenue  
P.O. Box 2140  
Sioux Falls, South Dakota 57101  
Phone: (605) 339-1711

815 St. Joseph Street, Suite 203  
Rapid City, South Dakota 57701  
Phone: (605) 721-1158

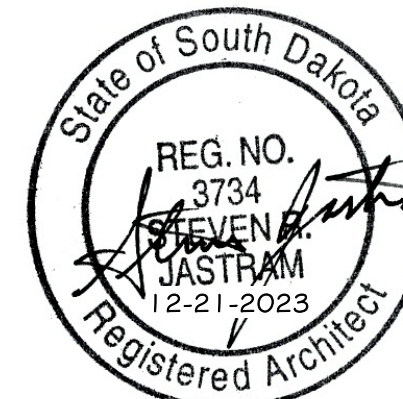

LENNOX HIGH SCHOOL ADDITION


SECTION DETAILS

Project


number 0215.2902.22  
date DECEMBER 21, 2023  
revision  
drawn MS checked SRJ

DATE DESCRIPTION  
1/18/2024 ADDENDUM #2


5.45

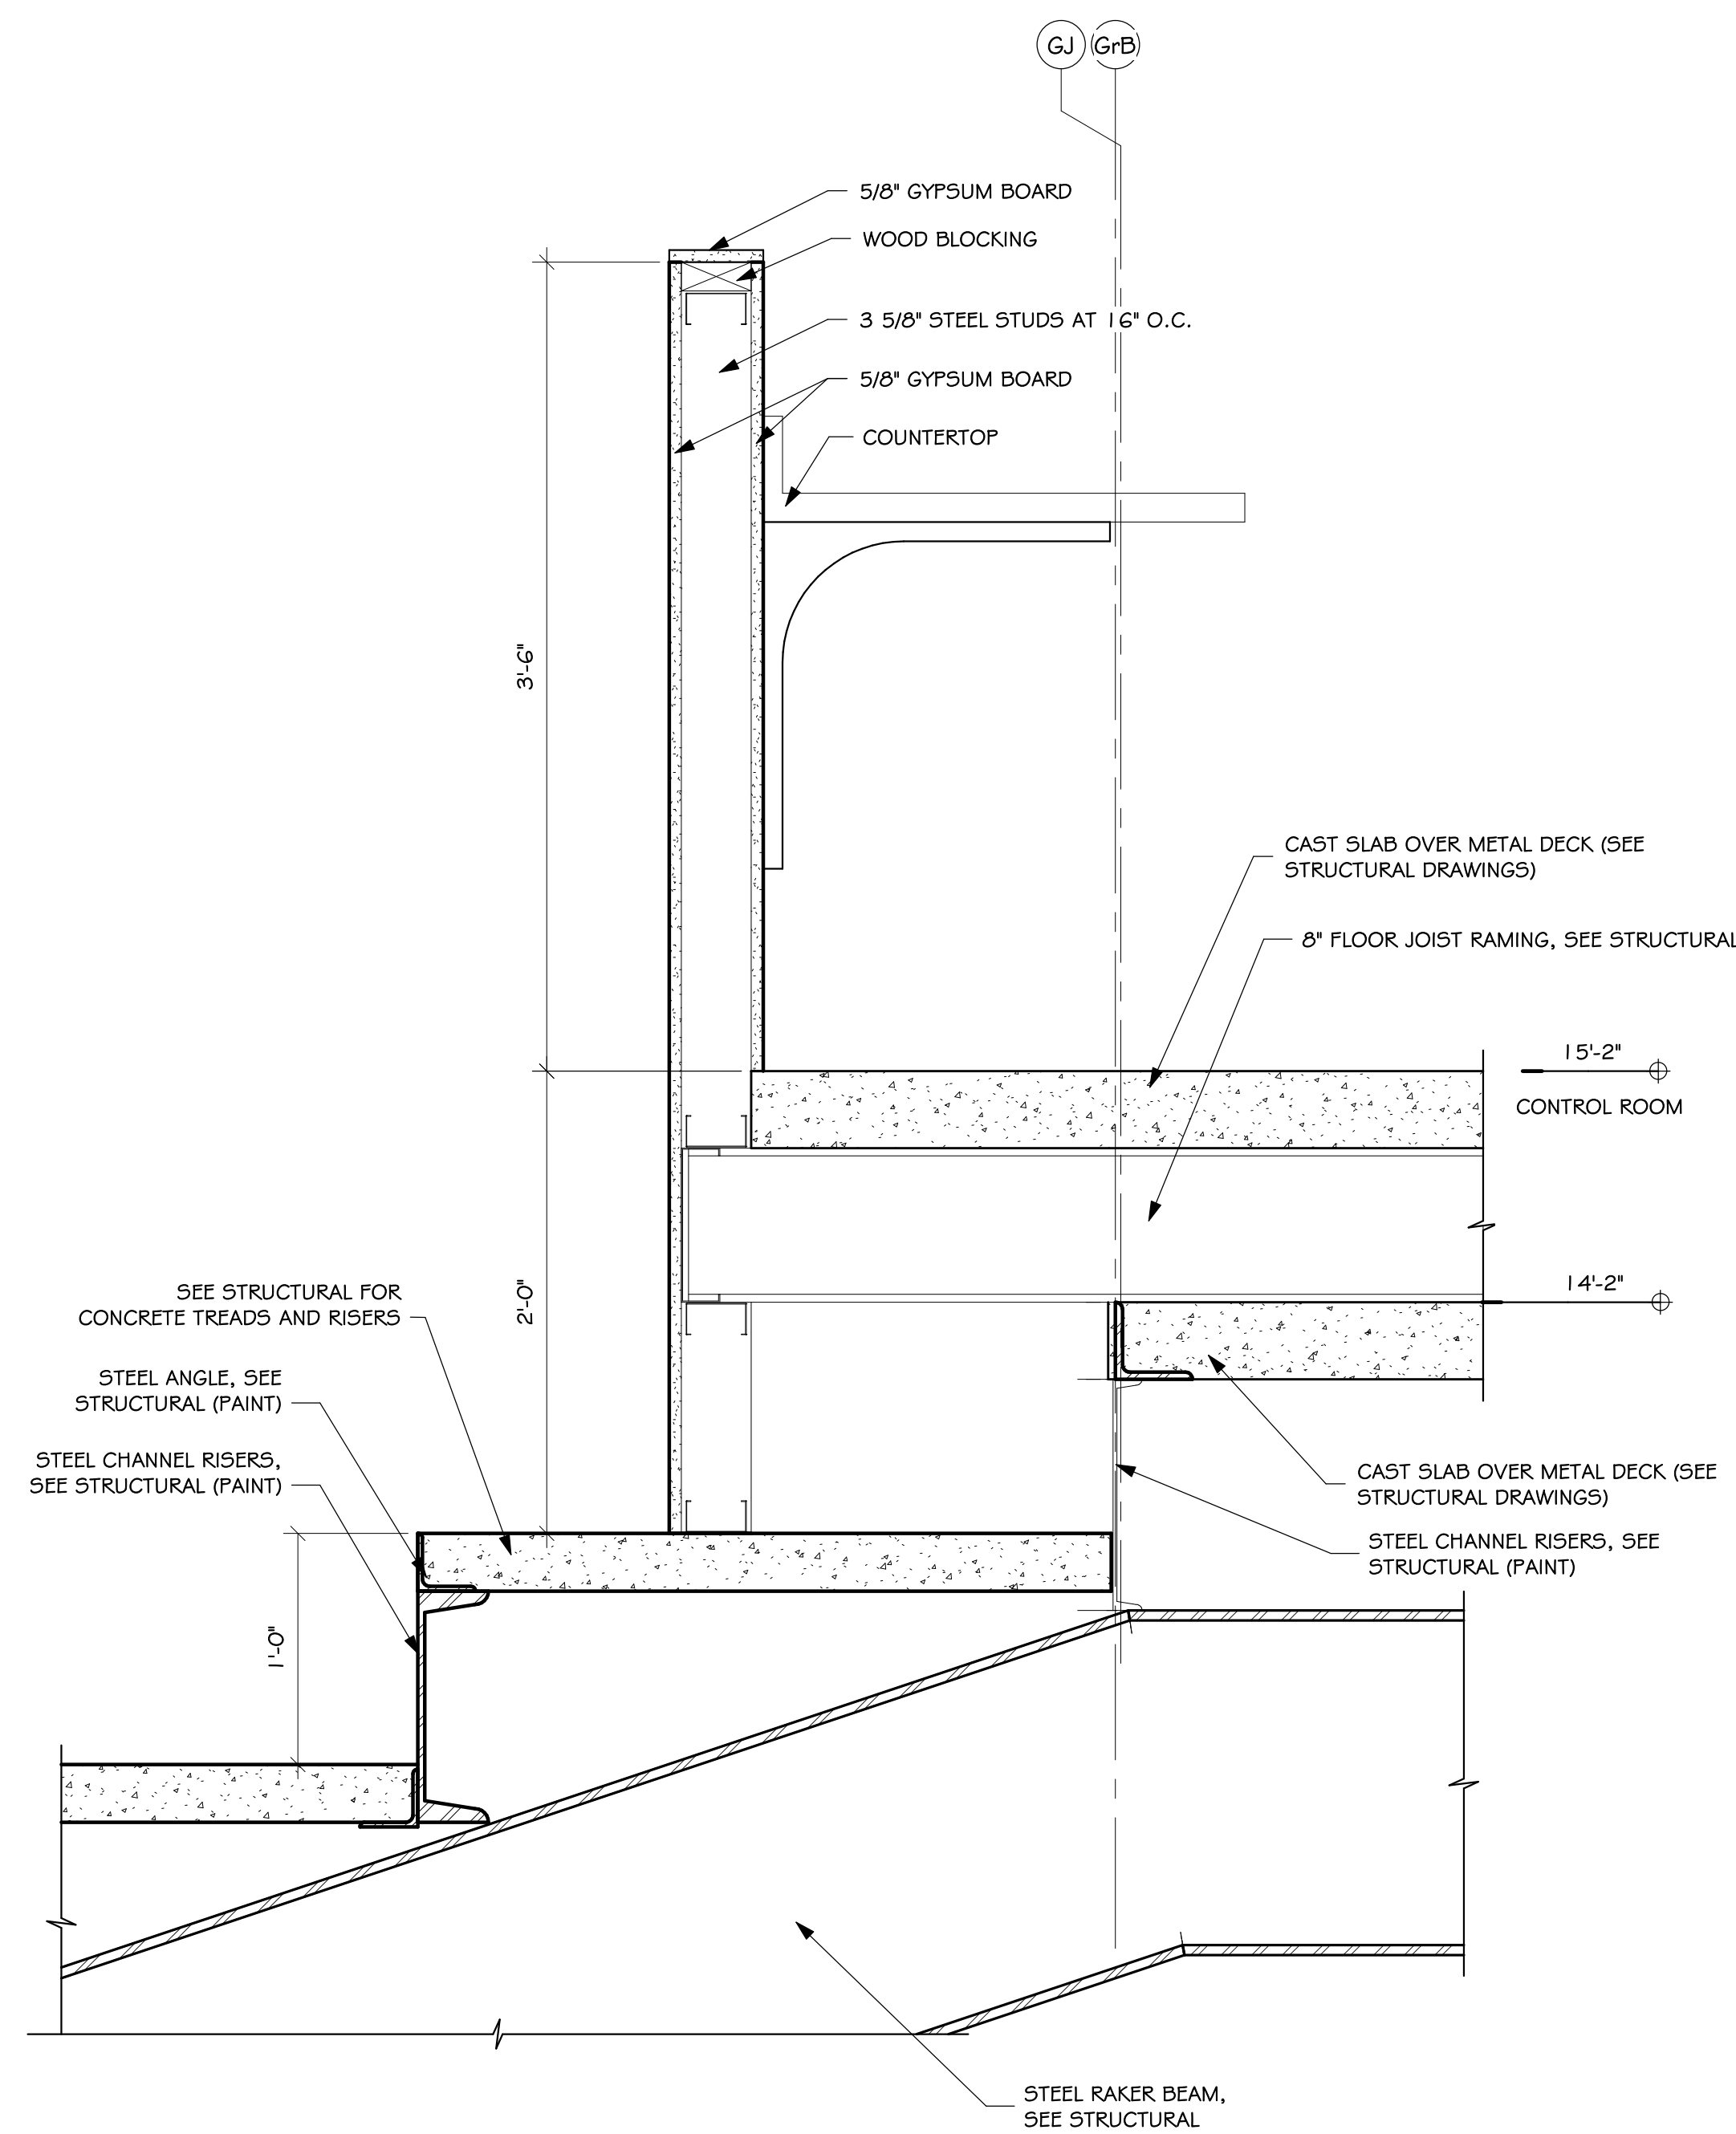


1 AREA G - CONTROL ROOM WALL DETAIL  
SCALE: 1 1/2" = 1'-0"

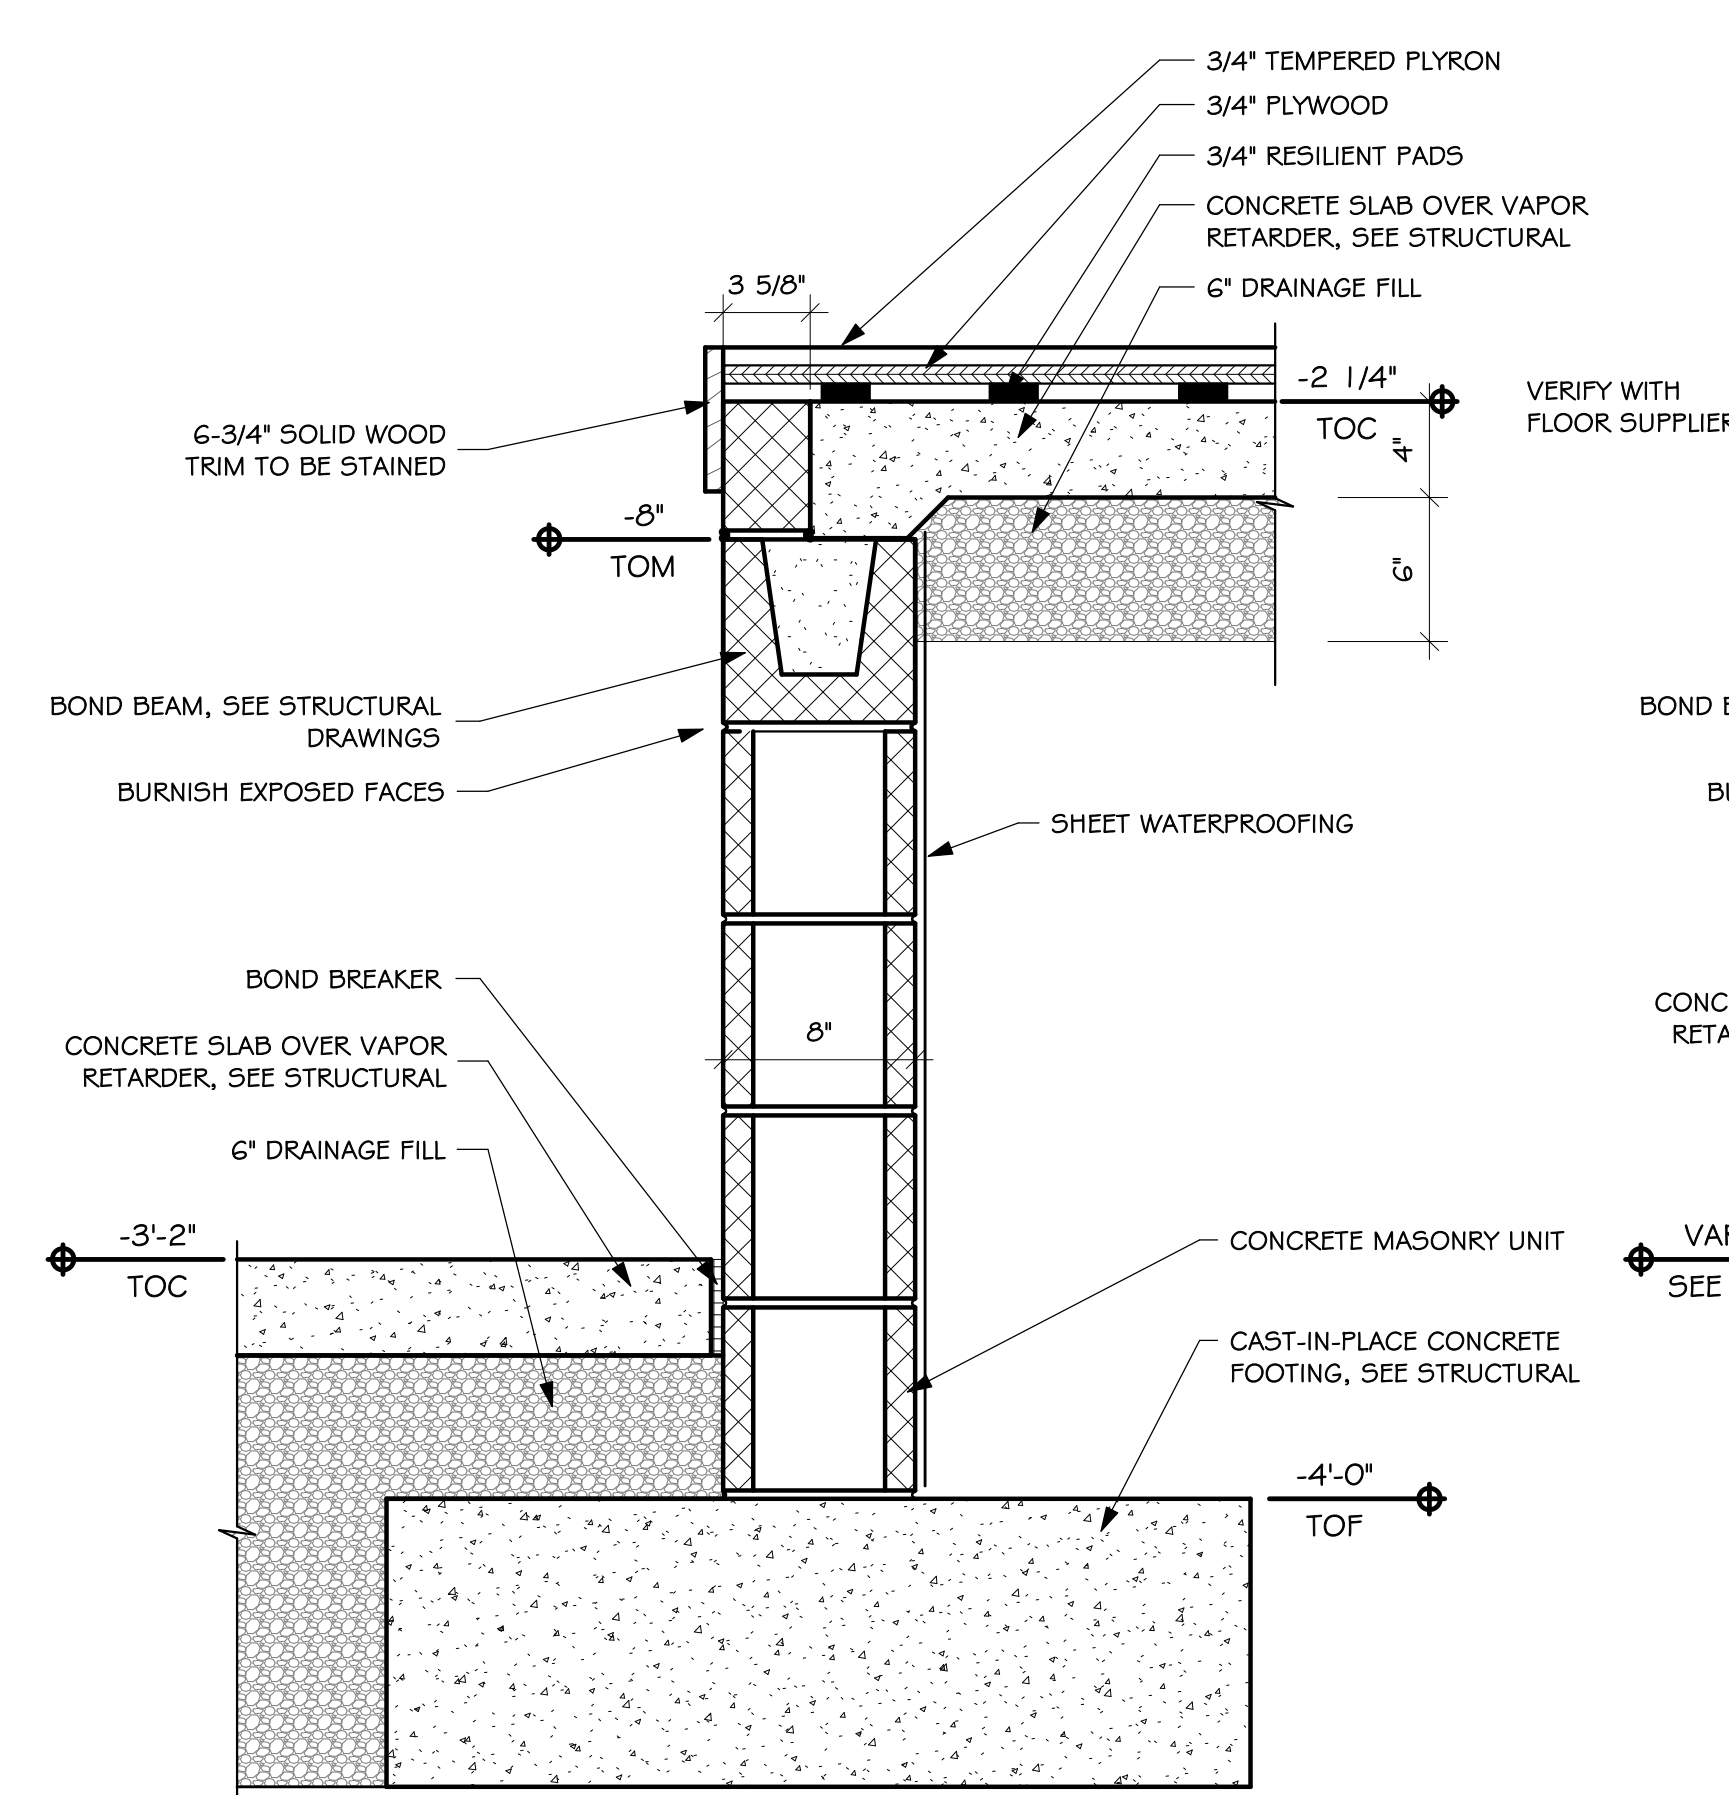


2 AREA G - FRONT STAGE DETAIL  
SCALE: 1 1/2" = 1'-0"

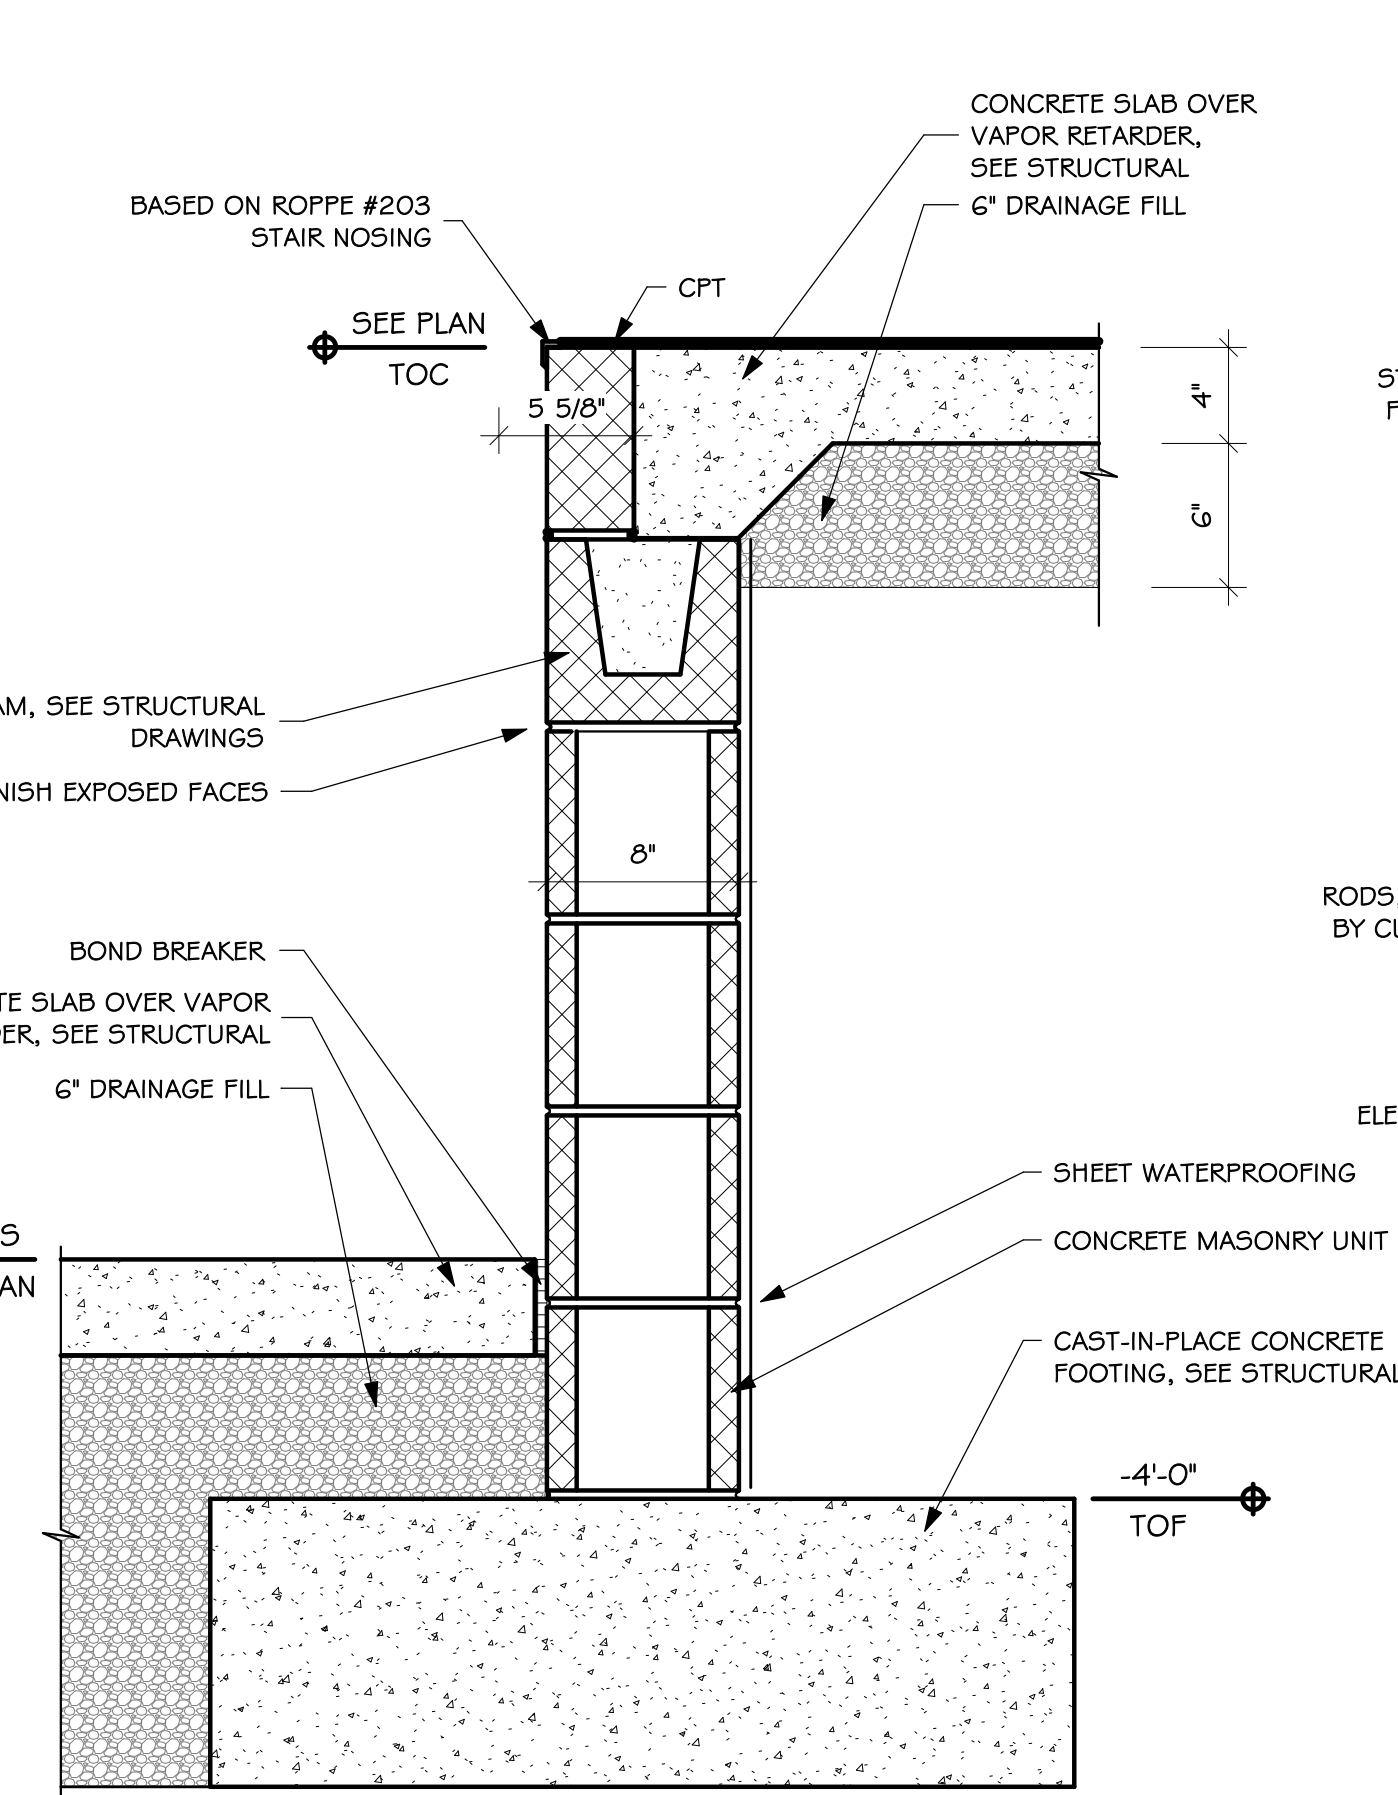


3 ARE G - SIDE STAGE DETAIL  
SCALE: 1 1/2" = 1'-0"

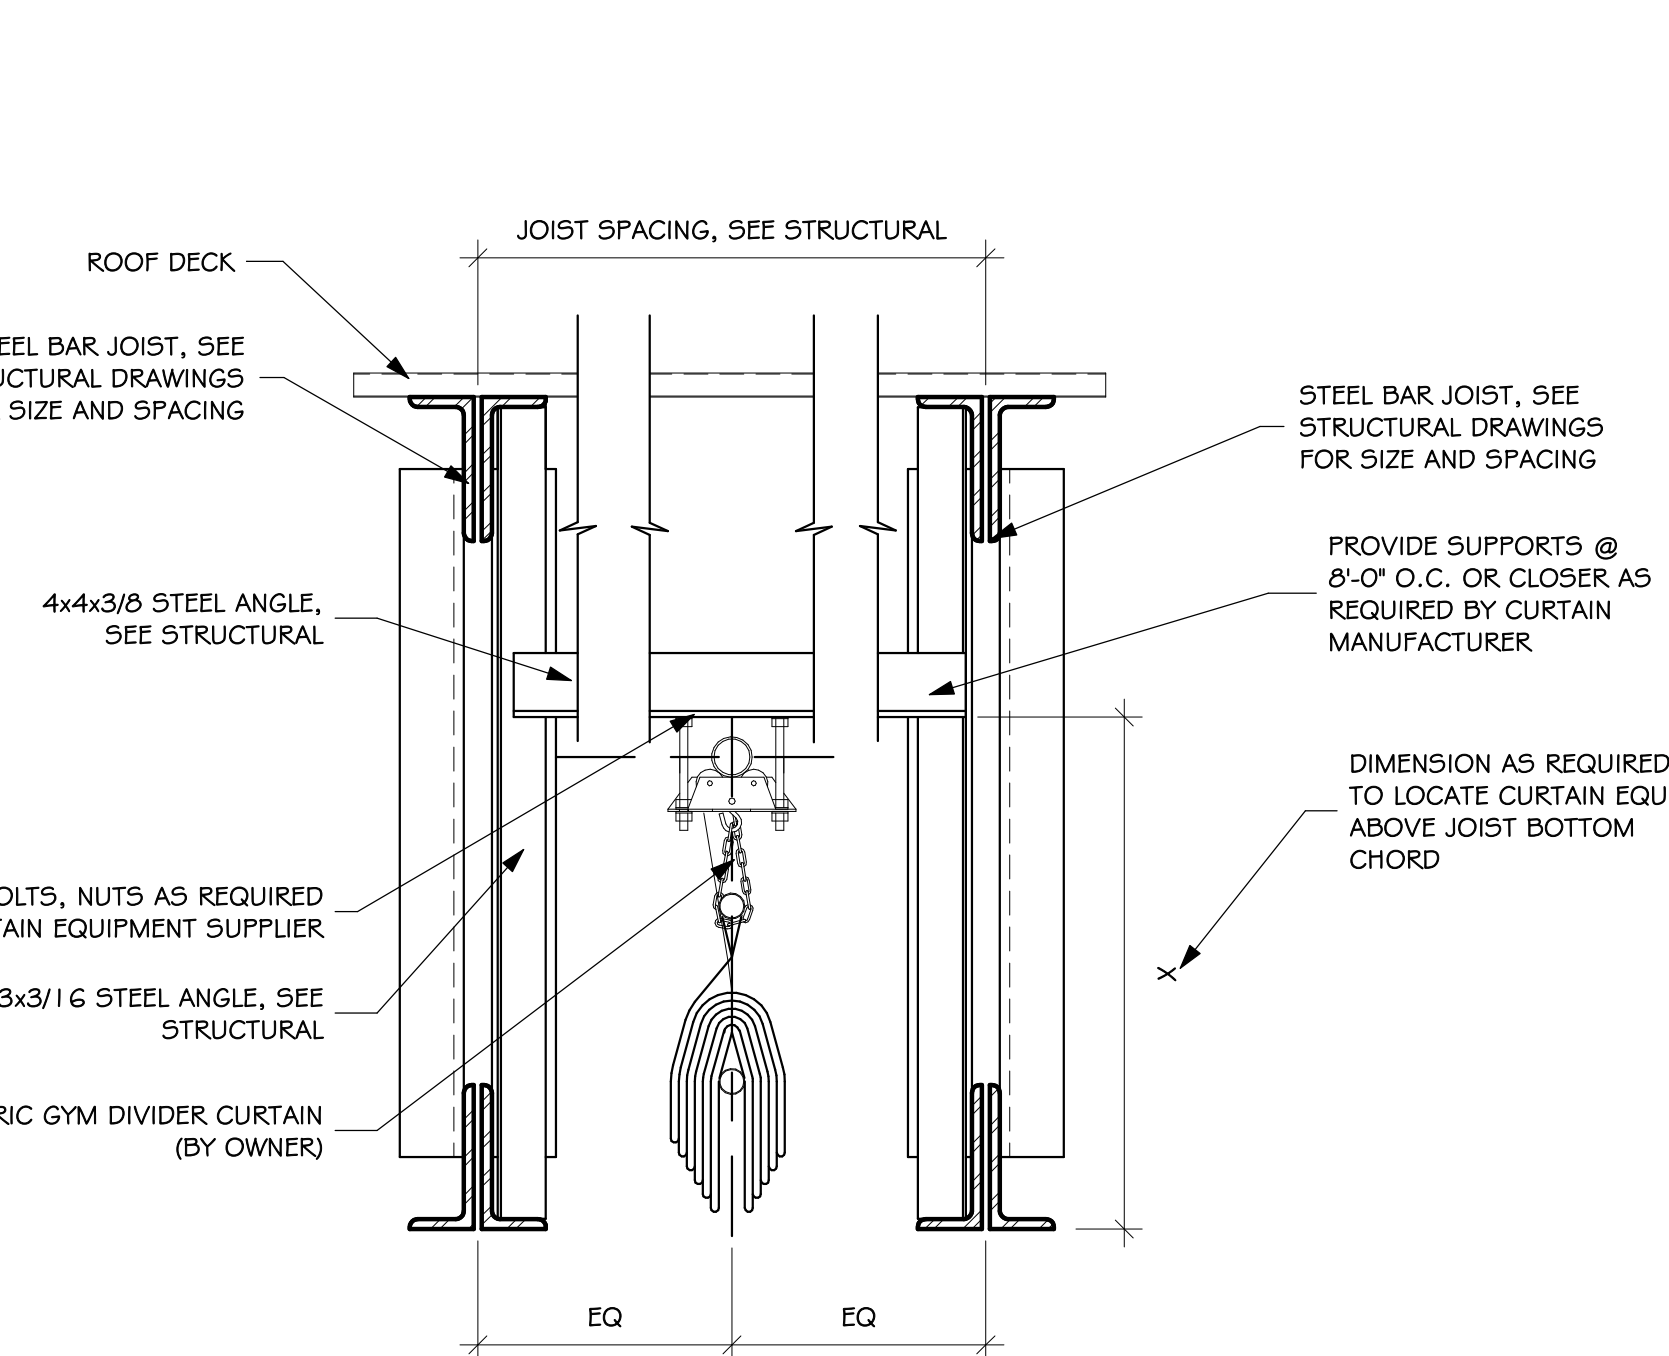


4 GYM DIVIDER CURTAIN DETAIL  
SCALE: 1" = 1'-0"

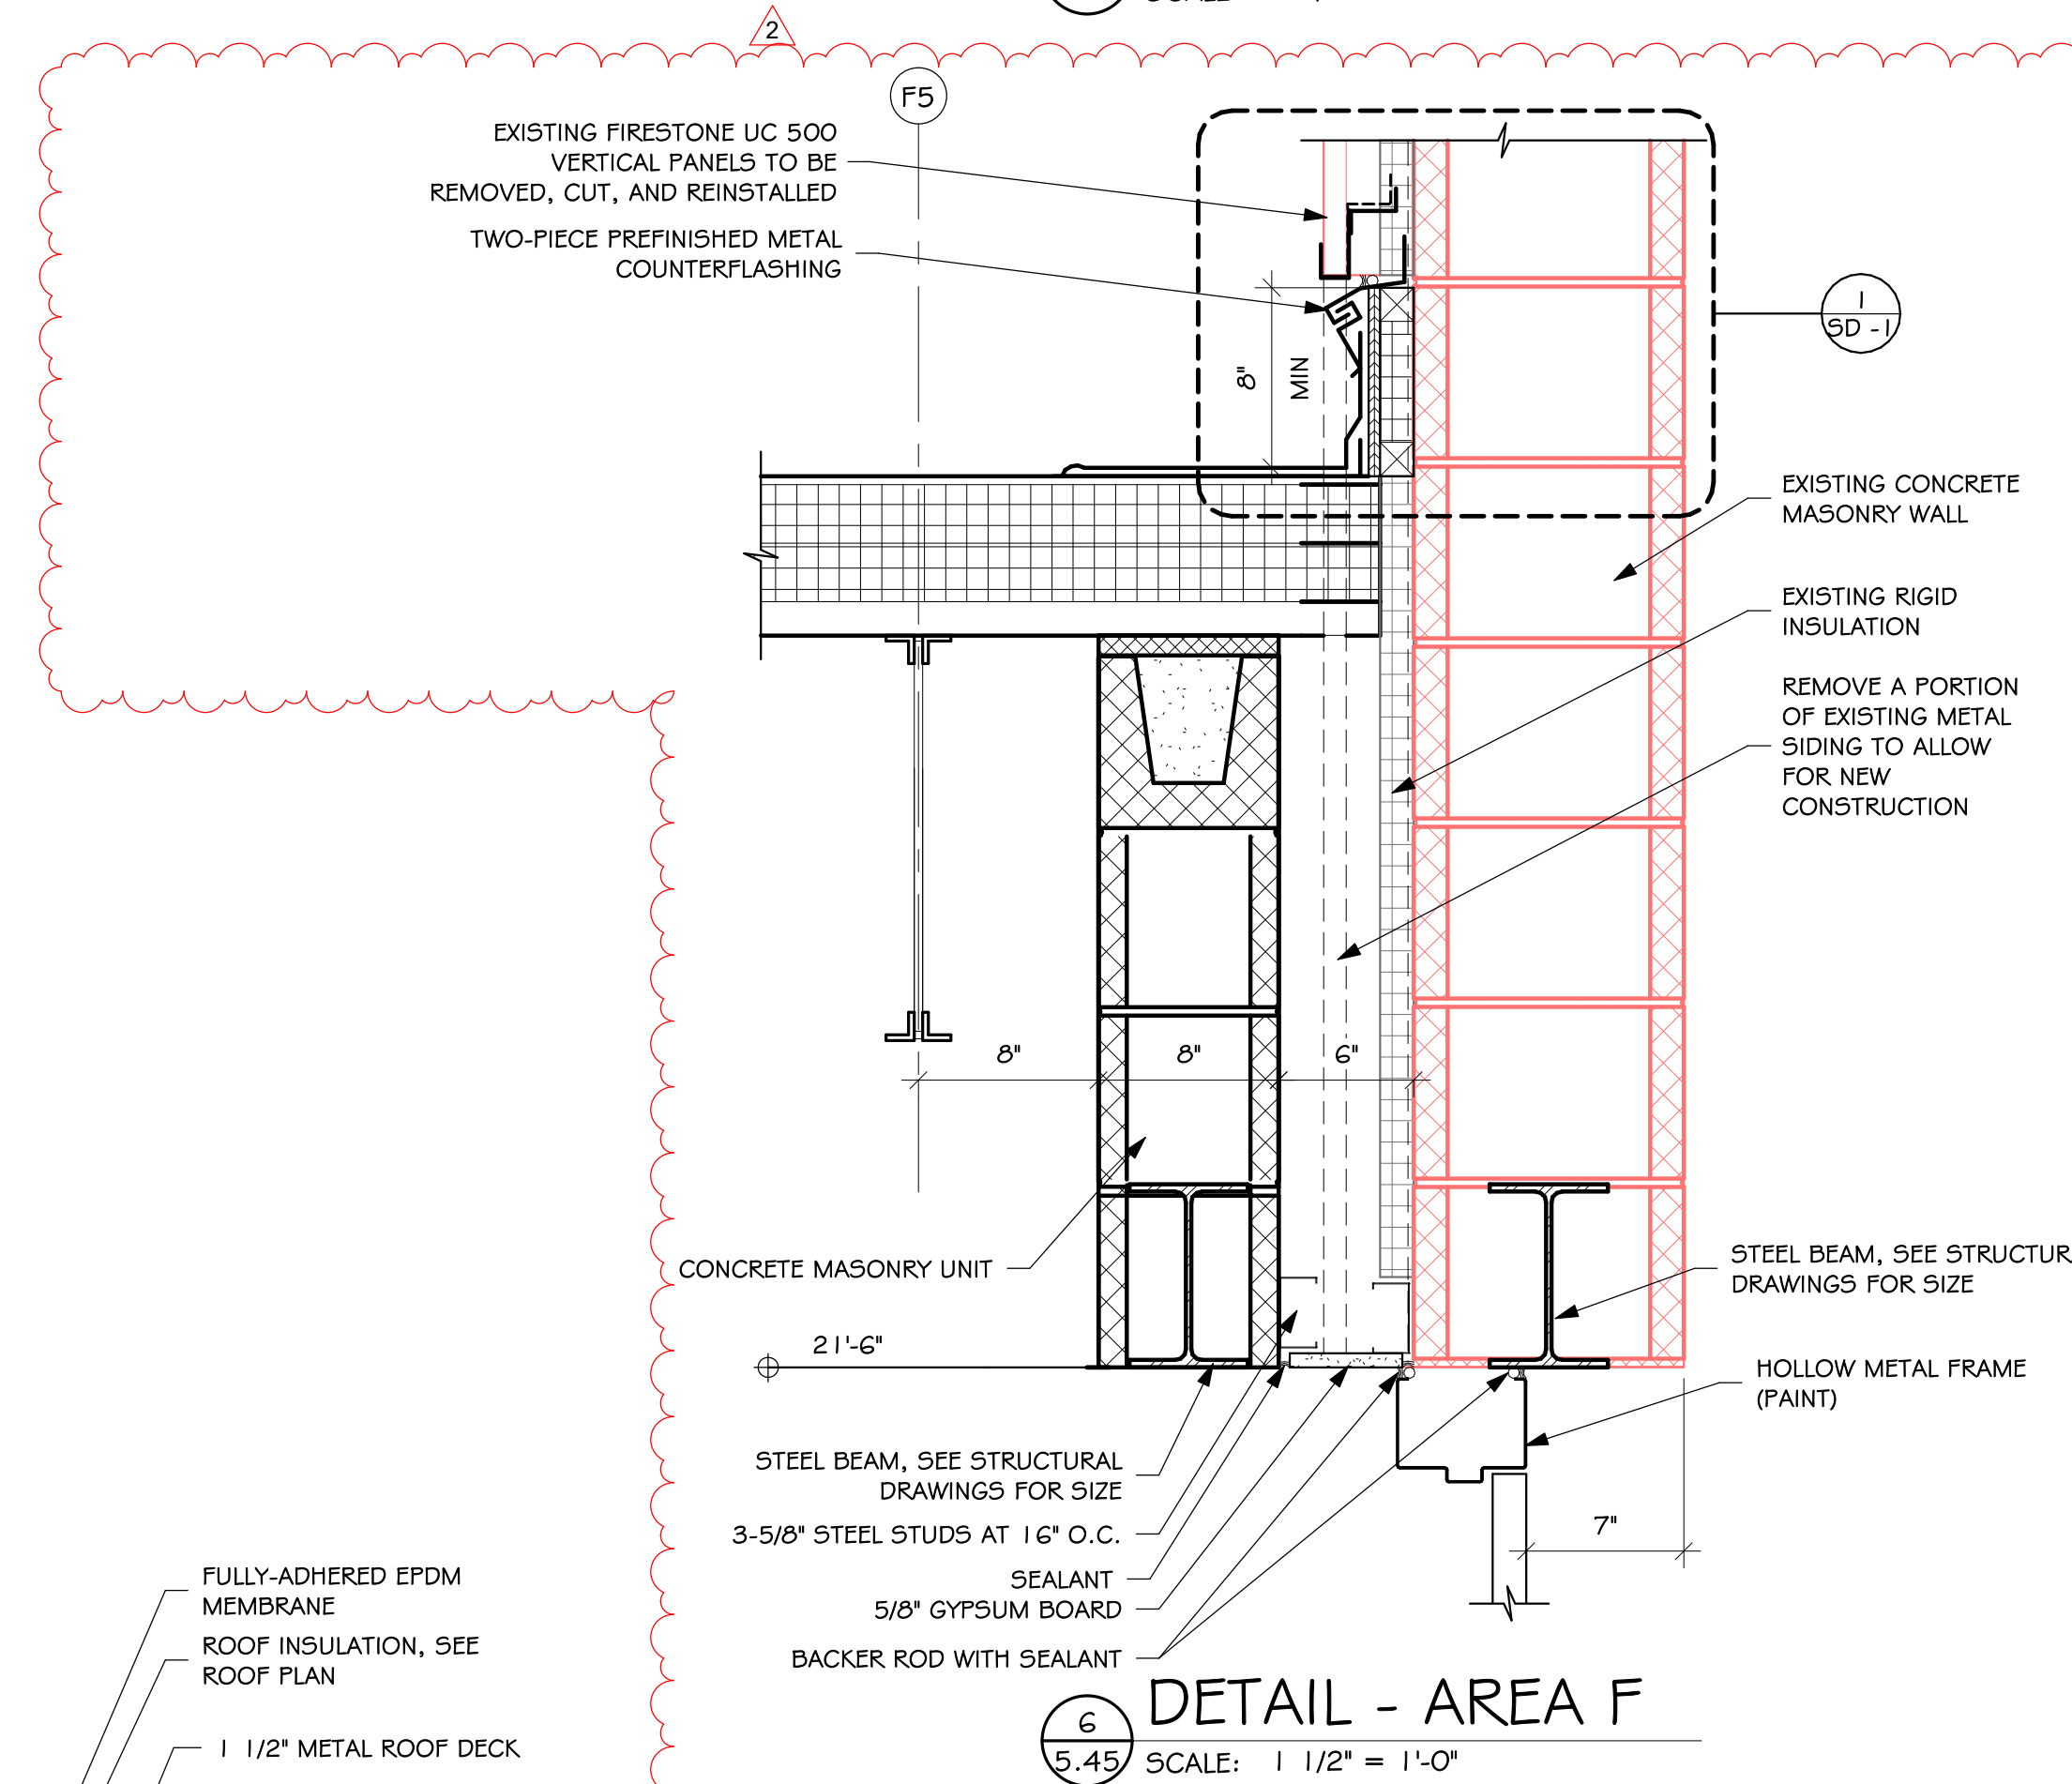


6 DETAIL - AREA F  
SCALE: 1 1/2" = 1'-0"

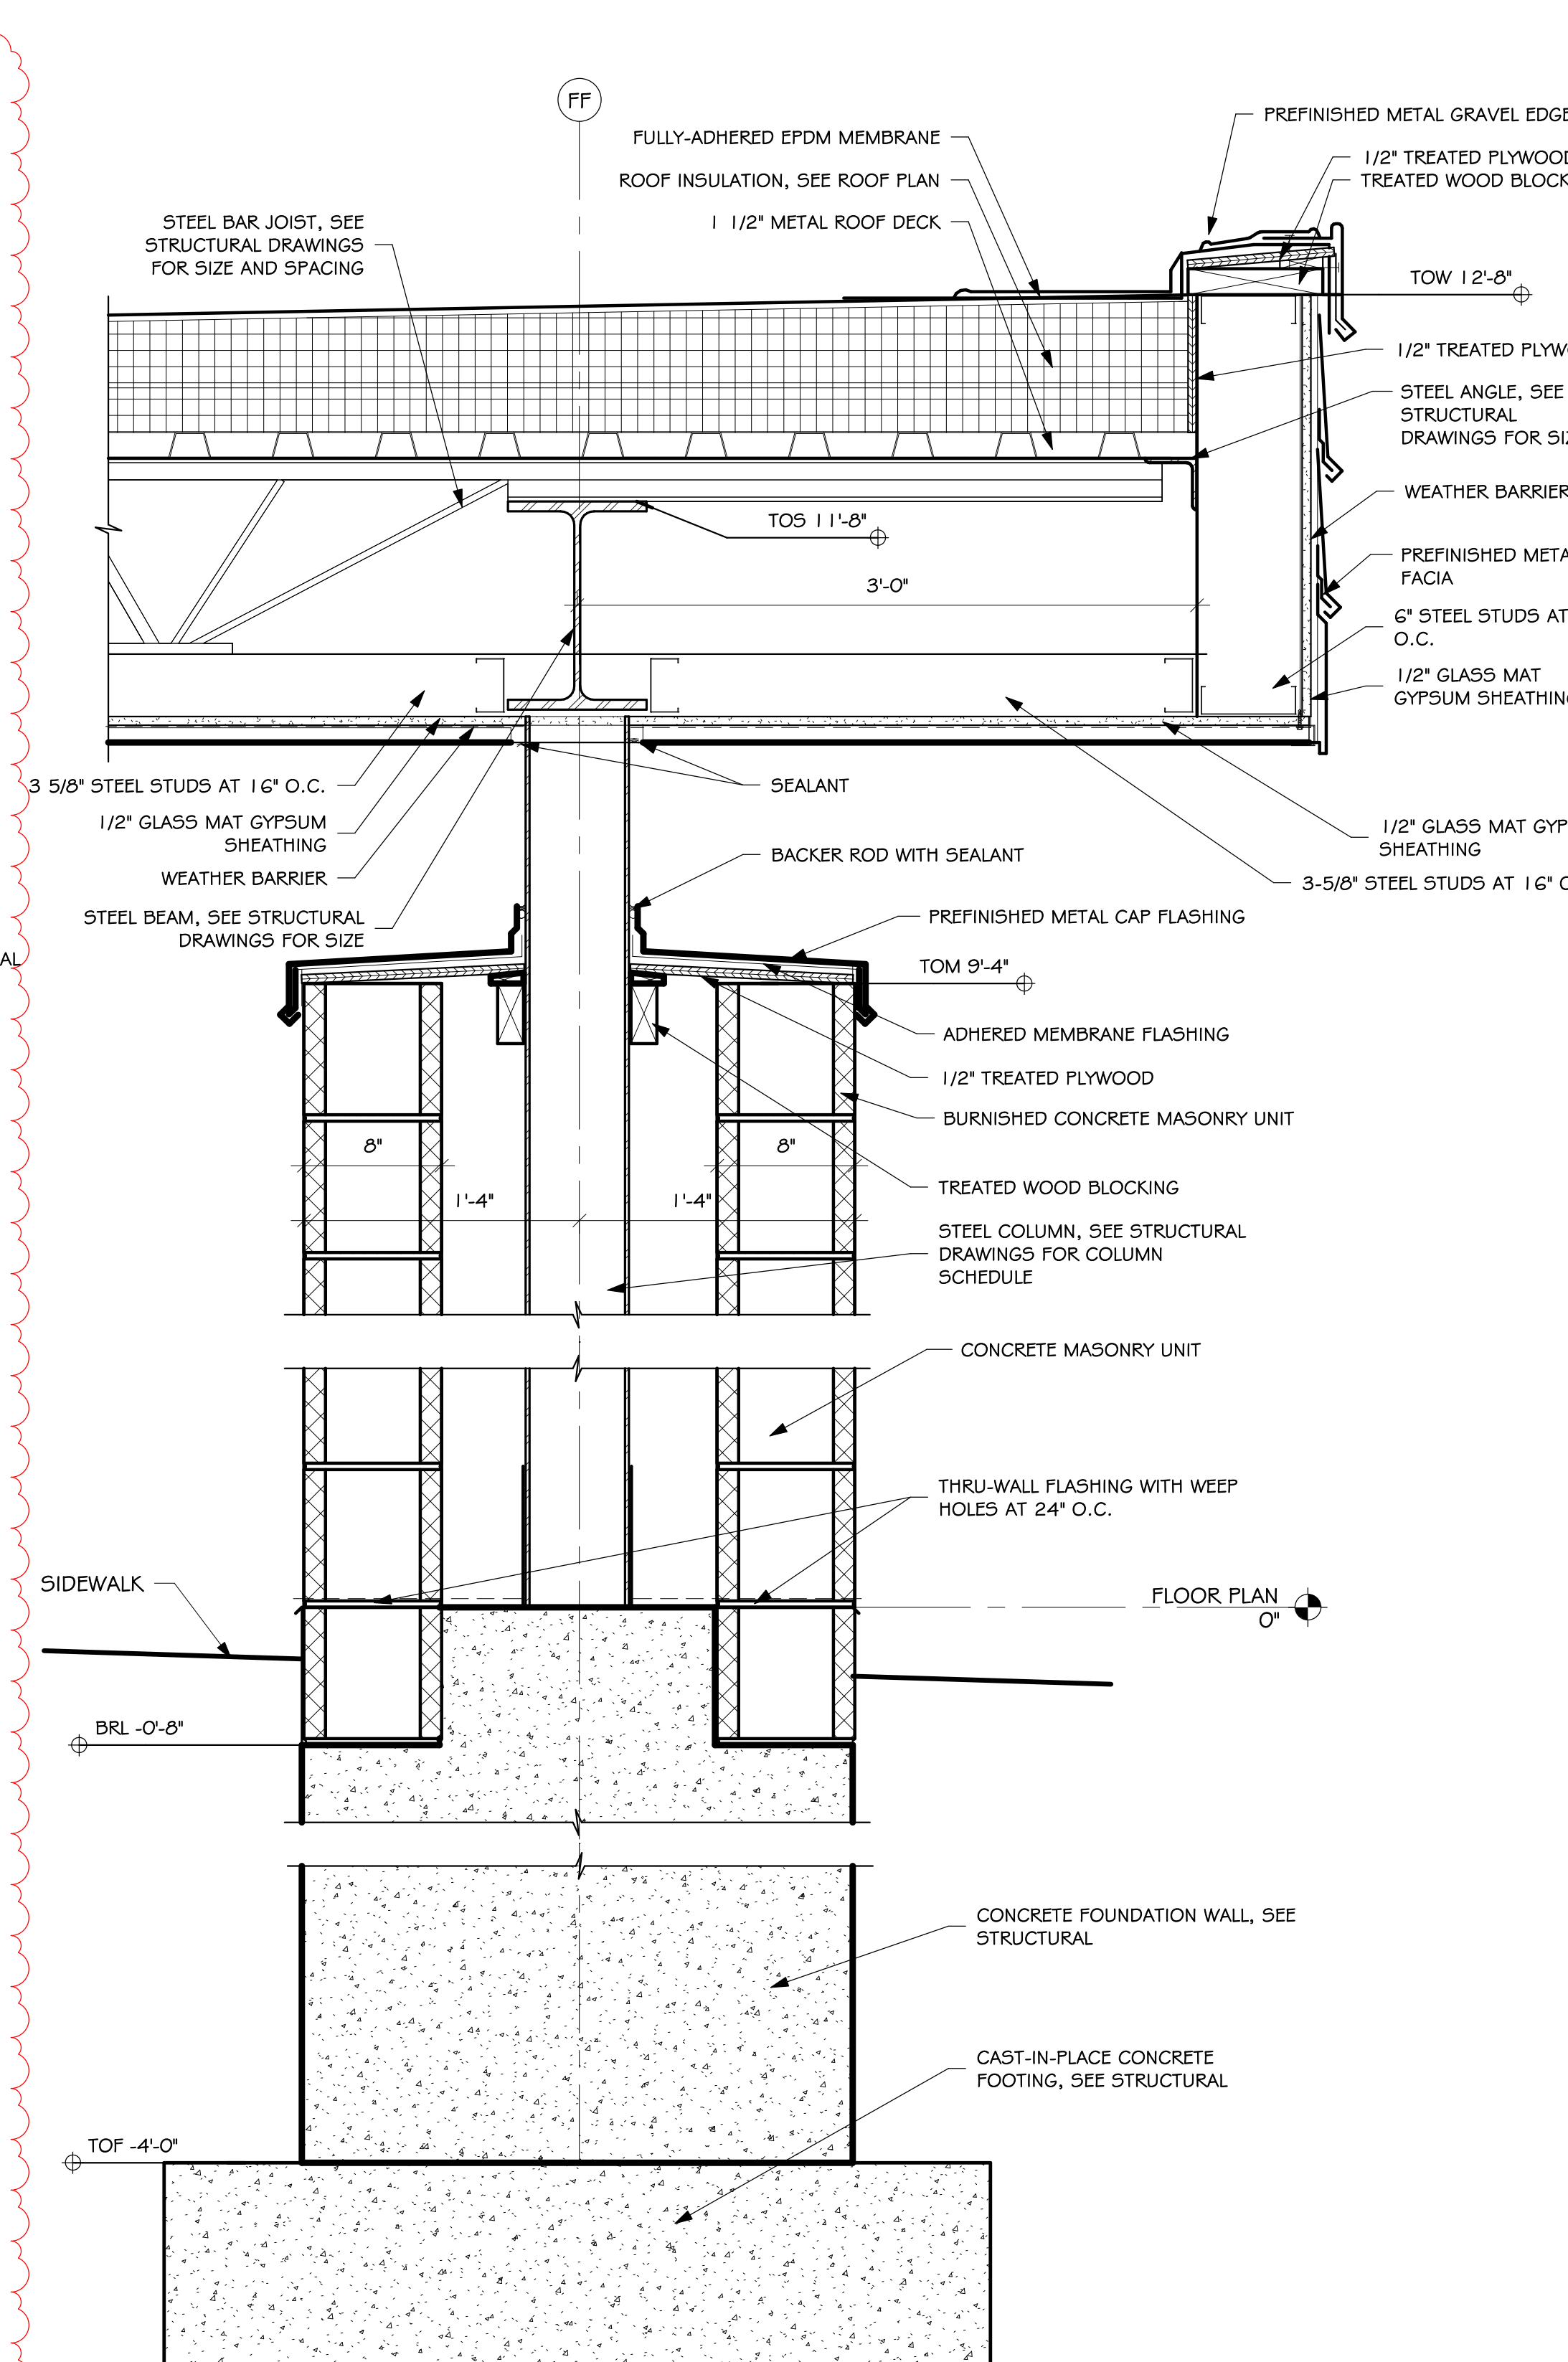

8 DETAIL - AREA F  
SCALE: 1 1/2" = 1'-0"

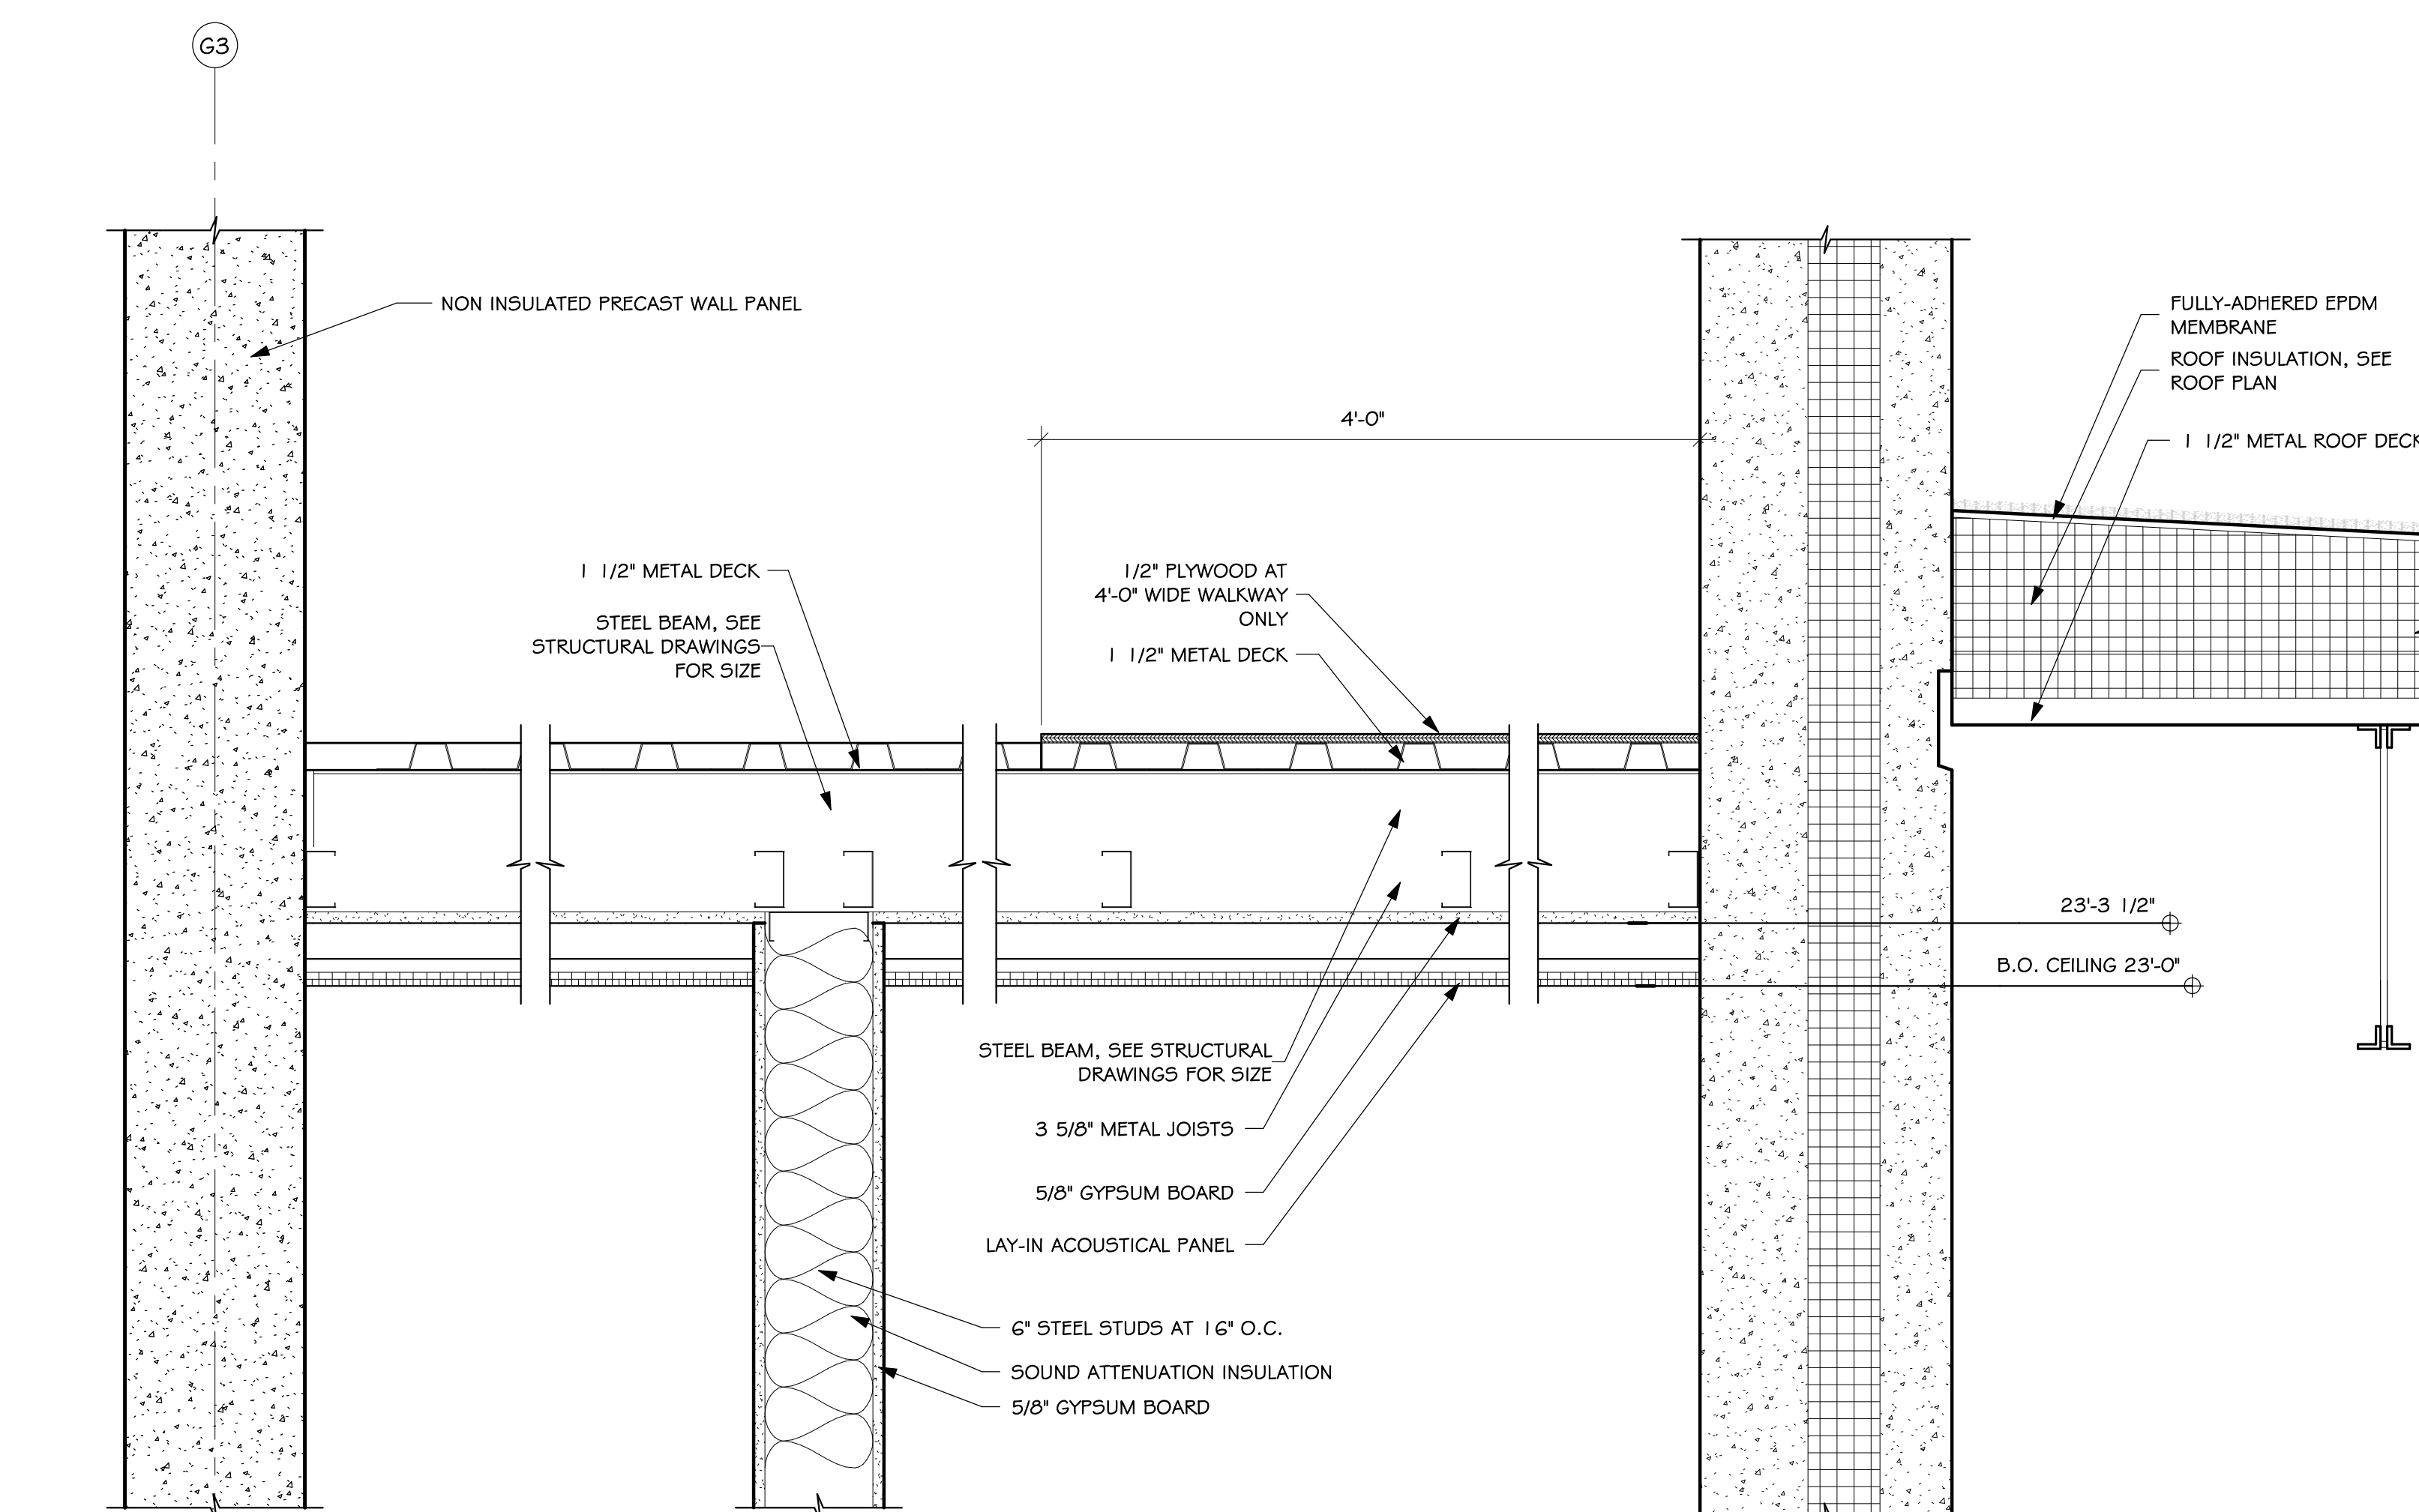

5 AREA G - DETAIL  
SCALE: 1 1/2" = 1'-0"

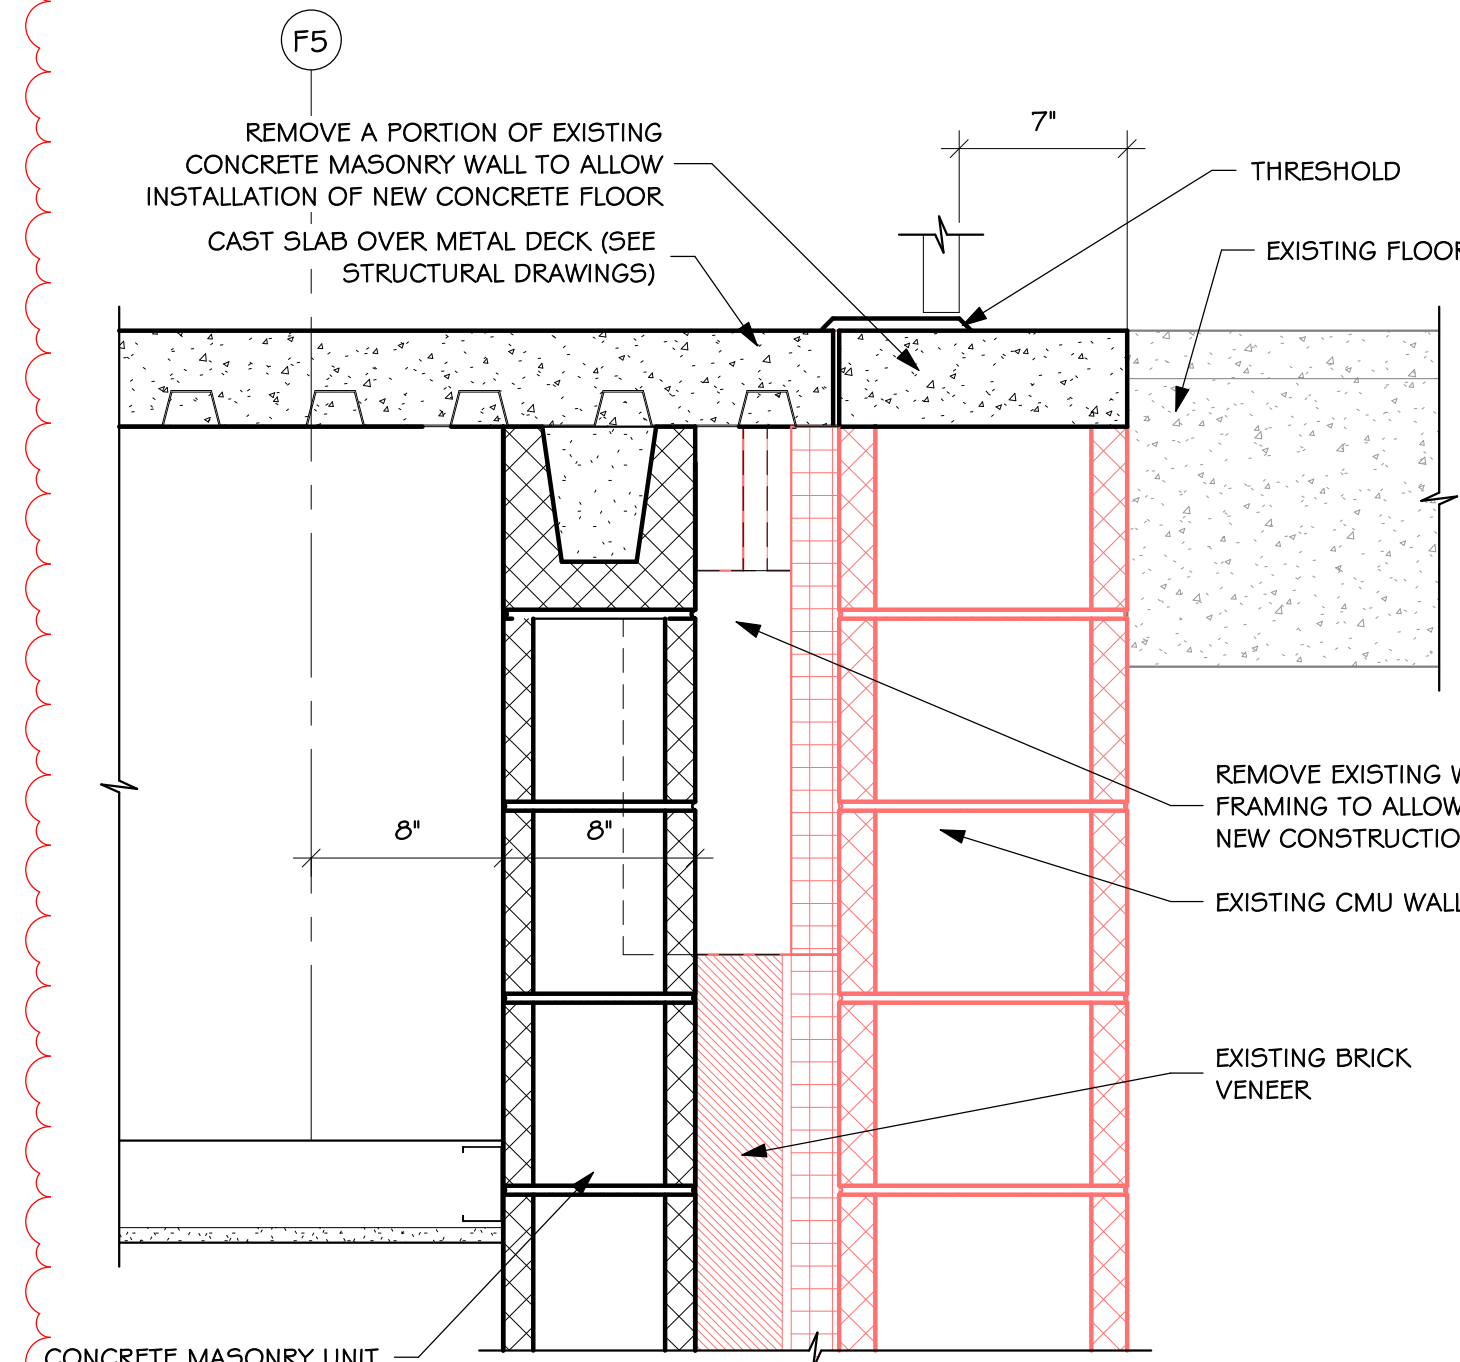

7 DETAIL - AREA F  
SCALE: 1 1/2" = 1'-0"


1/18/2024 5:14:13 PM



0215.2982.22  
DECEMBER 21, 2023  
MS/SWP checked SRJ


DATE	DESCRIPTION
1/8/2024	ADDENDUM #2

## 6.10-D

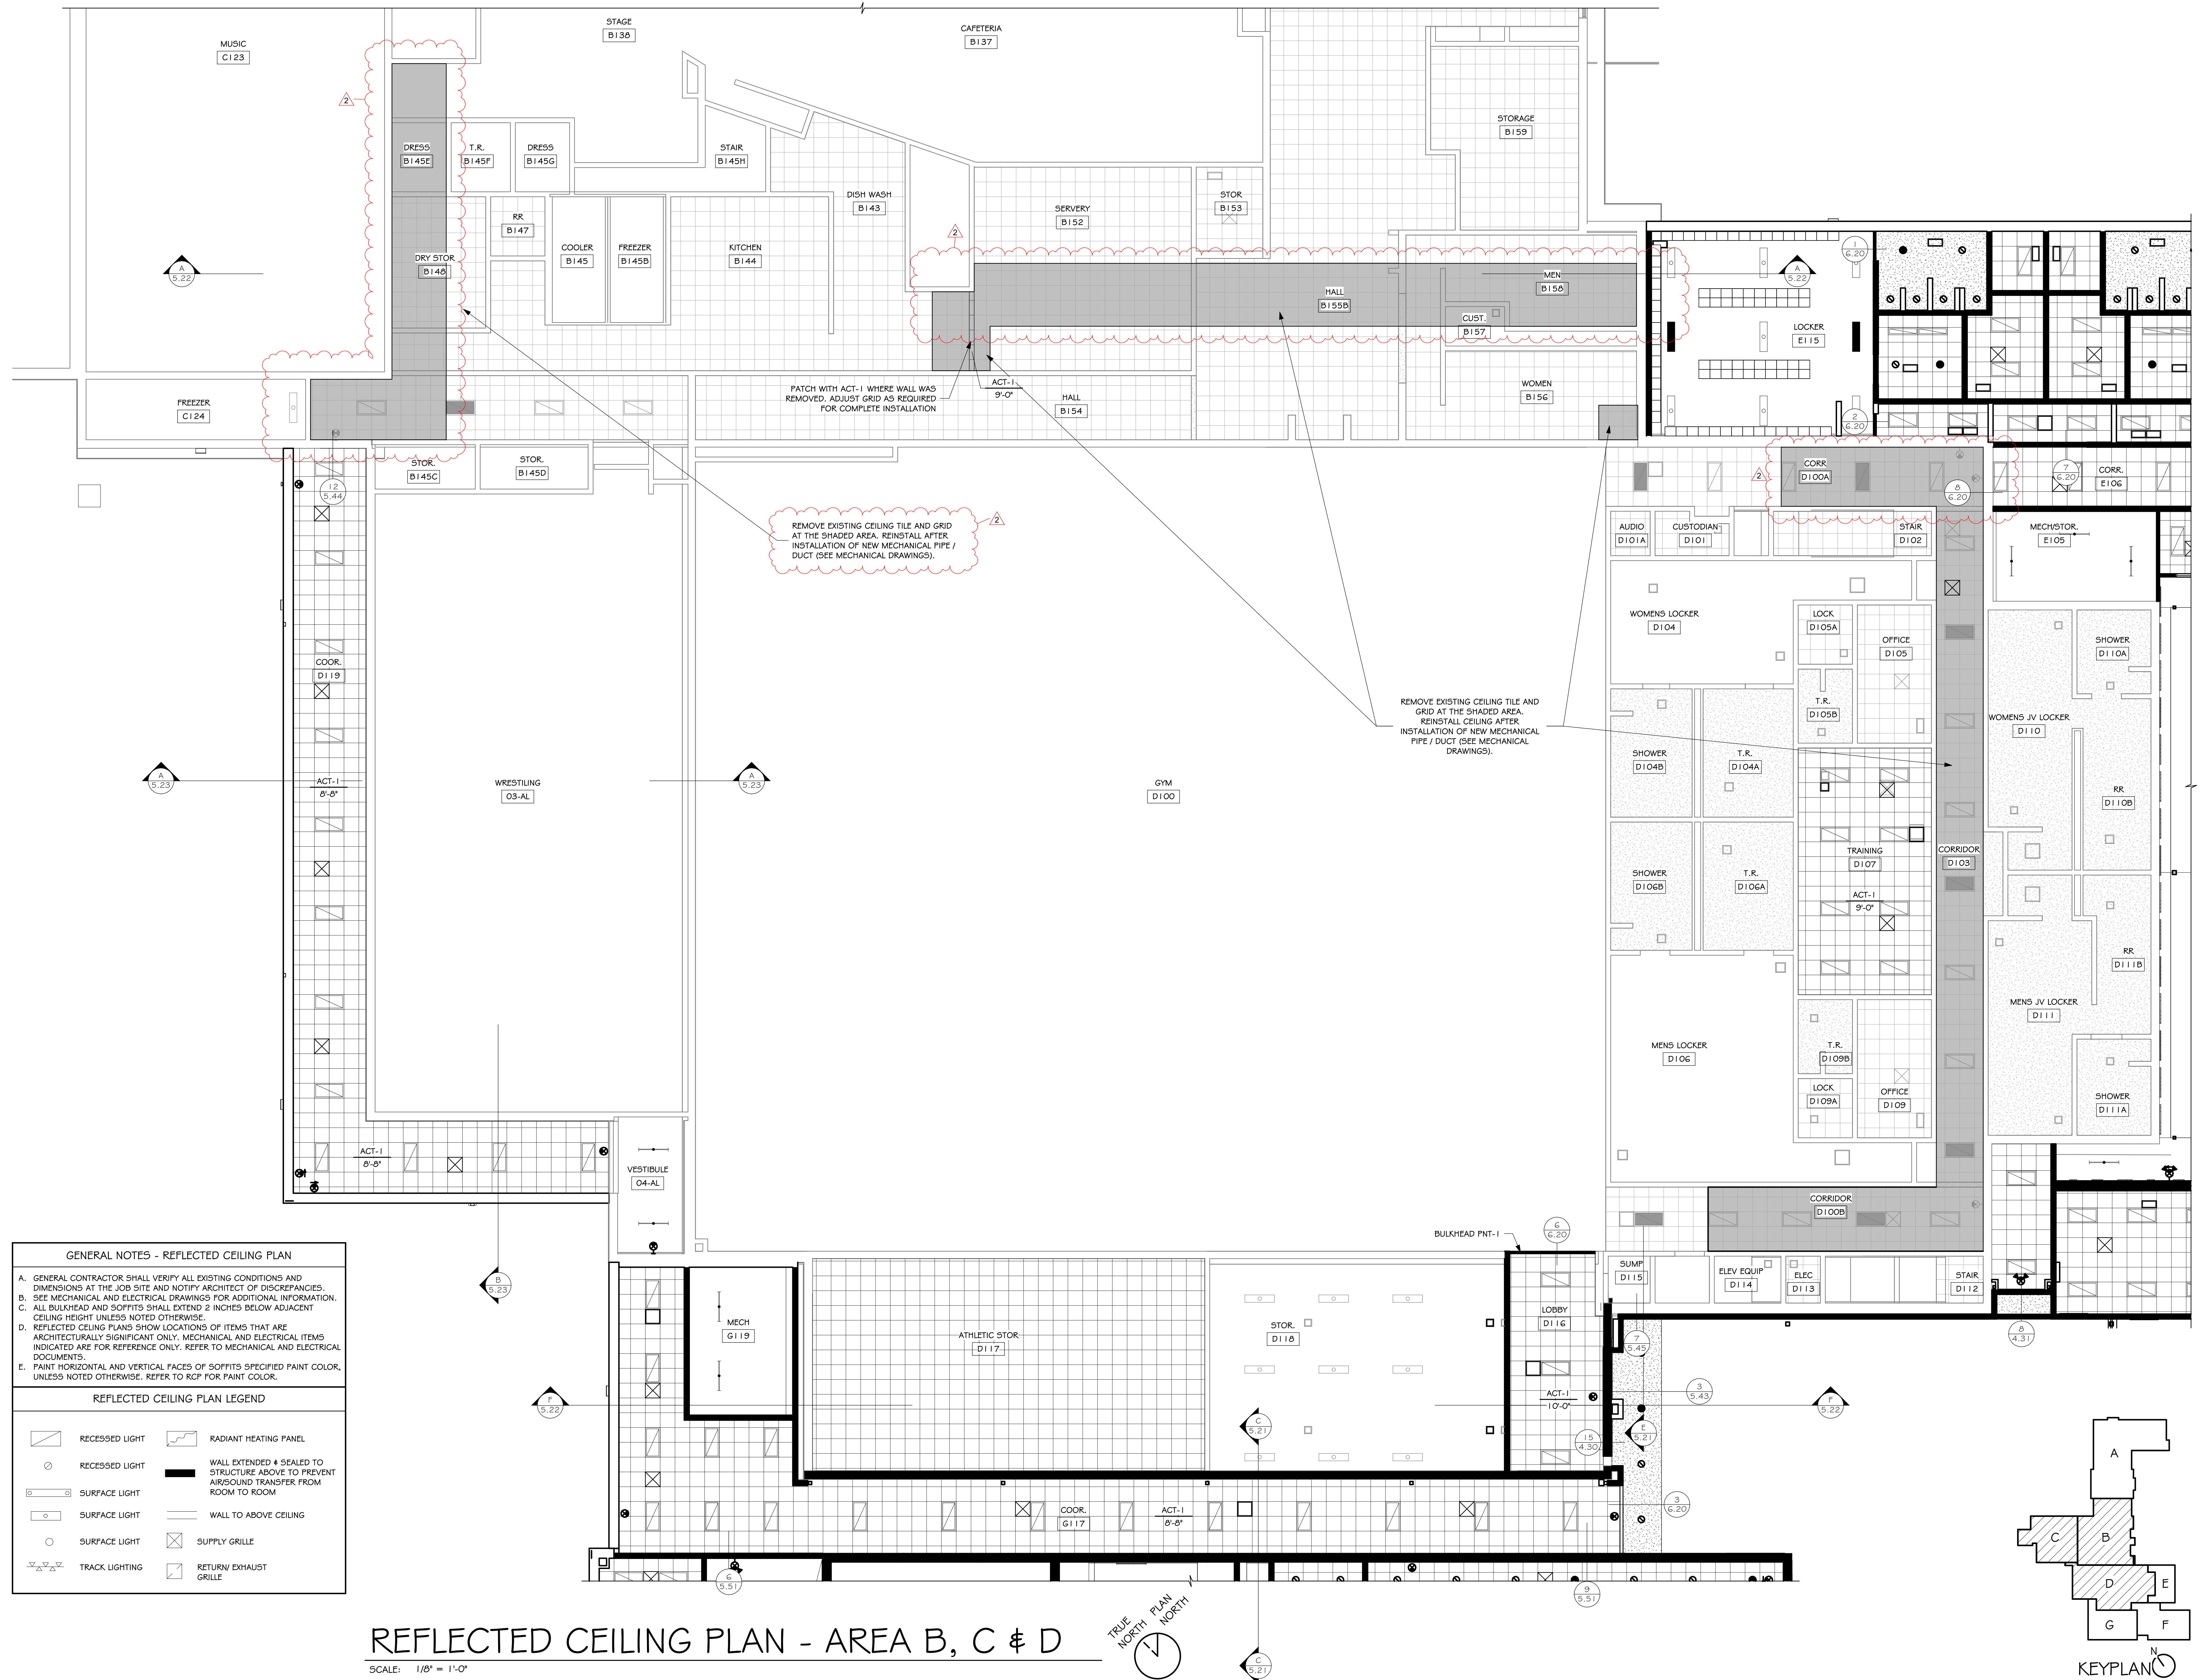





1/18/2024 3:06:21 PM

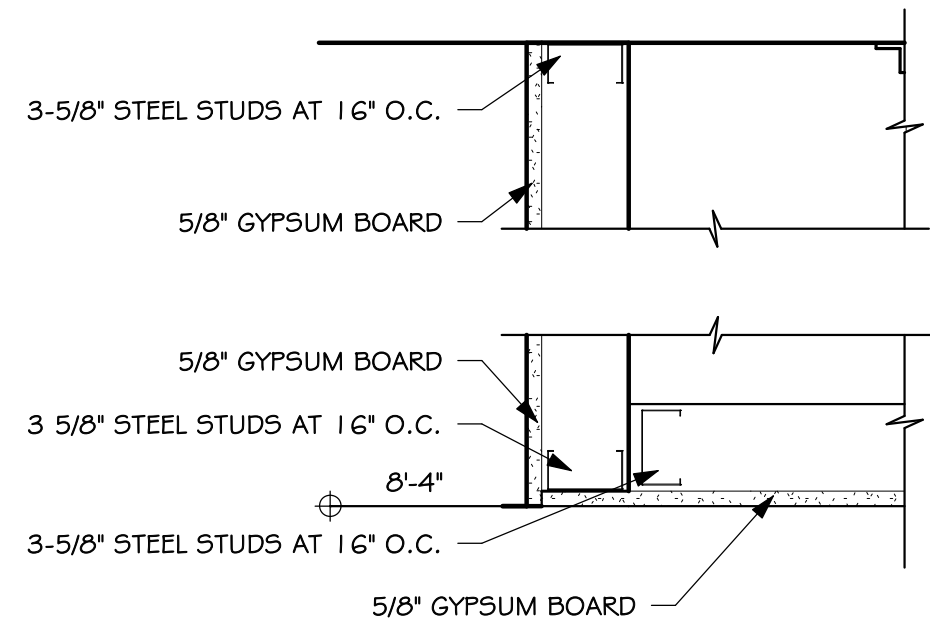


1  
6.20  
DETAIL  
SCALE: 1 1/2" = 1'-0"

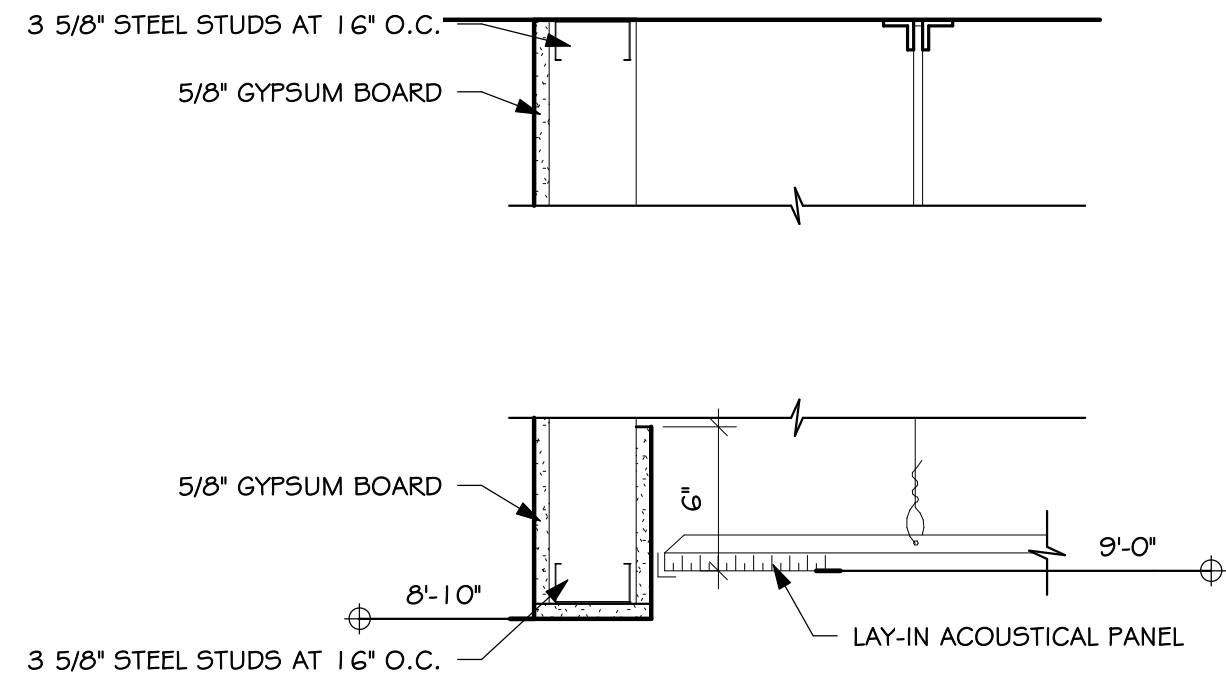


2  
6.20  
DETAIL  
SCALE: 1 1/2" = 1'-0"

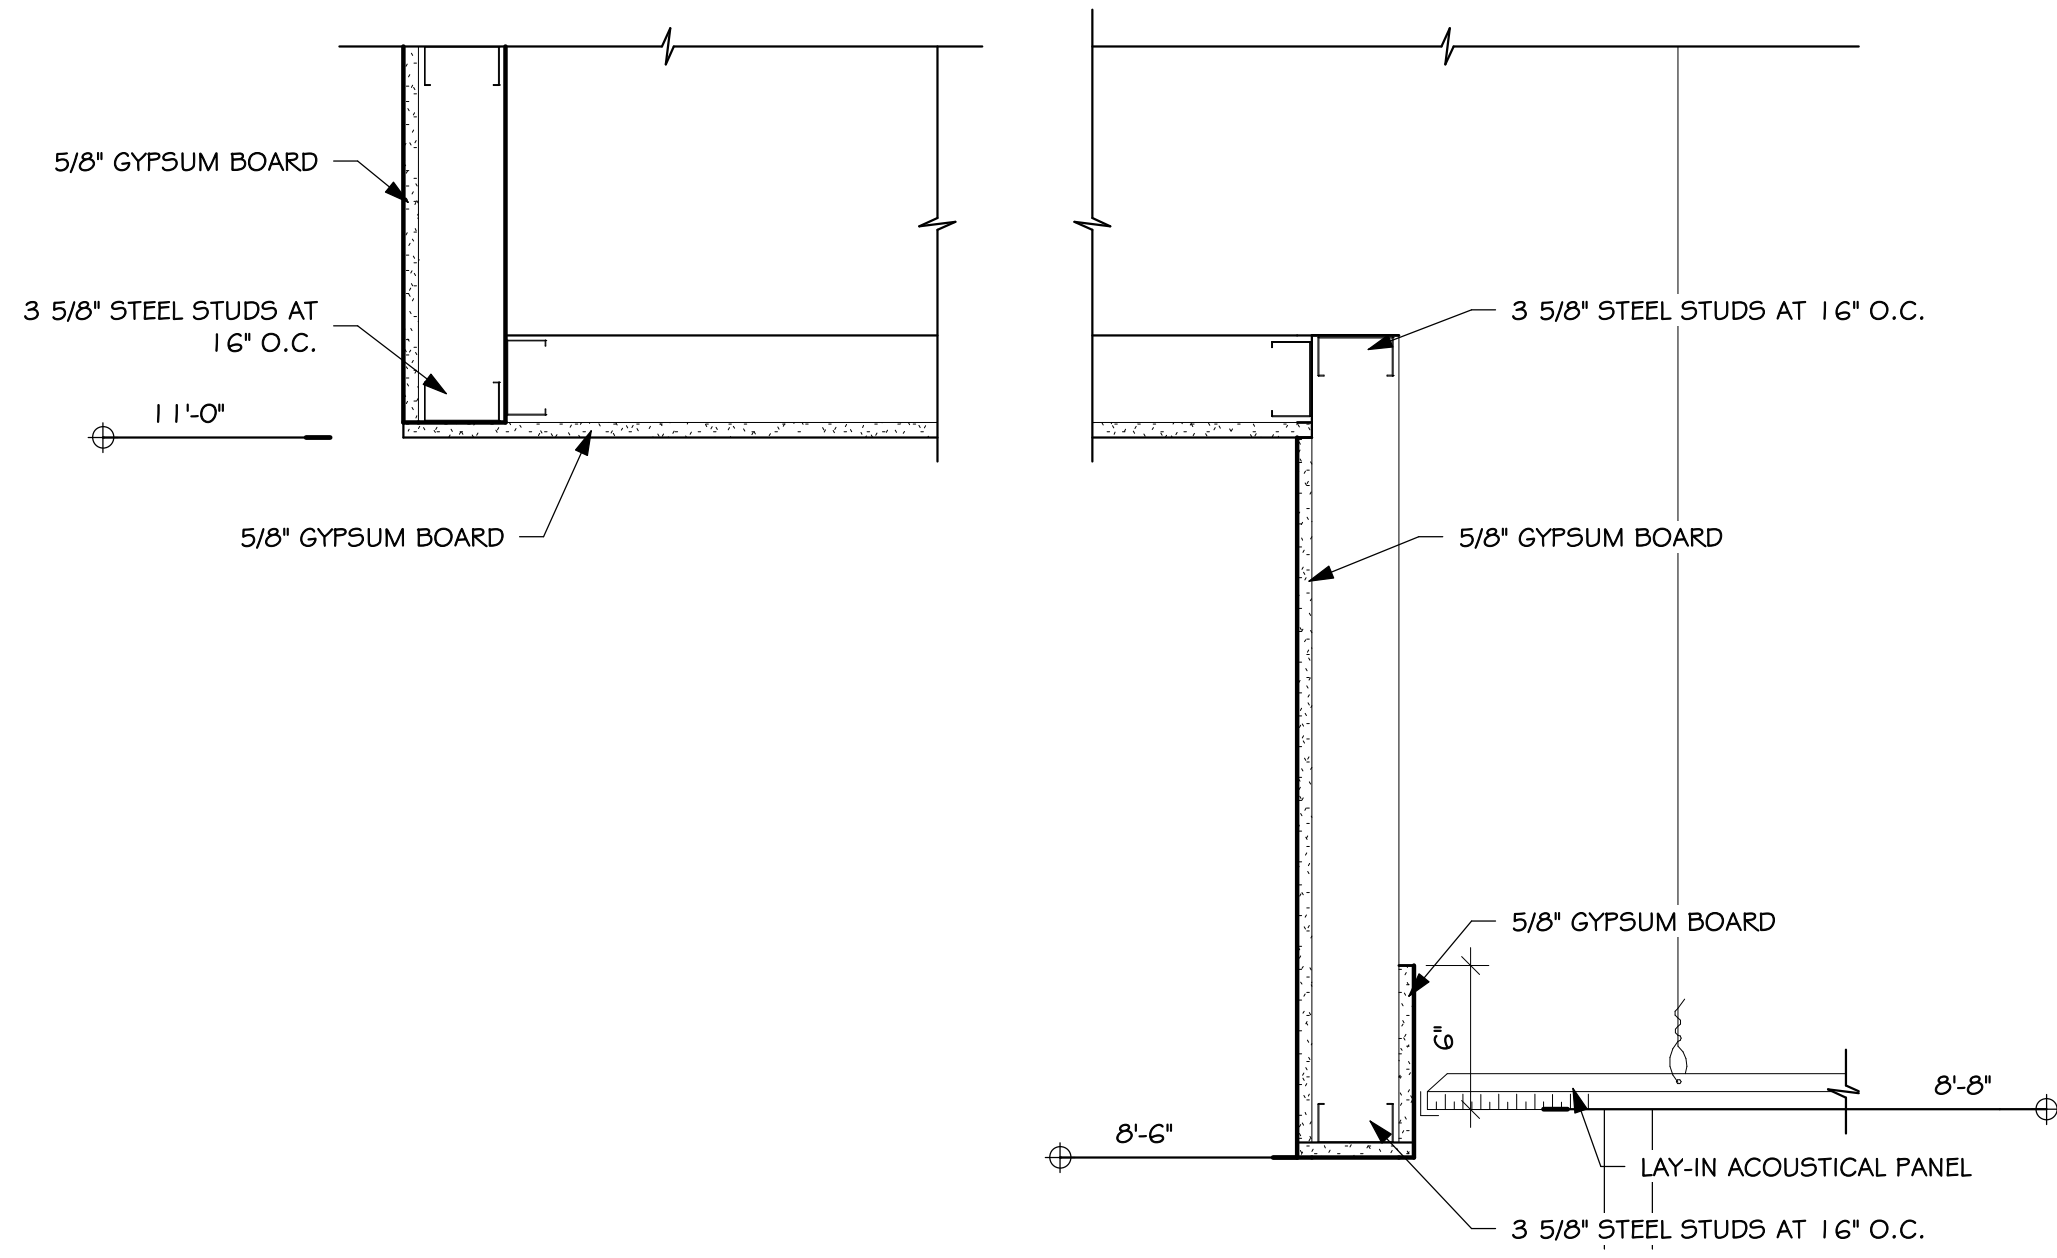


3  
6.20  
DETAIL  
SCALE: 1 1/2" = 1'-0"

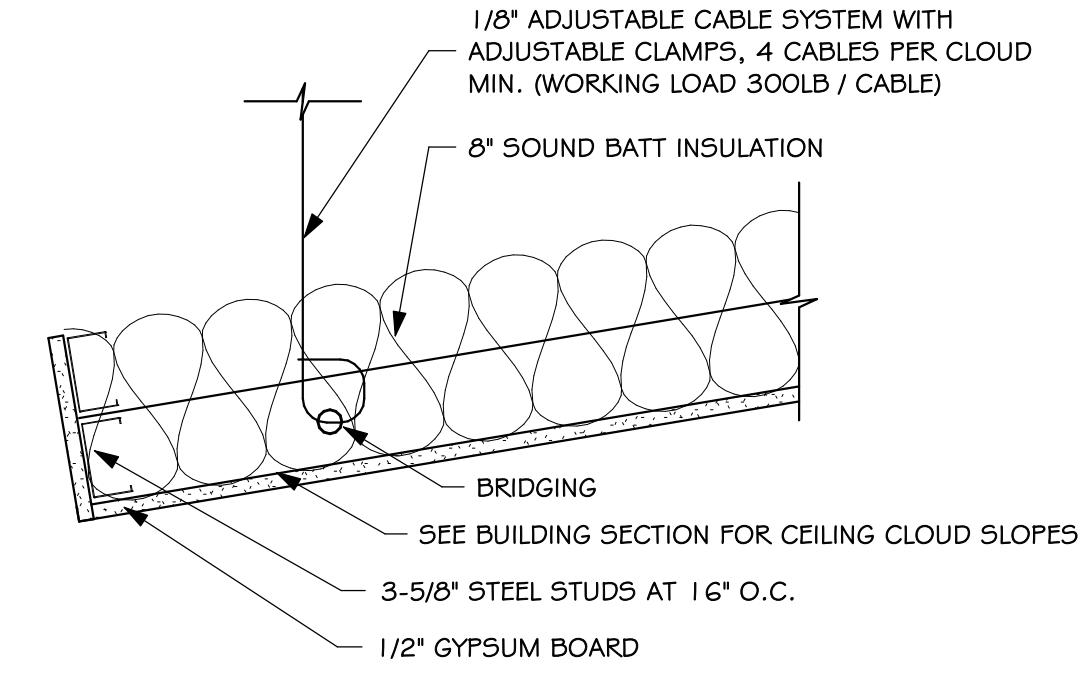


4  
6.20  
CEILING CLOUD DETAIL AT THEATER  
SCALE: 1 1/2" = 1'-0"

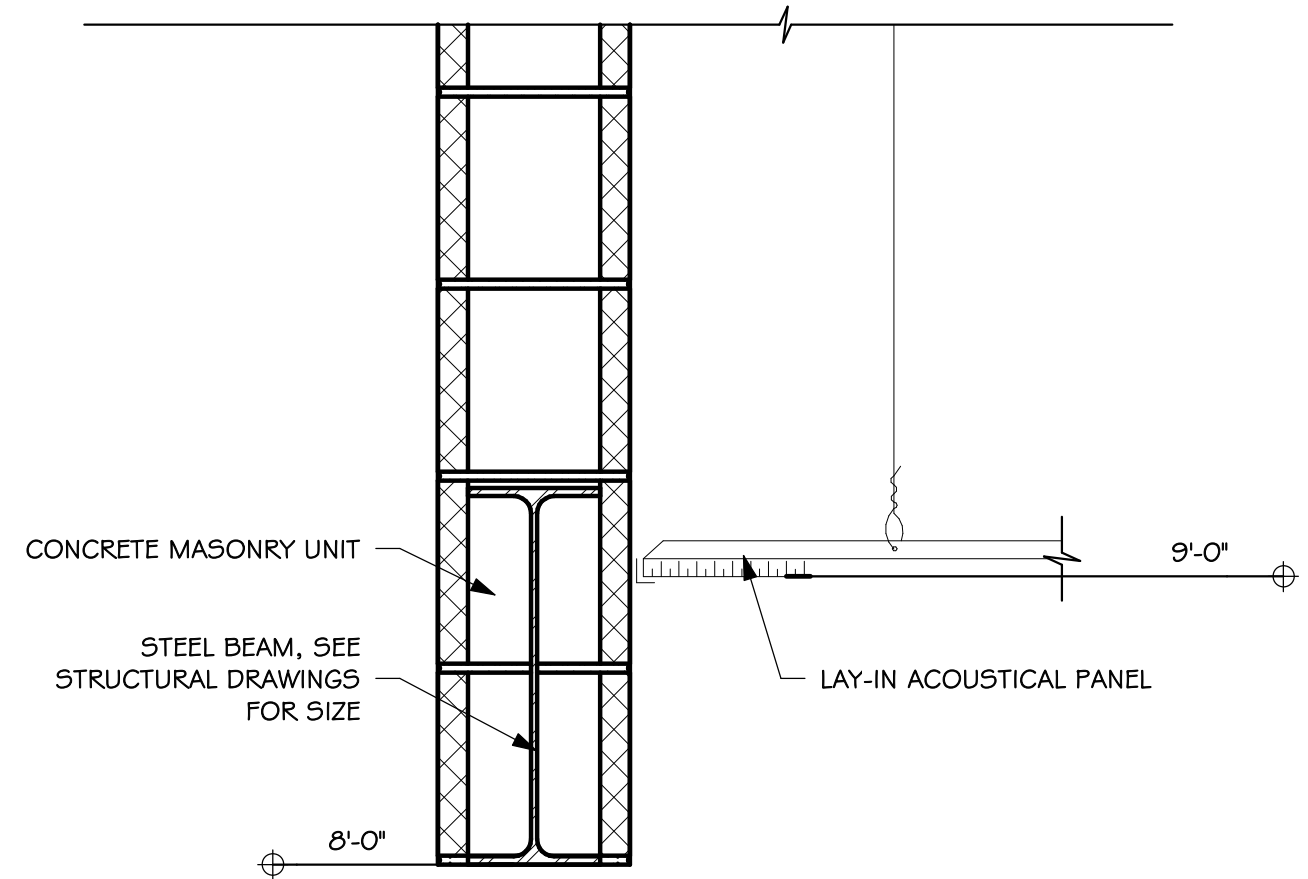


5  
6.20  
DETAIL  
SCALE: 1 1/2" = 1'-0"

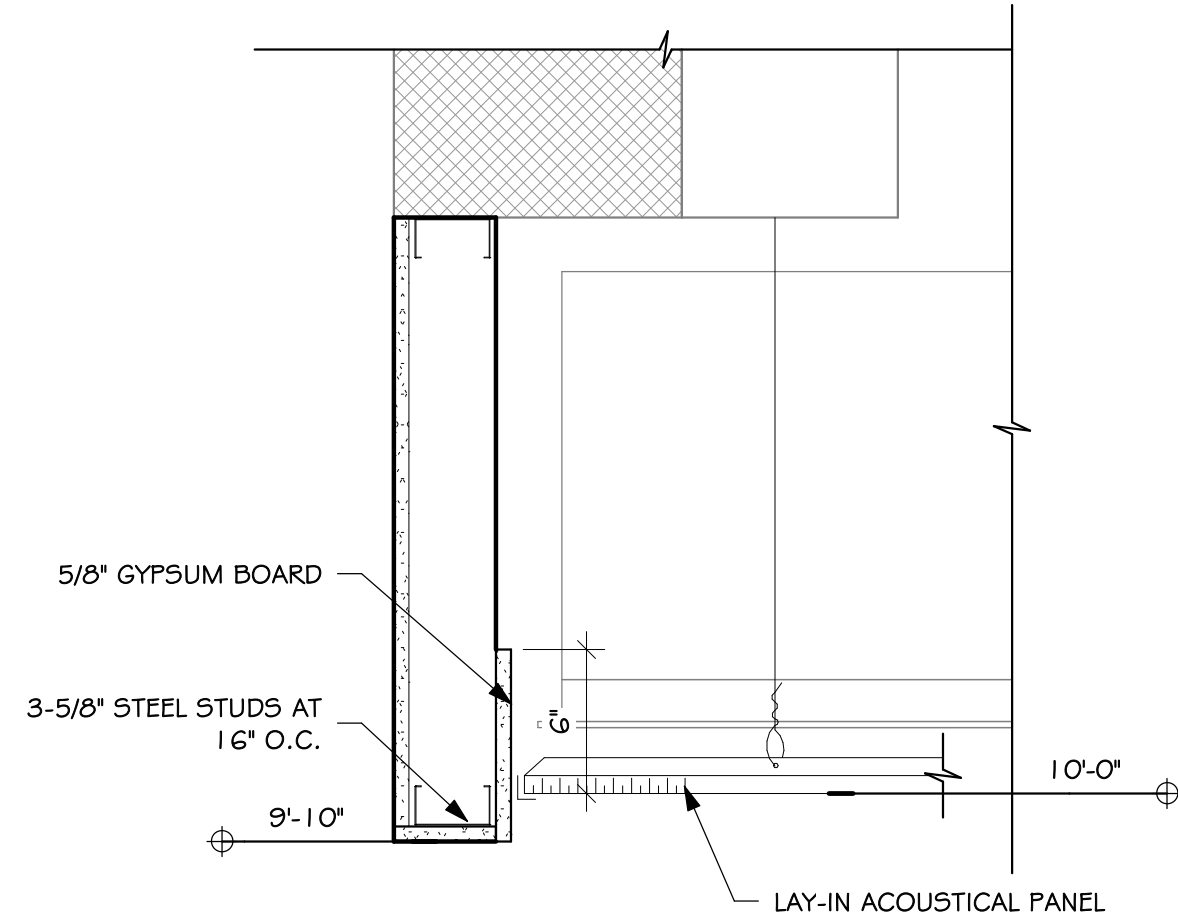


6  
6.20  
DETAIL  
SCALE: 1 1/2" = 1'-0"

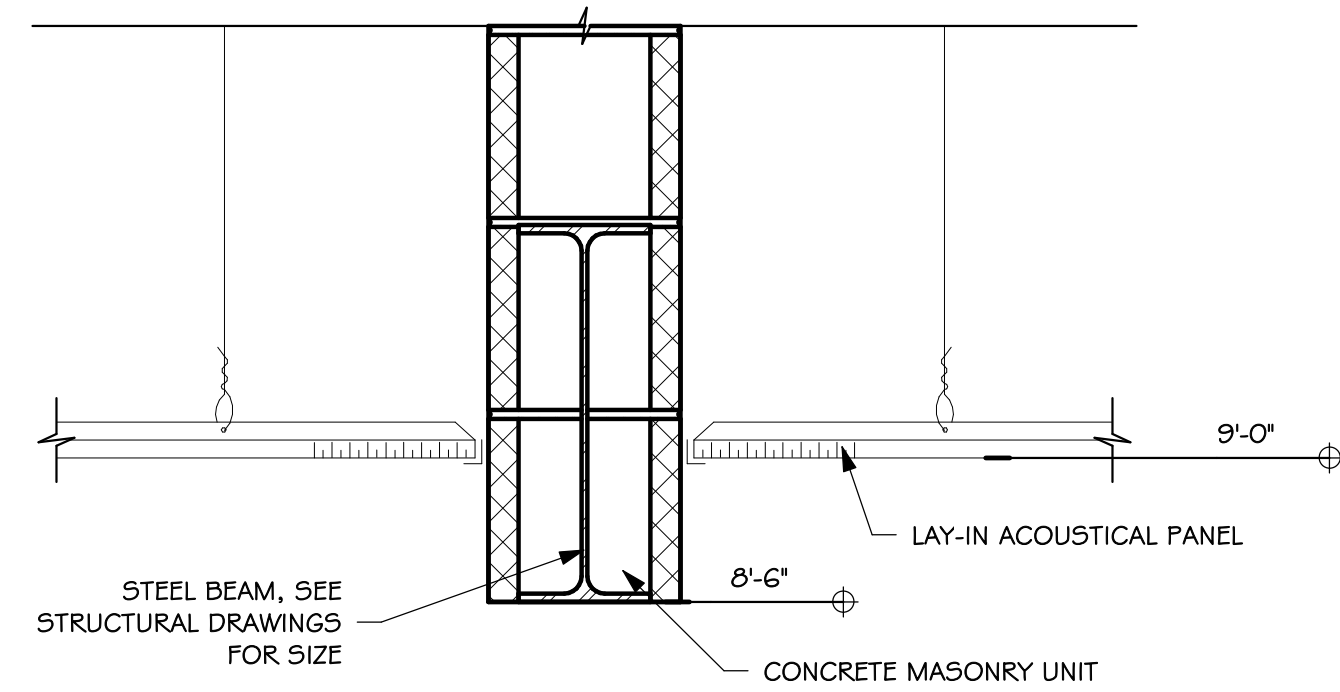

7  
6.20  
DETAIL  
SCALE: 1 1/2" = 1'-0"

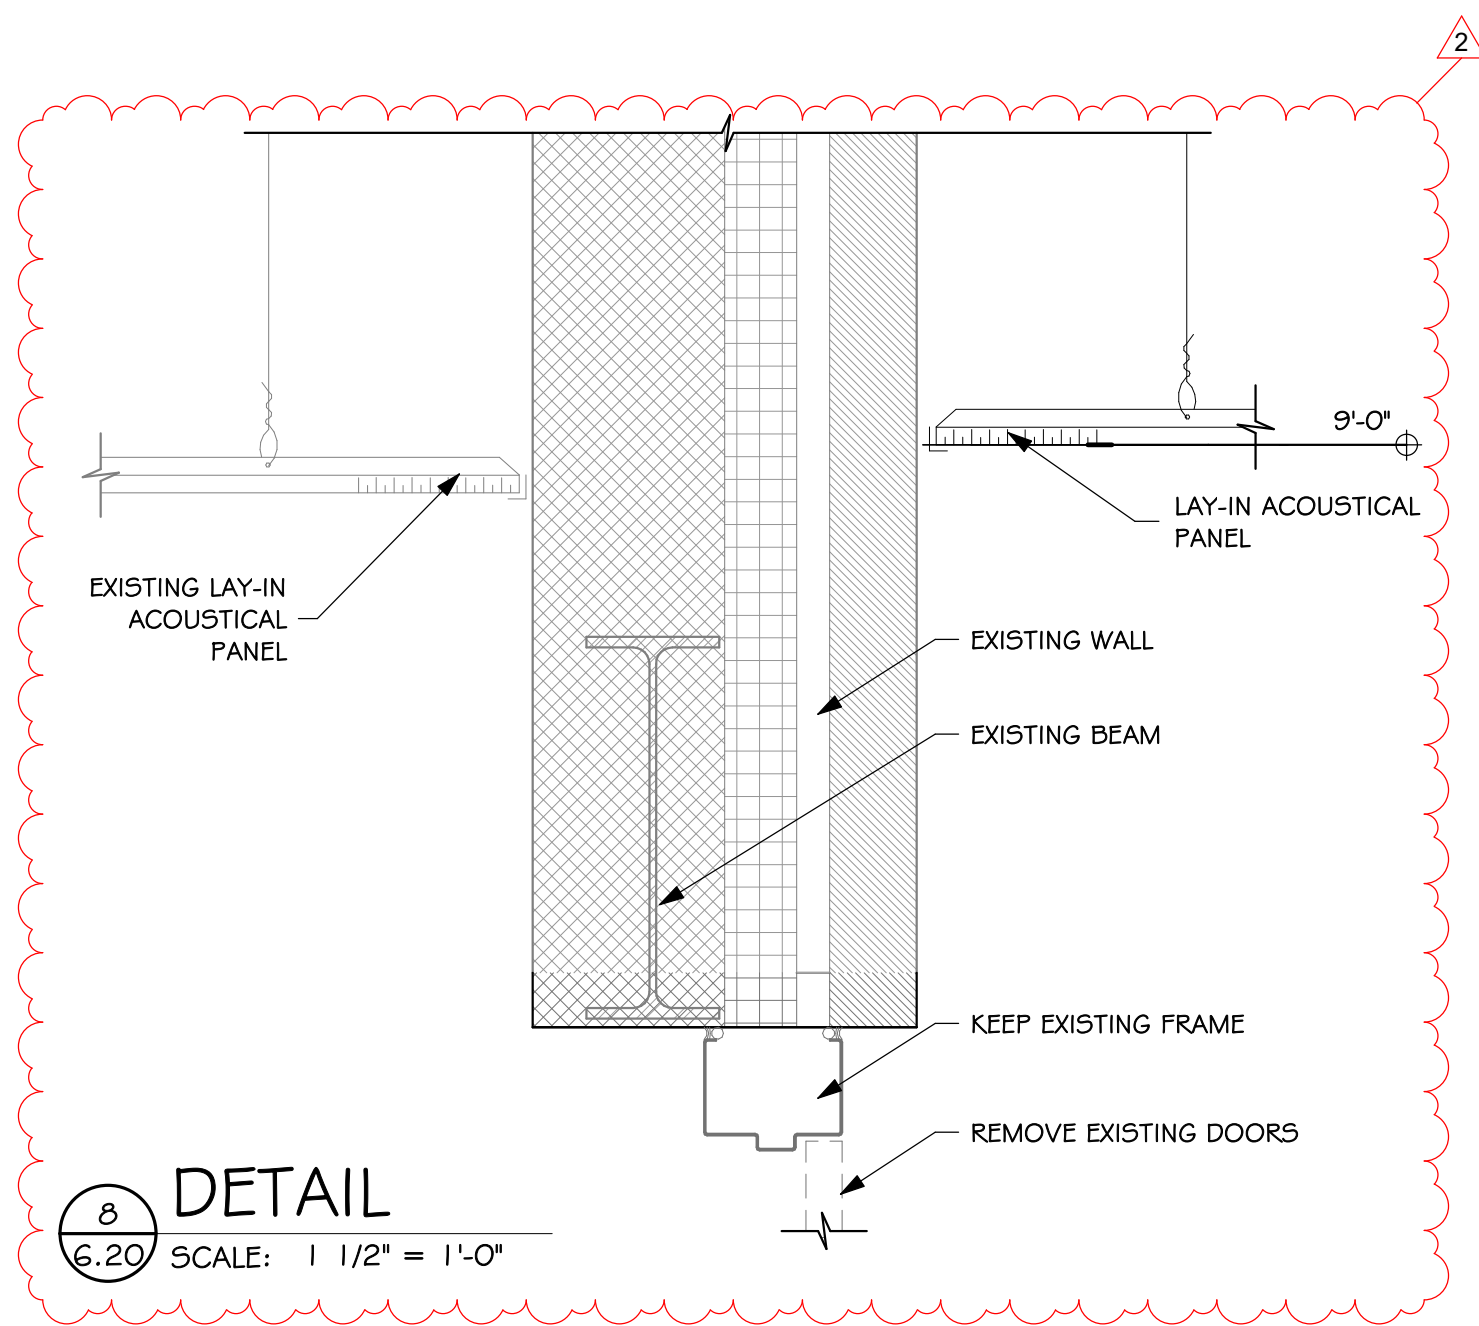

8  
6.20  
DETAIL  
SCALE: 1 1/2" = 1'-0"

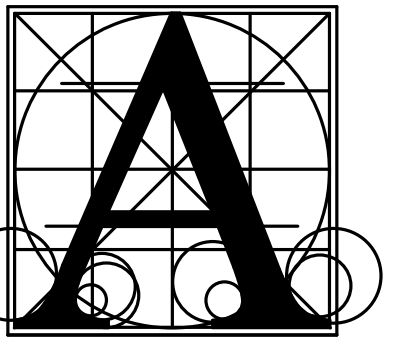

Architecture  
Incorporated

415 South Main Avenue  
P.O. Box 2140  
Sioux Falls, South Dakota 57101  
Phone: (605) 339-1711

815 St Joseph Street, Suite 203  
Rapid City, South Dakota 57701  
Phone: (605) 721-1158





Project  
**LENNOX HIGH SCHOOL ADDITION**  
sheet contents  
CEILING DETAILS

number 0215.2902.22  
date DECEMBER 21, 2023  
revision  
drawn BJO checked SRJ


DATE	DESCRIPTION
1/18/2024	ADDENDUM #2

6.20

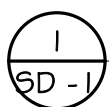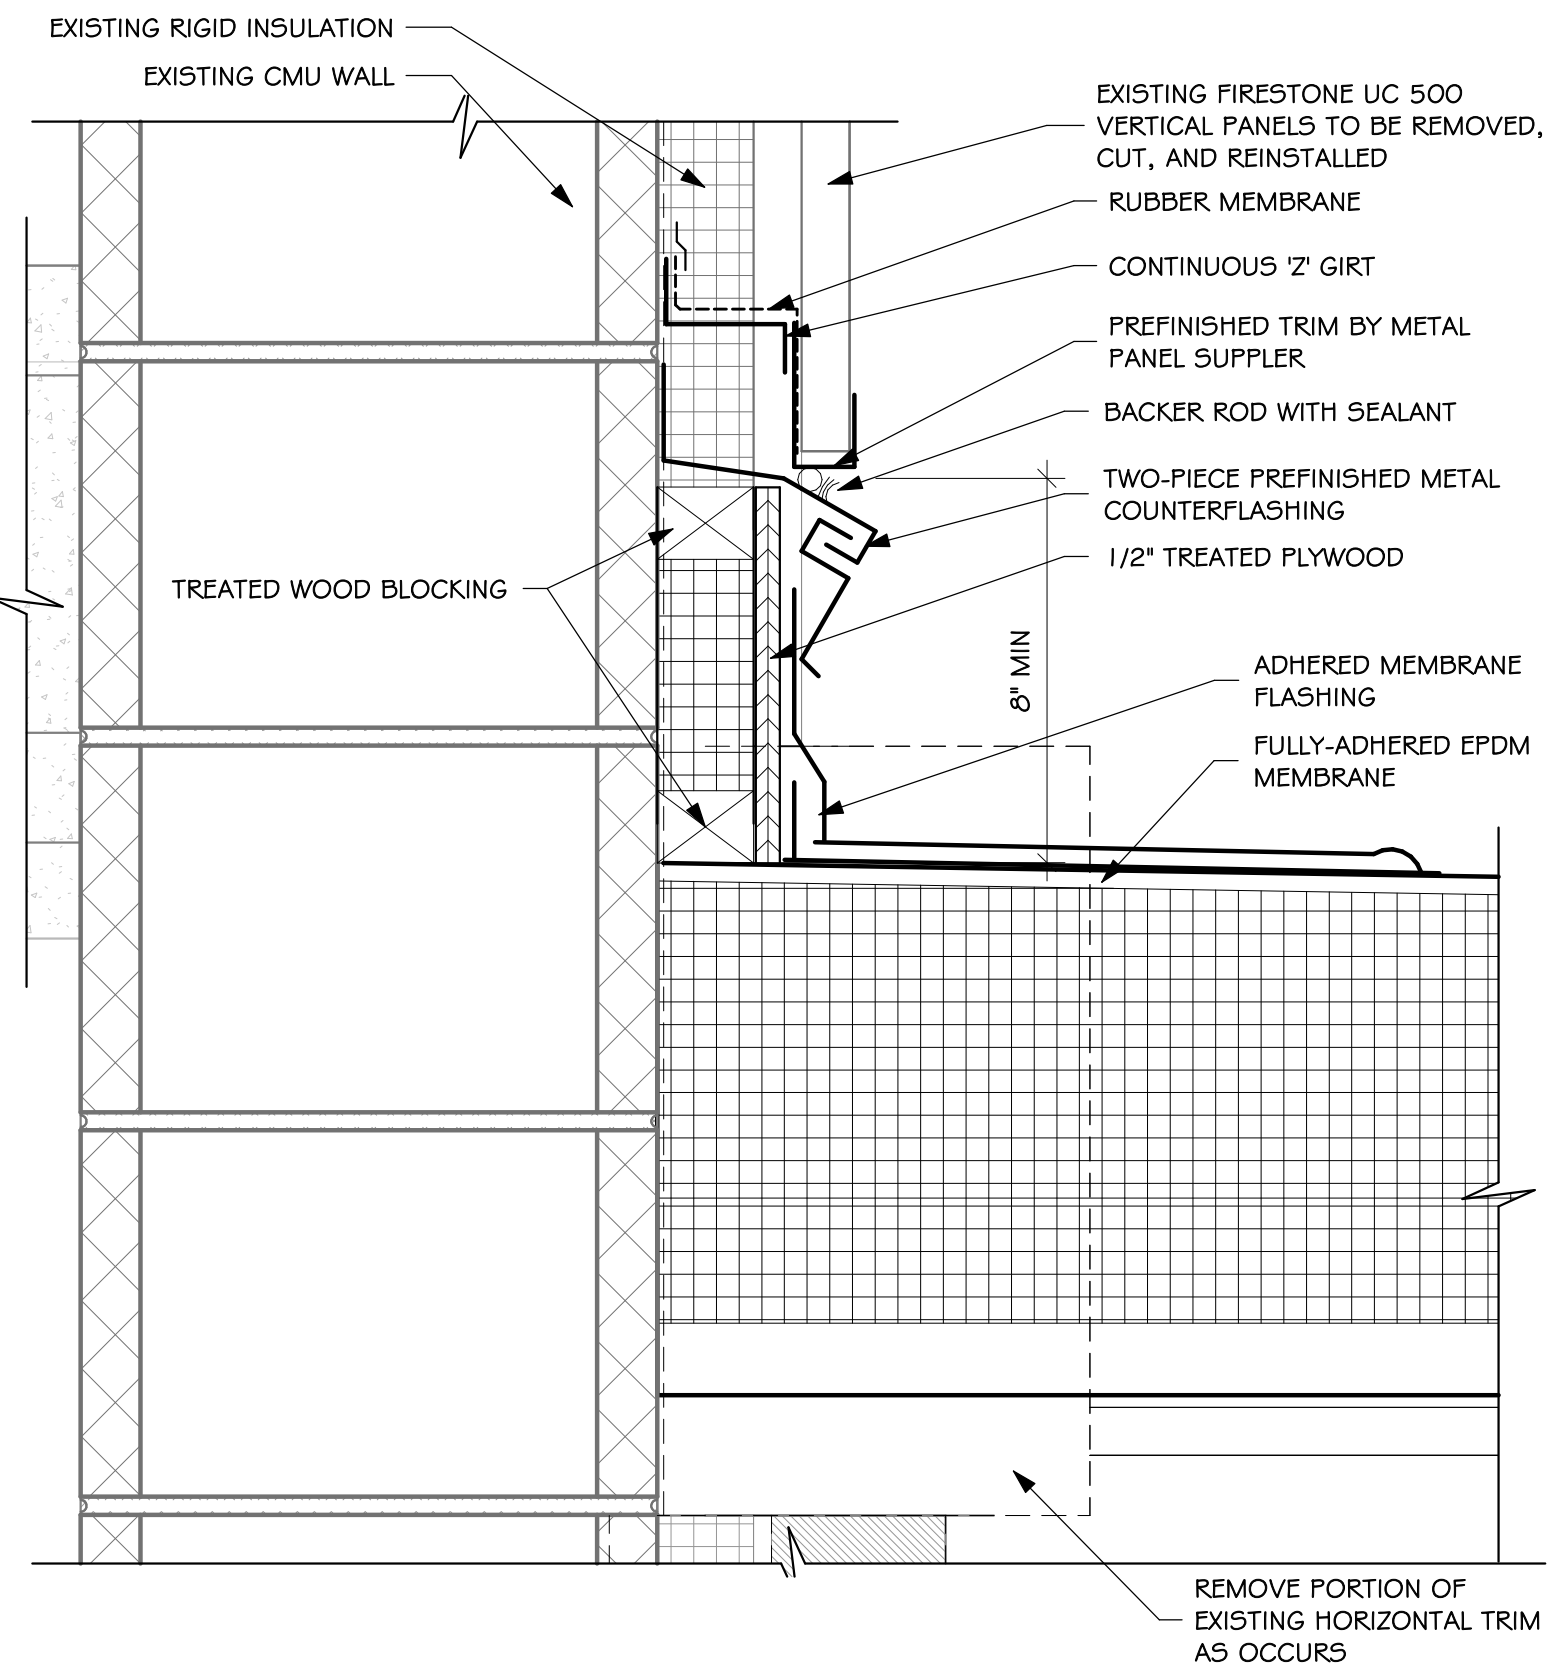

# EXISTING METAL PANEL TIE-IN DETAIL

SCALE: 3" = 1'-0"

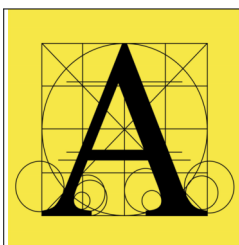

project LENNOX HIGH SCHOOL ADDITION

number 0215.2982.22

drawn MS

checked SRJ

date 01/18/2024



revision ADDENDUM #2

**Architecture Incorporated**

sioux falls and rapid city, south dakota


DRAWING

SD - 1

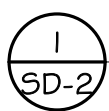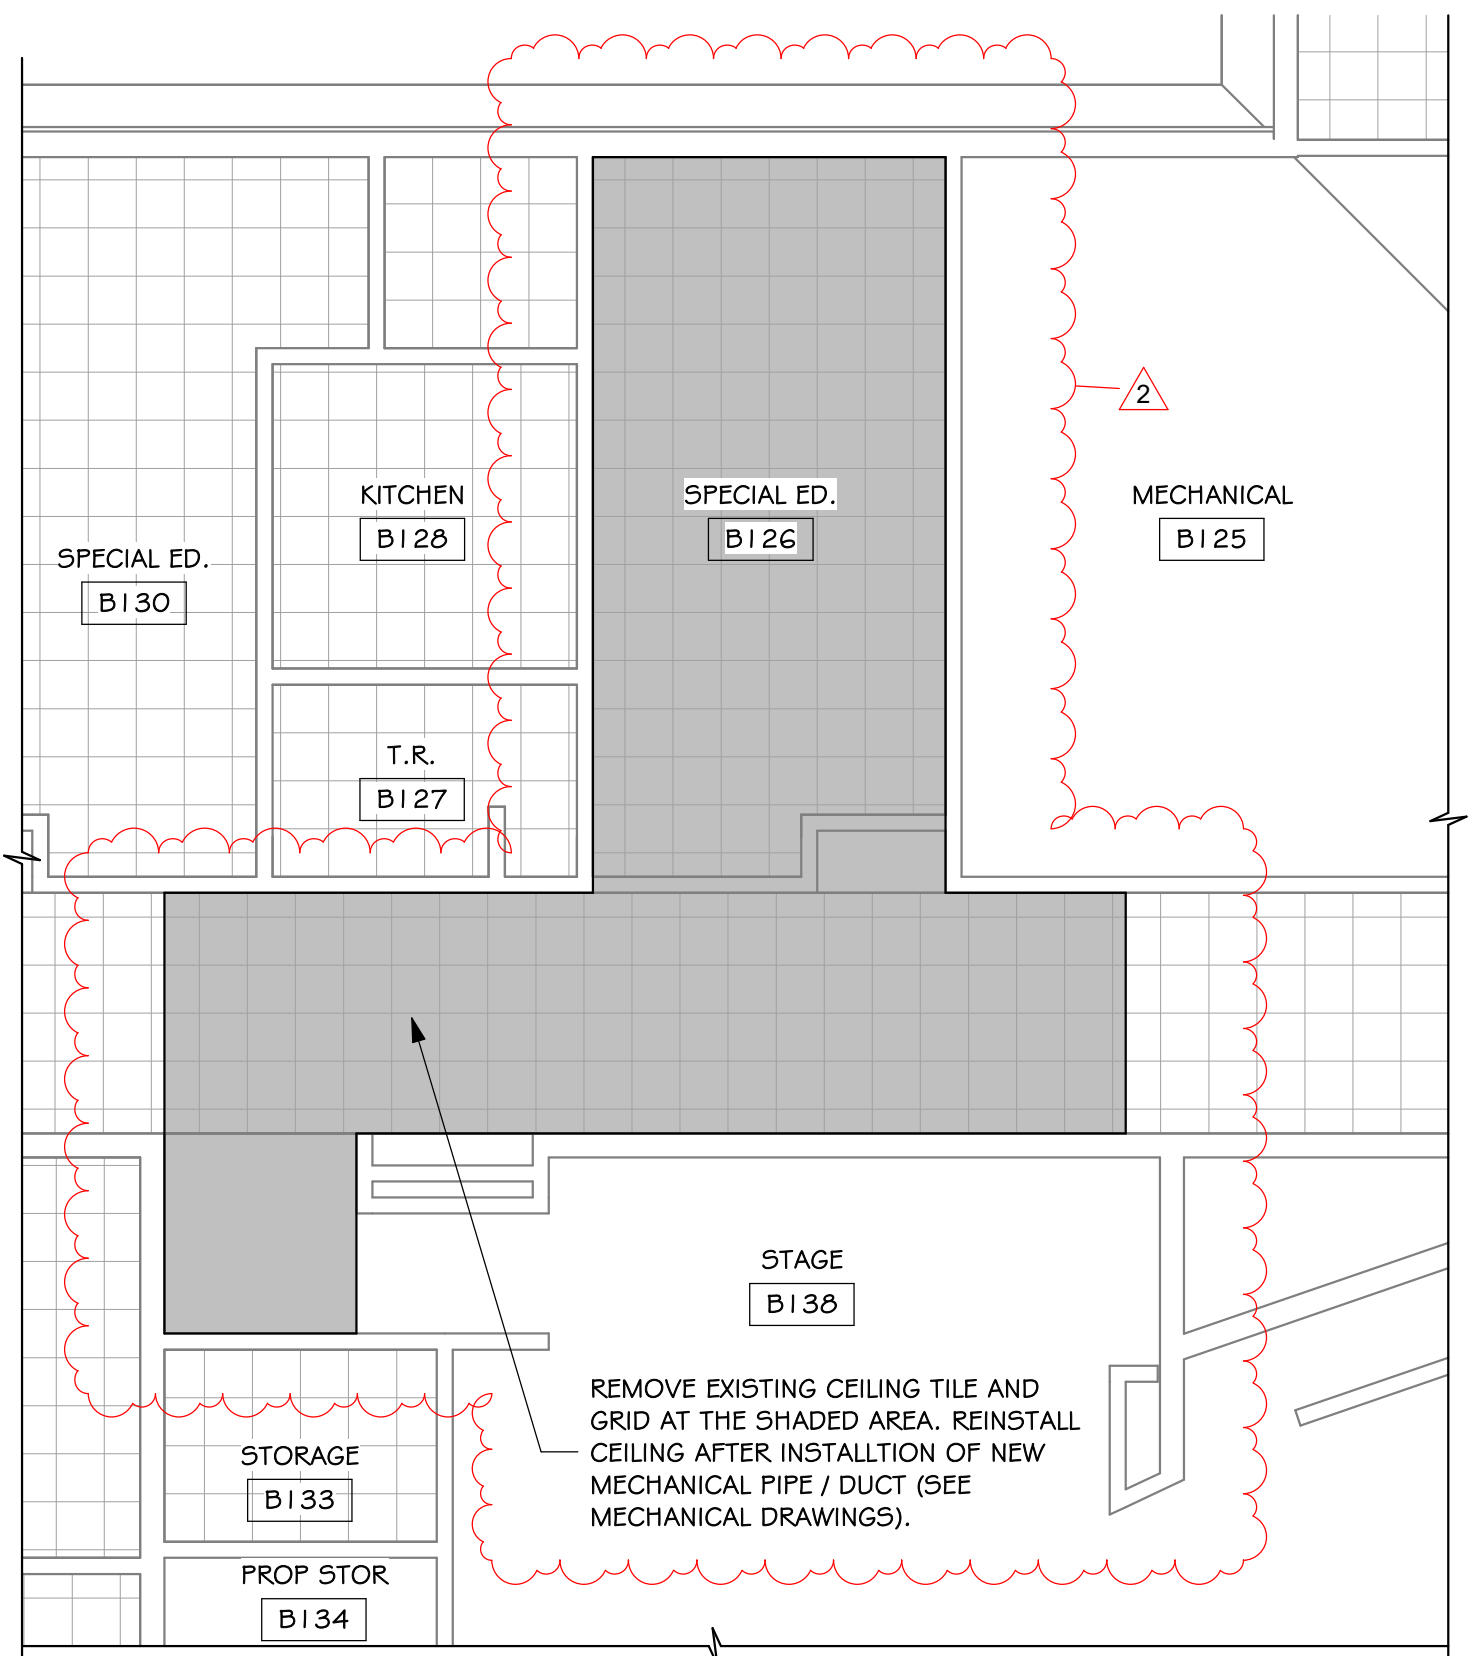

# REFLECTED CEILING PLAN - AREA B

SCALE: 1/8" = 1'-0"

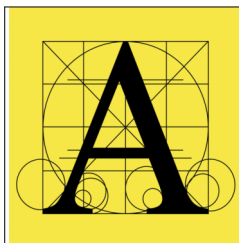

project LENNOX HIGH SCHOOL ADDITION

number 0215.2982.22

drawn MS

checked SRJ

date 01/18/2024




















revision ADDENDUM #2

**Architecture Incorporated**

sioux falls and rapid city, south dakota

DRAWING


SD-2

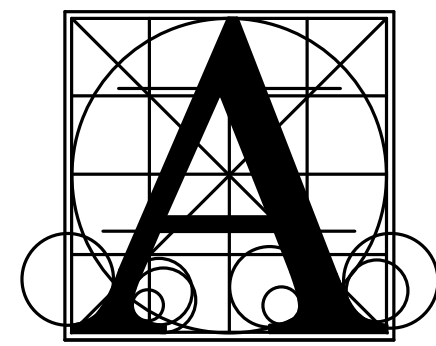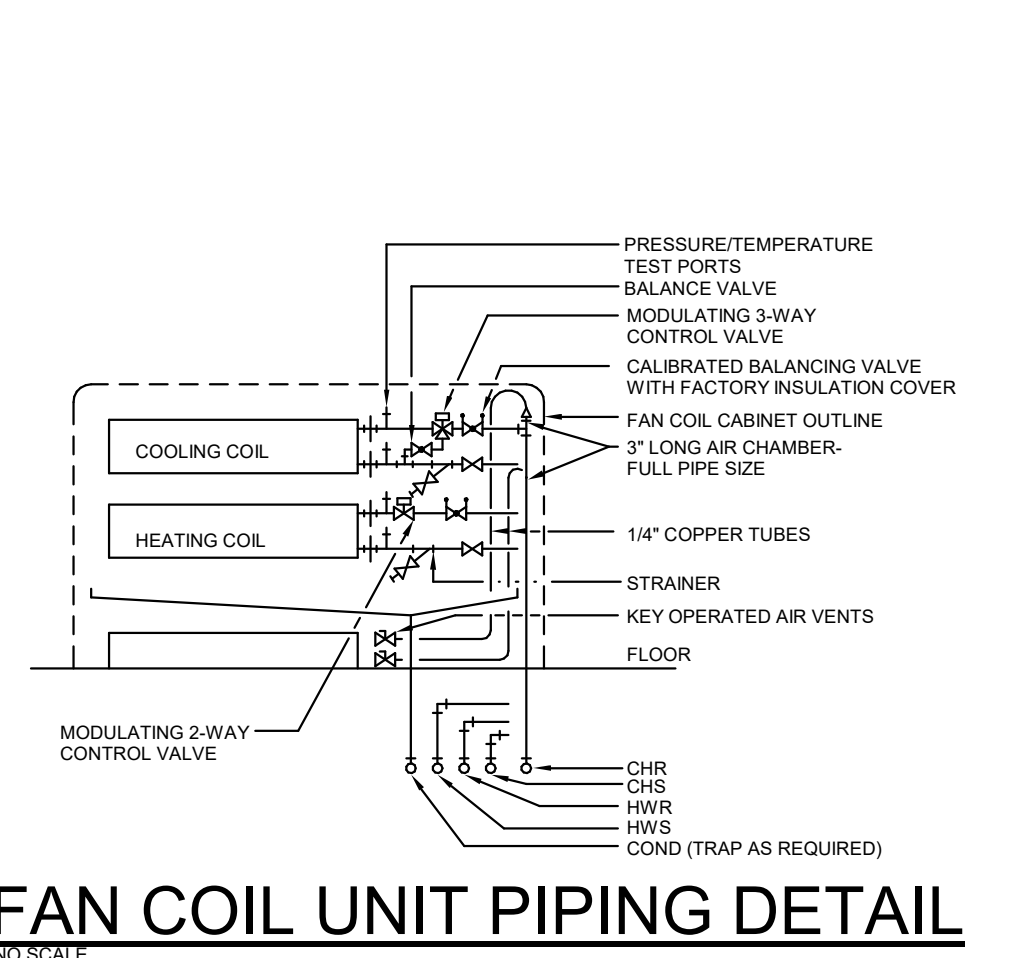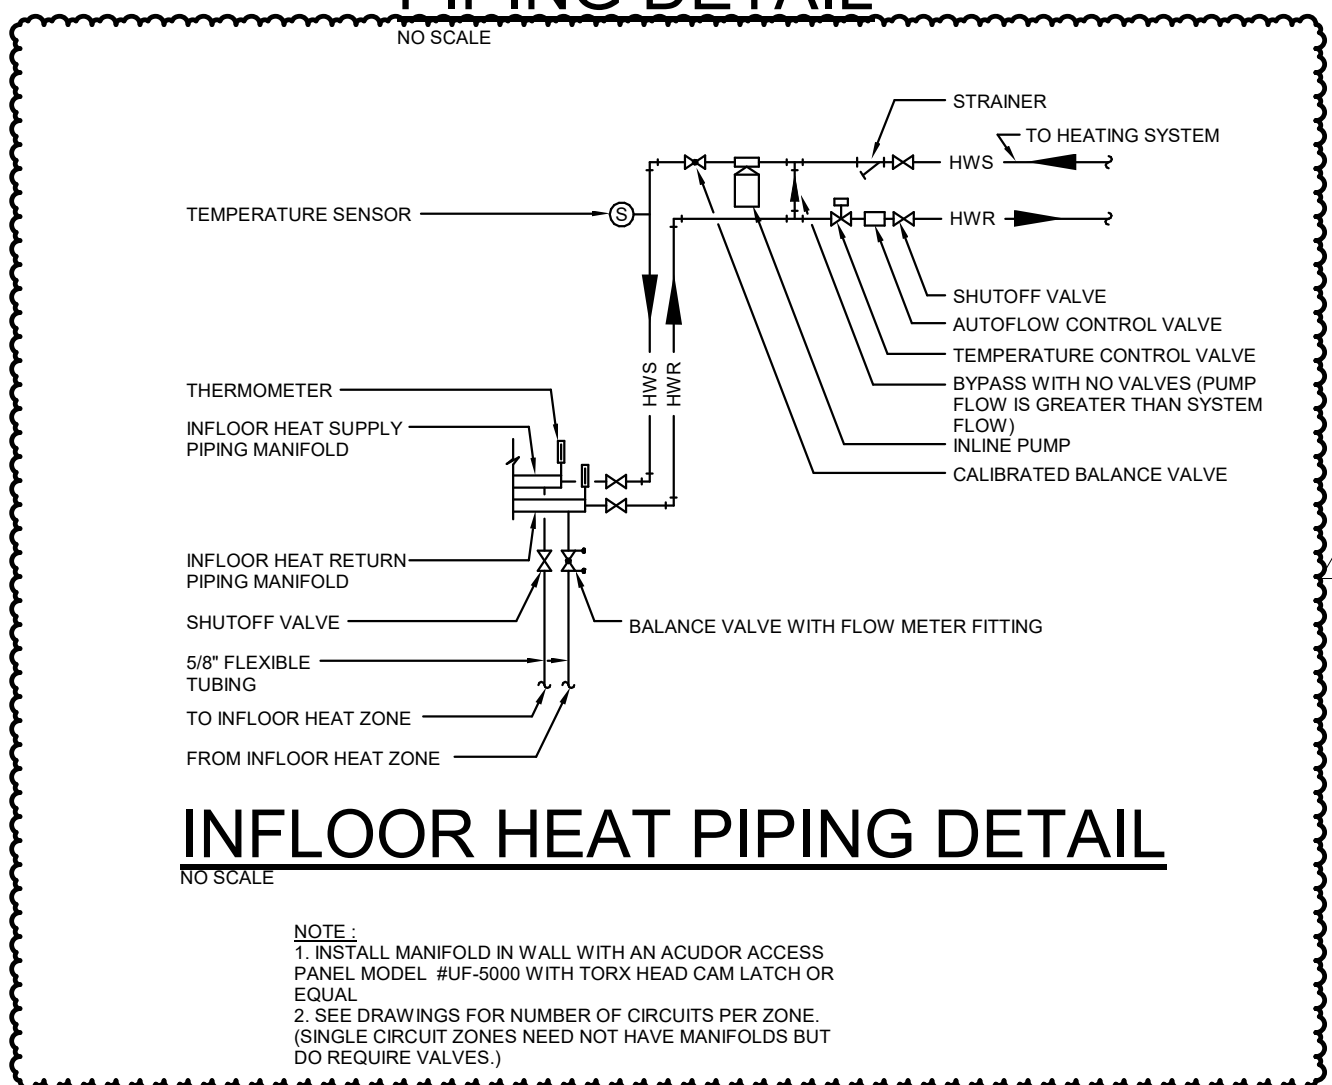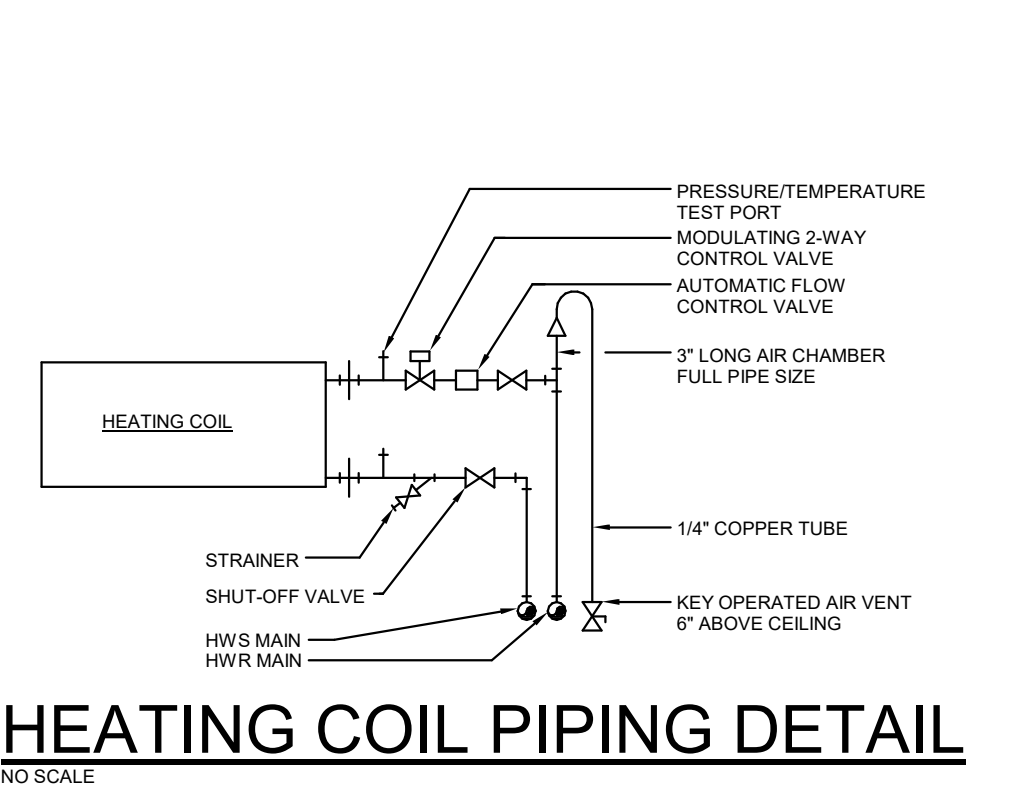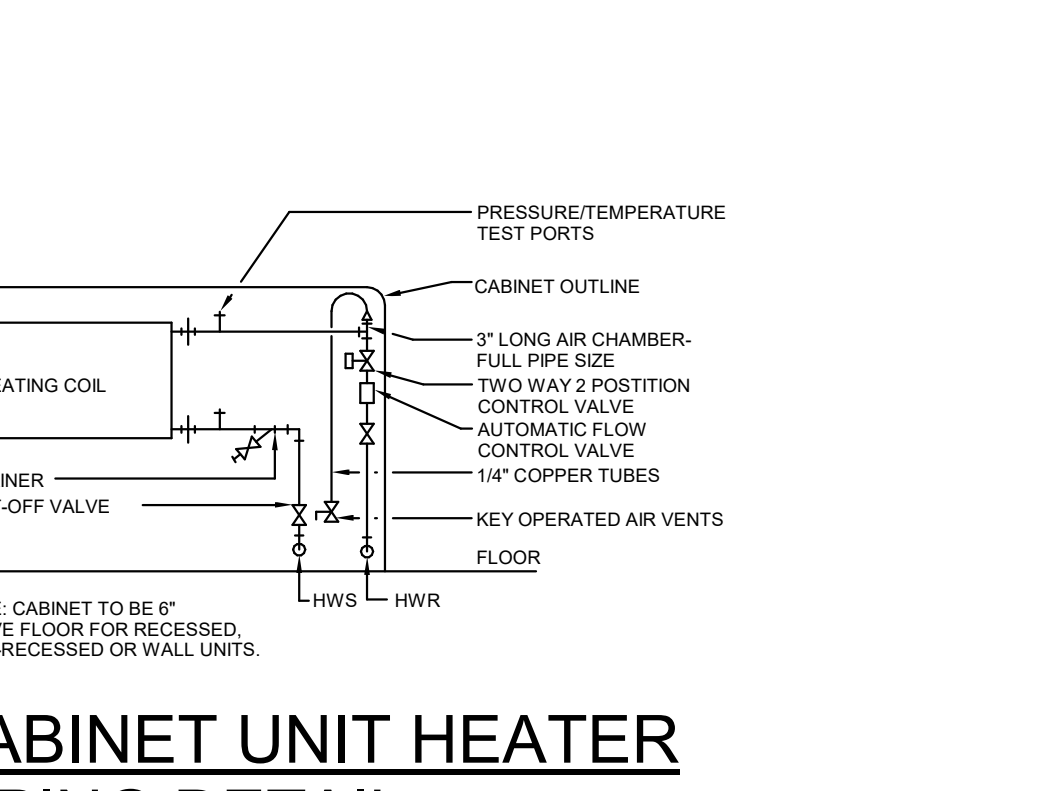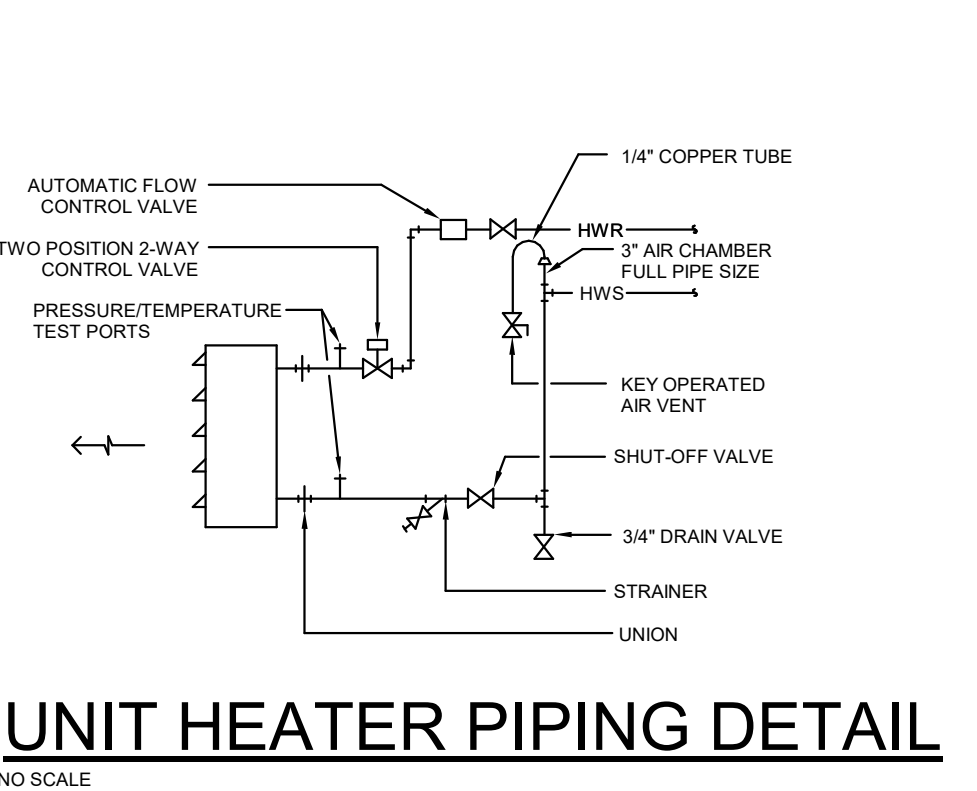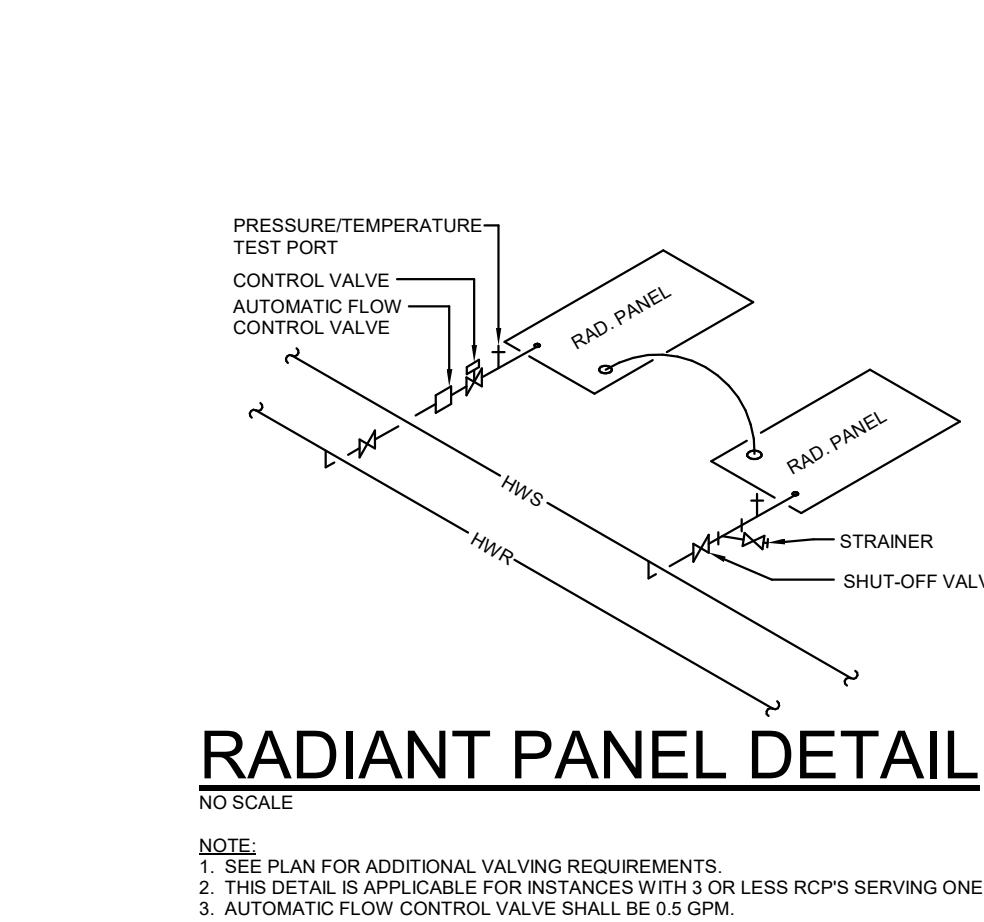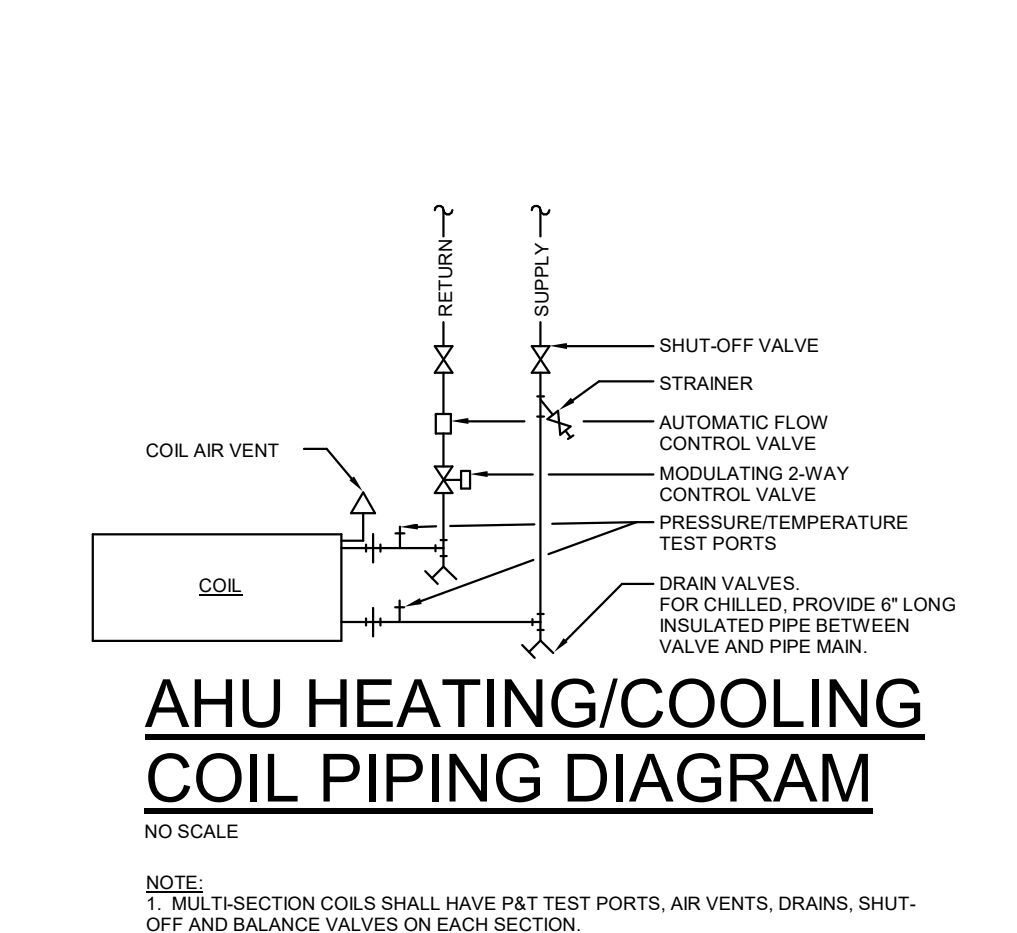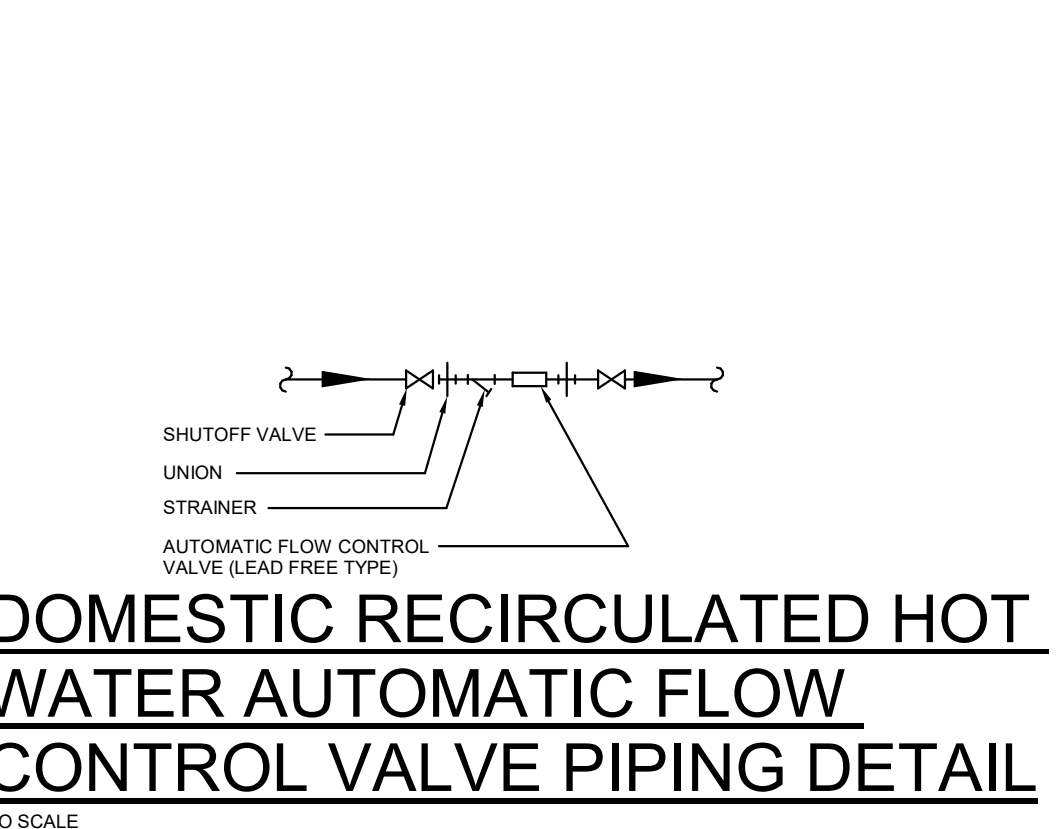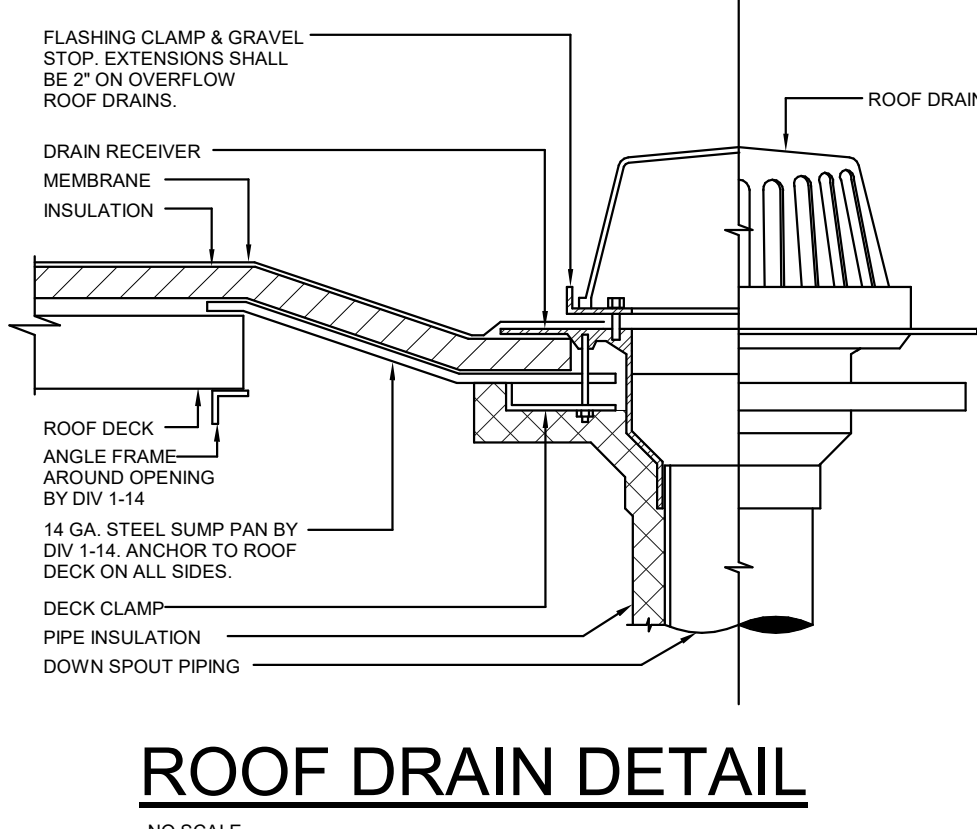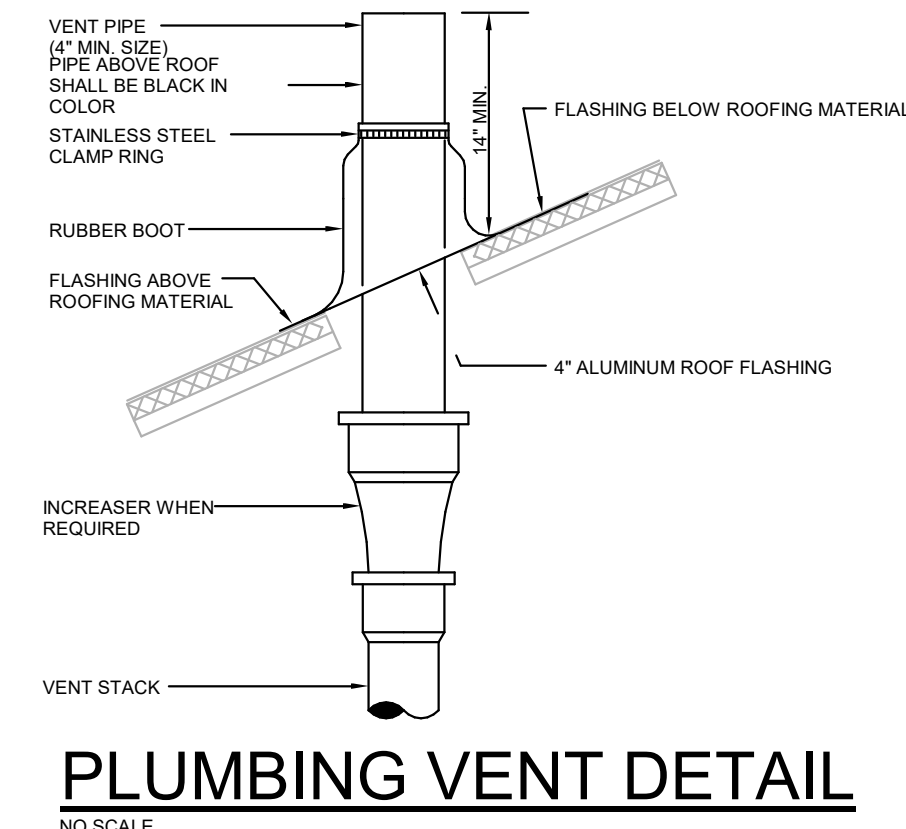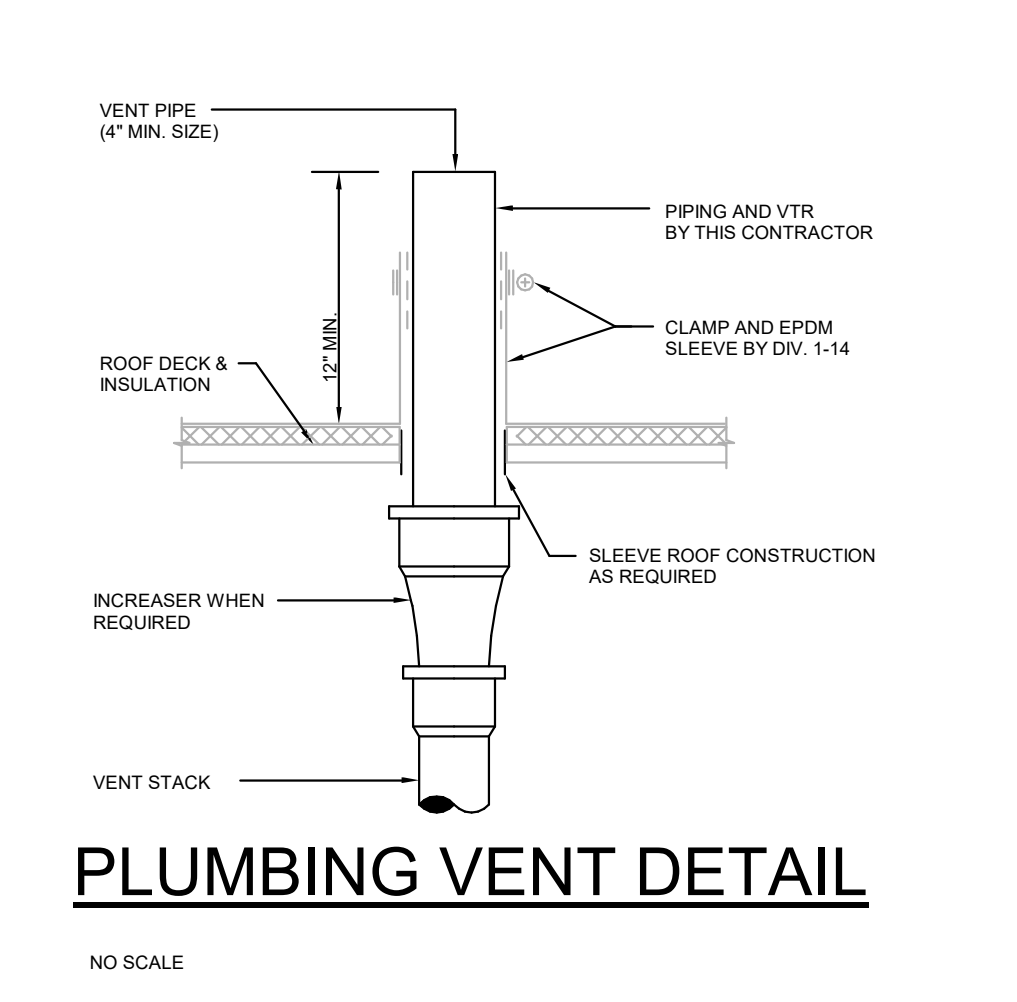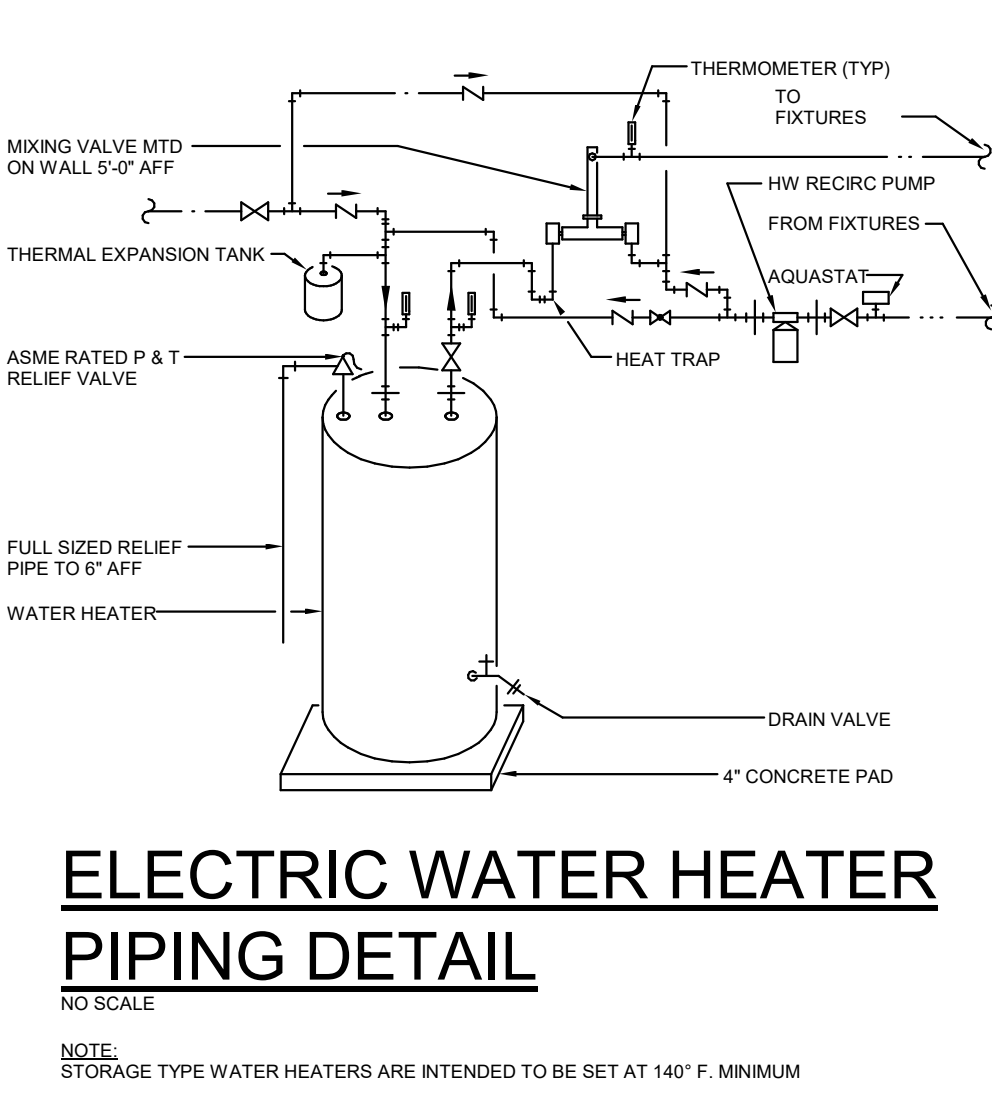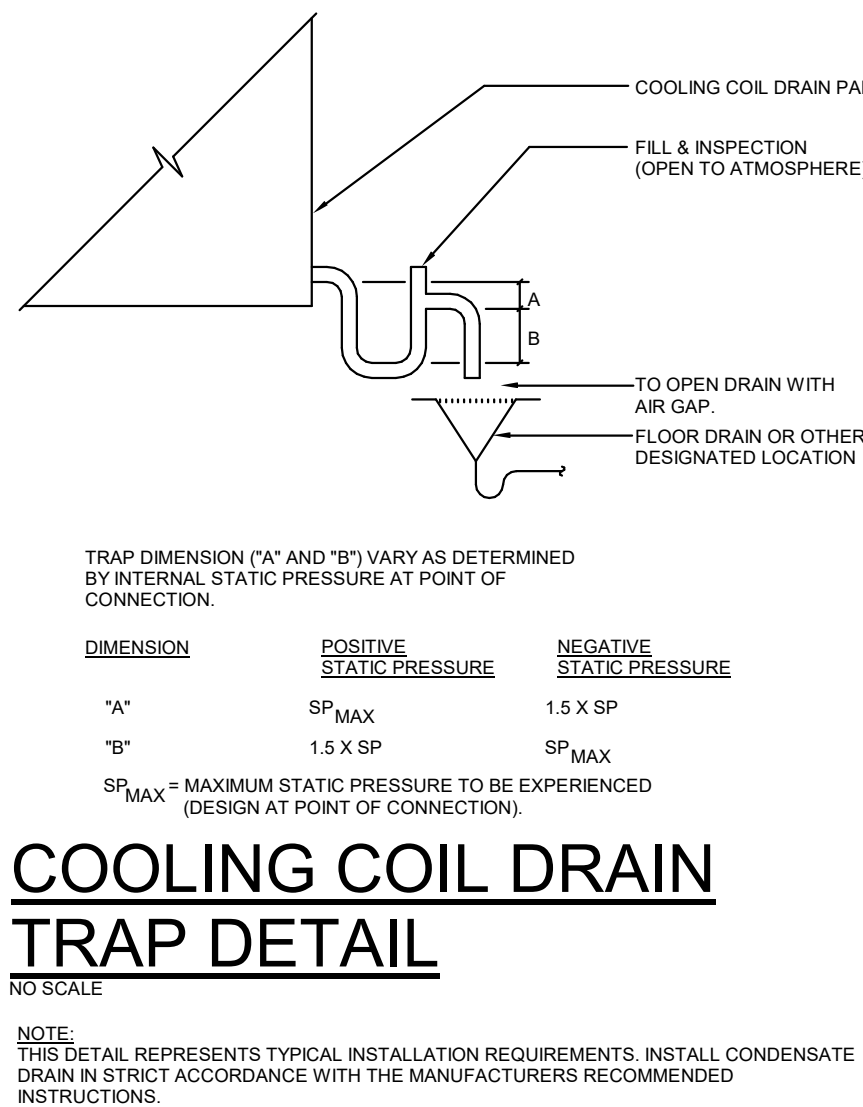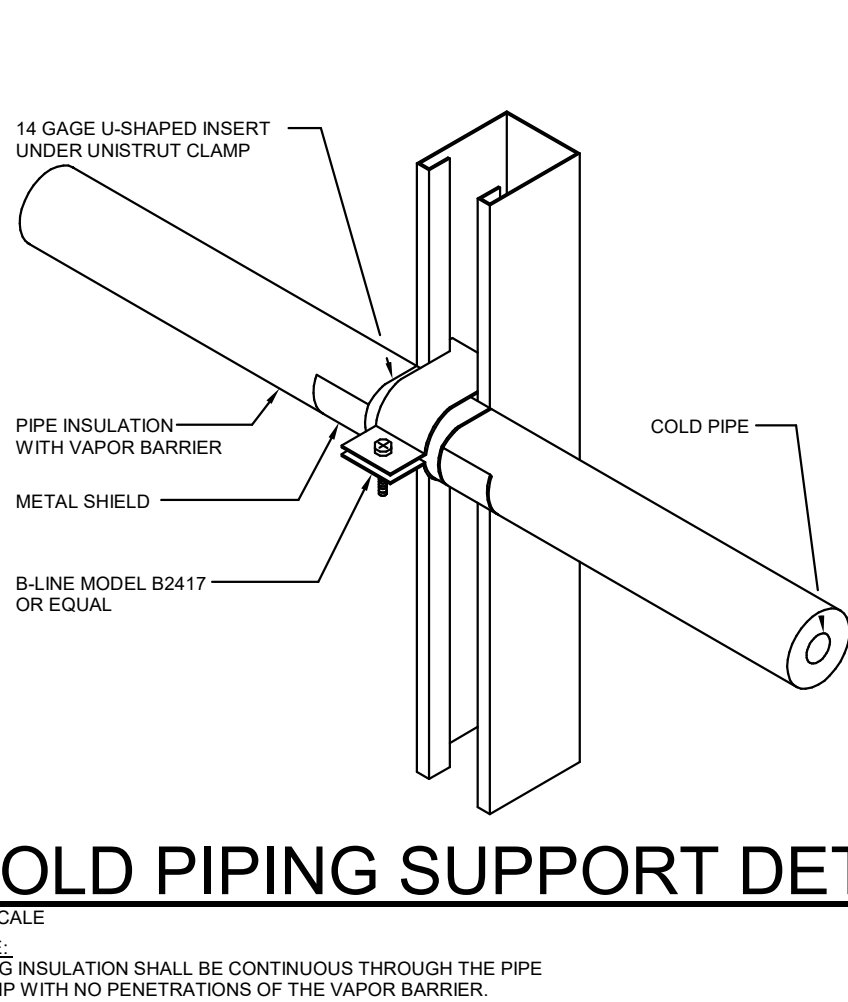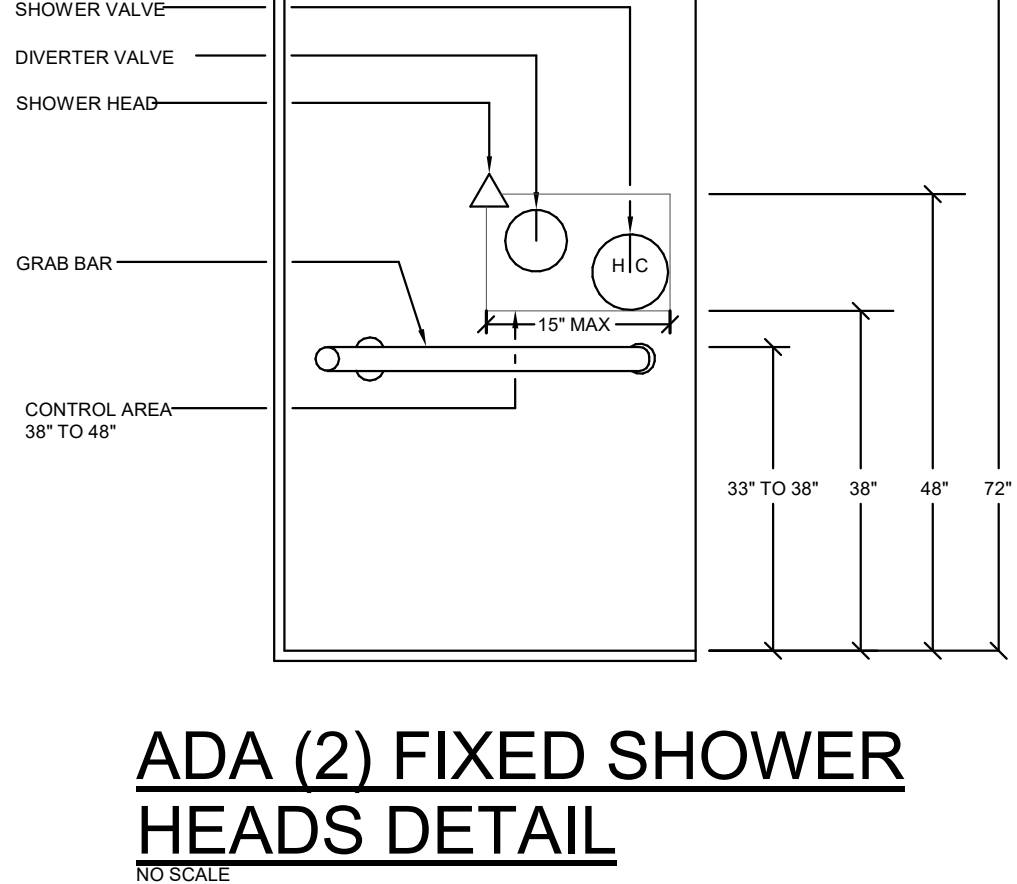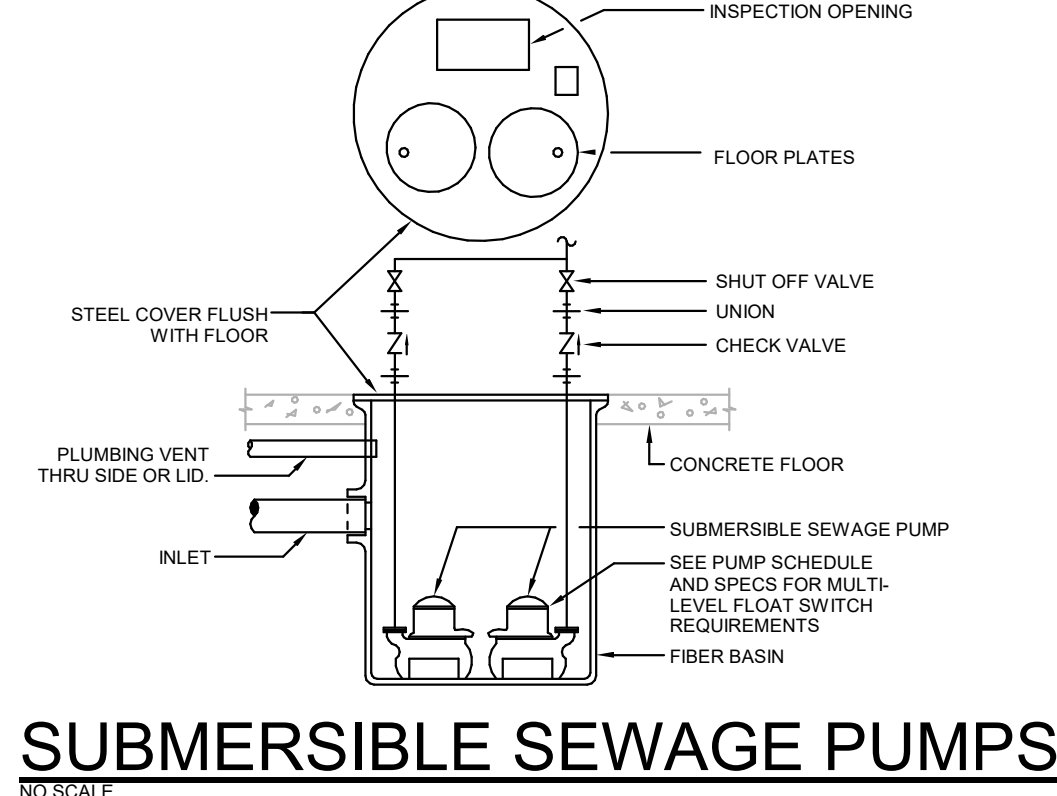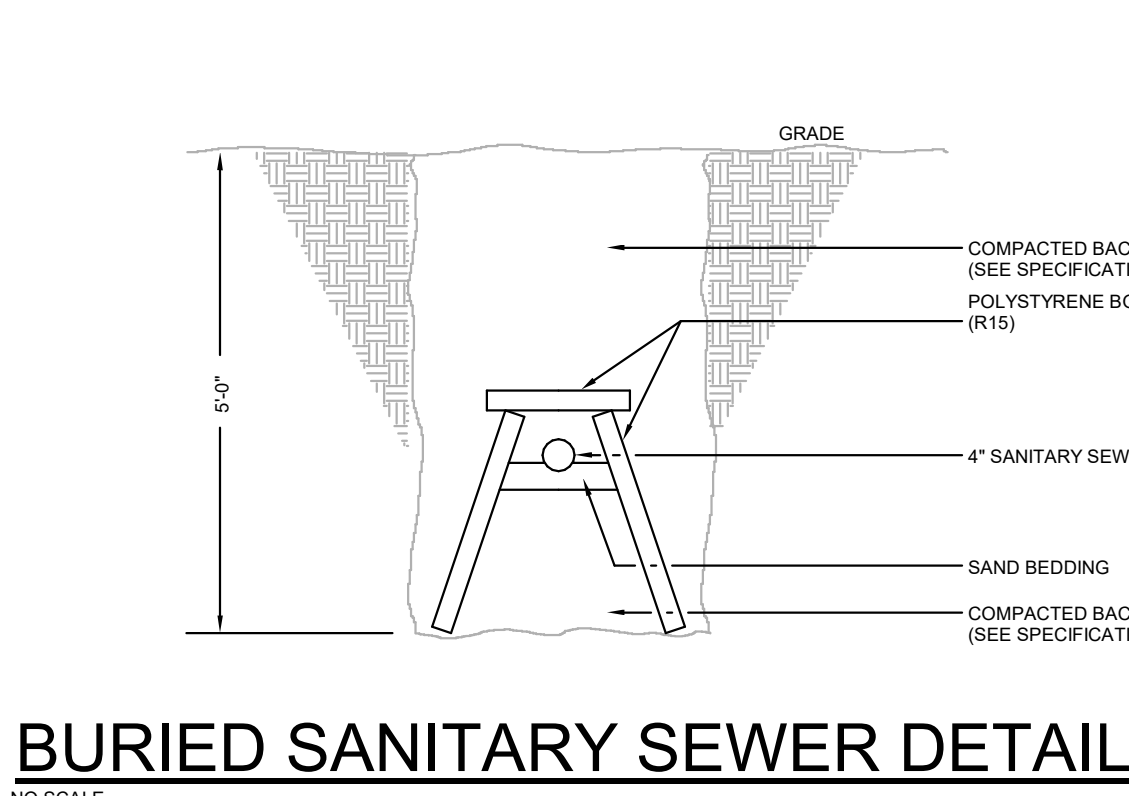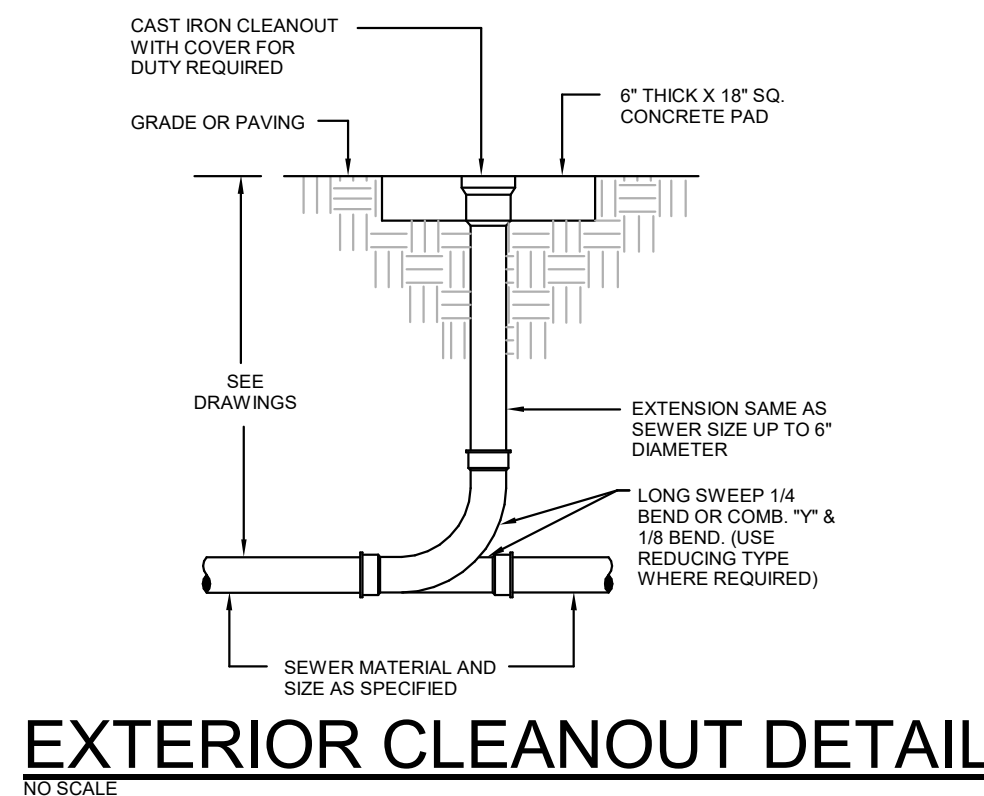

**Architecture Incorporated**

415 South Main Avenue  
P.O. Box 2140  
Sioux Falls, South Dakota 57101  
Phone: (605) 339-1711

815 St Joseph Street, Suite 203  
Rapid City, South Dakota 57701  
Phone: (605) 721-1158

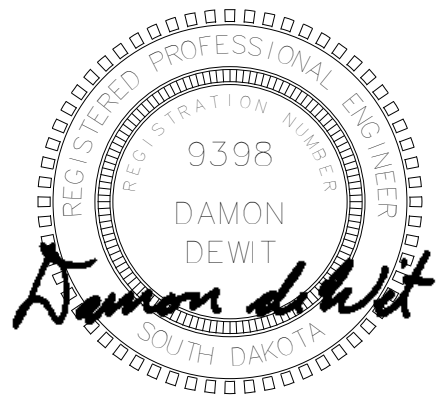

**Associated Consulting Engineering, Incorporated**

340 S. Phillips Ave.  
Sioux Falls, SD 57104  
(605) 335-3720  
Fax 335-6220  
E-mail acei@aceinet.com  
ACEI PROJ. #123034

**LENNOX HIGH SCHOOL ADDITION**



Sheet Contents

**DETAILS**

number	0215.2902.22
date	DECEMBER 21, 2023
revision	
drawn	DWM
checked	Dd
DATE	DESCRIPTION
01-18-2024	Addendum #2



1/18/2024 11:33:32 AM

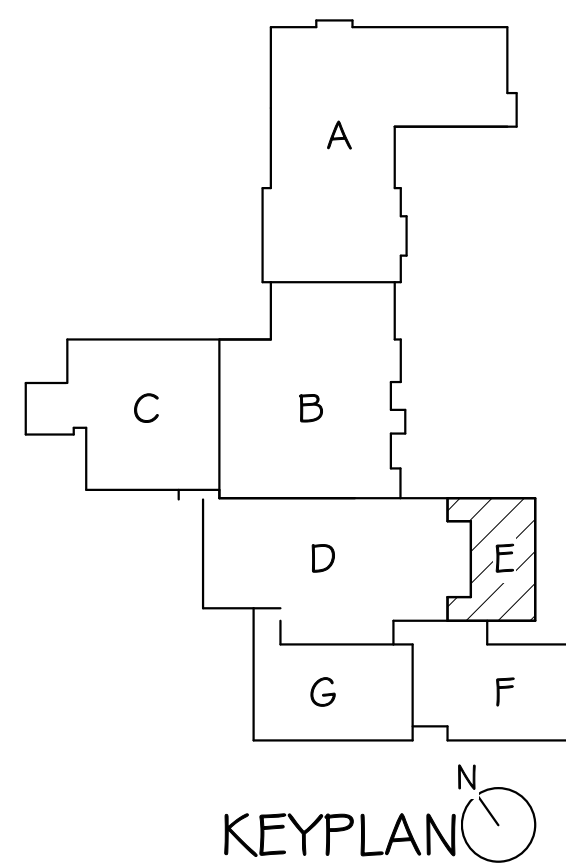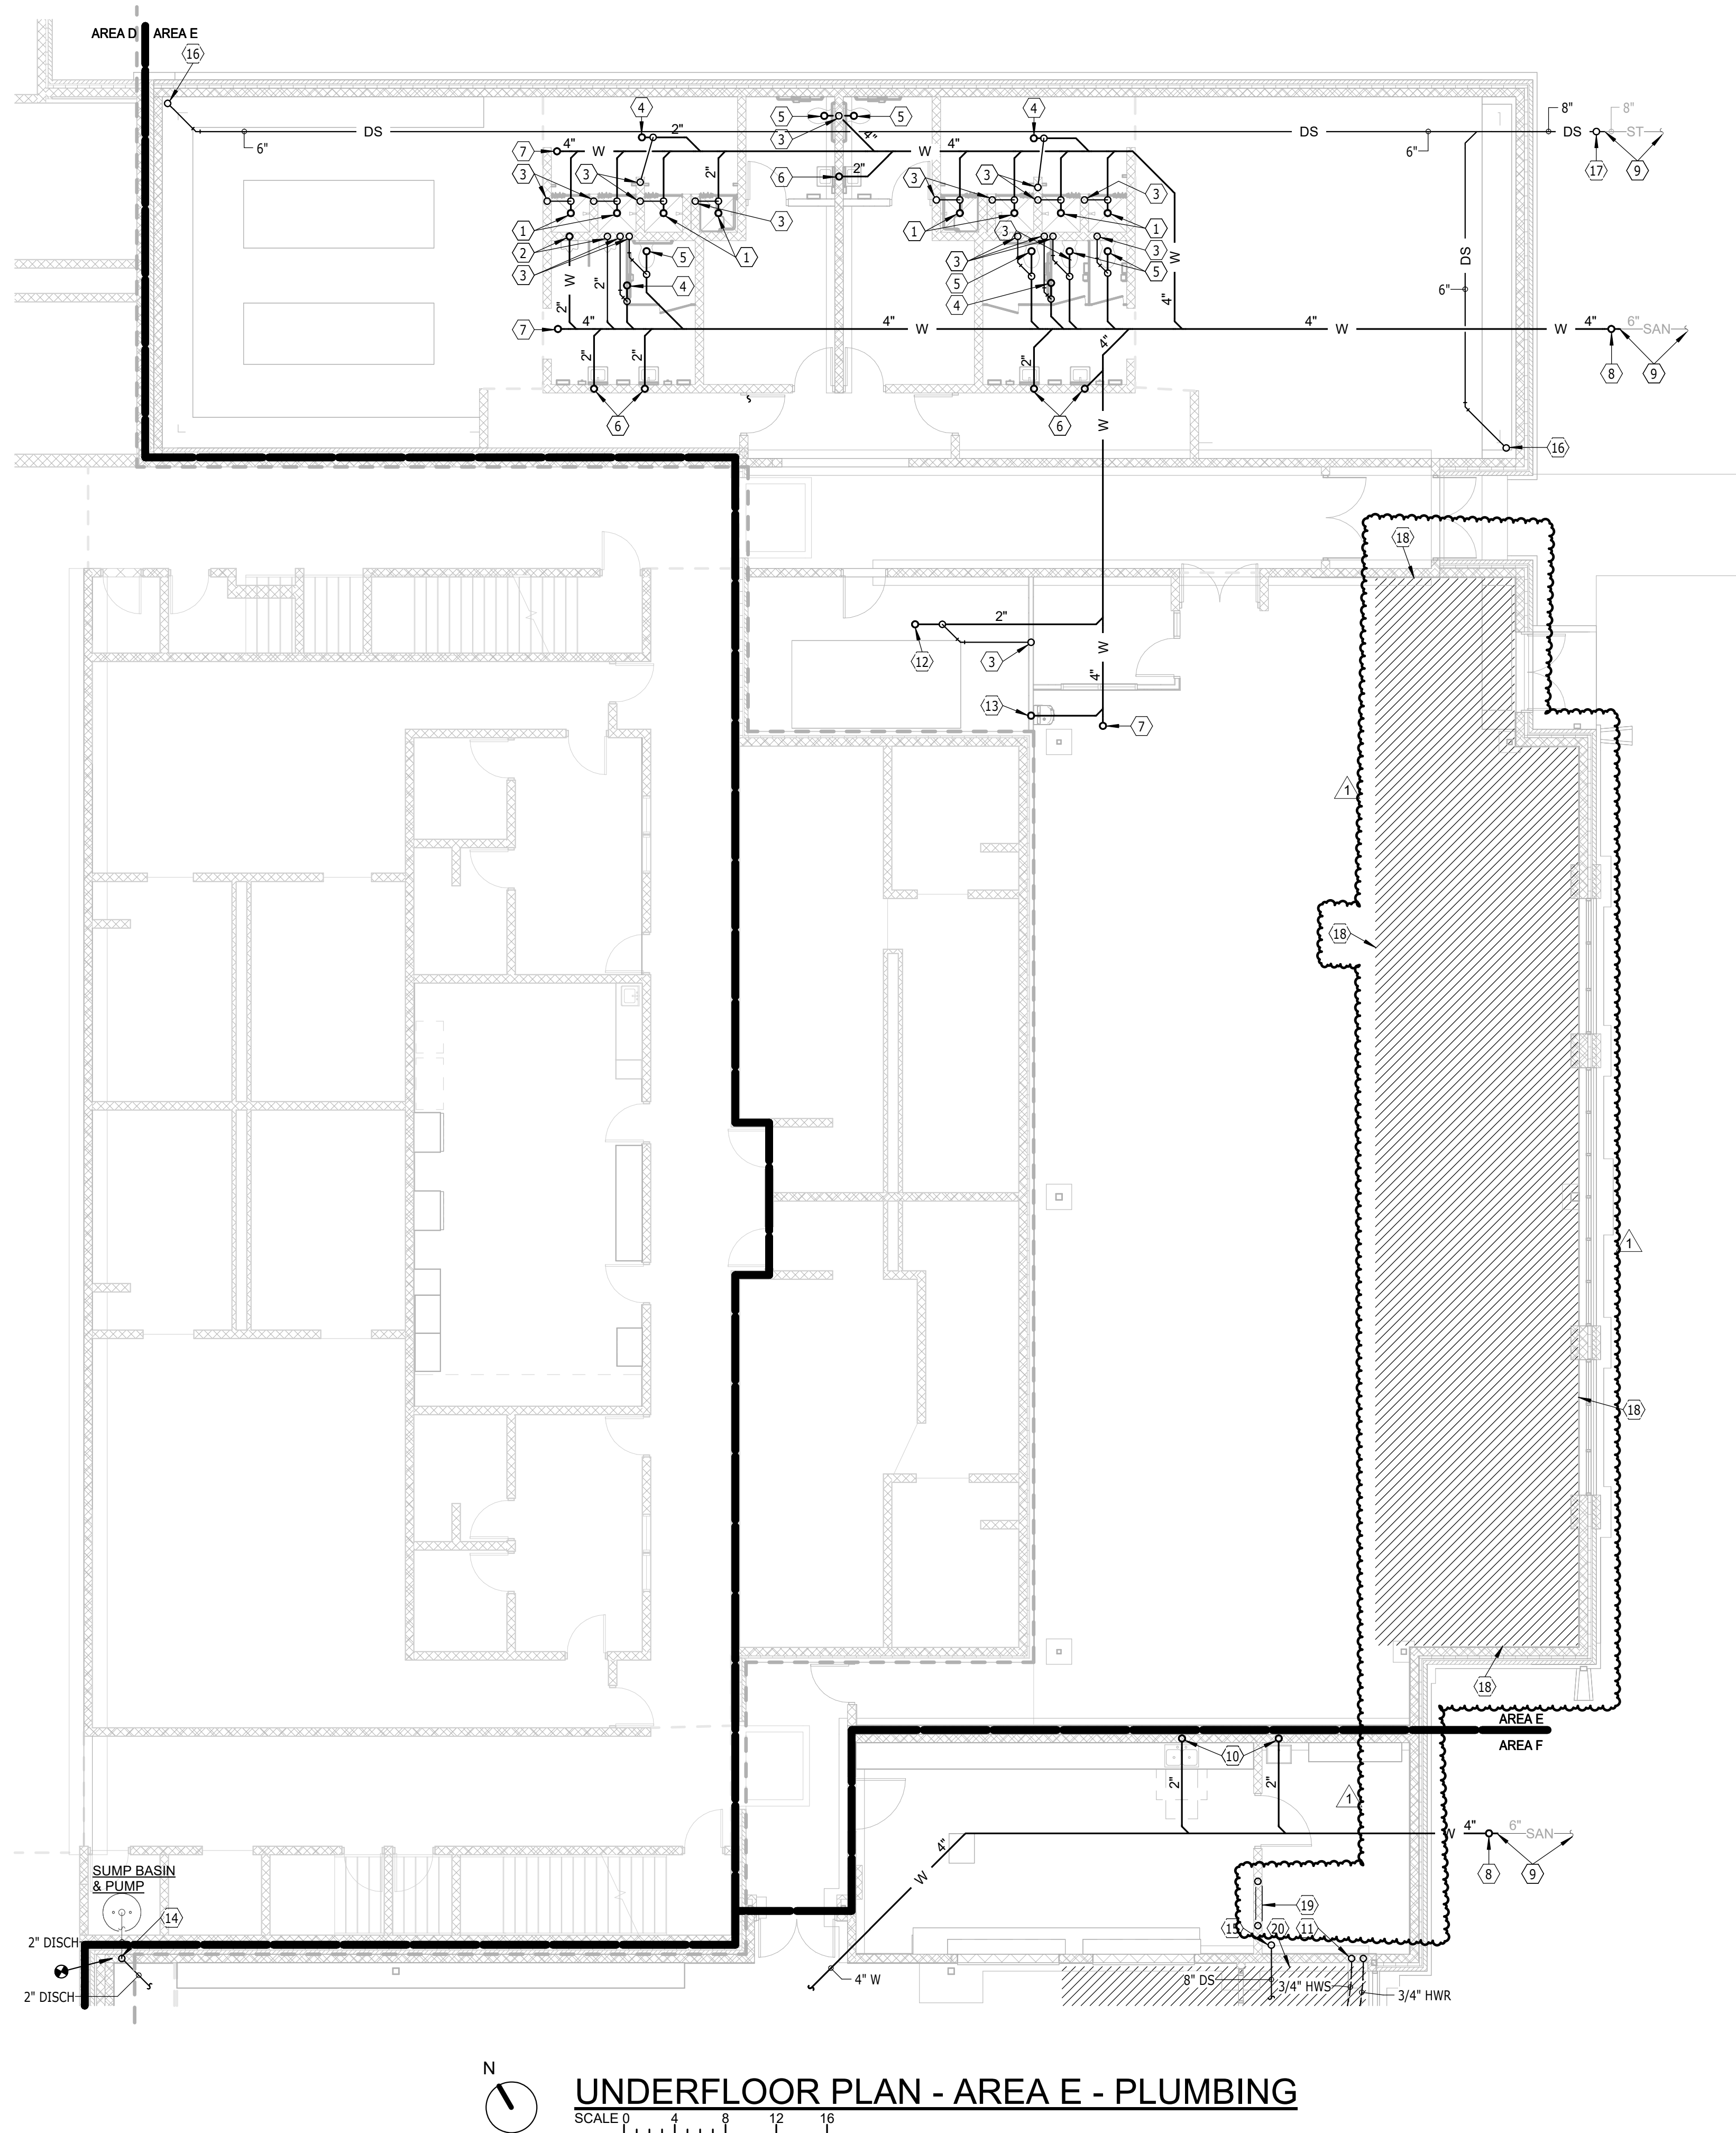

GENERAL SHEET NOTES	
A.	THE CEILING SPACE AVAILABLE REQUIRES COORDINATION WITH OTHER TRADES. THE CONTRACTORS SHALL PROVIDE ALL OFFSETS AND RELOCATE AS REQUIRED TO COORDINATE THE INSTALLATION OF ALL MATERIALS AND EQUIPMENT WITH OTHER TRADES.
B.	ON DEMO DRAWINGS, ITEMS SHOWN LIGHT ARE EXISTING TO REMAIN, ITEMS SHOWN BOLD ARE EXISTING TO BE REMOVED.
C.	ON NEW CONSTRUCTION DRAWINGS, ITEMS SHOWN LIGHT ARE EXISTING TO REMAIN, ITEMS SHOWN BOLD ARE NEW WORK.

PLUMBING & HEATING NOTES	
1	2" W UP TO SH
2	2" W UP TO UR
3	2" V UP
4	2" W UP TO FD
5	4" W UP TO WC
6	2" W UP TO LAV
7	4" W UP TO CO
8	4" W UP TO GRADE CO
9	CONNECT TO PIPING PROVIDED BY SITE UTILITY CONTRACTOR. SEE SITE UTILITY DRAWINGS FOR CONTINUATION
10	2" W UP TO SK
11	3/4" HWR UP, 3/4" HWS UP
12	2" W UP TO FSK
13	2" W UP TO EWC
14	CONNECT TO EXISTING SLUMP PUMP DISCHARGE PIPING. VERIFY SIZE & LOCATION PRIOR TO ASSOCIATED WORK
15	8" DS UP
16	8" DS UP

18	INFLOOR HEAT ZONE #1 : 1280 SQ FT, 39 MBH, 4 GPM, 3 CIRCUITS, 5/8" TUBING, 12" SPACING, 3' WPD
19	INFLOOR HEAT ZONES #1 & #2 PIPING MANIFOLD. SEE INFLOOR HEAT MANIFOLD, PIPING DETAIL
20	INFLOOR HEAT ZONE #2 : 990 SQ FT, 30 MBH, 3 GPM, 2 CIRCUITS, 5/8" TUBING, 12" SPACING, 3' WPD

Architecture  
Incorporated

415 South Main Avenue  
P.O. Box 2140  
Sioux Falls, South Dakota 57101  
Phone: (605) 339-1711

815 St Joseph Street, Suite 203  
Rapid City, South Dakota 57701  
Phone: (605) 721-1158

Associated  
Consulting  
Engineering,  
Incorporated

340 S. Phillips Ave.  
Sioux Falls, SD 57104

(605) 335-3720  
Fax 335-6220  
E-mail acei@aceinet.com

ACEI PROJ. #123034

Project

number 0215.2902.22

date DECEMBER 21, 2023

revision

drawn DWM checked Dd

DATE	DESCRIPTION
01-18-2024	Addendum #2



LENNOX HIGH SCHOOL ADDITION

UNDERFLOOR PLAN - AREA E - PLUMBING

8.30-E



1/18/2024 11:35:14 AM

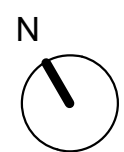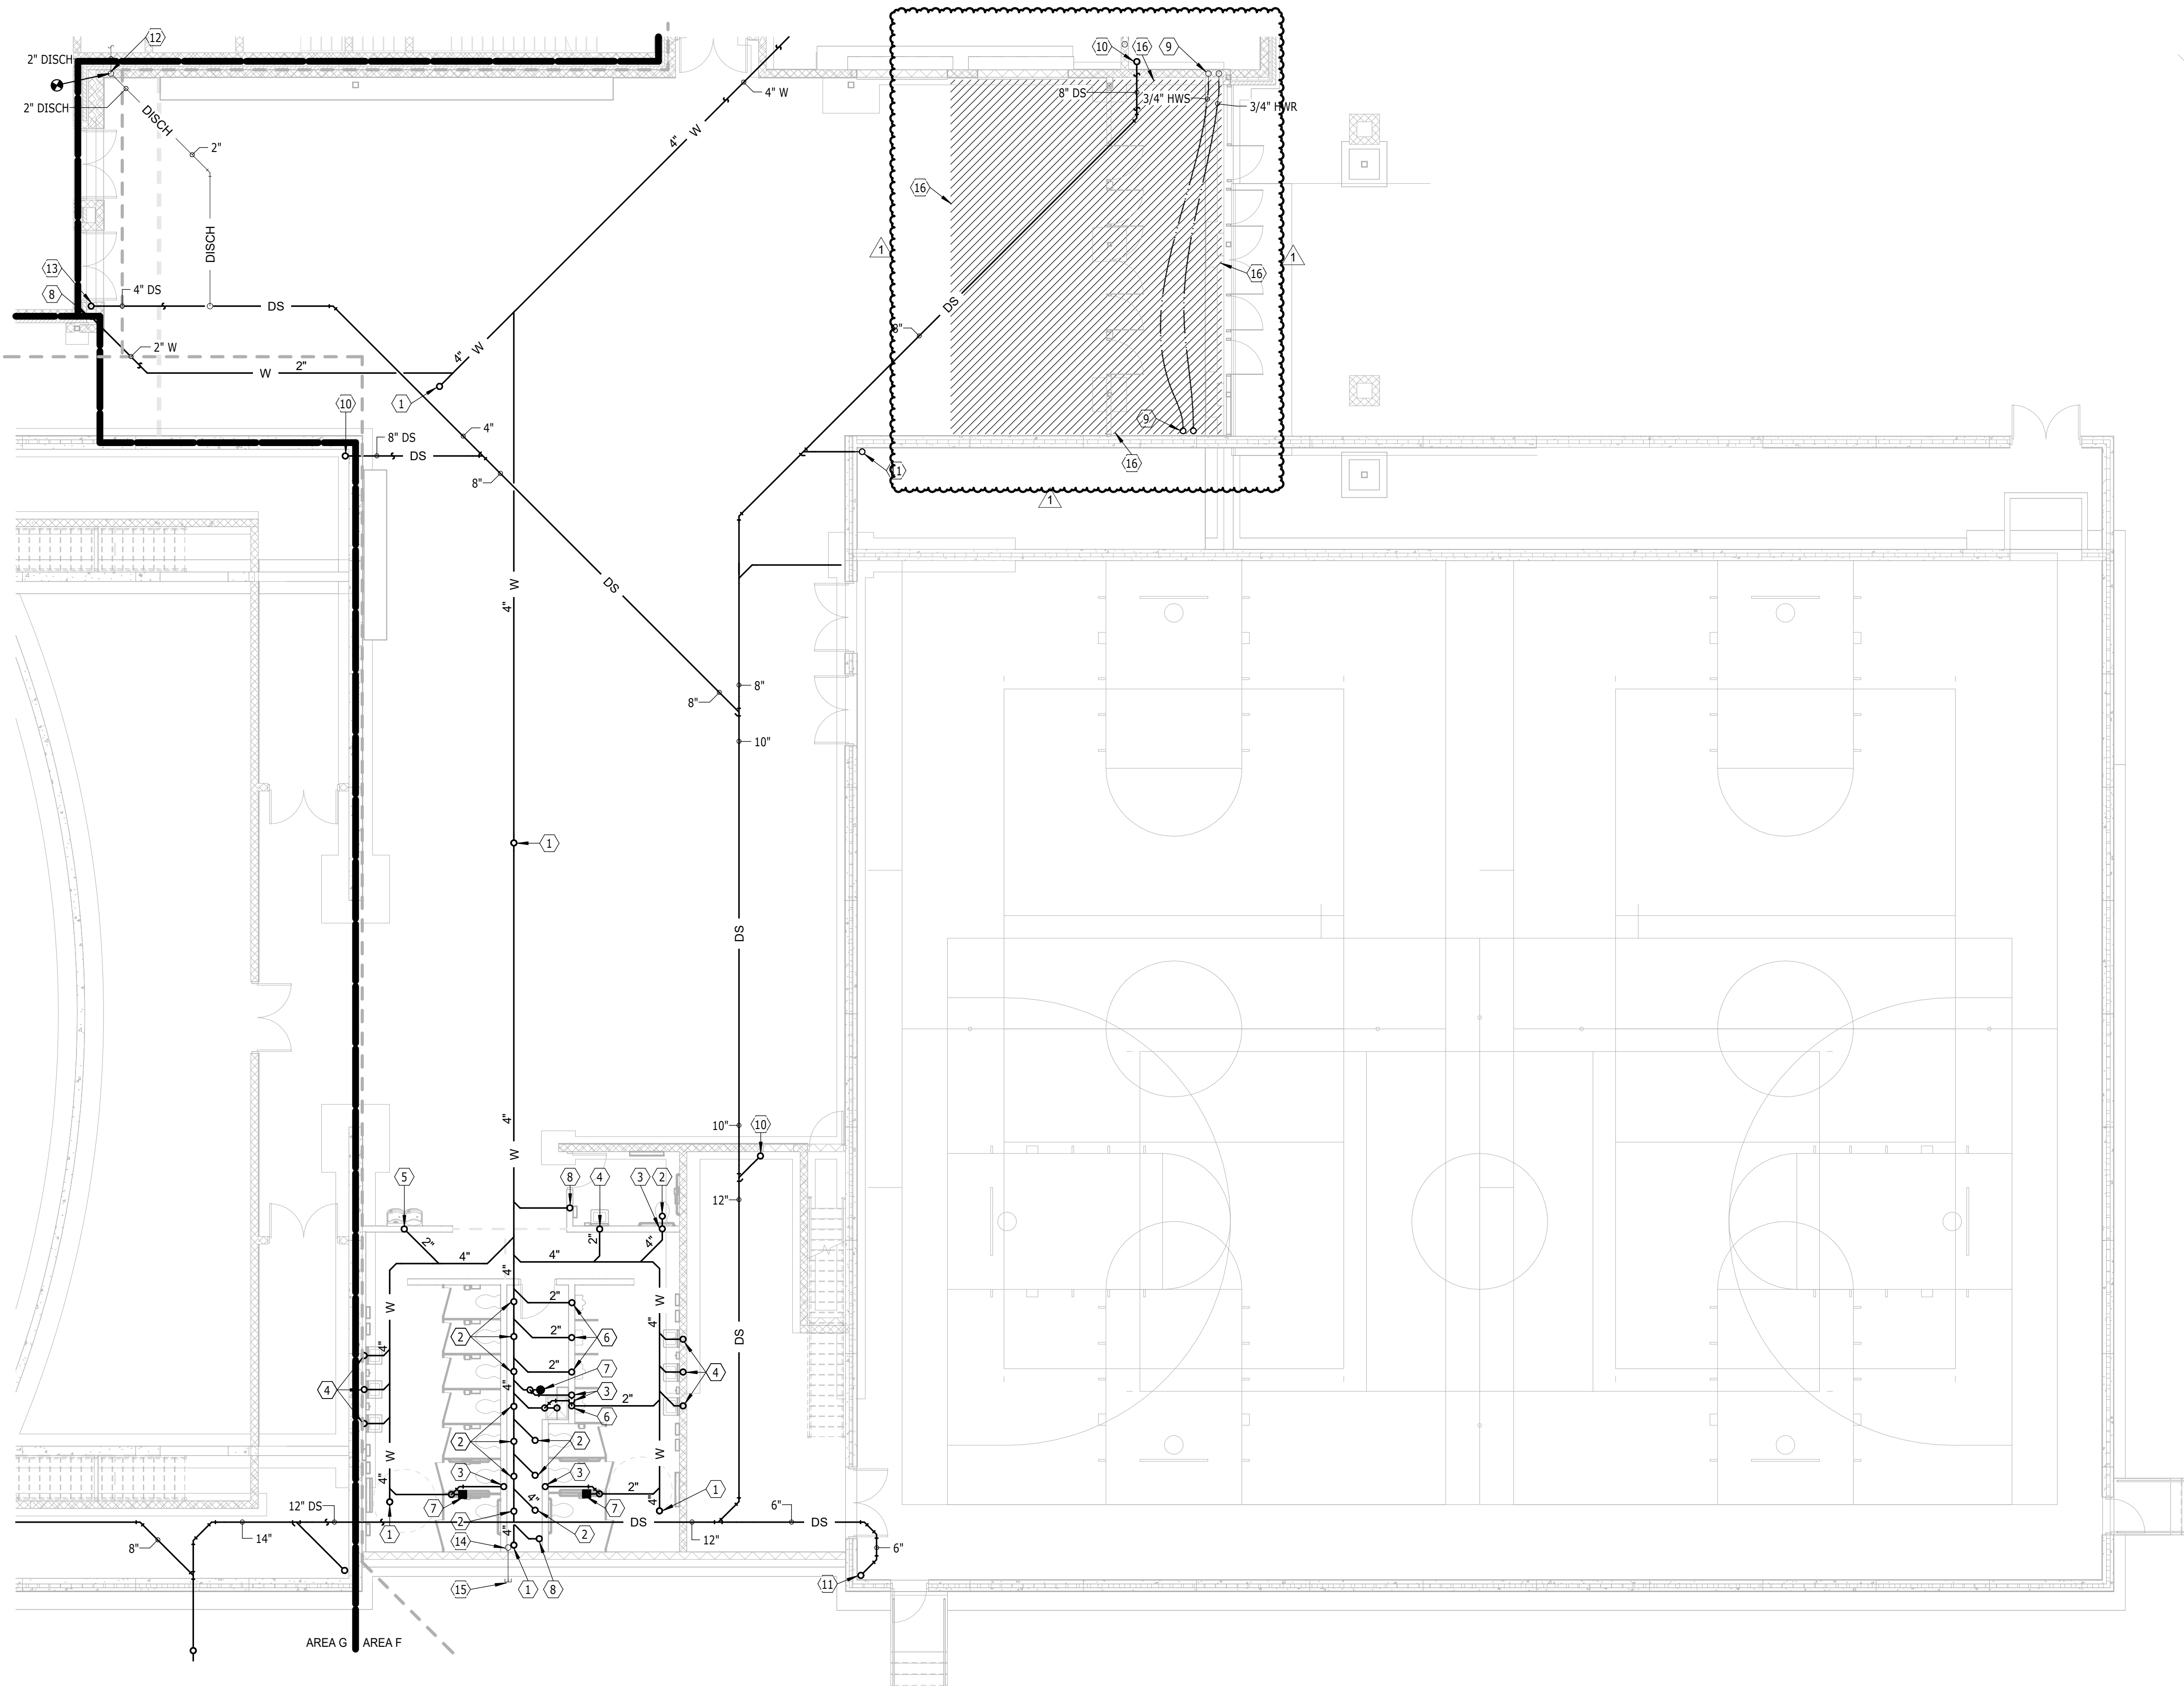

UNDERFLOOR PLAN - AREA F - PLUMBING - ADD ALTERNATE


SCALE 0 4 8 12 16

GENERAL SHEET NOTES

- A. THE CEILING SPACE AVAILABLE REQUIRES COORDINATION WITH OTHER TRADES. THE CONTRACTORS SHALL PROVIDE ALL OFFSETS AND RELOCATE AS REQUIRED TO COORDINATE THE INSTALLATION OF ALL MATERIALS AND EQUIPMENT WITH OTHER TRADES.
- B. ON DEMO DRAWINGS, ITEMS SHOWN LIGHT ARE EXISTING TO REMAIN, ITEMS SHOWN BOLD ARE EXISTING TO BE REMOVED.
- C. ON NEW CONSTRUCTION DRAWINGS, ITEMS SHOWN LIGHT ARE EXISTING TO REMAIN, ITEMS SHOWN BOLD ARE NEW WORK.

PLUMBING & HEATING NOTES


- 1 4" W UP TO CO
- 2 4" W UP TO WC
- 3 2" V UP
- 4 2" W UP TO LAV
- 5 2" W UP TO EWC
- 6 2" W UP TO UR
- 7 2" W UP TO FD
- 8 2" W STACK UP
- 9 3/4" HWR UP, 3/4" HWS UP
- 10 8" DS UP
- 11 6" DS UP
- 12 CONNECT TO EXISTING SUMP PUMP DISCHARGE PIPING. VERIFY SIZE & LOCATION PRIOR TO ASSOCIATED WORK
- 13 4" DS UP
- 14 3/4" CW UP
- 15 3/4" CW CAPPED FOR FUTURE TENNIS COURTS
- 16 INFLOOR HEAT ZONE #2 (ALT) : 750 SQ FT, 23 MBH, 3 GPM, 2 CIRCUITS, 5/8" TUBING, 12" SPACING, 3" WPD

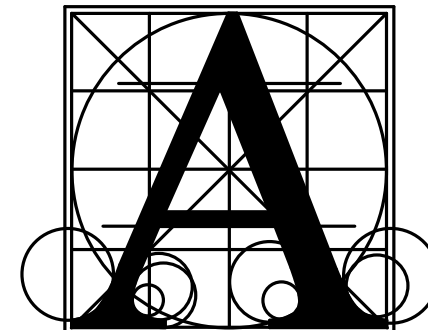

Architecture  
Incorporated

415 South Main Avenue  
P.O. Box 2140  
Sioux Falls, South Dakota 57101  
Phone: (605) 339-1711

815 St. Joseph Street, Suite 203  
Rapid City, South Dakota 57701  
Phone: (605) 721-1158

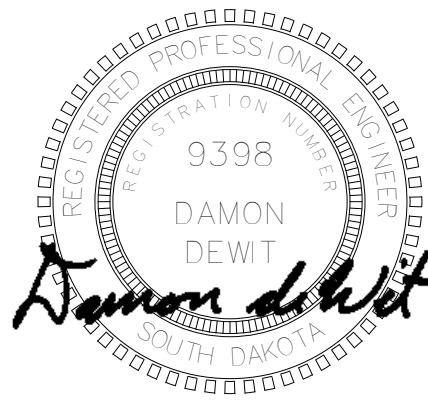

Associated  
Consulting  
Engineering,  
Incorporated

340 S. Phillips Ave.  
Sioux Falls, SD 57104

(605) 335-3720  
Fax 335-6220  
E-mail acei@aceinet.com

ACEI PROJ. #123034

Project

LENNOX HIGH SCHOOL ADDITION

Sheet Contents

UNDERFLOOR PLAN - AREA F - ADD ALTERNATE

number 0215.2902.22

date DECEMBER 21, 2023



revision

drawn DWM checked Dd

DATE DESCRIPTION


01-18-2024 Addendum #2

8.30-F-A

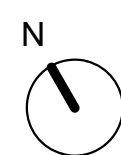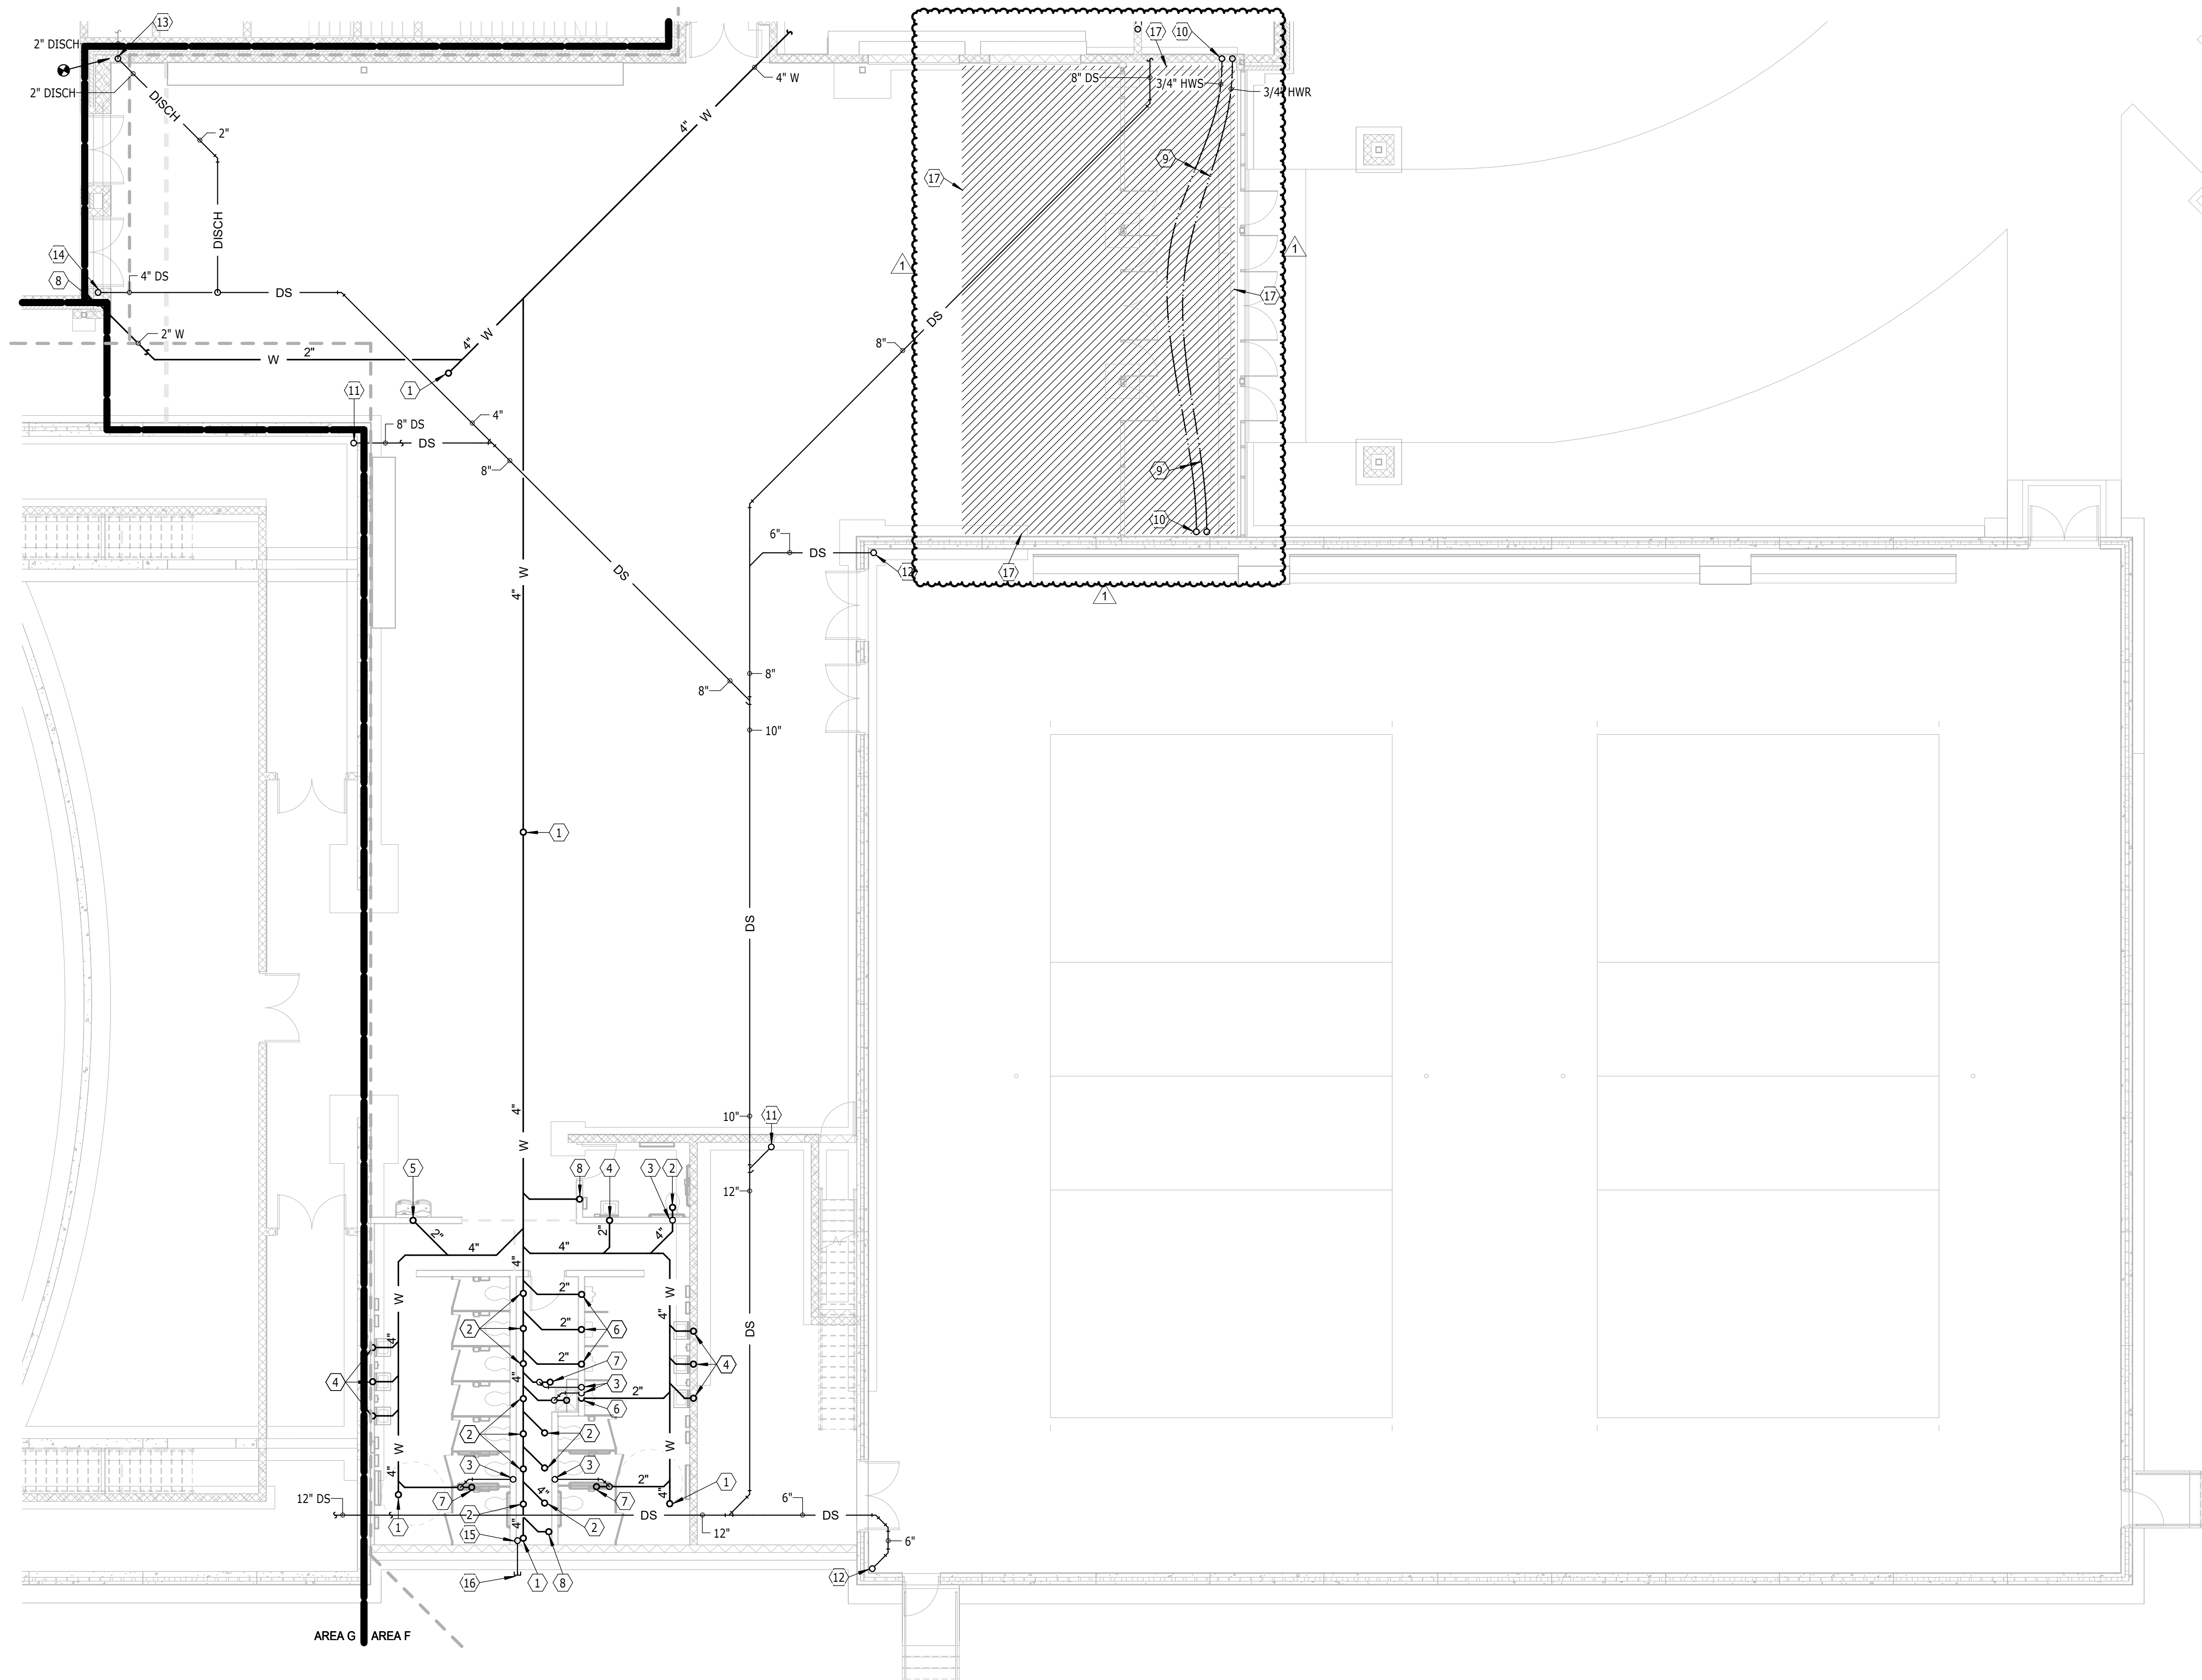

UNDERFLOOR PLAN - AREA F - PLUMBING

SCALE 0 4 8 12 16

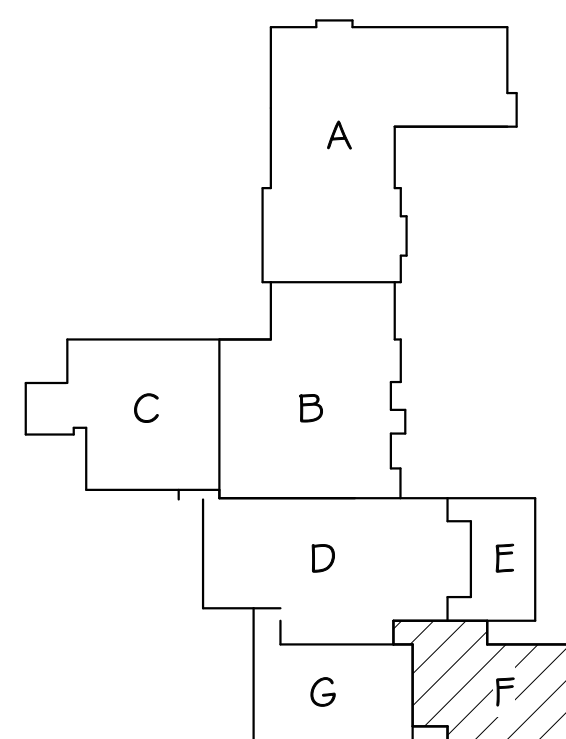


KEYPLAN

- GENERAL SHEET NOTES**
- A. THE CEILING SPACE AVAILABLE REQUIRES COORDINATION WITH OTHER TRADES. THE CONTRACTORS SHALL PROVIDE ALL OFFSETS AND RELOCATE AS REQUIRED TO COORDINATE THE INSTALLATION OF ALL MATERIALS AND EQUIPMENT WITH OTHER TRADES.
- B. ON DEMO DRAWINGS, ITEMS SHOWN LIGHT ARE EXISTING TO REMAIN, ITEMS SHOWN BOLD ARE EXISTING TO BE REMOVED.
- C. ON NEW CONSTRUCTION DRAWINGS, ITEMS SHOWN LIGHT ARE EXISTING TO REMAIN, ITEMS SHOWN BOLD ARE NEW WORK.

**PLUMBING & HEATING NOTES**


- 1 4\"/>

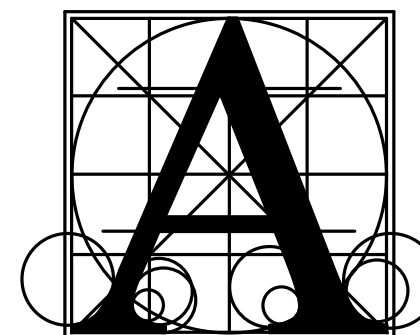

Architecture  
Incorporated

415 South Main Avenue  
P.O. Box 2140  
Sioux Falls, South Dakota 57101  
Phone: (605) 339-1711

815 St. Joseph Street, Suite 203  
Rapid City, South Dakota 57701  
Phone: (605) 721-1158

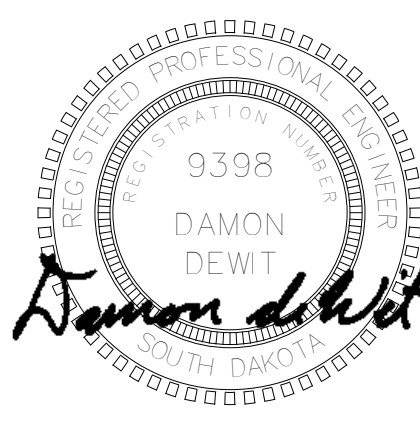

Associated  
Consulting  
Engineering,  
Incorporated

340 S. Phillips Ave.  
Sioux Falls, SD 57104

(605) 335-3720  
Fax 335-6220  
E-mail acei@aceinet.com

ACEI PROJ. #123034

LENNOX HIGH SCHOOL ADDITION

UNDERFLOOR PLAN - AREA F - PLUMBING

Project

number 0215.2902.22

date DECEMBER 21, 2023

revision


drawn DWM checked Dd

DATE DESCRIPTION


01-18-2024 Addendum #2

8.30-F


1/18/2024 11:37:34 AM

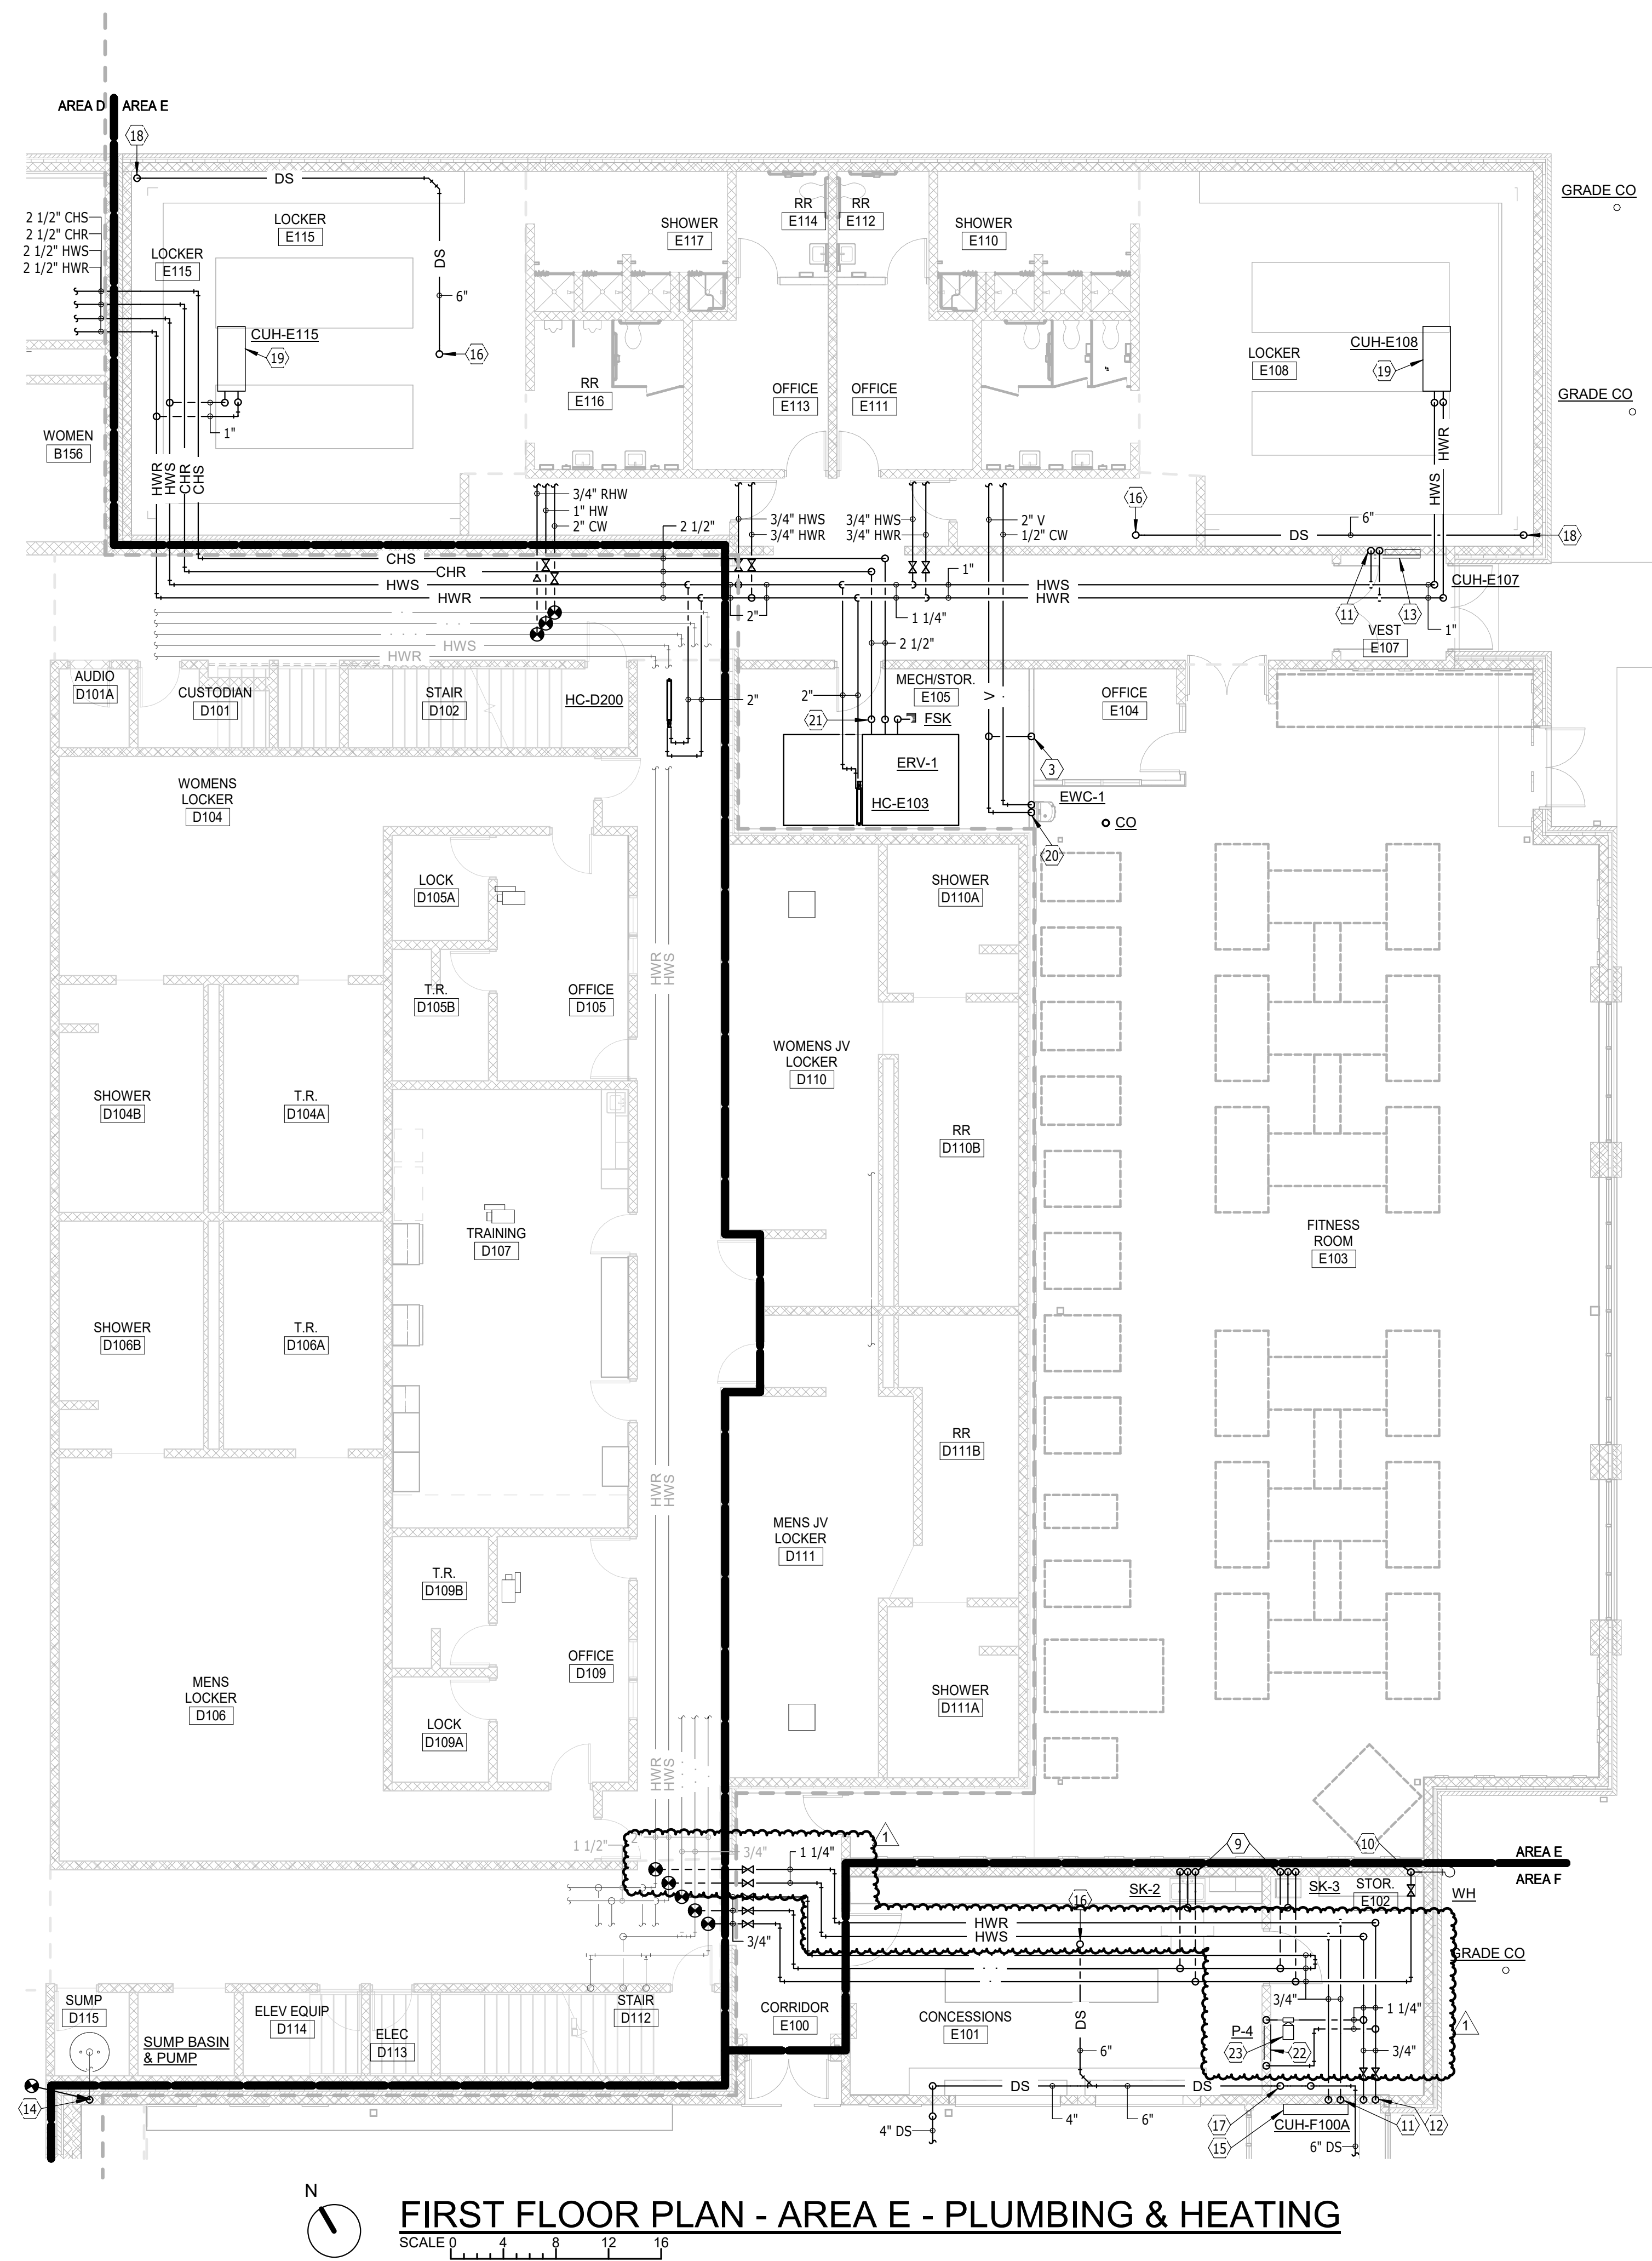

FIRST FLOOR PLAN - AREA E - PLUMBING & HEATING

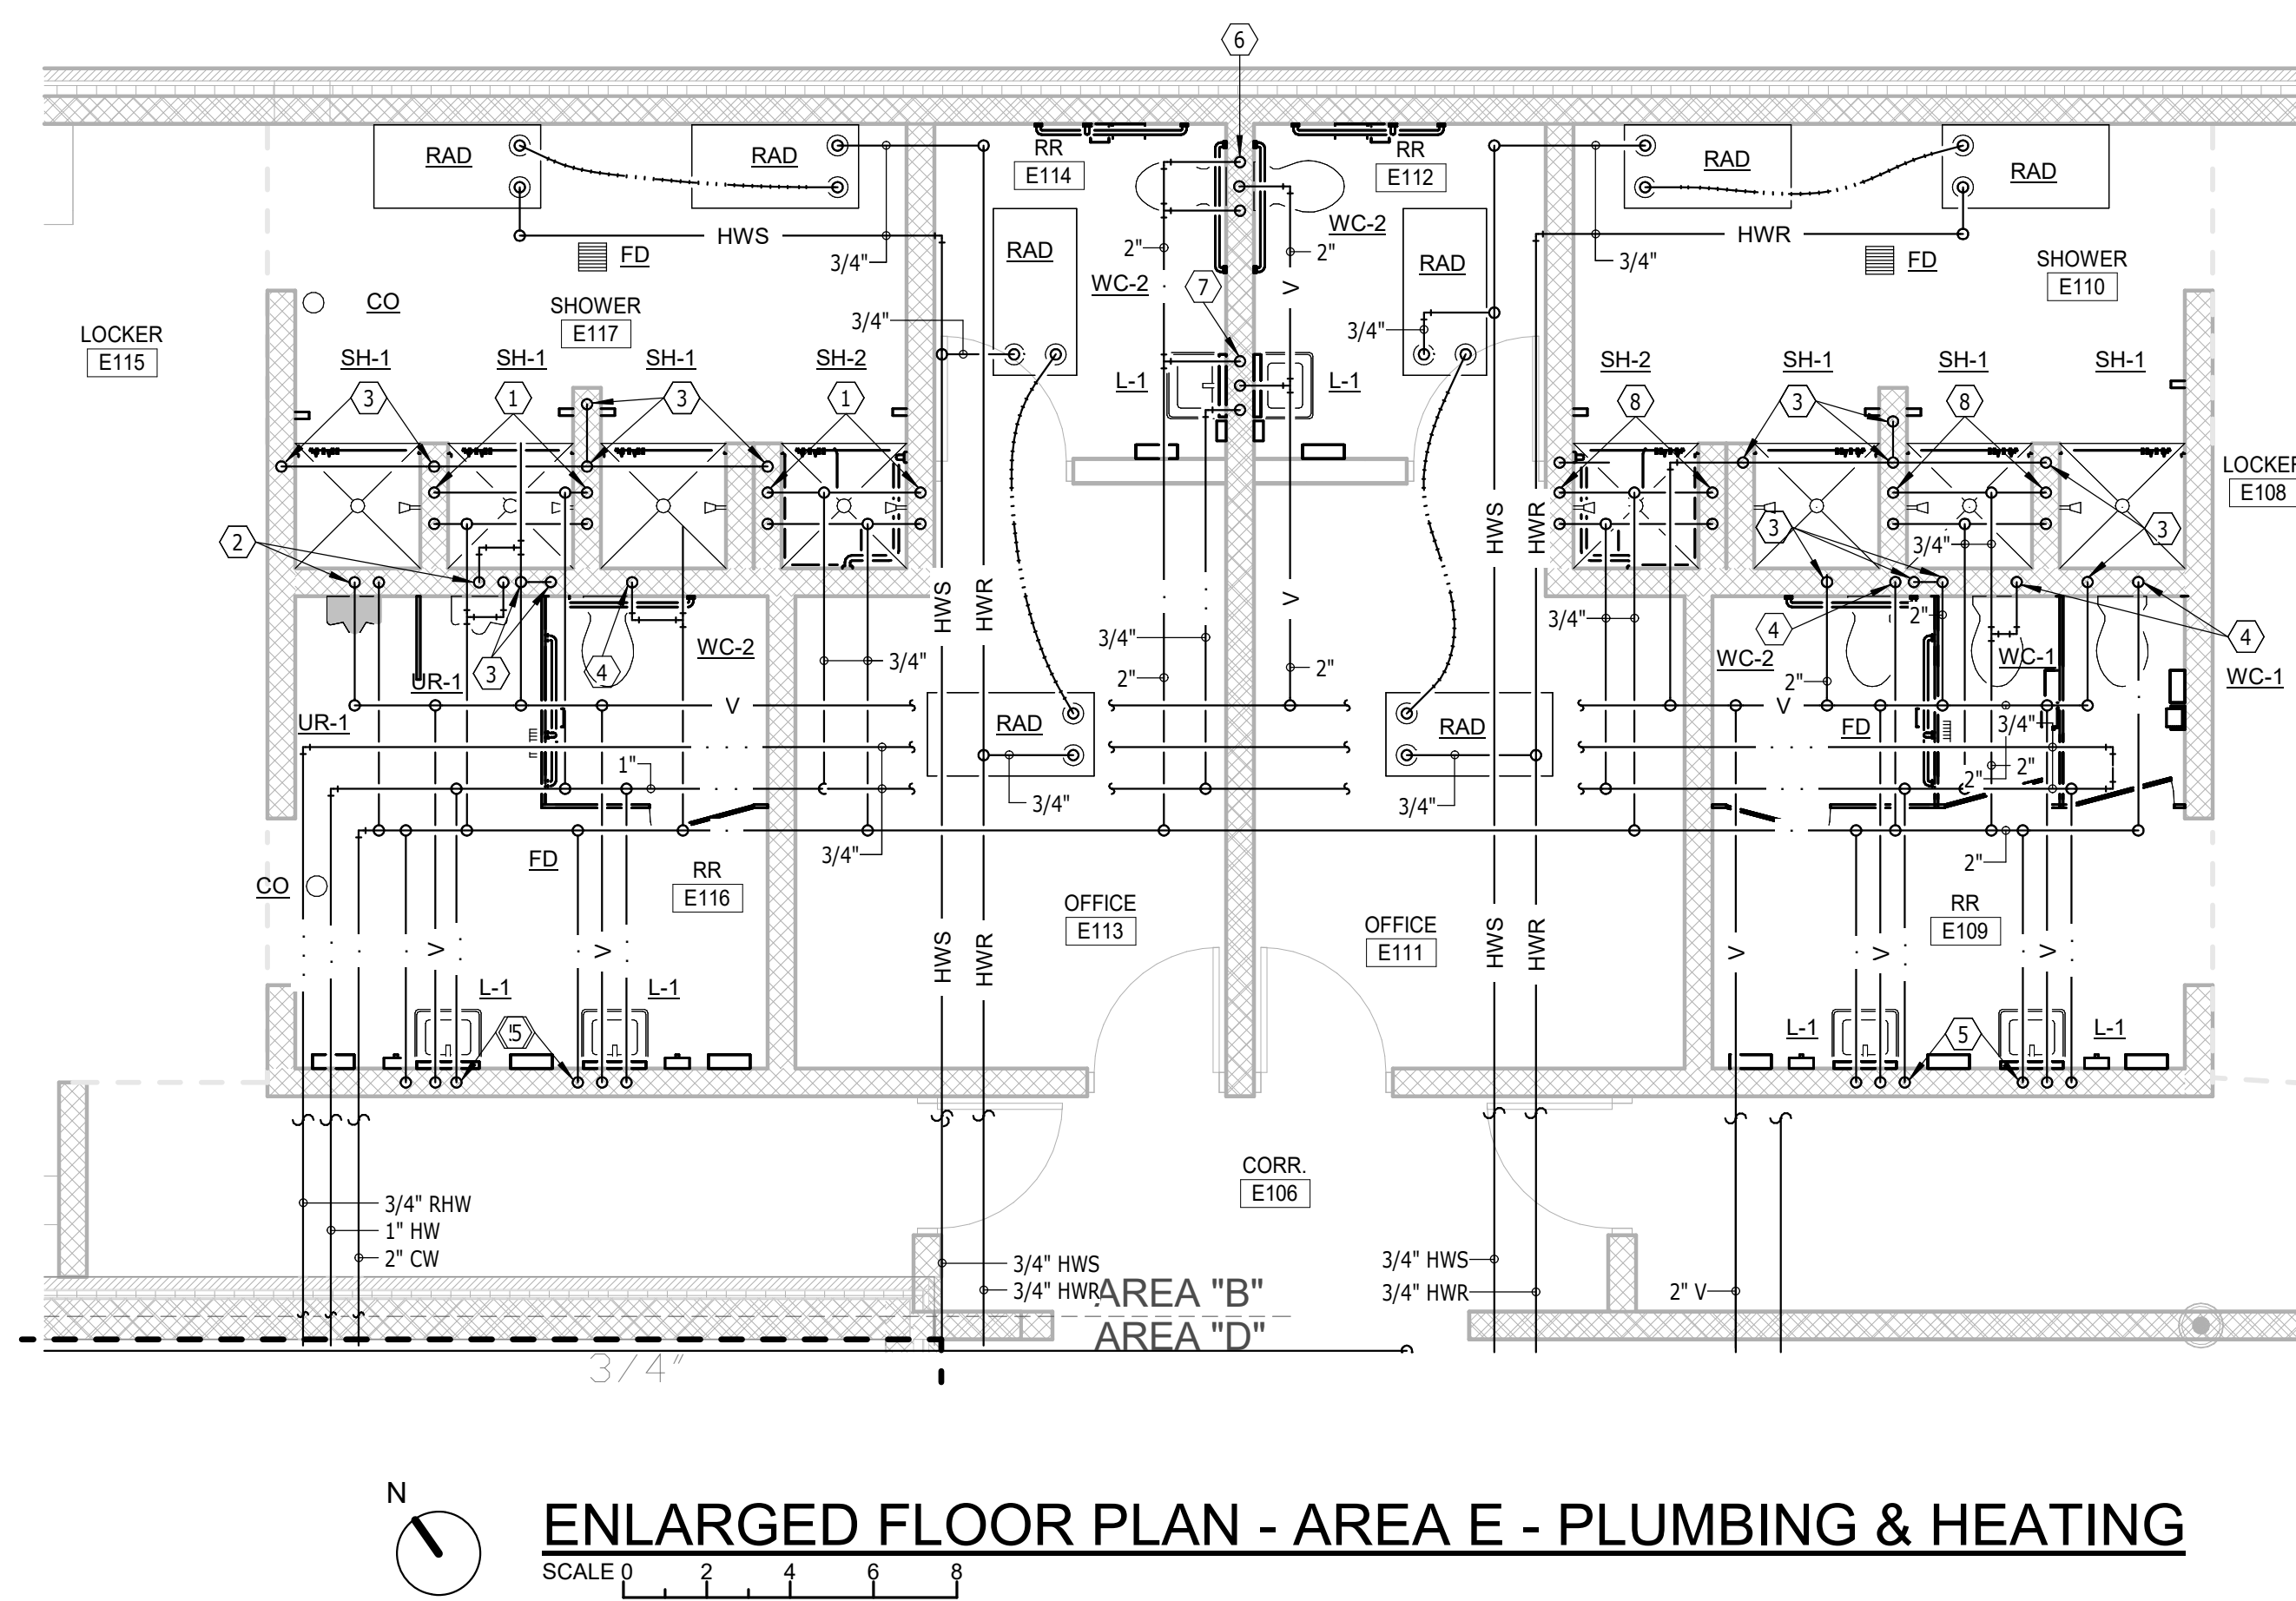


ENLARGED FLOOR PLAN - AREA E - PLUMBING & HEATING

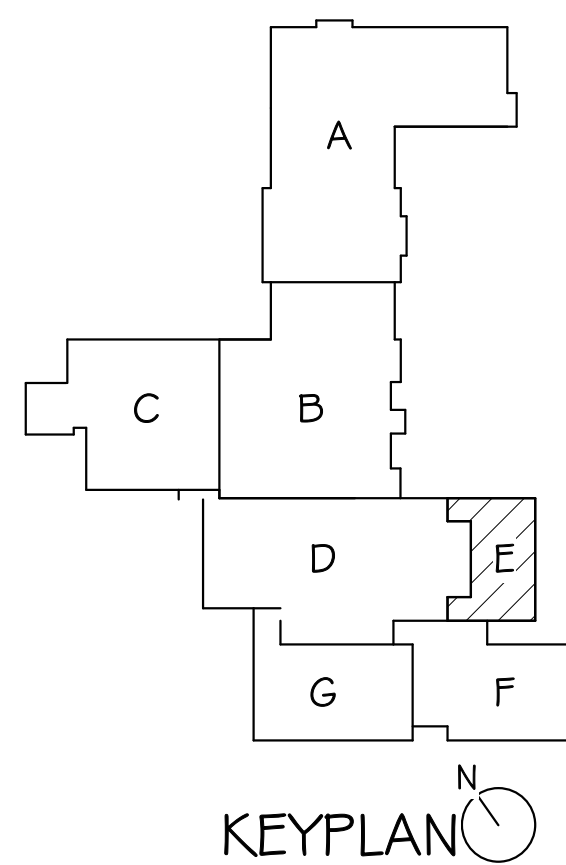

KEYPLAN


- GENERAL SHEET NOTES**
- THE CEILING SPACE AVAILABLE REQUIRES COORDINATION WITH OTHER TRADES. THE CONTRACTORS SHALL PROVIDE ALL OFFSETS AND RELOCATE AS REQUIRED TO COORDINATE THE INSTALLATION OF ALL MATERIALS AND EQUIPMENT WITH OTHER TRADES.
  - ON DEMO DRAWINGS, ITEMS SHOWN LIGHT ARE EXISTING TO REMAIN, ITEMS SHOWN BOLD ARE EXISTING TO BE REMOVED.
  - ON NEW CONSTRUCTION DRAWINGS, ITEMS SHOWN LIGHT ARE EXISTING TO REMAIN, ITEMS SHOWN BOLD ARE NEW WORK.
- PLUMBING & HEATING NOTES**
- 1/2" HW DN, 1/2" CW DN
  - 1 1/2" V/2" W DN, 1" CW DN
  - 2" V DN
  - 1 1/4" CW DN
  - 1/2" CW DN, 1 1/2" V/2" W DN, 1/2" HW DN
  - 1 1/4" CW DN, 2" V DN, 1 1/4" CW DN
  - 3/4" CW DN, 1 1/2" V/2" W DN, 3/4" HW DN
  - 1/2" CW DN, 1/2" HW DN
  - 1/2" HW DN, 1 1/2" V/2" W DN, 1/2" CW DN
  - 3/4" CW DN TO WH MTD 24" ABOVE GRADE
  - 1/2" CW DN, 1 1/2" V/2" W DN, 1/2" HW DN
  - 3/4" HWS & 3/4" HWR DN TO THRU FLOOR
  - HYDRONIC SEMI-RECESSED CABINET UNIT HEATER. SEE CABINET UNIT HEATER PIPING DETAIL
  - CONNECT TO EXISTING SLUMP PUMP DISCHARGE PIPING. VERIFY SIZE & LOCATION PRIOR TO ASSOCIATED WORK
  - HYDRONIC FLOOR MOUNTED CABINET UNIT HEATER. SEE CABINET UNIT HEATER PIPING DETAIL
  - 6" DS UP TO 6" RD
  - 8" DS DN W/CO 24" AFF
  - 6" DS DN W/CO 24" AFF
  - HYDRONIC CEILING MOUNTED CABINET UNIT HEATER. SEE CABINET UNIT HEATER PIPING DETAIL
  - 1/2" CW DN, 1 1/2" V/2" W DN
  - 2 1/2" CHS & 2 1/2" CH DN EXTEND TO FSR
  - INFLOOR HEAT ZONES #1 & #2 PIPING MANIFOLD. SEE INFLOOR HEAT MANIFOLD PIPING DETAIL
  - INFLOOR HEAT ZONE PUMP. SEE INFLOOR HEAT PUMP PIPING DETAIL

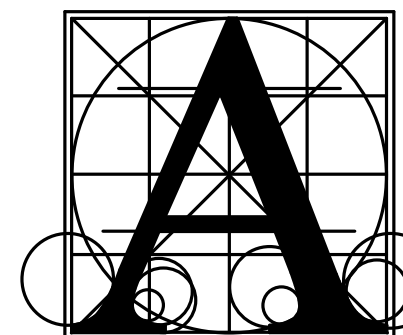

Architecture  
Incorporated

415 South Main Avenue  
P.O. Box 2140  
Sioux Falls, South Dakota 57101  
Phone: (605) 339-1711

815 St. Joseph Street, Suite 203  
Rapid City, South Dakota 57701  
Phone: (605) 721-1158

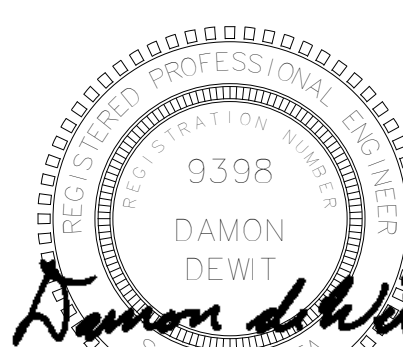

Associated  
Consulting  
Engineering,  
Incorporated

340 S. Phillips Ave.  
Sioux Falls, SD 57104

(605) 335-3720  
Fax 335-6220  
E-mail acei@aceinet.com

ACEI PROJ. #123034

LENNOX HIGH SCHOOL ADDITION  
FIRST FLOOR PLAN - AREA E - PLUMBING & HEATING


Project number 0215.2902.22  
date DECEMBER 21, 2023  
revision  
drawn DWM checked Dd

DATE DESCRIPTION  
01-18-2024 Addendum #2

8.31-E



1/18/2024 12:49:05 PM

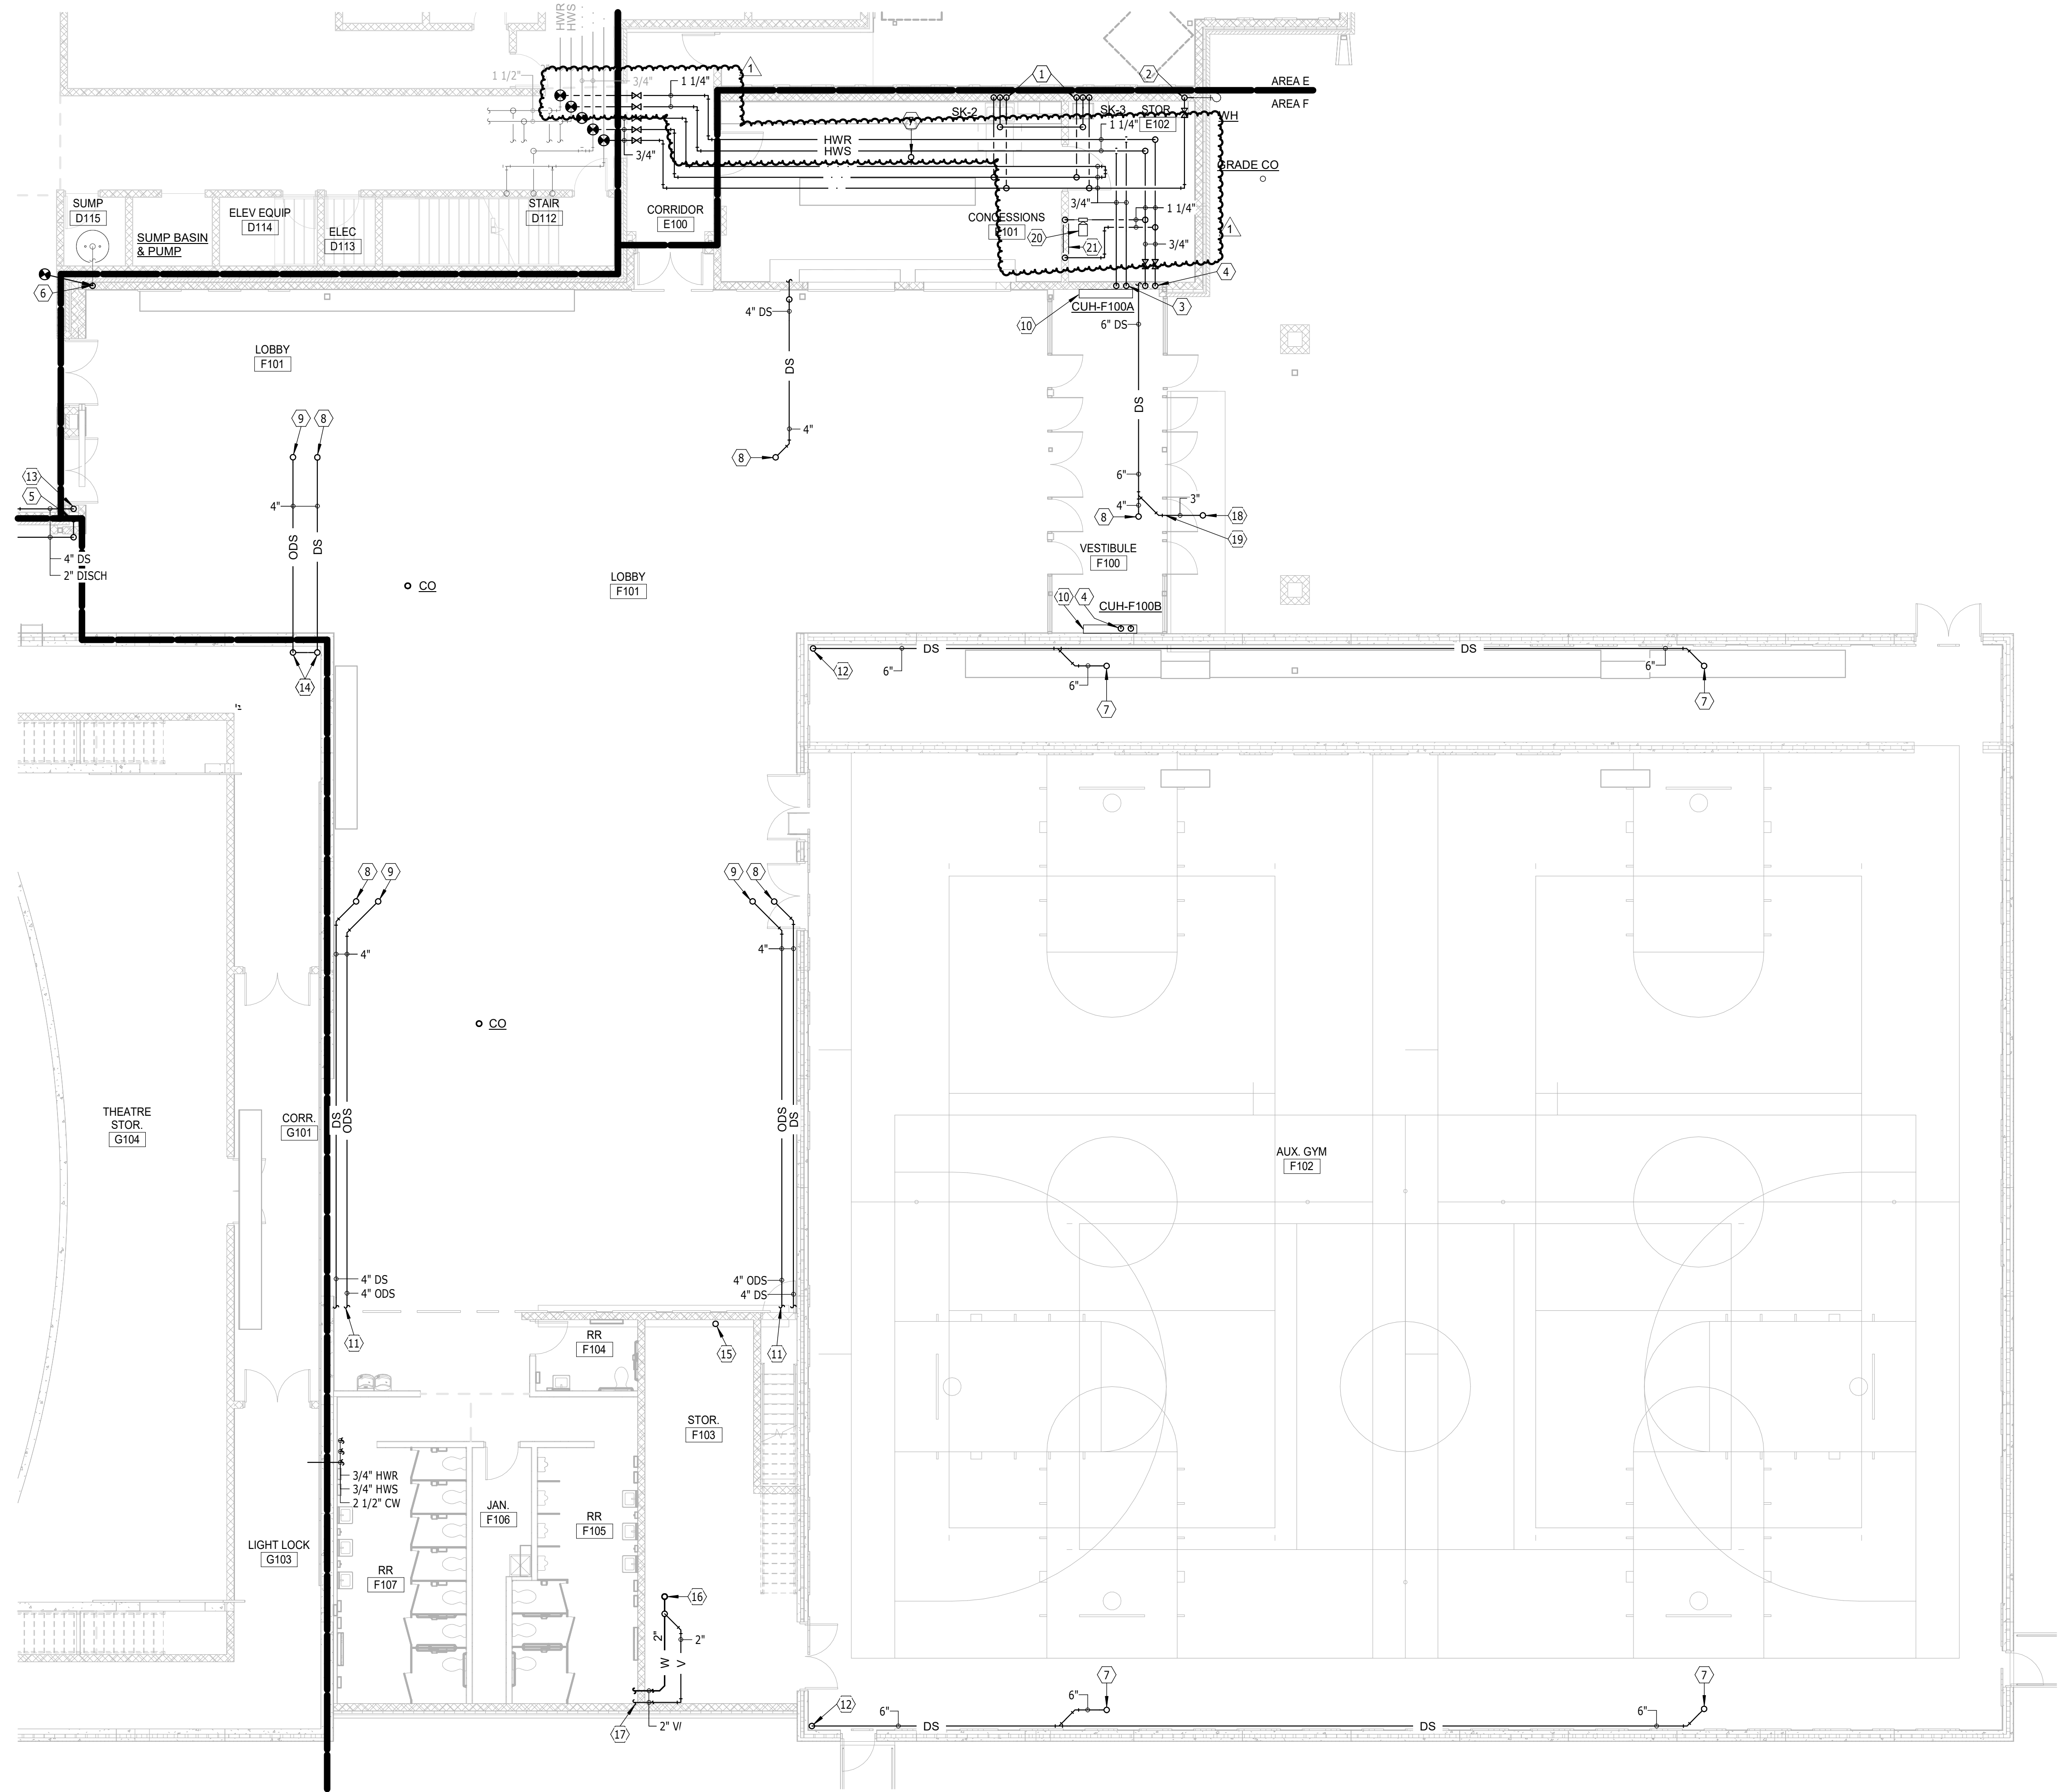


N  
FIRST FLOOR PLAN - AREA F - PLUMBING & HEATING- ADD ALTERNATE  
SCALE 0 4 8 12 16

#### GENERAL SHEET NOTES

- A. THE CEILING SPACE AVAILABLE REQUIRES COORDINATION WITH OTHER TRADES. THE CONTRACTORS SHALL PROVIDE ALL OFFSETS AND RELOCATE AS REQUIRED TO COORDINATE THE INSTALLATION OF ALL MATERIALS AND EQUIPMENT WITH OTHER TRADES.
- B. ON DEMO DRAWINGS, ITEMS SHOWN LIGHT ARE EXISTING TO REMAIN, ITEMS SHOWN BOLD ARE EXISTING TO BE REMOVED.
- C. ON NEW CONSTRUCTION DRAWINGS, ITEMS SHOWN LIGHT ARE EXISTING TO REMAIN, ITEMS SHOWN BOLD ARE NEW WORK.

#### PLUMBING & HEATING NOTES


1. 1/2" HW DN, 1 1/2" 1/2" W DN, 1/2" CW DN
2. 3/4" CW DN TO WH MTD 24" ABOVE GRADE
3. 3/4" HWS & 3/4" HWR DN TO CUH
4. 3/4" HWS & 3/4" HWR DN TO THRU FLOOR
5. 2" DISCH DN W/CO 24" AFF
6. CONNECT TO EXISTING SUMP PUMP DISCHARGE PIPING. VERIFY SIZE & LOCATION PRIOR TO ASSOCIATED WORK
7. 6" DS UP TO 6" RD
8. 4" DS UP TO 4" RD
9. 4" ODS UP TO 4" ORD
10. HYDRONIC FLOOR MOUNTED CABINET UNIT HEATER. SEE CABINET UNIT HEATER PIPING DETAIL
11. SEE ENLARGED MEZZANINE AREA F ON SHEET 8.32-B FOR CONTINUATION
12. 6" DS DN WITH PVC JACKET TO CO 24" AFF
13. 4" DS DN WITH CO 24" AFF
14. 6" DS UP/8" DS DN WITH CO 24" AFF. CONNECT ODS PIPING TO VERTICAL DS PIPING
15. 8" DS UP/DN WITH CO 24" AFF
16. 2" W UP TO FSK
17. SEE ENLARGED REST ROOM PLANS ON THIS SHEET
18. 3" DS UP TO 3" RD
19. COORDINATE PIPING CONNECTION THROUGH EXISTING STRUCTURAL OPENINGS
20. INFLOOR HEAT ZONE PUMP. SEE INFLOOR HEAT PUMP PIPING DETAIL
21. INFLOOR HEAT ZONES #1 & #2 PIPING MANIFOLD. SEE INFLOOR HEAT MANIFOLD PIPING DETAIL

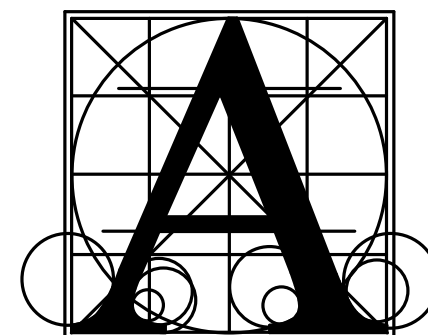

#### Architecture Incorporated

415 South Main Avenue  
P.O. Box 2140  
Sioux Falls, South Dakota 57101  
Phone: (605) 339-1711

815 St. Joseph Street, Suite 203  
Rapid City, South Dakota 57701  
Phone: (605) 721-1158

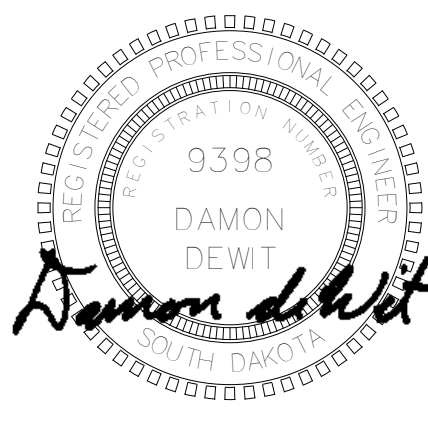

#### Associated Consulting Engineering, Incorporated

340 S. Phillips Ave.  
Sioux Falls, SD 57104  
(605) 335-3720  
Fax 335-6220  
E-mail acei@aceinet.com  
ACEI PROJ. #123034

#### LENNOX HIGH SCHOOL ADDITION

sheet contents

#### FIRST FLOOR PLAN - AREA F - PLUMBING & HEATING - ADD ALTERNATE



Project

number 0215.2902.22  
date DECEMBER 21, 2023  
revision  
drawn Author checked Checker

DATE	DESCRIPTION
01-18-2024	Addendum #2

# 8.31-F-A


1/18/2024 12:50:40 PM

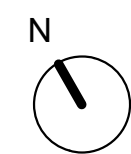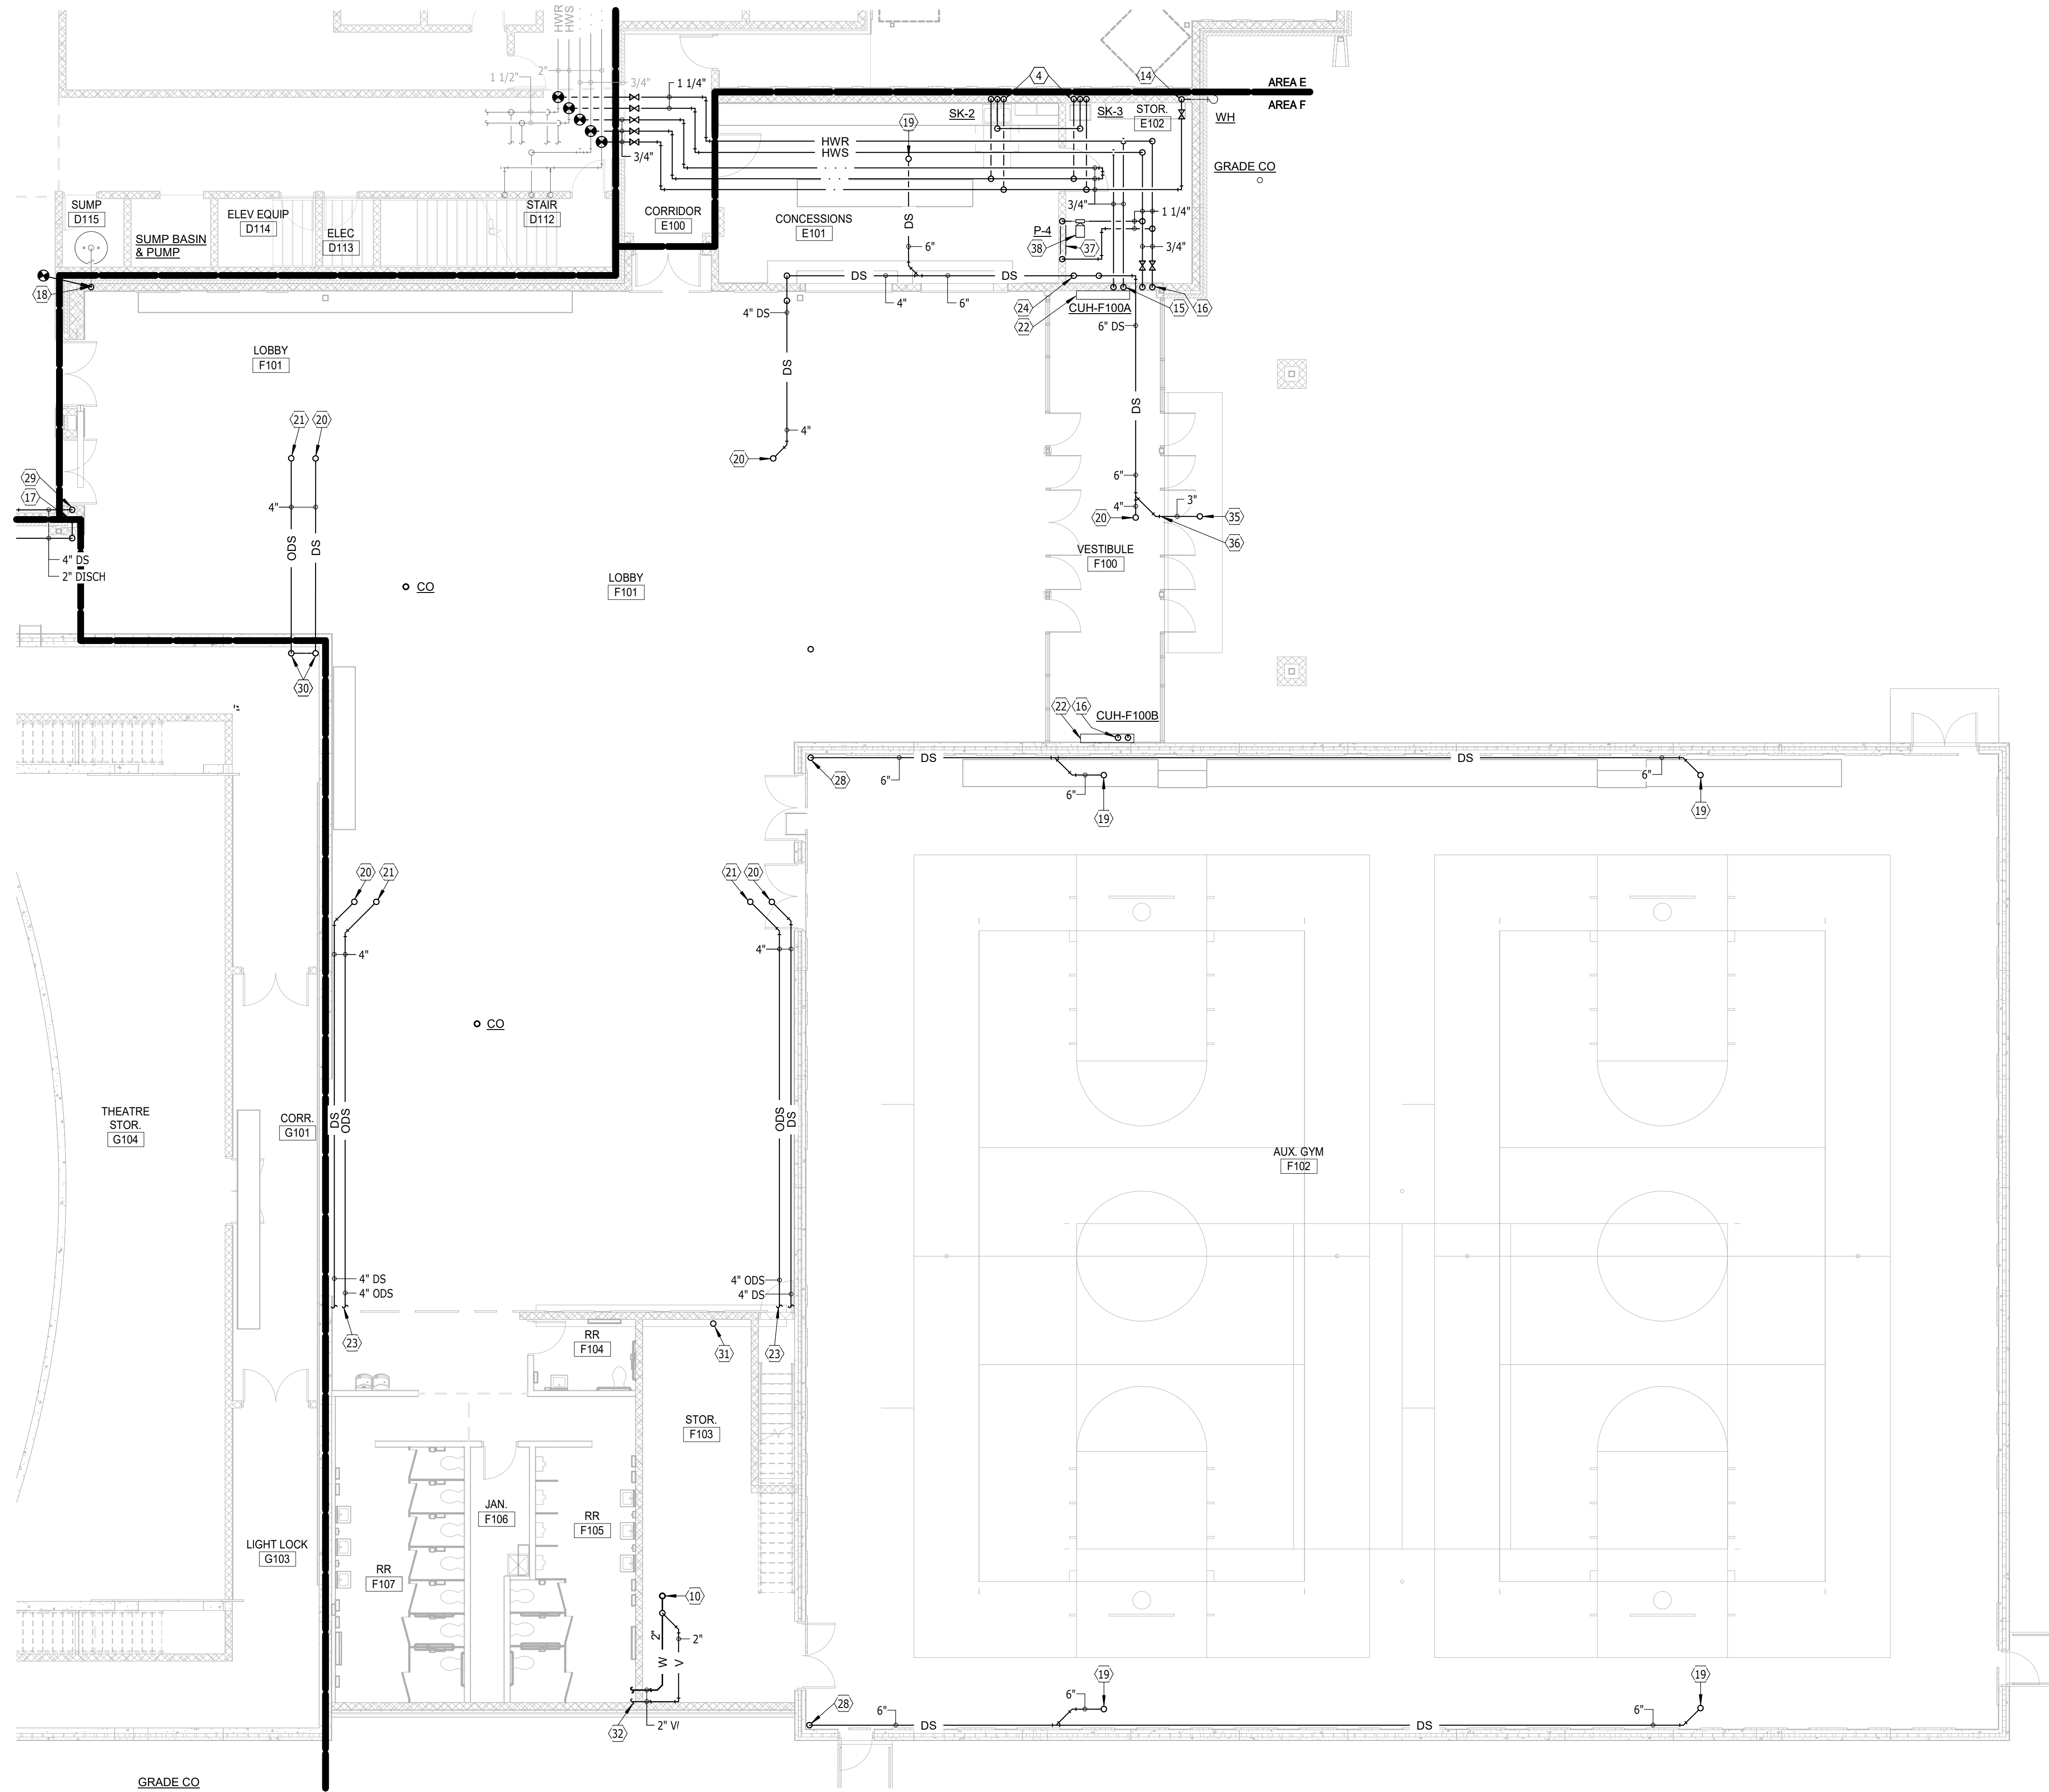

FIRST FLOOR PLAN - AREA F - PLUMBING & HEATING


SCALE 0 4 8 12 16

- GENERAL SHEET NOTES**
- THE CEILING SPACE AVAILABLE REQUIRES COORDINATION WITH OTHER TRADES. THE CONTRACTORS SHALL PROVIDE ALL OFFSETS AND RELOCATE AS REQUIRED TO COORDINATE THE INSTALLATION OF ALL MATERIALS AND EQUIPMENT WITH OTHER TRADES.
  - ON DEMO DRAWINGS, ITEMS SHOWN LIGHT ARE EXISTING TO REMAIN, ITEMS SHOWN BOLD ARE EXISTING TO BE REMOVED.
  - ON NEW CONSTRUCTION DRAWINGS, ITEMS SHOWN LIGHT ARE EXISTING TO REMAIN, ITEMS SHOWN BOLD ARE NEW WORK.
- PLUMBING & HEATING NOTES**
- 2" V DN
  - 1 1/4" CW DN
  - 2" V/4" W DN
  - 1/2" HW DN, 1 1/2" V/2" W DN, 1/2" CW DN
  - 1/2" CW DN, 1 1/2" V/2" W DN, 1/2" HW DN
  - 3/4" CW DN TO HB/MSK, 1/2" HW DN TO MSK
  - 1" CW DN
  - 1 1/2" V/2" W DN
  - 1/2" CW DN, 1 1/2" V/2" W DN
  - 2" W UP TO FSK
  - 2" W DN W/CO 24" AFF
  - 4" V/2" W DN
  - 2" V UP
  - 3/4" CW DN TO WH MTD 24" ABOVE GRADE
  - 3/4" HWS & 3/4" HWR DN TO CUH
  - 3/4" HWS & 3/4" HWR DN TO THRU FLOOR
  - 2" DISCH DN W/CO 24" AFF
  - CONNECT TO EXISTING SUMP PUMP DISCHARGE PIPING. VERIFY SIZE & LOCATION PRIOR TO ASSOCIATED WORK
  - 6" DS UP TO 6" RD
  - 4" DS UP TO 4" RD
  - 4" ODS UP TO 4" ORD
  - HYDRONIC FLOOR MOUNTED CABINET UNIT HEATER. SEE CABINET UNIT HEATER PIPING DETAIL
  - SEE ENLARGED MEZZANINE AREA F ON SHEET 8.32-B FOR CONTINUATION
  - 8" DS DN W/CO 24" AFF
  - 3/4" CW DN WITH HB MTD 24" AFF/DN THRU FLOOR
  - 4" CHR UP, 4" CHS UP, 3" HWR UP, 3/4" HWS UP
  - 6" DS DN WITH PVC JACKET TO CO 24" AFF
  - 4" DS DN WITH CO 24" AFF
  - 6" DS UP/8" DS DN WITH CO 24" AFF. CONNECT ODS PIPING TO VERTICAL DS PIPING
  - 8" DS UP/DN WITH CO 24" AFF
  - SEE ENLARGED REST ROOM PLANS ON THIS SHEET
  - 1" CW UP, 1" HW UP, 3/4" RHW UP
  - HYDRONIC 24"x48" RADIANT CEILING PANEL. SEE RADIANT PANEL PIPING DETAIL
  - 3" DS UP TO 3" RD
  - COORDINATE PIPING PENETRATION THROUGH WITH STRUCTURAL OPENINGS
  - INFLOOR HEAT ZONES #1 & #2 PIPING MANIFOLD. SEE INFLOOR HEAT MANIFOLD PIPING DETAIL
  - INFLOOR HEAT ZONE PUMP. SEE INFLOOR HEAT PUMP PIPING DETAIL

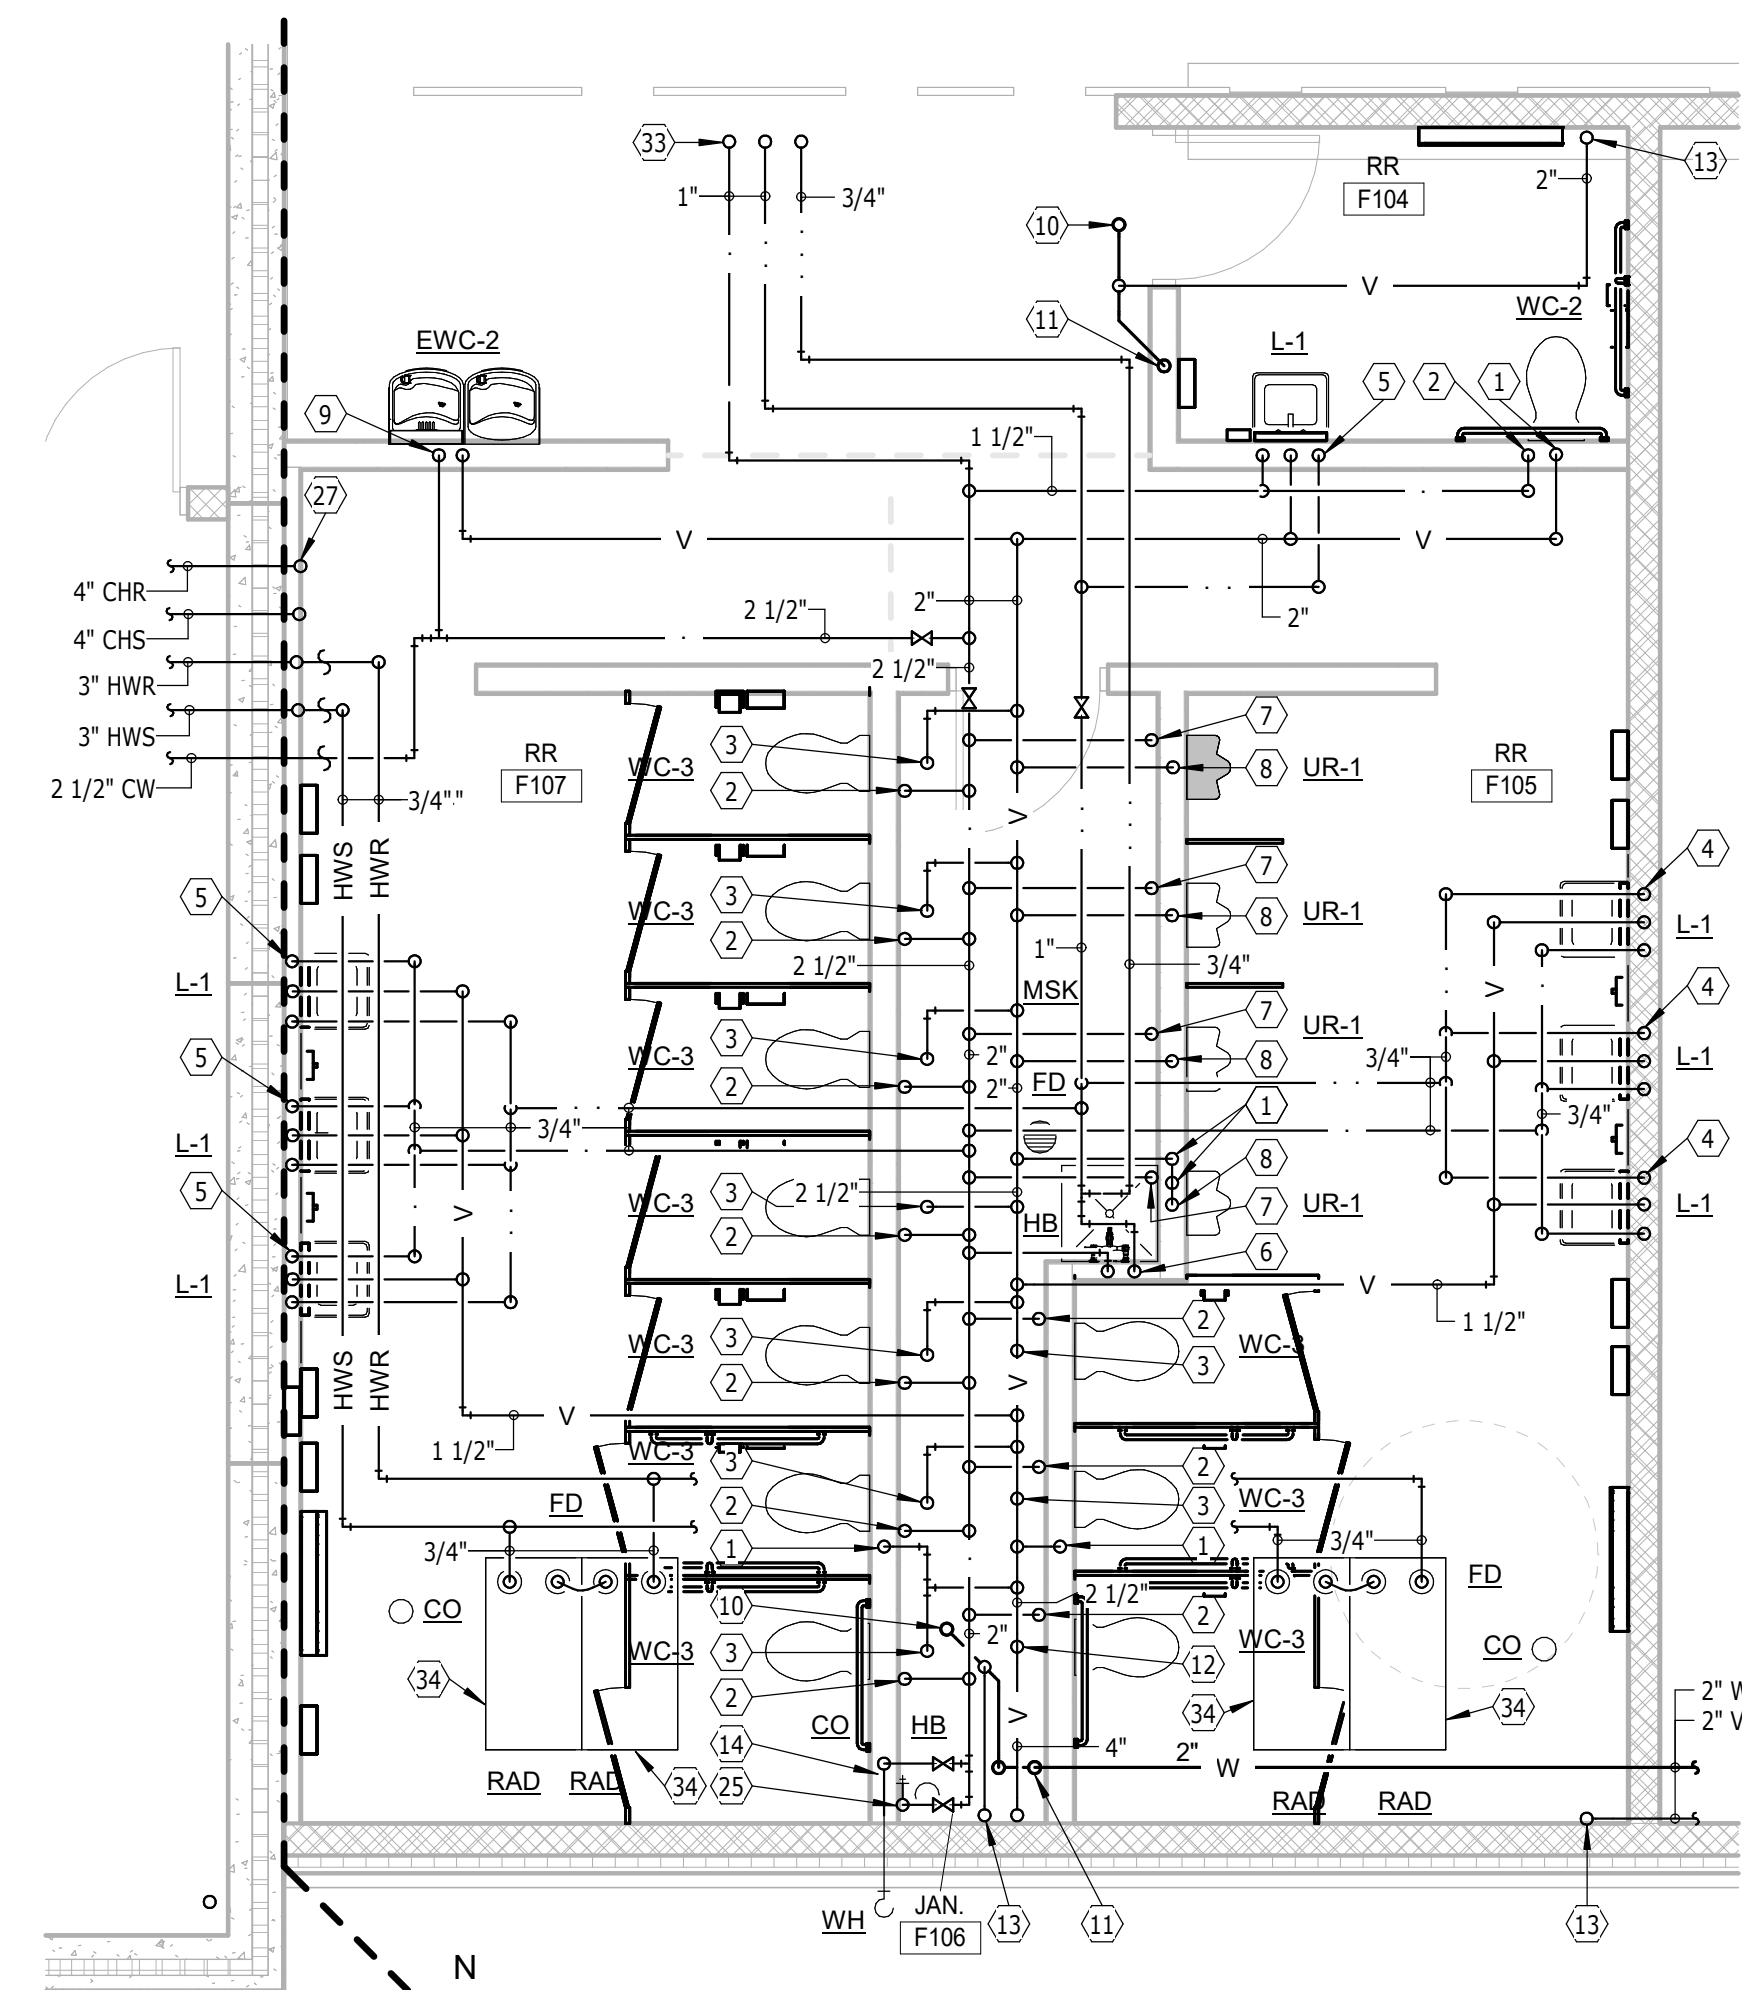


ENLARGED FLOOR PLAN - AREA F - PLUMBING & HEATING

SCALE 0 2 4 6 8

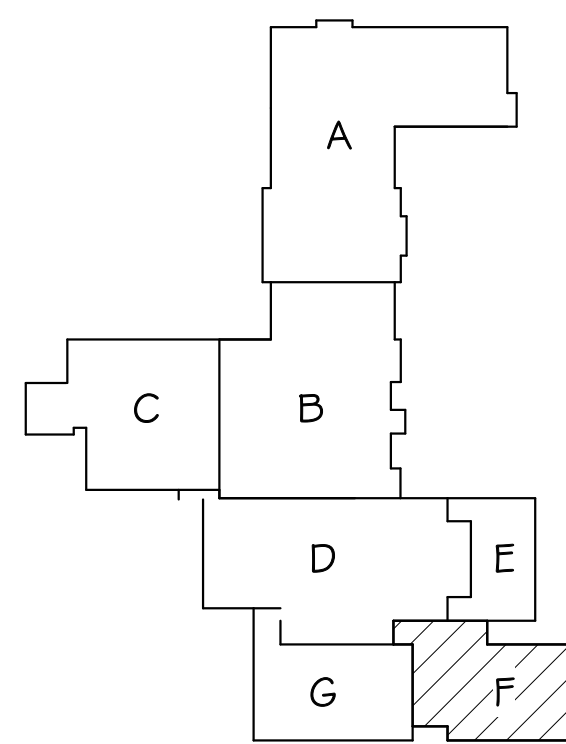


KEYPLAN

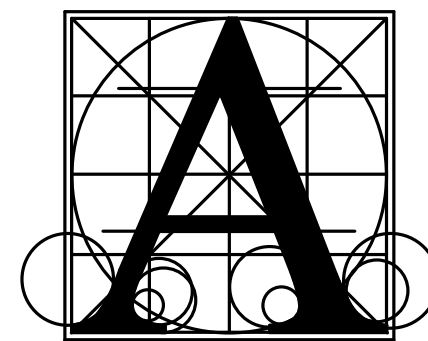

Architecture  
Incorporated

415 South Main Avenue  
P.O. Box 2140  
Sioux Falls, South Dakota 57101  
Phone: (605) 339-1711

815 St. Joseph Street, Suite 203  
Rapid City, South Dakota 57701  
Phone: (605) 721-1158

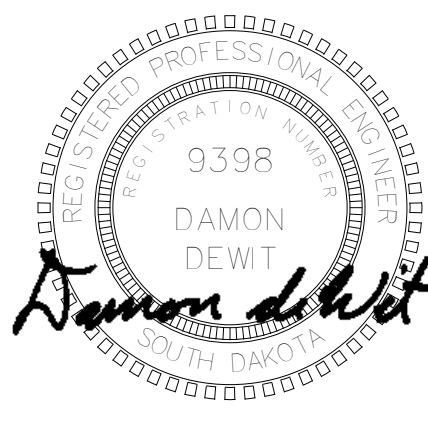

Associated  
Consulting  
Engineering,  
Incorporated

340 S. Phillips Ave.  
Sioux Falls, SD 57104

(605) 335-3720  
Fax 335-6220

E-mail acei@aceinet.net

ACEI PROJ. #123034

LENNOX HIGH SCHOOL ADDITION

FIRST FLOOR PLAN - AREA F - PLUMBING & HEATING

Project

number 0215.2902.22

date DECEMBER 21, 2023

revision

drawn DWM checked Dd

DATE DESCRIPTION


01-18-2024 Addendum #2

8.31-F








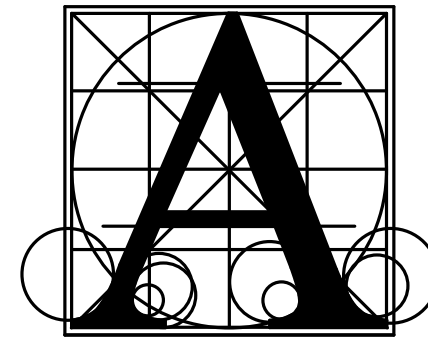

Architecture  
Incorporated

415 South Main Avenue  
P.O. Box 2140  
Sioux Falls, South Dakota 57101  
Phone: (605) 339-1711

815 St Joseph Street, Suite 203  
Rapid City, South Dakota 57701  
Phone: (605) 721-1158

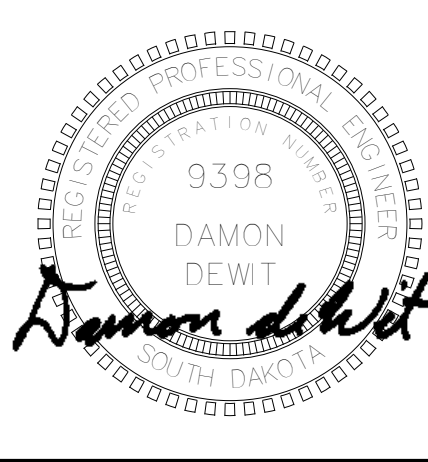

Associated  
Consulting  
Engineering,  
Incorporated

340 S. Phillips Ave.  
Sioux Falls, SD 57104  
(605) 335-3720  
Fax 335-6220  
E-mail acei@aceinet.net  
ACEI PROJ. #123034

Project  
LENNOX HIGH SCHOOL ADDITION  
SCHEDULES  
sheet contents

number	O215.2902.22
date	DECEMBER 21, 2023
revision	
drawn	DDK checked Dd
DATE	DESCRIPTION
01-11-2024	Addendum #1
01-18-2024	Addendum #2

8.50

ENERGY RECOVERY VENTILATOR SCHEDULE

UNIT NO.	MANUF.	MODEL NO.	SUPPLY AIR					EXHAUST AIR					HEAT WHEEL					OUTSIDE AIR					ROOM AIR					DISCHARGE AIR TEMP		COOLING CAPACITY					SUPPLY SIDE FILTER					EXHAUST SIDE FILTER					OPER. WT(LBS.)	REMARKS
			CFM	ESP	FAN HP	VOLT/PH	RPM	MCA	MOCF	CFM	ESP	FAN HP	VOLT/PH	RPM	MCA	MOCF	HP	VOLT/PH	RPM	MCA	MOCF	SUMMER DB/WB	WINTER DB/WB	SUMMER DB/WB	T. EFF. %	WINTER DB/WB	T. EFF. %	MBH	EWT/LWT	EAT	LAT	GPM	WPD	MERV	AREA(SF)	MAX FV	APD	THICK	MERV	AREA(SF)	MAX FV	APD	THICK			
ERV-1	VTS	AVS100-R-ERFCV / AVS100-L-FRV	11,000	1.5"	7.5(X2)	480/3	1730	MCA 23.8	MOCF 30.9	11,000	1.5"	5(X2)	480/3	1617	MCA 16.8	MOCF 21.8	1/2	115/1	5.7	15	95/74	-20/-20	74.0/62.0	68.0/47.0	77.9/64.4	76%	46.7/35.0	81%	348	45/55	77.9/64.4	55.0/53.7	72	9.16	13		513	0.83	2"	8		513	0.6	2"	3820	ALL
REMARKS: 1. PROVIDE SINGLE VARIABLE FREQ. DRIVES FOR DUAL FANS W/ MOTOR SHAFT GROUNDING RINGS. FAN VFD'S WILL BE BY TEMPERATURE CONTROL CONTRACTOR. WHEEL VFD TO BE INTEGRAL TO UNIT. 2. PROVIDE DIRECT DRIVE PREMIUM EFFICIENCY MOTORS. 3. COOLING COIL CAPACITIES BASED ON 60% WATER/40% PROPYLENE GLYCOL. 4. TOTAL ENERGY ALUMINUM WHEEL.																																														

AHU SCHEDULE

AHU NO.	MANUF.	MODEL NO.	CFM	MIN O/A CFM	ESP	TSP	FAN MHP	BHP	MOTOR VOLTS/PH	FAN TYPE/SIZE	RPM	MBH	EAT	LAT	FV	APD	EWT	LWT	GPM	WPD	COOLING COIL CAPACITY	MBH	EAT	LAT	FV	APD	EWT	LWT	GPM	WPD	HEATING COIL CAPACITY	MBH	EAT	LAT	FV	APD	EWT	LWT	GPM	WPD	FILTER TYPE	AREA(SF)	MAX FV	APD	THICK	OPER. WT(LBS)	REMARKS
AHU-10	DAIKIN	CAH032GDGM	15,500	5,500	2.50	4.56	20	16.24	480/3	DD, PLENUM/30	1495	635.7	82.0/67.2	54.0/53.6	522	0.92	44	56	112.9	11.8	919.4	43.1	100.4	541	0.21	180	150	64.1	8.8	MERV13	78.6	350	0.55	2"	5750	ALL											
AHU-11	DAIKIN	CAH010GDGM	4,200	1,140	1.50	3.17	5	3.40	480/3	DD, PLENUM/16	2656	163.1	81.1/66.3	53.7/53.2	457	0.69	44	56	28.9	11.7	180.3	50.7	92.2	487	0.18	180	150	12.6	3.8	MERV8	18.9	350	0.54	2"	2350	ALL											
AHU-12	DAIKIN	CAH018GDGM	8,500	3,665	1.50	3.65	10	7.00	480/3	DD, PLENUM/24	1568	391.4	83.6/68.5	53.8/53.5	498	0.89	44	56	67.8	16.1	656.6	36.5	111.1	523	0.37	180	150	45.4	9	MERV8	34.1	350	0.55	2"	3370	ALL											
AHU-13	DAIKIN	CAH014GDGM	6,200	1,460	1.50	3.29	7.5	4.59	480/3	DD, PLENUM/22	1611	235.7	81.6/66.0	53.7/53.1	467	0.71	44	56	41.6	11.9	291.8	53.6	99.1	498	0.24	180	150	20	1.8	MERV8	28.3	350	0.54	2"	3025	ALL											
REMARKS:																																															
1. HEATING COIL CAPACITIES ARE BASED ON 75% WATER/25% PROPYLENE GLYCOL. COOLING COIL CAPACITIES ARE BASED ON 60% WATER/40% PROPYLENE GLYCOL.																																															
2. FILTER APD AT MEAN LIFE.																																															
3. DIRECT DRIVE PLENUM FAN. FAN SPEED CONTROLLED WITH A VFD PROVIDED BY TEMPERATURE CONTROL CONTRACTOR. PROVIDE PREMIUM EFFICIENCY MOTOR.																																															
4. ACCESS SHALL BE PROVIDED INTO THE FILTER SECTION, BLENDER SECTION, BETWEEN THE HEATING AND COOLING COILS, AND FAN/PLENUM SECTION. PROVIDE 15 INCH (MIN.) DOORS AND 18 INCH (MIN.) SPACE BETWEEN COILS.																																															
PROVIDE HEAVY DUTY 18 GAUGE STAINLESS STEEL DRAIN PANS FOR COMPLETE DRAINAGE AND WALKING TRAFFIC.																																															
5. AIR HANDLER, ANGLED FILTER MIXING BOX, BLENDER, COOLING COIL, HEATING COIL, FAN/DISCHARGE PLENUM.																																															
6. PROVIDE LIGHTS IN ALL SECTIONS WITH DOORS EXCEPT IN BLENDER SECTION.																																															

BLOWER COIL UNIT SCHEDULE

UNIT NO.	MANUF.	MODEL NO.	TOTAL CFM	MIN O/A CFM	ESP	MOTOR			COOLING COIL							HEATING COIL							OPER. WEIGHT (LBS.)	REMARKS
						HP	RPM	V/PH	MBH	EAT	LAT	GPM	WPD	EWT	LWT	MBH	EAT	GPM	EWT	LWT	WPD			
BCU-G111	AAON	H3-BRB-3-0-28HC-12Q	1900	600	1.5	2	1760	480/3	70.4	82.0/66.2	53.3/53.3	14.5	25	44	56	143.3	46.1	10	180	150	14.9	700	ALL	
BCU-G117	AAON	H3-BRB-3-0-028HA-12H	1925	203	1.5	2	1760	480/3	59.2	82.1/63.1	52.0/51.9	11	16.2	44	56	108.7	61.4	7.5	180	150	2.2	670	ALL	

REMARKS:

1. HEATING COIL CAPACITIES ARE BASED ON 75% WATER/25% PROPYLENE GLYCOL. COOLING COIL CAPACITIES ARE BASED ON 60% WATER/40% PROPYLENE GLYCOL.

2. PROVIDE FACTORY INSTALLED VFD, SINGLE POINT POWER CONNECTION.

3. UNIT TO BE HUNG TIGHT TO STRUCTURE WITH ANTI-VIBRATION HANGING KIT. PROVIDE FLEXIBLE DUCT CONNECTIONS.

FAN SCHEDULE

FAN NO.	MANUF.	MODEL NO.	TYPE	LOCATION	CFM	S.P.	RPM	TIP SPEED (FPM)	MOTOR MHP	BHP	ELEC. VOLTS	PH	SONES	WEIGHT (LBS)	REMARKS
EF-F106	GREENHECK	SQ-120-VG	DD, INLINE	F106 JAN.	1225	0.4	1332	4578	1/2	0.2	120	1	6.3	70	2,3
EF-G111	GREENHECK	G-300-C-VGD	PRV	ROOF	12400	0.65	860	6867	5	4.31	480	3	25	470	1,4
REMARKS: 1. PROVIDE ROOF CURB, BACKDRAFT DAMPER. 2. PROVIDE ECM MOTOR, INTEGRAL ELECTRICAL DISCONNECT, FAN SPEED CONTROLLER. 3. PROVIDE ANTI-VIBRATION HANGING KIT AND FLEX DUCT CONNECTORS. 4. PROVIDE ECM MOTOR, INTEGRAL VFD, BACKNET CAPABILITIES.															

INTAKE AND RELIEF HOOD SCHEDULE

UNIT NO.	SERVES	MANUFACTURER	MODEL NO.	HOOD SIZE	THROAT SIZE	THROAT AREA	CFM	THROAT FPM	PD IN. WG.	REMARKS
IH-G119	AHU-13	GREENHECK	FGI	48/96	24/64	10.67	6,200	581	0.045	1
RH-F101	LOBBY	GREENHECK	FGR	43/48	32/32	7.11	3,400	478	0.055	2
RH-F102-1	GYM	GREENHECK	FGR	43/48	32/32	7.11	3,400	478	0.055	2
RH-F102-2	GYM	GREENHECK	FGR	43/48	32/32	7.11	3,400	478	0.055	2
RH-D118	STORAGE D118	GREENHECK	FGR	26/36	16/16	1.78	1,620	911	0.12	2,3
REMARKS: 1. PROVIDE INSULATED ROOF CURB, EXTENDED HEIGHT NECK, BIRD SCREEN, ALUMINUM CONSTRUCTION. 2. PROVIDE INSULATED ROOF CURB, STANDARD HEIGHT NECK, BIRD SCREEN, ALUMINUM CONSTRUCTION, ANTI CONDENSATE COATING ON HOOD. 3. PROVIDE PITCHED ROOF CURB. CONFIRM ROOF PITCH PRIOR TO ORDERING.										

LOUVER SCHEDULE

LVR NO.	MANUFACTURER	MODEL NO.	SIZE W X H X D	FREE AREA S.F.	CFM	VEL FPM	PD IN. WG.	REMARKS
LVR-E110	GREENHECK	ESD-635	72X36X6	10.14	11,000	1085	0.16	ALL
LVR-F106	GREENHECK	ESD-635	28X24X6	1.82	1,225	672	0.06	ALL
LVR-G207	GREENHECK	ESD-635	144X84X6	53.27	28,200	529	0.04	ALL
REMARKS: 1. COLOR BY ARCHITECT. 2. PROVIDE WITH BIRDSCREEN								

REGISTER GRILLE & DIFFUSER SCHEDULE

SYMBOL	MANUF.	CONSTR	MODEL NO.	MAX CFM	OVERALL SIZE	THROAT SIZE	NC	THROW	TOTAL PD (IN.W.G.)	FRAME	PATTERNS	REMARKS
D1	KRUEGER	S	1400	230	24/24	8"	26	12	0.08	LAY-IN	4-WAY	
D2	KRUEGER	S	1400	430	24/24	10"	26	17	0.08	LAY-IN	4-WAY	
G1	KRUEGER	A	EGC5	620	24/12	22/10	15	---	0.03	LAY-IN	1/2" GRID	
G2	KRUEGER	A	EGC5	1400	24/24	22/22	15	---	0.03	LAY-IN	1/2" GRID	
G3	KRUEGER	A	EGC5	250	10/10	8/8	21	---	0.07	SURFACE	1/2" GRID	
G4	KRUEGER	S	80H	200	10/10	8/8	20	20	0.07	SURFACE	1-WAY, 22.25" DEF.	1
G5	KRUEGER	S	S480H	4200	34/34	32/32	32	---	0.05	SURFACE	1-WAY, 0" DEF.	1
G6	KRUEGER	S	S480H	8500	74/32	72/30	34	---	0.05	SURFACE	1-WAY, 0" DEF.	1
G7	KRUEGER	S	S80H	4000	44/32	42/30	32	---	0.05	SURFACE	1-WAY	1
G8	KRUEGER	S	480	310	14/12	12/10	16	25	0.04	DUCT	1-WAY, 22.25" DEF.	
G9	KRUEGER	S	S480H	6200	40/42	38/40	34	---	0.05	SURFACE	1-WAY, 0" DEF.	1
G10	KRUEGER	S	480H	11000	74/42	72/40	35	---	0.05	SURFACE	1-WAY, 0" DEF.	1
G11	KRUEGER	S	480	935	20/16	18/14	27	59	0.07	DUCT	1-WAY	1
G12	KRUEGER	S	S480H	2370	50/16	48/14	28	---	0.04	SURFACE	1-WAY, 0" DEF.	1
G13	KRUEGER	S	S480H	2370	38/22	36/20	26	---	0.04	SURFACE	1-WAY, 0" DEF.	1
R1	KRUEGER	A	DMGDR	405	16/12	14/10	20	20	0.06	DUCT	DD, 22.5" DEF.	2
LEGEND: R - REGISTER G - GRILLE D - DIFFUSER  SD - SINGLE DEFLECTION DD - DOUBLE DEFLECTION  A - ALUMINUM CONSTRUCTION. S - STEEL CONSTRUCTION.												
GENERAL NOTES: 1. THROWS ARE BASED ON TERMINAL VELOCITIES AT 50 FPM. 2. NC VALUES ARE BASED UPON A 10dB ROOM ATTENUATION. 3. SEE SPECIFICATIONS FOR OPPOSED BLADE DAMPER REQUIREMENTS.												
REMARKS: 1. COLOR BY ARCHITECT. 2. PROVIDE WITH SCOOP DAMPER.												

HEATING COIL SCHEDULE

COIL NO.	SIZE	CFM	EAT	APD (IN.W.G.)	MBH	GPM	WPD	EWT	LWT	REMARKS
HC-D200	35X30	5,175	20	0.57	360.6	25	3.4	180	150	ALL
HC-E103	31X33	5,825	20	0.67	401	28	10.1	180	150	ALL
REMARKS: 1. COIL CAPACITIES ARE BASED ON 60% WATER/40% PROPYLENE GLYCOL.										

AIR COOLED CHILLER SCHEDULE

UNIT NO.	MANUF.	MODEL NO.	MBH CAPACITY	AMB AIR TEMP	EVAP. BUNDLE EWT	LWT	WPD	GPM	ELEC. VOLTS	PH	MCA	MFS	STEPS UNLOAD	EER	SOUND (dB)	OPER. WEIGHT	REMARKS
CH-1	DAIKIN	AGZ241E	2042.4	80	32	23	10.9	480.8	480	3	532	600	4	10.35	94	10,320	ALL
REMARKS: 1. CAPACITY IS BASED ON 60% WATER/40% PROPYLENE GLYCOL. 2. EER IS BASED ON AIR STANDARD CONDITIONS. 3. SOUND RATING BASED ON ANSI-370 OVERALL "A" WEIGHTED SOUND POWER LEVEL. 4. UNIT SHALL BE MOUNTED ON NEOPRENE OR SPRING TYPE VIBRATION ISOLATORS AS DESIGNED BY THE MANUFACTURER. 5. PROVIDE 6BK SCR RATING.																	

DUCTLESS SPLIT SYSTEM SCHEDULE

UNIT NO.	SERVES	MANUF.	MODEL NO.	MATCHED UNIT	CFM	ELEC. VOLTS	PH	MCA	MOCF	CAPACITY MBH	OPER. WT. (LBS)	REMARKS
DSS-G204	ELEC. G204	DAIKIN	FTXS36LVJURKS36LVJU	CU-G204	770/635/519/473	208	1	19.5	20	36	40	1
REMARKS: 1. WALL MOUNT DUCTLESS SPLIT SYSTEM COOLING UNIT. WIRED THERMOSTAT. 2. EXTEND CONDENSATE OUT WALL ONTO ADJACENT ROOF. 3. INDOOR UNIT IS POWERED THRU THE OUTDOOR UNIT.												

CONDENSING UNIT SCHEDULE

UNIT NO.	MANUF.	MODEL NO.	MATCHED UNIT	CAPACITY (NOM.TON)	CAPACITY MBH	AMB.AIR TEMP.	ELECTRICAL VOLTS	PH	MCA	FLA	MOCF	MIN EER	OPER. WT.(LBS)	REMARKS
CU-G204	DAIKIN	RKS36LVJU	DSS-G204	36	36	95	208	1	19.5	---	20	8.37	180	1,2
REMARKS: 1. 40 DEG. AMBIENT OPERATION W/ MANUFACTURERS RECOMMENDED ACCESSORIES, REF. LINE SETS, 5 YEAR COMPRESSOR WARRANTY. 2. INVERTER COMPRESSOR 3. INDOOR UNIT IS POWERED THRU THE OUTDOOR UNIT.														

1/19/2024 11:39:47 AM

 **SITE DEMOLITION PLAN - ELECTRICAL**  
SCALE 0 10 20 30 40

EXISTING LENNOX  
HIGH SCHOOL


EXISTING  
FLAG  
POLE

#### ELECTRICAL NOTES

1. RELOCATE EXISTING SITE LIGHT, POLE AND BASE. REWORK EXISTING UNDERGROUND CIRCUIT AS REQUIRED TO CONNECT TO REMAINING SITE LIGHTS.
2. SALVAGE EXISTING SITE LIGHT, POLE AND BASE TO OWNER. REWORK EXISTING UNDERGROUND CIRCUIT AS REQUIRED TO CONNECT REMAINING SITE LIGHTS.

#### GENERAL DEMOLITION SHEET NOTES


- A. DEMO HATCHED ITEMS.
- B. PERFORM ALL DEMOLITION WORK AS REQUIRED AND REMODELING WORK AS SHOWN ON THE DRAWINGS INCLUDING MINOR ITEMS OF MATERIAL OR EQUIPMENT NECESSARY TO MEET THE REQUIREMENTS AND INTENT OF THE PROJECT.
- C. PRIOR TO SUBMITTING BID, CONTRACTOR SHALL EXAMINE ALL GENERAL CONSTRUCTION DRAWINGS AND SHOULD HAVE HAD VISITED THE CONSTRUCTION SITE. THE CONTRACTOR SHALL BE FAMILIAR WITH THE EXISTING CONDITIONS UNDER WHICH HE/SHE WILL HAVE TO OPERATE AND WHICH WILL IN ANY WAY AFFECT THE WORK UNDER THIS CONTRACT IN BEHALF OF THE CONTRACTOR FOR ANY ERROR OR NEGLIGENCE ON HIS/HER PART.
- D. CERTAIN REMODELING OF ELECTRICAL FACILITIES WILL BE REQUIRED IN THE EXISTING BUILDING. EXISTING CONDUIT RUNS ARE GENERALLY NOT SHOWN. ALTHOUGH A FULL ATTEMPT HAS BEEN MADE TO SHOW SOME EXISTING CONDITIONS, OF WHICH INFORMATION HAS BEEN TAKEN FROM EXISTING RECORD DRAWINGS OF THIS PROJECT. THE DRAWINGS SHOWING LOCATIONS OF EXISTING EQUIPMENT, OUTLETS, FIXTURES, ETC. IN EXISTING AREA ARE APPROXIMATE ONLY (FIELD VERIFY).
- E. BRANCH CIRCUITS SHALL BE REUSED WHERE PRACTICAL AND SHALL, IN ADDITION, BE REMODELED AS REQUIRED. THE CONTRACTOR SHALL CONCEAL ALL WORK WHERE POSSIBLE. WHERE EXPOSED WORK IS REQUIRED IN FINISHED AREAS, THE CONTRACTOR SHALL USE SURFACE MOUNTED, MULTI-OUTLET RACEWAY, PANDUIT T70 SERIES. EXISTING RUNS SHALL BE VERIFIED.
- F. EXISTING ELECTRICAL WIRING WHICH WILL NOT BE MADE OBSOLETE AND WHICH WILL BE DISTURBED DUE TO CONSTRUCTION CHANGES REQUIRED BY THIS CONTRACT SHALL BE RESTORED TO OPERATING CONDITION, AS REQUIRED AND/OR DIRECTED. WHERE REQUIRED, SHOWN AND/OR DIRECTED. OUTLETS AND CONDUIT RUNS SHALL BE RELOCATED. IN SOME CASES, IT MAY BE NECESSARY TO EXTEND CONDUITS AND PULL IN NEW WIRING OR INSTALL JUNCTION BOXES AND SPICE IN NEW WIRING OR REPLACE OLD WIRING WITH NEW.
- G. OUTLETS FROM WHICH FIXTURES, SWITCHES, RECEPTACLES, AND/OR OTHER ELECTRICAL DEVICES ARE MOVED AND WHICH ARE NOT REPLACED OR REUSED SHALL BE REMOVED OR, IF NOT POSSIBLE, PROVIDED WITH A BLANK PLATE ON THE OUTLET BOX. WHERE OUTLETS, BOXES, ETC. ARE COMPLETELY REMOVED, THE CONTRACTOR SHALL CUT OFF CONDUITS AND REMOVE WIRING.
- H. WHERE EXISTING LIGHT FIXTURES ARE TO BE RE-USED, THE CONTRACTOR SHALL CLEAN THE FIXTURES AND REPLACE LAMPS. THE CONTRACTOR SHALL ALSO REPAIR OR REPLACE DEFECTIVE PARTS, INCLUDING LENSES, BALLASTS, ETC. AS REQUIRED SO THAT THE FIXTURES ARE FUNCTIONING CORRECTLY.
- I. WHERE CONDUITS EXTENDING THROUGH FLOORS ARE TO BE ABANDONED, THE CONTRACTOR SHALL CUT AND CAP OR PLUG CONDUIT, SO THAT IT WILL NOT PROTRUDE ABOVE THE FLOOR.
- J. WHERE EXISTING CONDUIT IS TO BE ABANDONED, THE CONDUIT SHALL BE REMOVED IF IT IS EXPOSED, INTO A CRAWL SPACE OR ACCESSIBLE CEILING. WHERE IT IS IMPOSSIBLE TO REMOVE THE CONDUIT, IT SHALL BE CUT OFF AND CAPPED OR PLUGGED.
- K. THE CONTRACTOR SHALL BE HELD RESPONSIBLE FOR THE PROPER RESTORATION OF ALL EXISTING SURFACES REQUIRING PATCHING, PLASTERING, PAINTING AND/OR OTHER REPAIR DUE TO THE INSTALLATION OF ELECTRICAL WORK UNDER THE TERMS OF THIS CONTRACT. CLOSE ALL OPENINGS, REPAIR ALL SURFACES, ETC. AS REQUIRED.
- L. THE CONTRACTOR SHALL EMPLOY QUALIFIED AND EXPERIENCED WORKMEN FOR THIS WORK. ALL RESTORATION WORK SHALL BE SUBJECT TO THE APPROVAL OF THE ARCHITECT AND/OR THE OWNER.
- M. ALL TEMPORARY AND REMODELING WORK SHALL BE CONSIDERED A PART OF THIS CONTRACT AND NO EXTRA CHARGES WILL BE ALLOWED. THIS SHALL INCLUDE MINOR ITEMS OF MATERIAL OR EQUIPMENT NECESSARY TO MEET THE REQUIREMENTS AND INTENT OF THE PROJECT.
- N. EXAMINE ARCHITECTURAL, STRUCTURAL AND MECHANICAL DRAWINGS AND SPECIFICATIONS TO DETERMINE THE SEQUENCE OF CONSTRUCTION THROUGHOUT THE PROJECT, INCLUDING EXISTING, TEMPORARY, REMODELED AND NEW AREAS.
- O. THE OWNER RESERVES THE RIGHT TO RETAIN ANY SELECTED SALVAGE ITEMS. ALL OTHER ITEMS SHALL BE THE CONTRACTORS RESPONSIBILITY FOR LEGAL DISPOSAL.

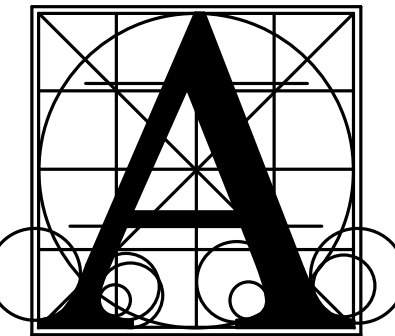

**Architecture  
Incorporated**

415 South Main Avenue  
P.O. Box 2140  
Sioux Falls, South Dakota 57101  
Phone: (605) 339-1711

815 St Joseph Street, Suite 203  
Rapid City, South Dakota 57701  
Phone: (605) 721-1158

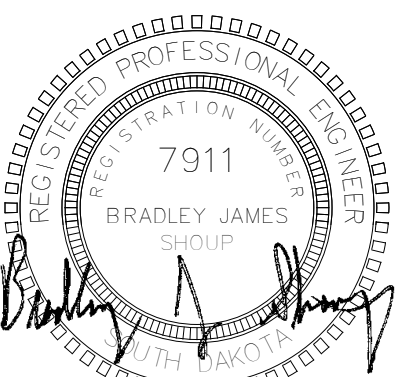

**A ssociated  
C onsulting  
E ngineering,  
I ncorporated**

340 S. Phillips Ave.  
Sioux Falls, SD 57104

(605) 335-3720  
Fax 335-6220  
E-mail acei@aceinet.com

ACEI PROJ. #123034

Project

number 0215.2902.22  
date DECEMBER 21, 2023  
revision  
drawn KMT checked BJS


DATE	DESCRIPTION
01-18-2024	Addendum #2

**9.10**

**LENNOX HIGH SCHOOL ADDITION**


**SITE DEMOLITION PLAN - ELECTRICAL**

1/19/2024 11:40:15 AM

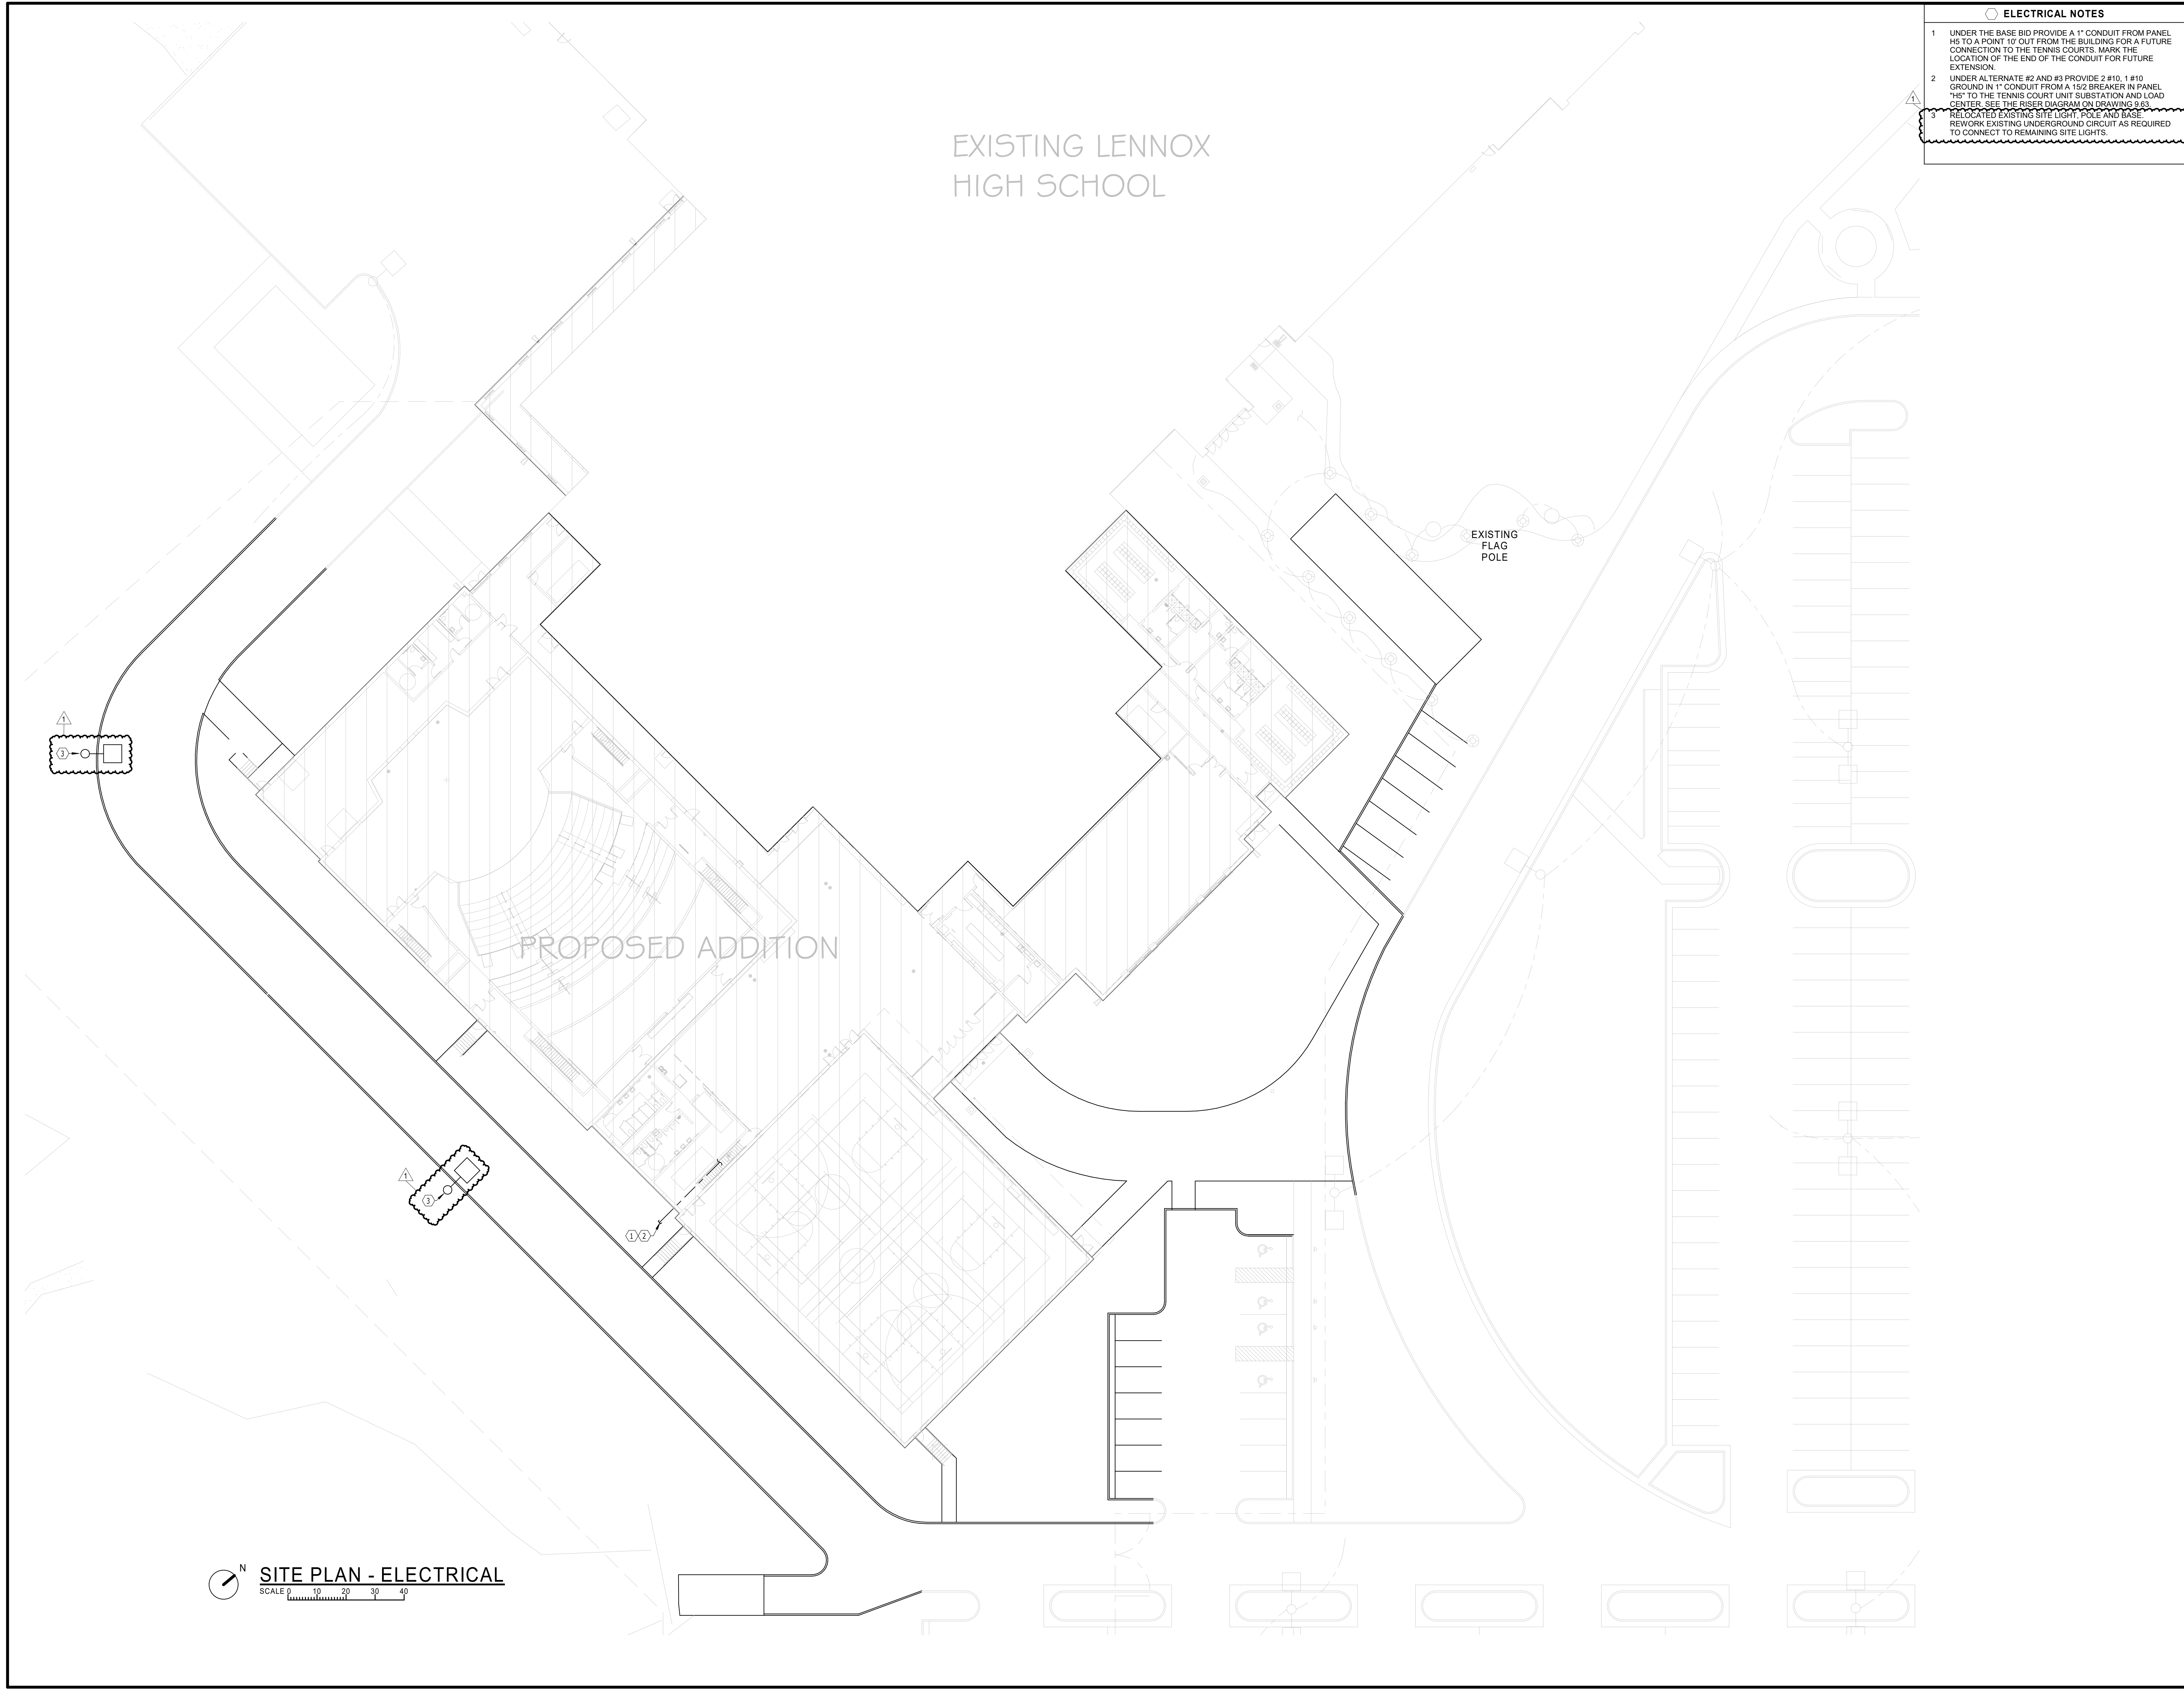

ELECTRICAL NOTES


1. UNDER THE BASE BID PROVIDE A 1" CONDUIT FROM PANEL HS TO A POINT 10' OUT FROM THE BUILDING FOR A FUTURE CONNECTION TO THE TENNIS COURTS. MARK THE LOCATION OF THE END OF THE CONDUIT FOR FUTURE EXTENSION.
2. UNDER ALTERNATE #2 AND #3 PROVIDE 2 #10, 1 #10 GROUND IN 1" CONDUIT FROM A 15/2 BREAKER IN PANEL #H5 TO THE TENNIS COURT UNIT SUBSTATION AND LOAD CENTER. SEE THE RISEP DIAGRAM ON DRAWING 9.63.
3. RELOCATED EXISTING SITE LIGHT, POLE AND BASE. REWORK EXISTING UNDERGROUND CIRCUIT AS REQUIRED TO CONNECT TO REMAINING SITE LIGHTS.

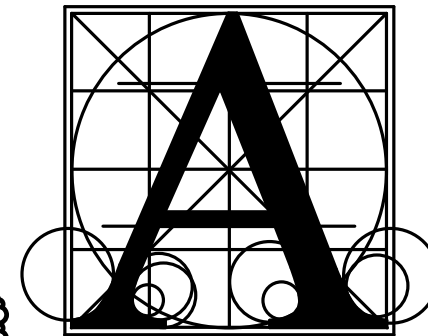

Architecture Incorporated

415 South Main Avenue  
P.O. Box 2140  
Sioux Falls, South Dakota 57101  
Phone: (605) 339-1711

815 St Joseph Street, Suite 203  
Rapid City, South Dakota 57701  
Phone: (605) 721-1158

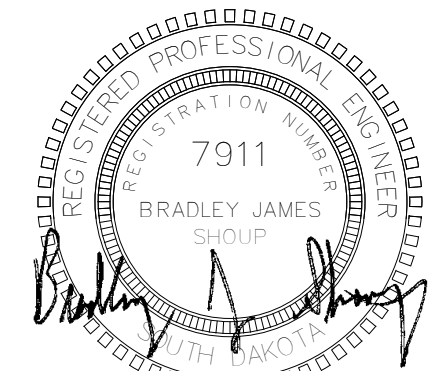

Associated Consulting Engineering, Incorporated

340 S. Phillips Ave.  
Sioux Falls, SD 57104

(605) 335-3720  
Fax 335-8220  
E-mail acei@aceinet.com

ACEI PROJ. #123034

Project

LENNOX HIGH SCHOOL ADDITION

Sheet Contents


SITE PLAN - ELECTRICAL

number	0215.2902.22
date	DECEMBER 21, 2023
revision	
drawn	KMT
checked	BJ5

DATE	DESCRIPTION
01-18-2024	Addendum #2



1/10/2024 3:20:21 PM

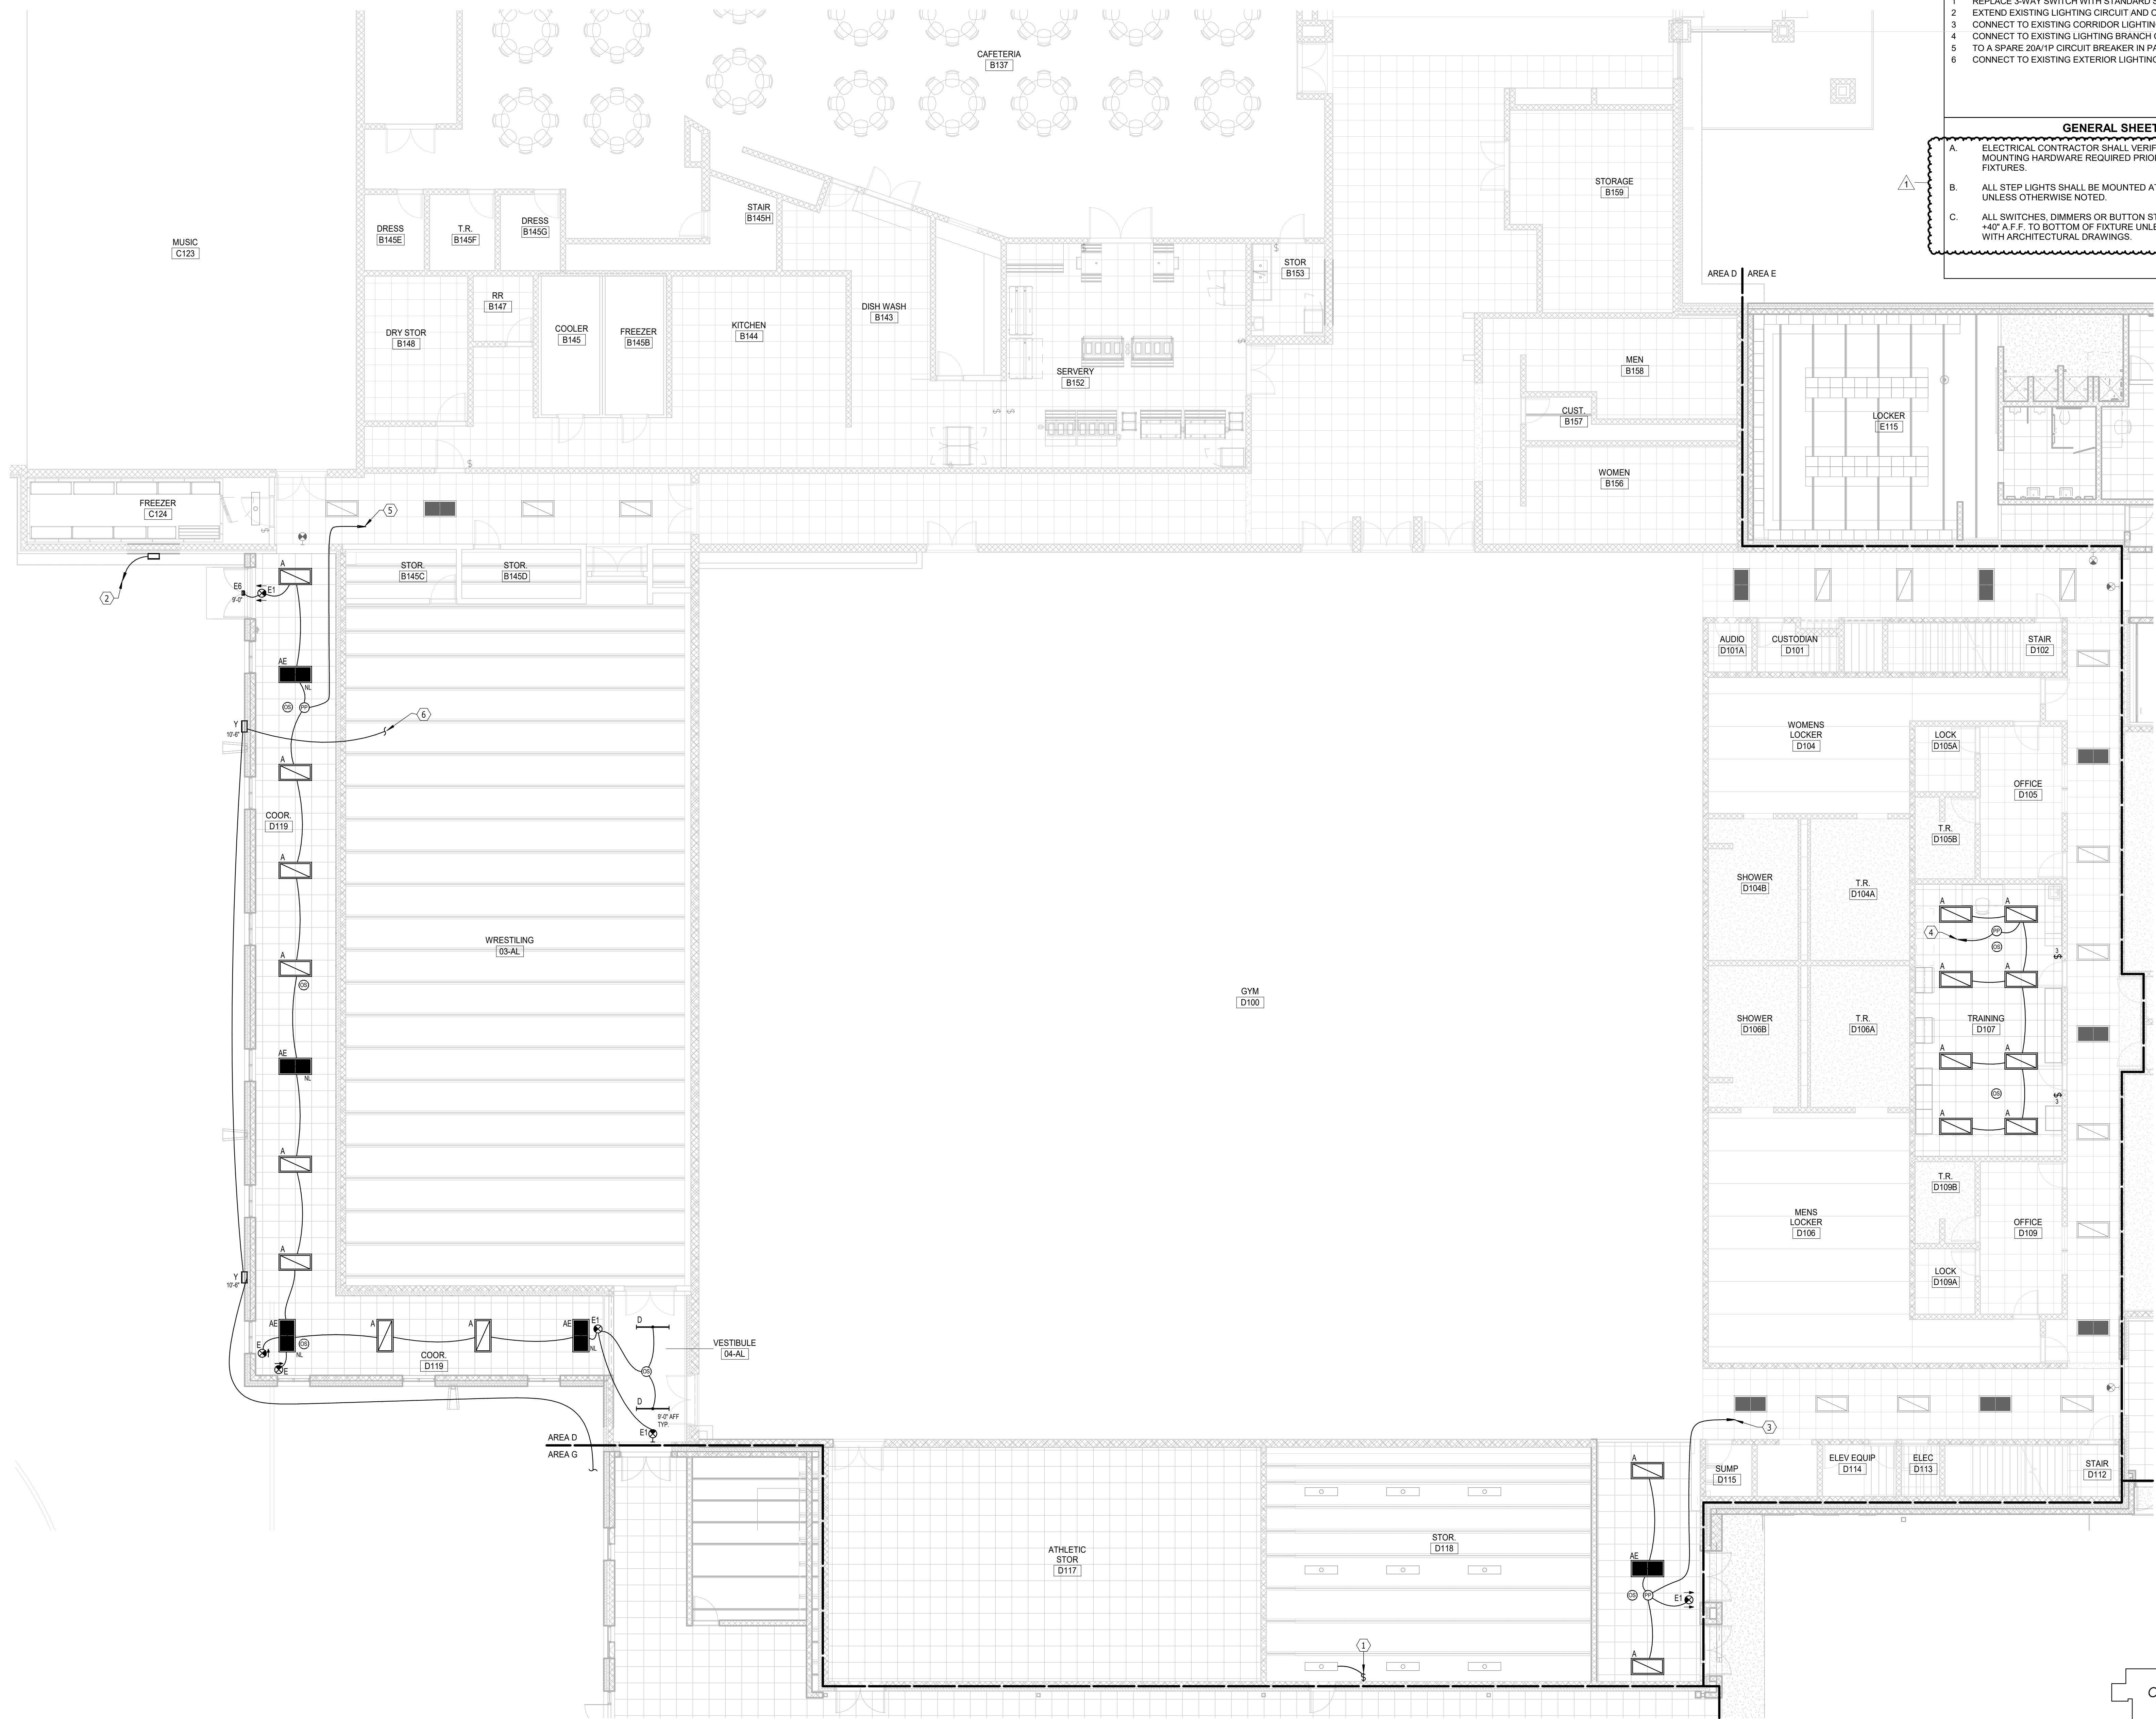


ELECTRICAL NOTES

1. REPLACE 3-WAY SWITCH WITH STANDARD SWITCH.
2. EXTEND EXISTING LIGHTING CIRCUIT AND CONTROL.
3. CONNECT TO EXISTING CORRIDOR LIGHTING CONTROL PANEL "LCP2".
4. CONNECT TO EXISTING LIGHTING BRANCH CIRCUIT SERVING THIS AREA.
5. TO A SPARE 20A/1P CIRCUIT BREAKER IN PANEL "H3".
6. CONNECT TO EXISTING EXTERIOR LIGHTING BRANCH CIRCUIT.

GENERAL SHEET NOTES


- A. ELECTRICAL CONTRACTOR SHALL VERIFY ALL CEILING TYPES, AND MOUNTING HARDWARE REQUIRED PRIOR TO PURCHASE OF ANY LIGHTING FIXTURES.
- B. ALL STEP LIGHTS SHALL BE MOUNTED AT +2'-0" A.F.F. TO CENTER OF FIXTURE UNLESS OTHERWISE NOTED.
- C. ALL SWITCHES, DIMMERS OR BUTTON STATIONS SHALL BE MOUNTED AT +40" A.F.F. TO BOTTOM OF FIXTURE UNLESS OTHERWISE NOTED. CONFIRM WITH ARCHITECTURAL DRAWINGS.

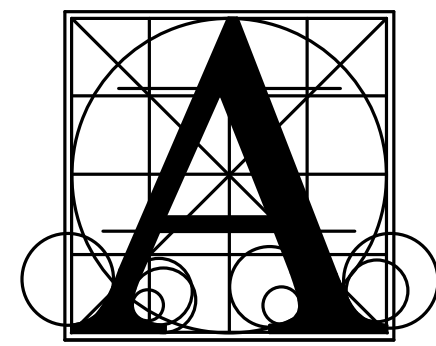

Architecture  
Incorporated

415 South Main Avenue  
P.O. Box 2140  
Sioux Falls, South Dakota 57101  
Phone: (605) 339-1711

815 St. Joseph Street, Suite 203  
Rapid City, South Dakota 57701  
Phone: (605) 721-1158

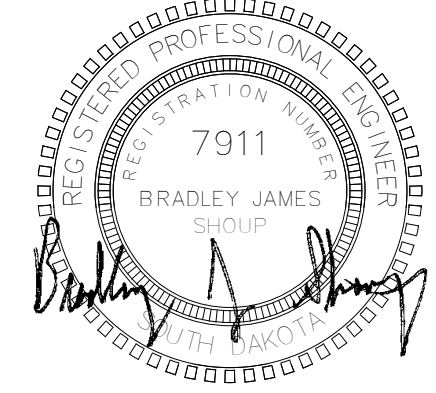

Associated  
Consulting  
Engineering,  
Incorporated

340 S. Phillips Ave.  
Sioux Falls, SD 57104  
(605) 335-3720  
Fax 335-6220  
E-mail acei@aceinet.net  
ACEI PROJ. #123034

LENNOX HIGH SCHOOL ADDITION


FIRST FLOOR PLAN - AREA D - LIGHTING

Project

number 0215.2902.22  
date DECEMBER 21, 2023  
revision  
drawn KMT checked BJS


DATE DESCRIPTION  
01-18-2024 Addendum #2

9.40-D

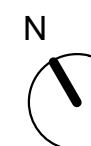


FIRST FLOOR PLAN - AREA D - LIGHTING


SCALE 0 4 8 12 16

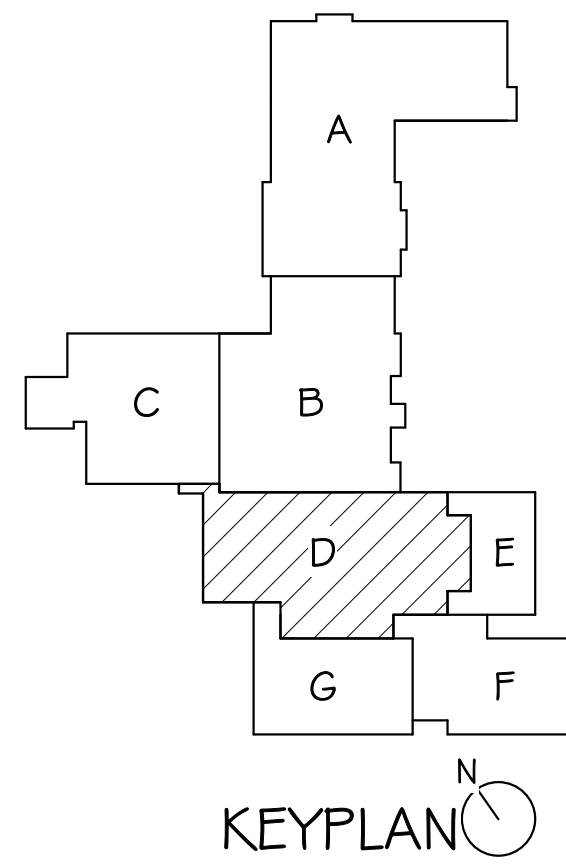

1/18/2024 3:20:26 PM

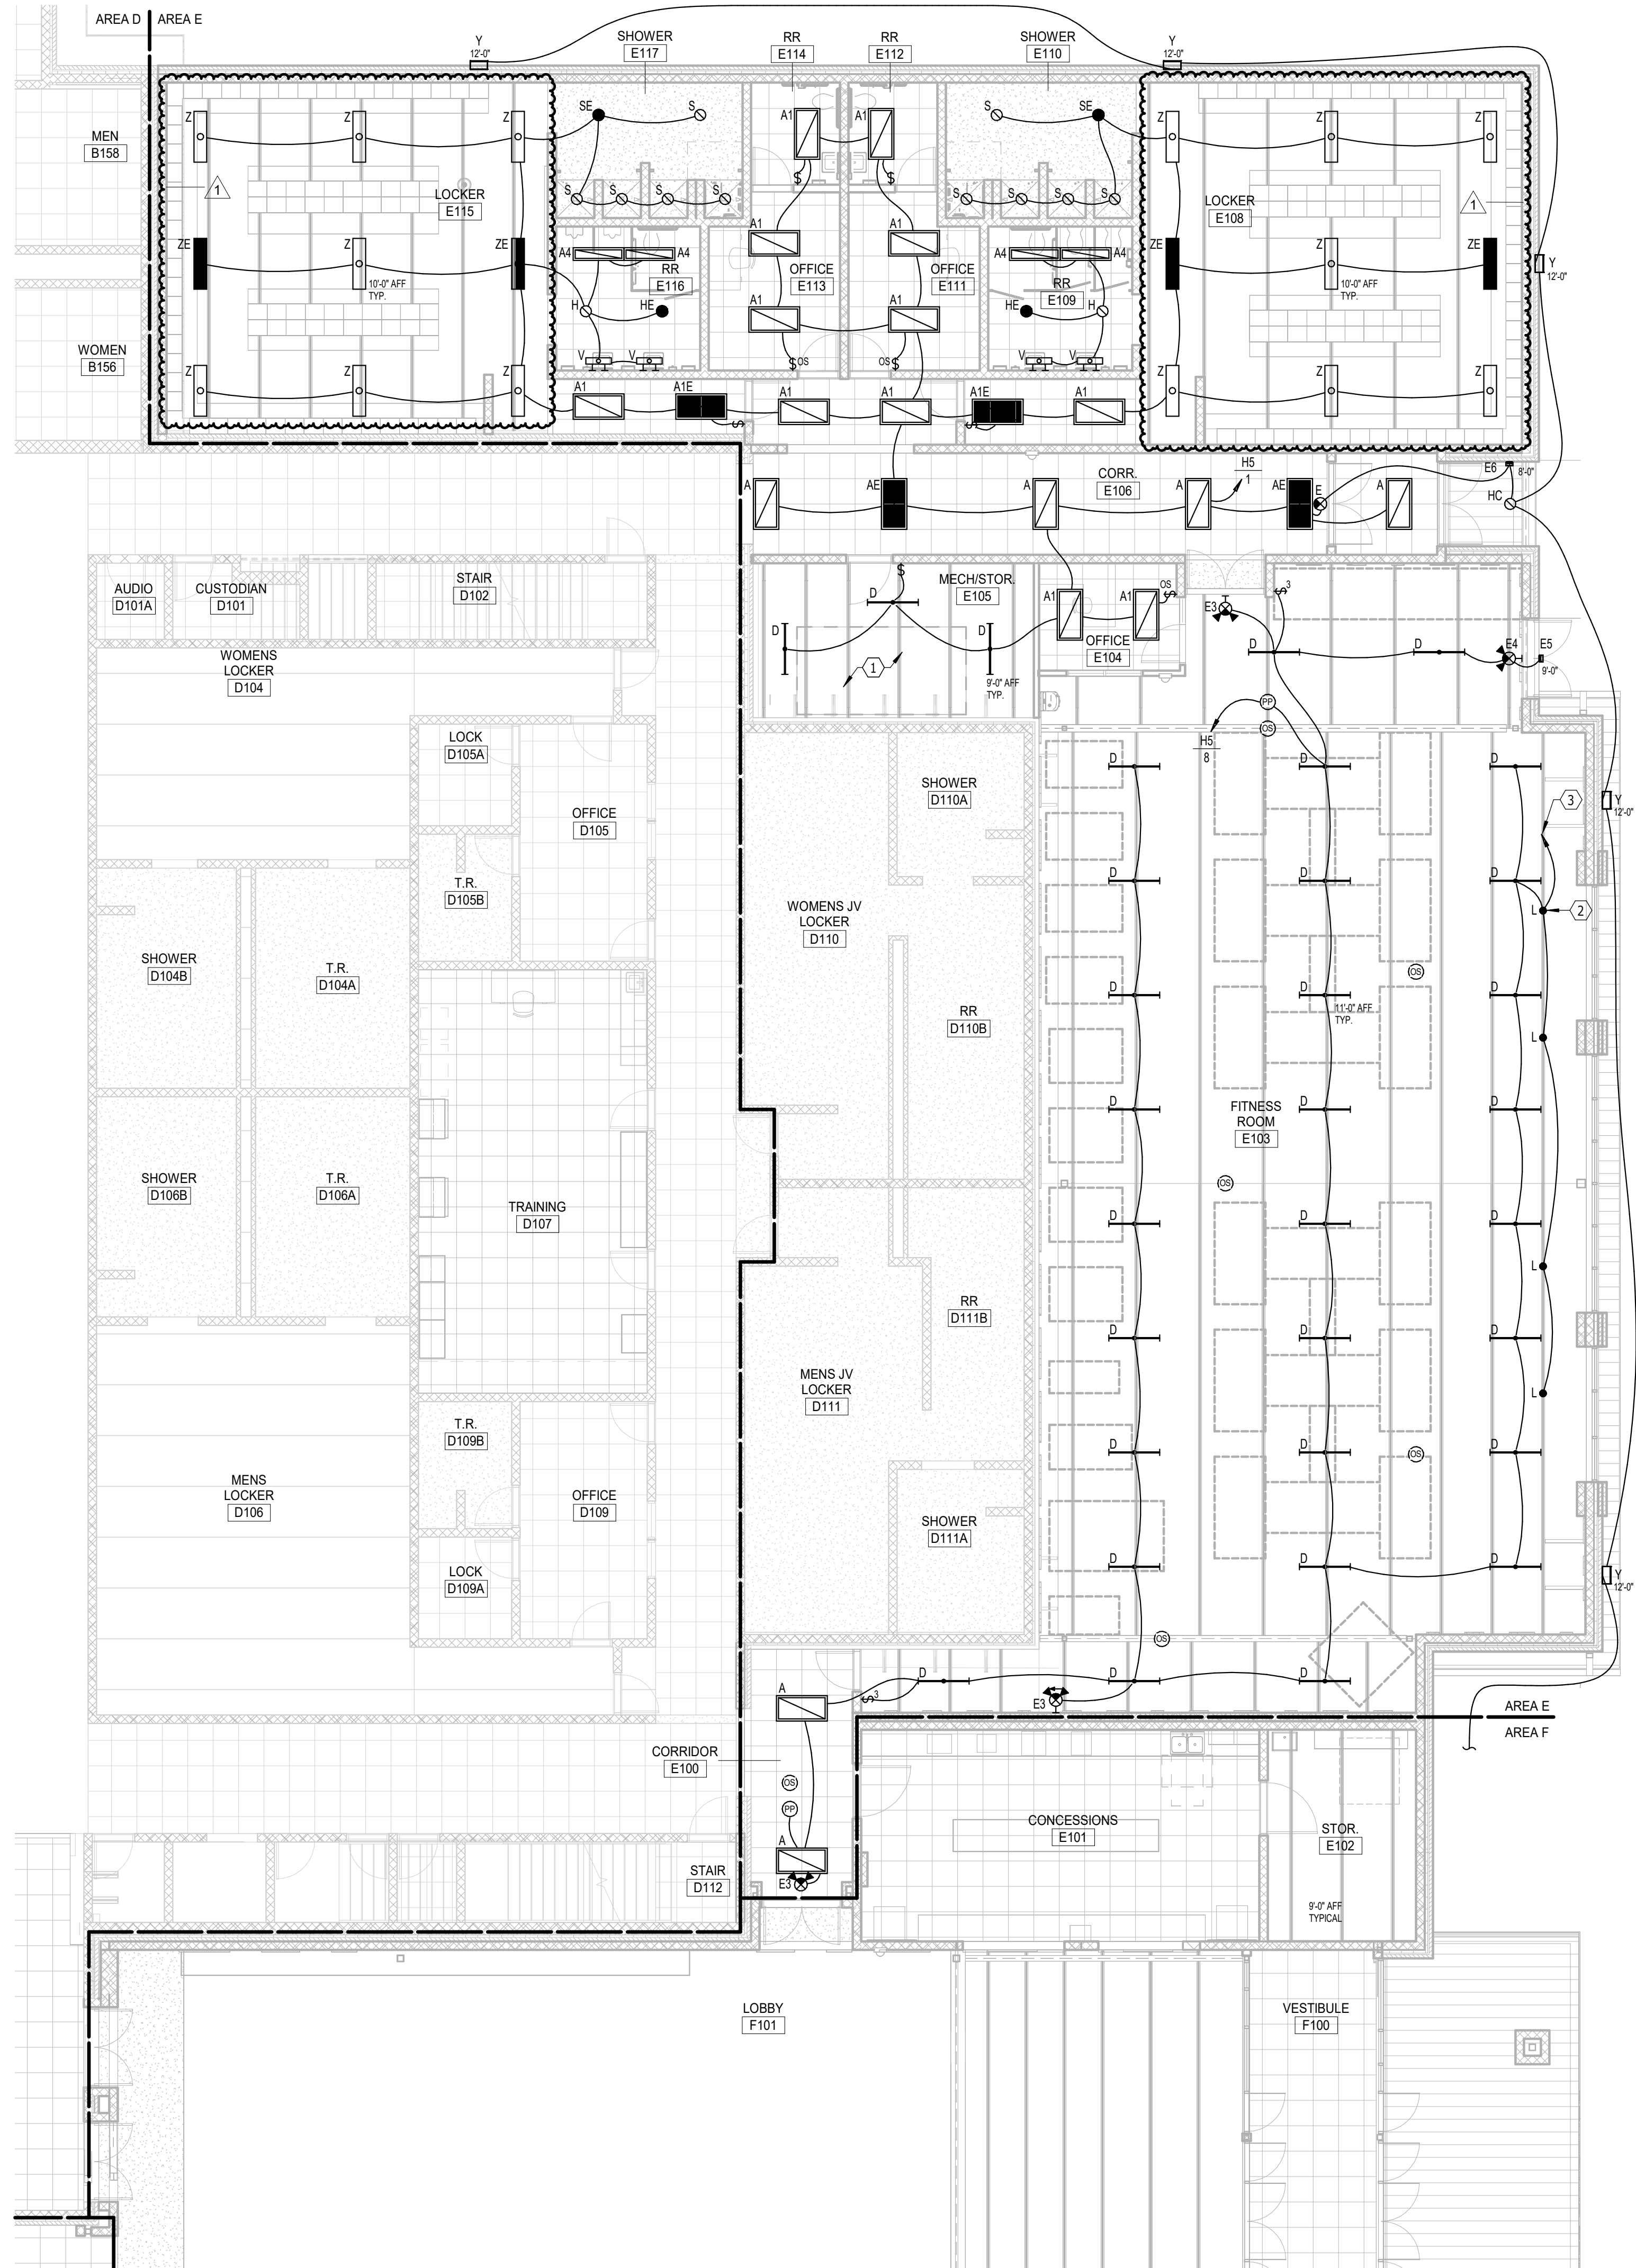

N  
SCALE 0 4 8 12 16  
**FIRST FLOOR PLAN - AREA E - LIGHTING**

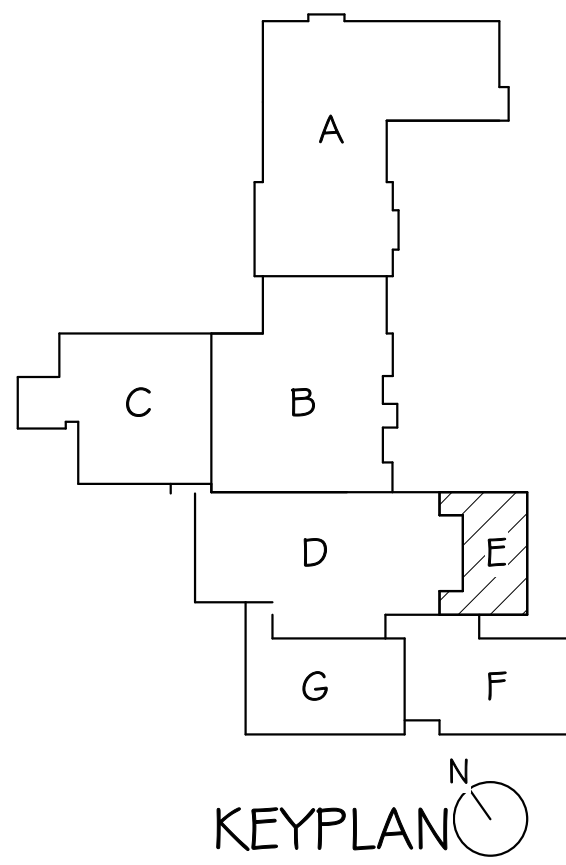


**ELECTRICAL NOTES**

- COORDINATE LIGHTING INSTALLATION WITH MECHANICAL EQUIPMENT, SHIFT AS NECESSARY.
- MOUNT FIXTURES TO BOTTOM OF JOISTS, TYPICAL OF (4).
- CONTROL FLOODLIGHTS THRU DIGITAL TIMECLOCK.

**GENERAL SHEET NOTES**


- ELECTRICAL CONTRACTOR SHALL VERIFY ALL CEILING TYPES, AND MOUNTING HARDWARE REQUIRED PRIOR TO PURCHASE OF ANY LIGHTING FIXTURES.
- ALL STEP LIGHTS SHALL BE MOUNTED AT +2'-0" A.F.F. TO CENTER OF FIXTURE UNLESS OTHERWISE NOTED.
- ALL SWITCHES, DIMMERS OR BUTTON STATIONS SHALL BE MOUNTED AT +4'-0" A.F.F. TO BOTTOM OF FIXTURE UNLESS OTHERWISE NOTED. CONFIRM WITH ARCHITECTURAL DRAWINGS.

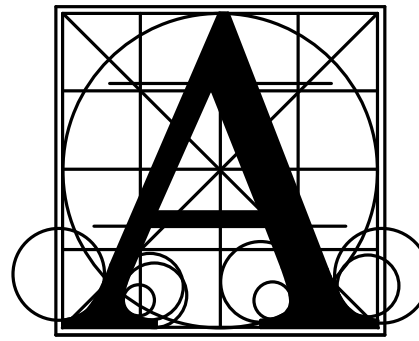

**Architecture  
Incorporated**

415 South Main Avenue  
P.O. Box 2140  
Sioux Falls, South Dakota 57101  
Phone: (605) 339-1711

815 St. Joseph Street, Suite 203  
Rapid City, South Dakota 57701  
Phone: (605) 721-1158

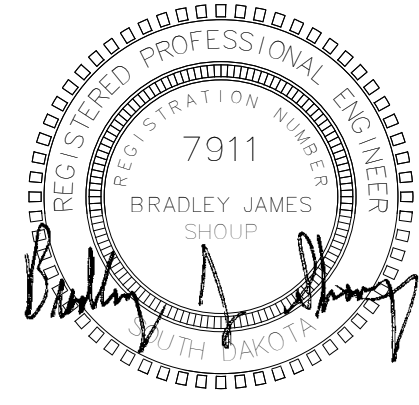

**Associated  
Consulting  
Engineering,  
Incorporated**




340 S. Phillips Ave.  
Sioux Falls, SD 57104  
(605) 335-3720  
Fax 335-6220  
E-mail acei@aceinet.com  
ACEI PROJ. #123034

**LENNOX HIGH SCHOOL ADDITION**  
**FIRST FLOOR PLAN - AREA E - LIGHTING**

Project	number	0215.2902.22
	date	DECEMBER 21, 2023
	revision	
	drawn	KMT
	checked	BJ5
DATE	DESCRIPTION	
01-18-2024	Addendum #2	

**9.42-E**



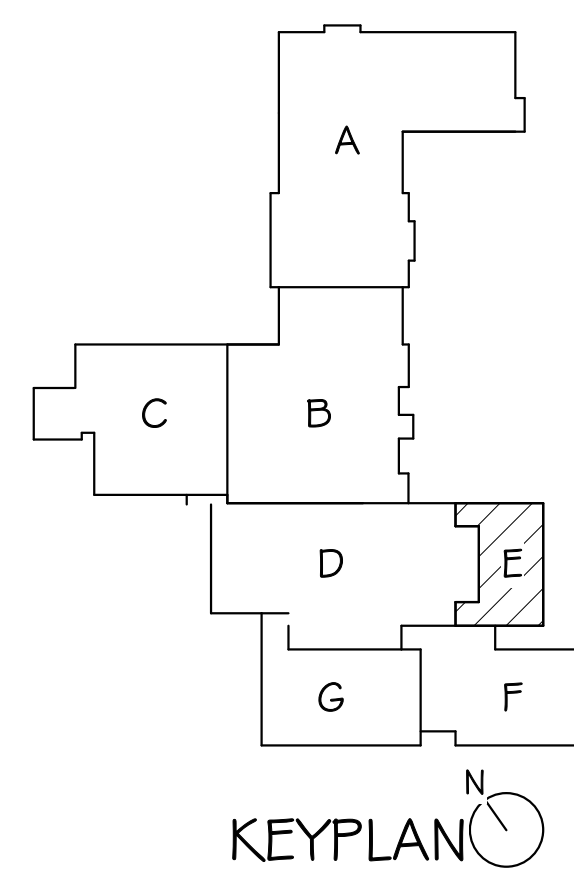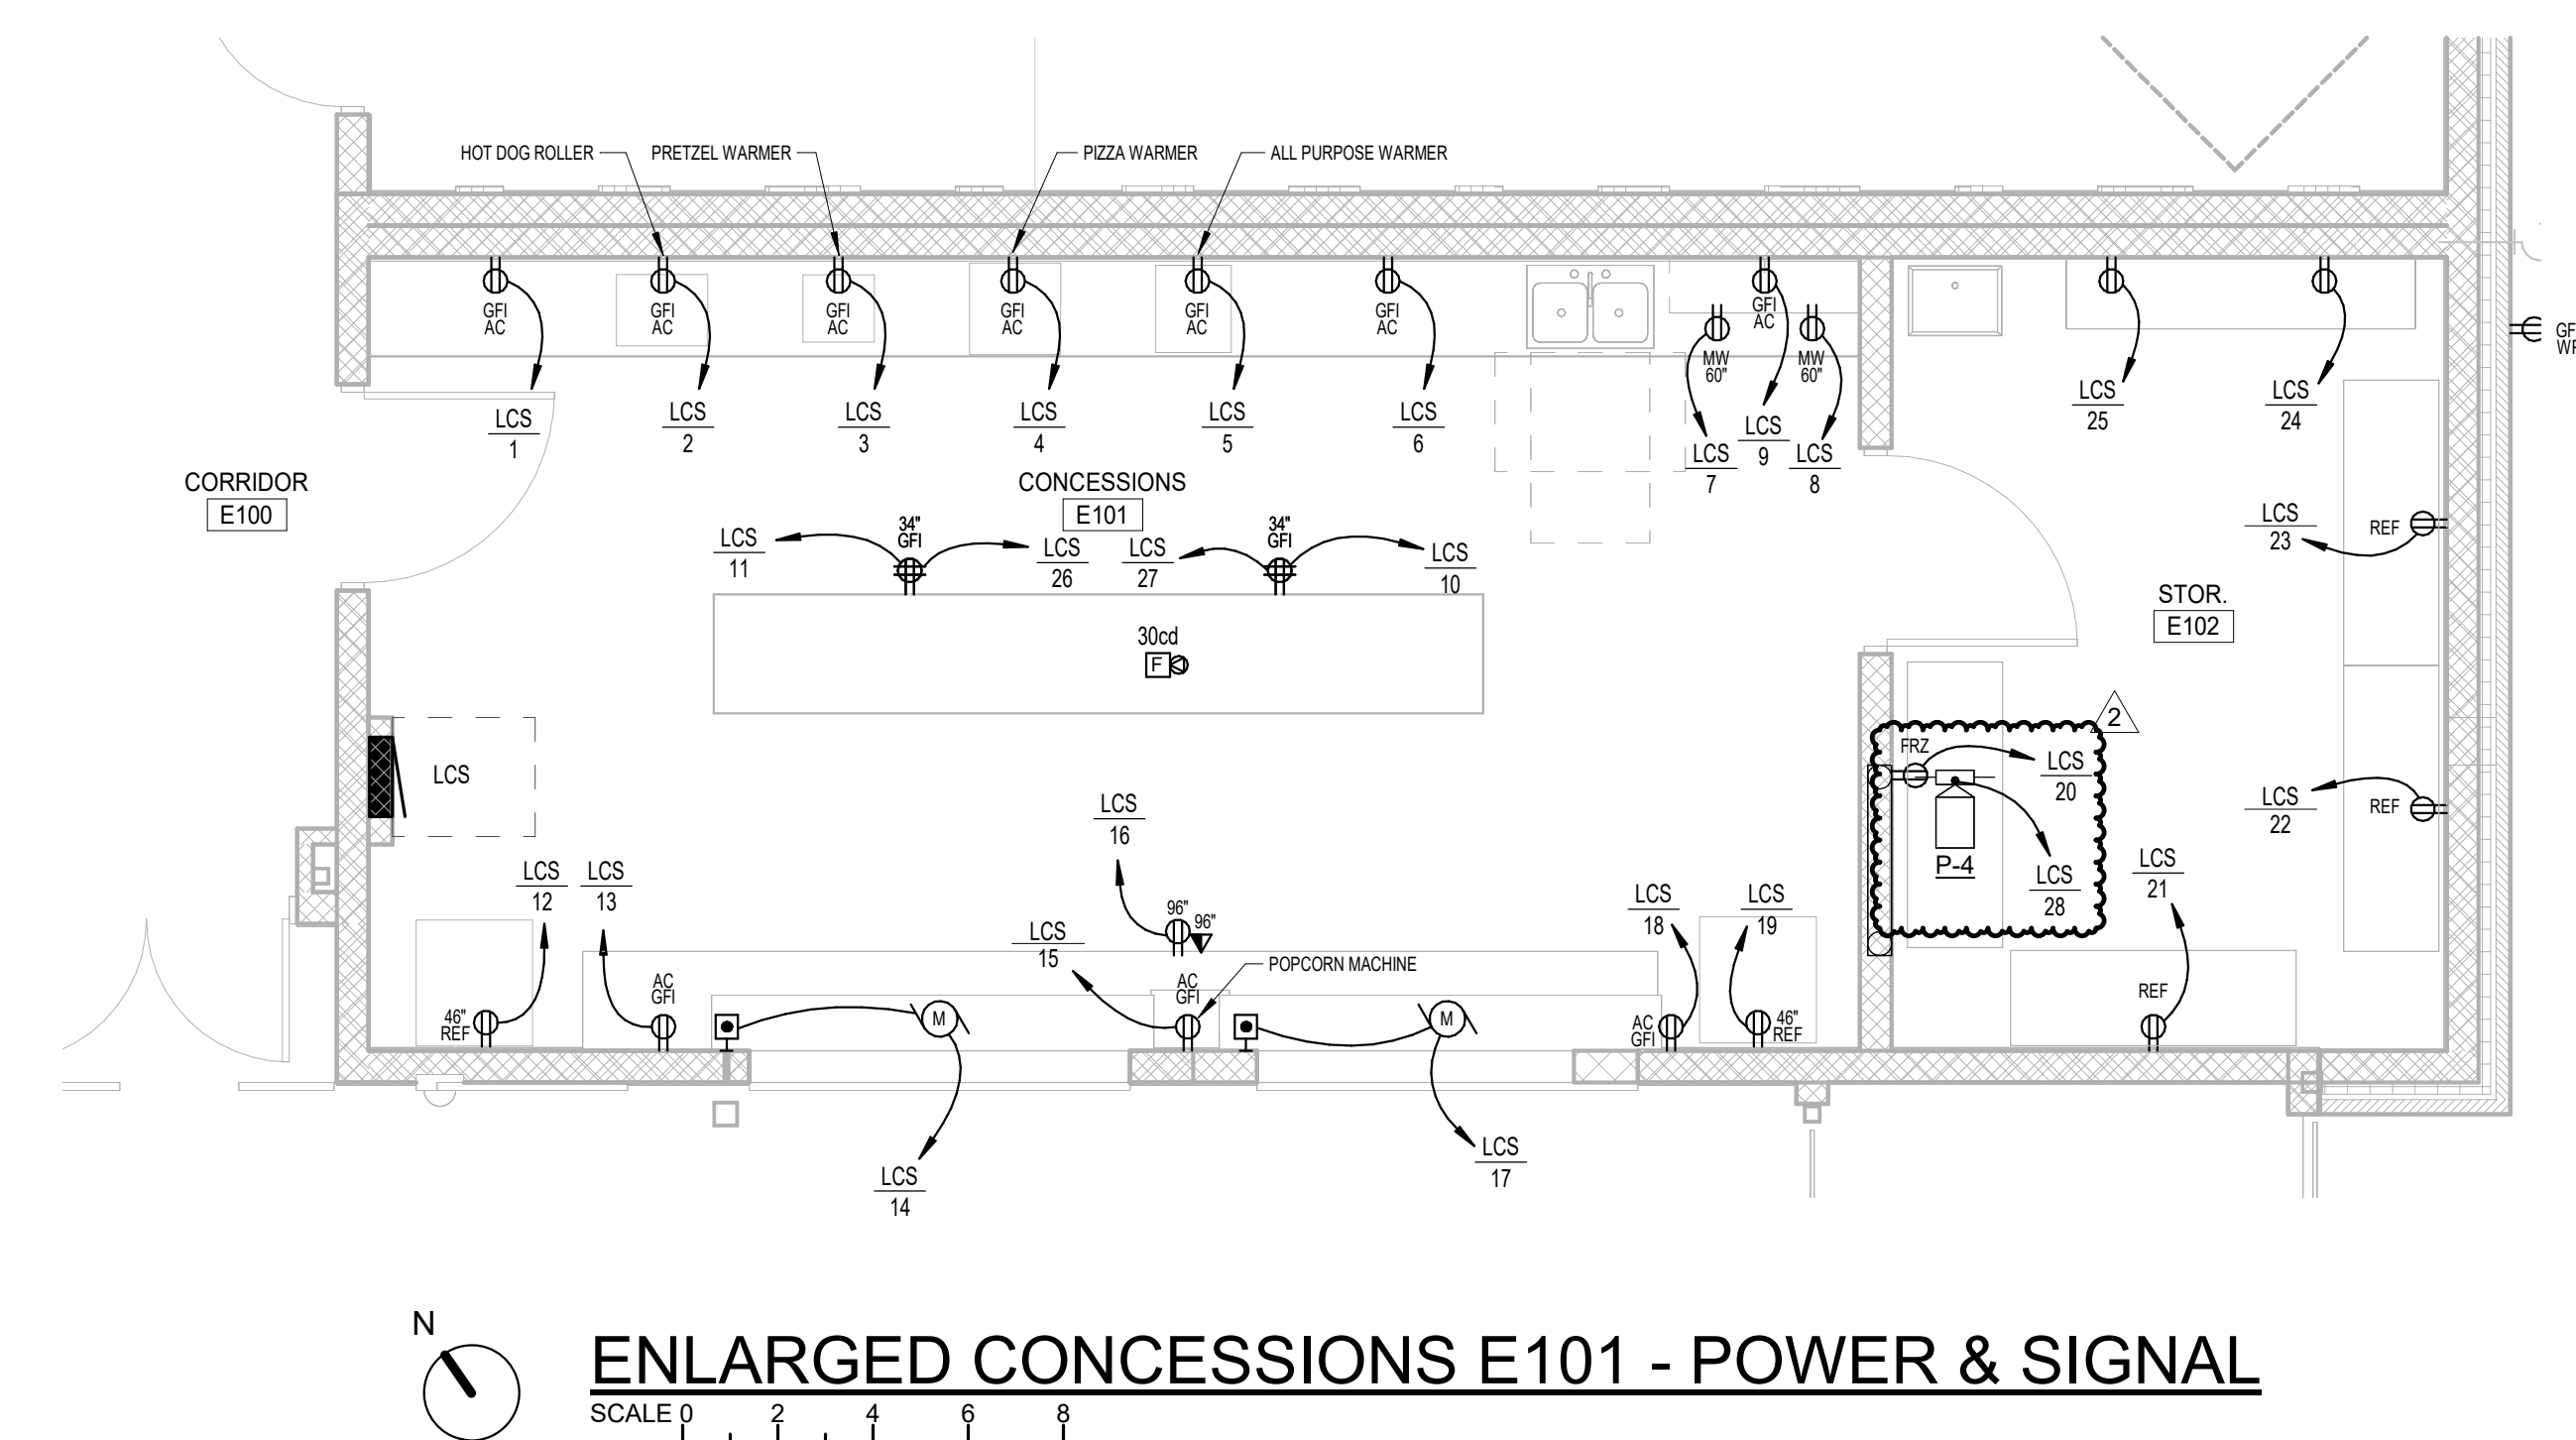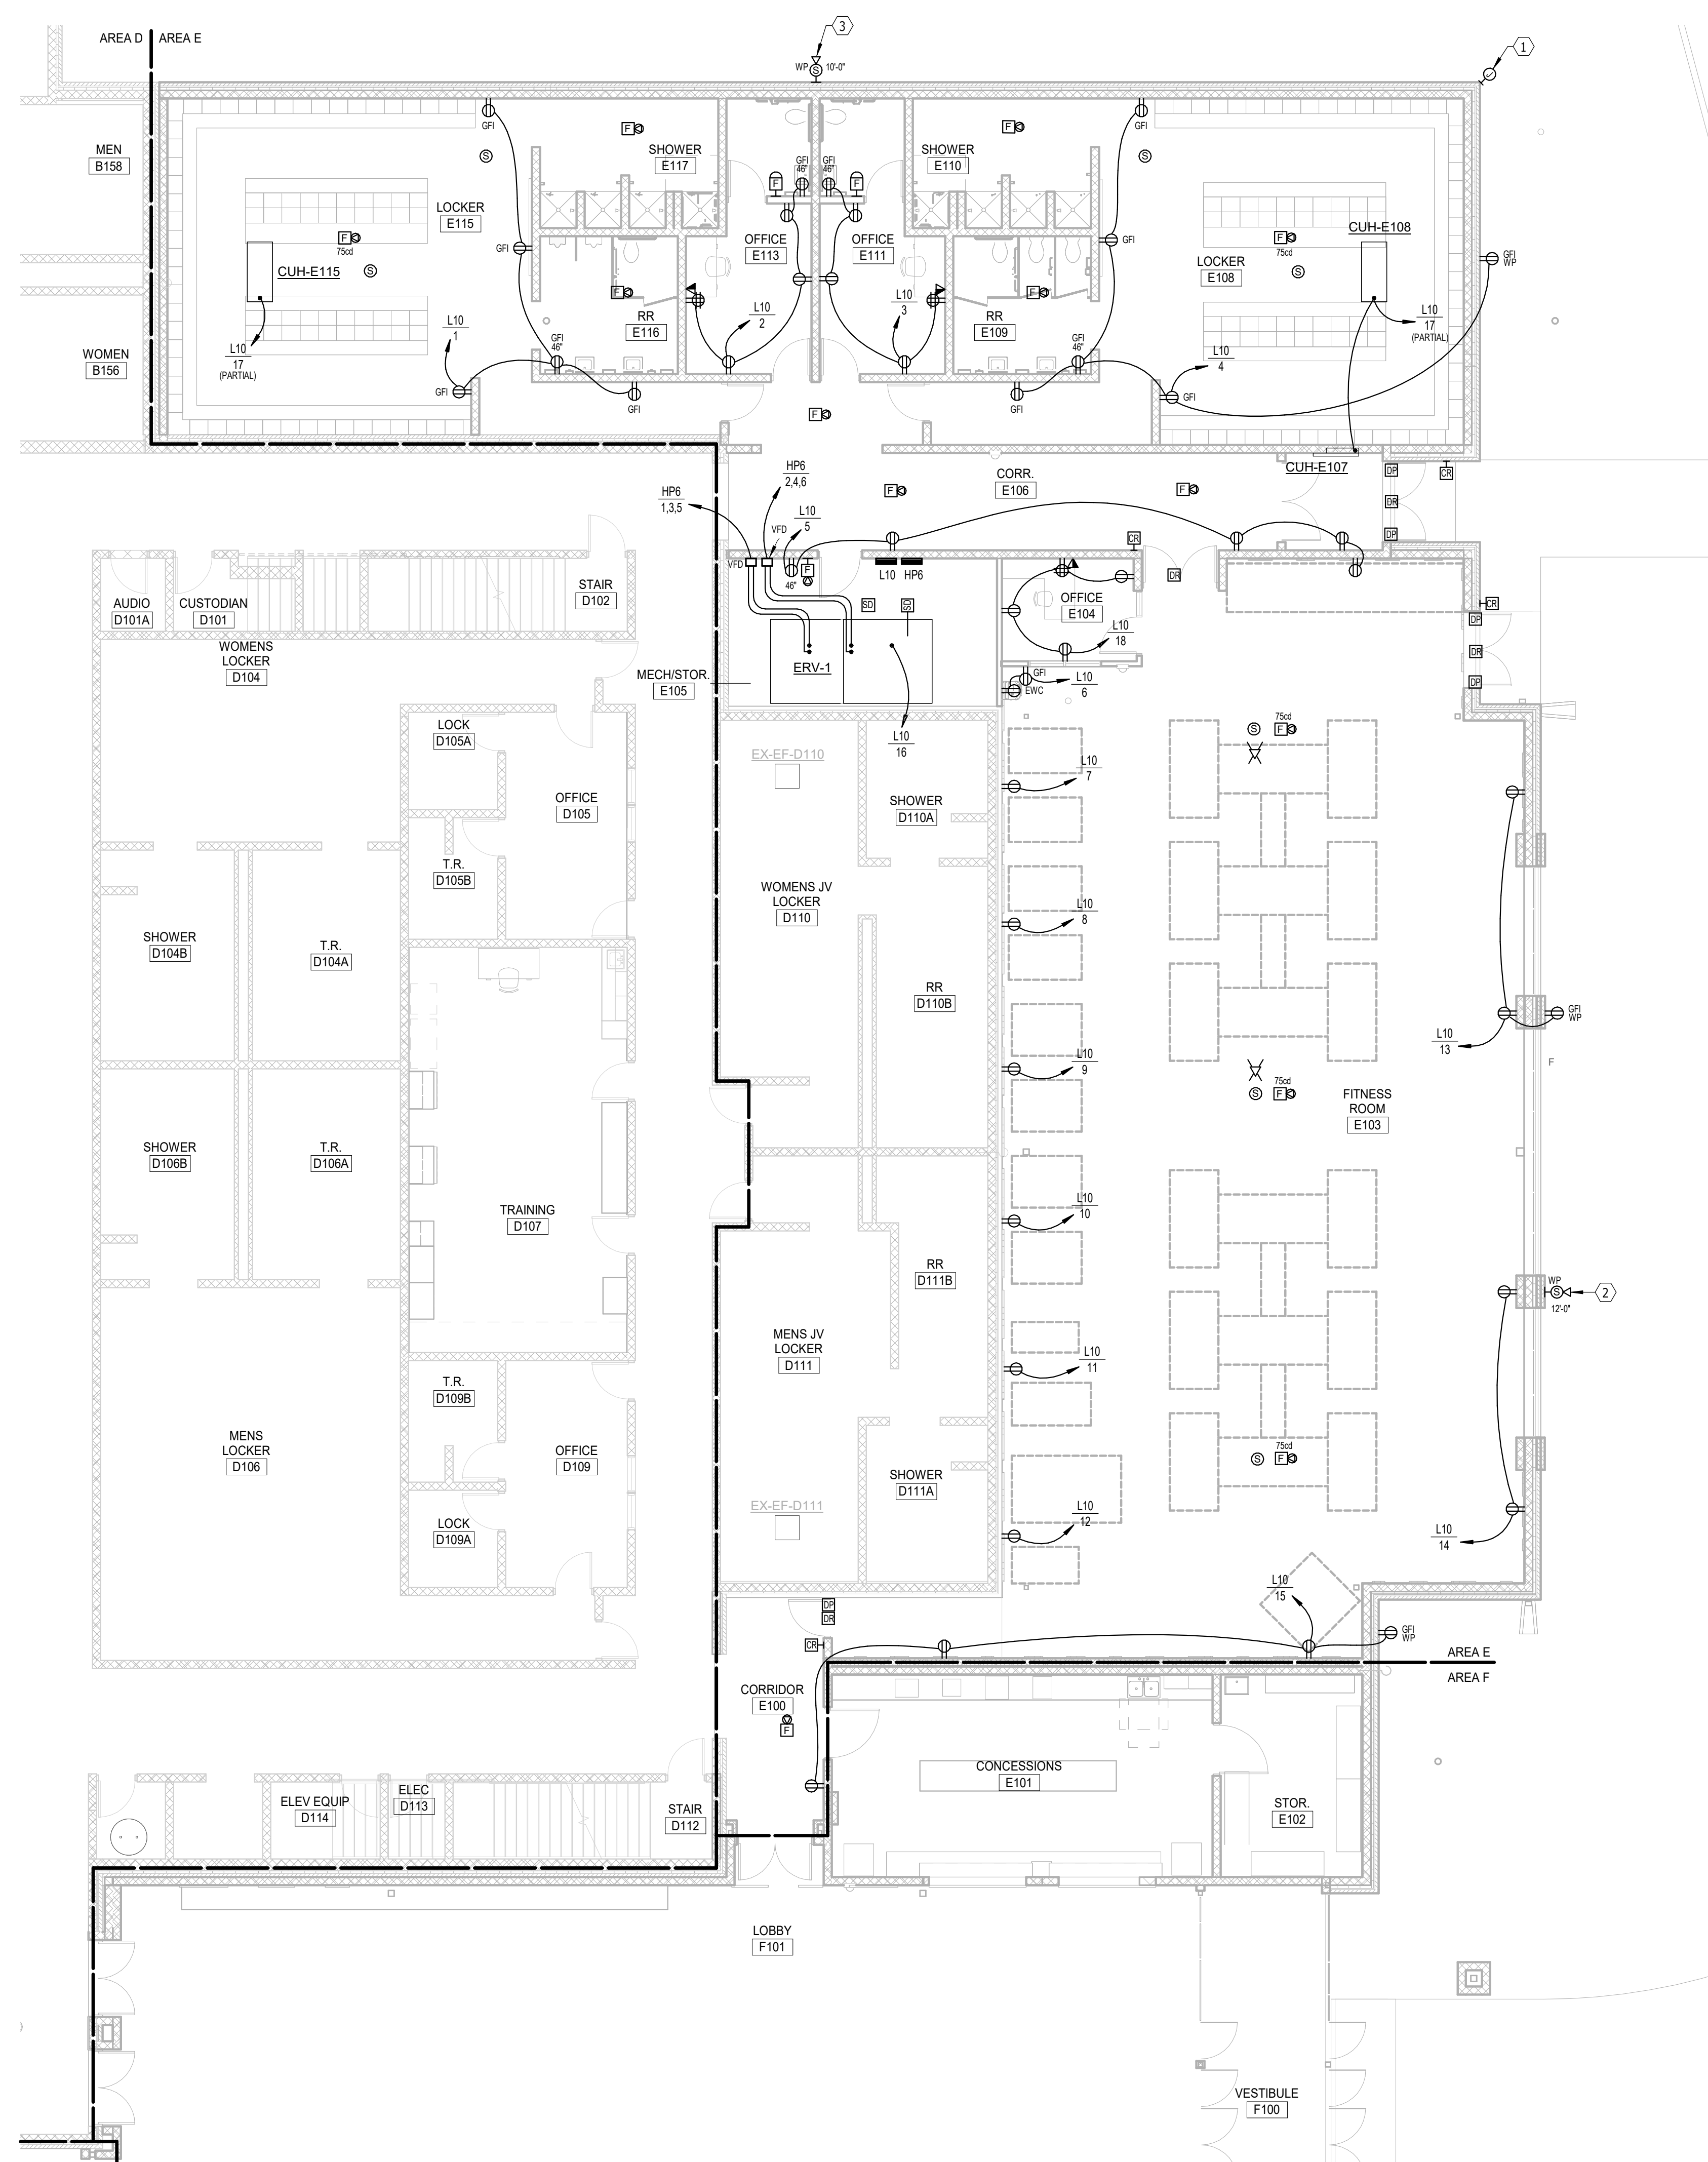


## ELECTRICAL NOTES

- 1 PROVIDE PROVISION FOR FUTURE CCTV CAMERA MOUNTED ON CORNER OF  
BUILDING. FIELD VERIFY MOUNTING HEIGHT WITH OWNER.  
2 EXISTING RELOCATED DEVICE.  
3 EXISTING RELOCATED DEVICE (PROVIDE NEW RECESSED BACKBOX).  
EXTEND/REROUTE EXISTING RACEWAYS AND CABLING AS REQUIRED.

### GENERAL SHEET NOTES


A. SEE AV DRAWINGS FOR ADDITIONAL WORK.

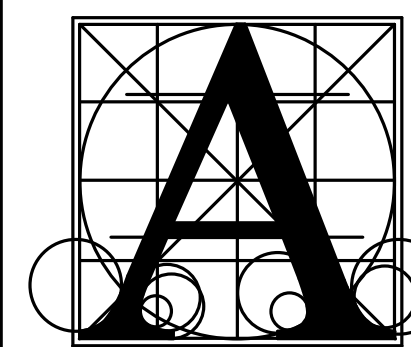

Architecture  
Incorporated

415 South Main Avenue  
P.O. Box 2140  
Sioux Falls, South Dakota 57101  
Phone: (605) 339-1711

815 St Joseph Street, Suite 203  
Rapid City, South Dakota 57701  
Phone: (605) 721-1158

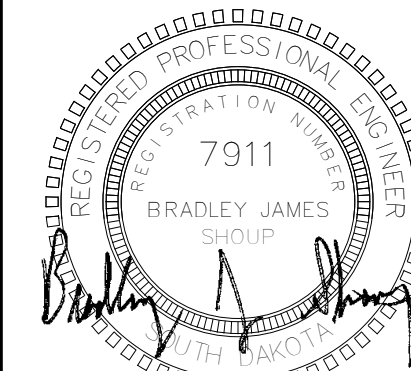

**A**ssociated  
**C**onsulting  
**E**ngineering,  
**I**ncorporated

340 S. Phillips Ave.  
Sioux Falls, SD 57104

(605) 335-3720  
Fax 335-6220  
E-mail: acei@aceinet.com

ACEI PROJ. #123034

project

number	0215.2982.22
--------	--------------

date	DECEMBER 21, 202
------	------------------

revision \_\_\_\_\_

drawn KMT checked B.

DATE	DESCRIPTION
------	-------------


01-11-2024	Addendum
------------	----------

01-18-2024	Addendum


**9.43-E**



1/10/2024 3:20:29 PM

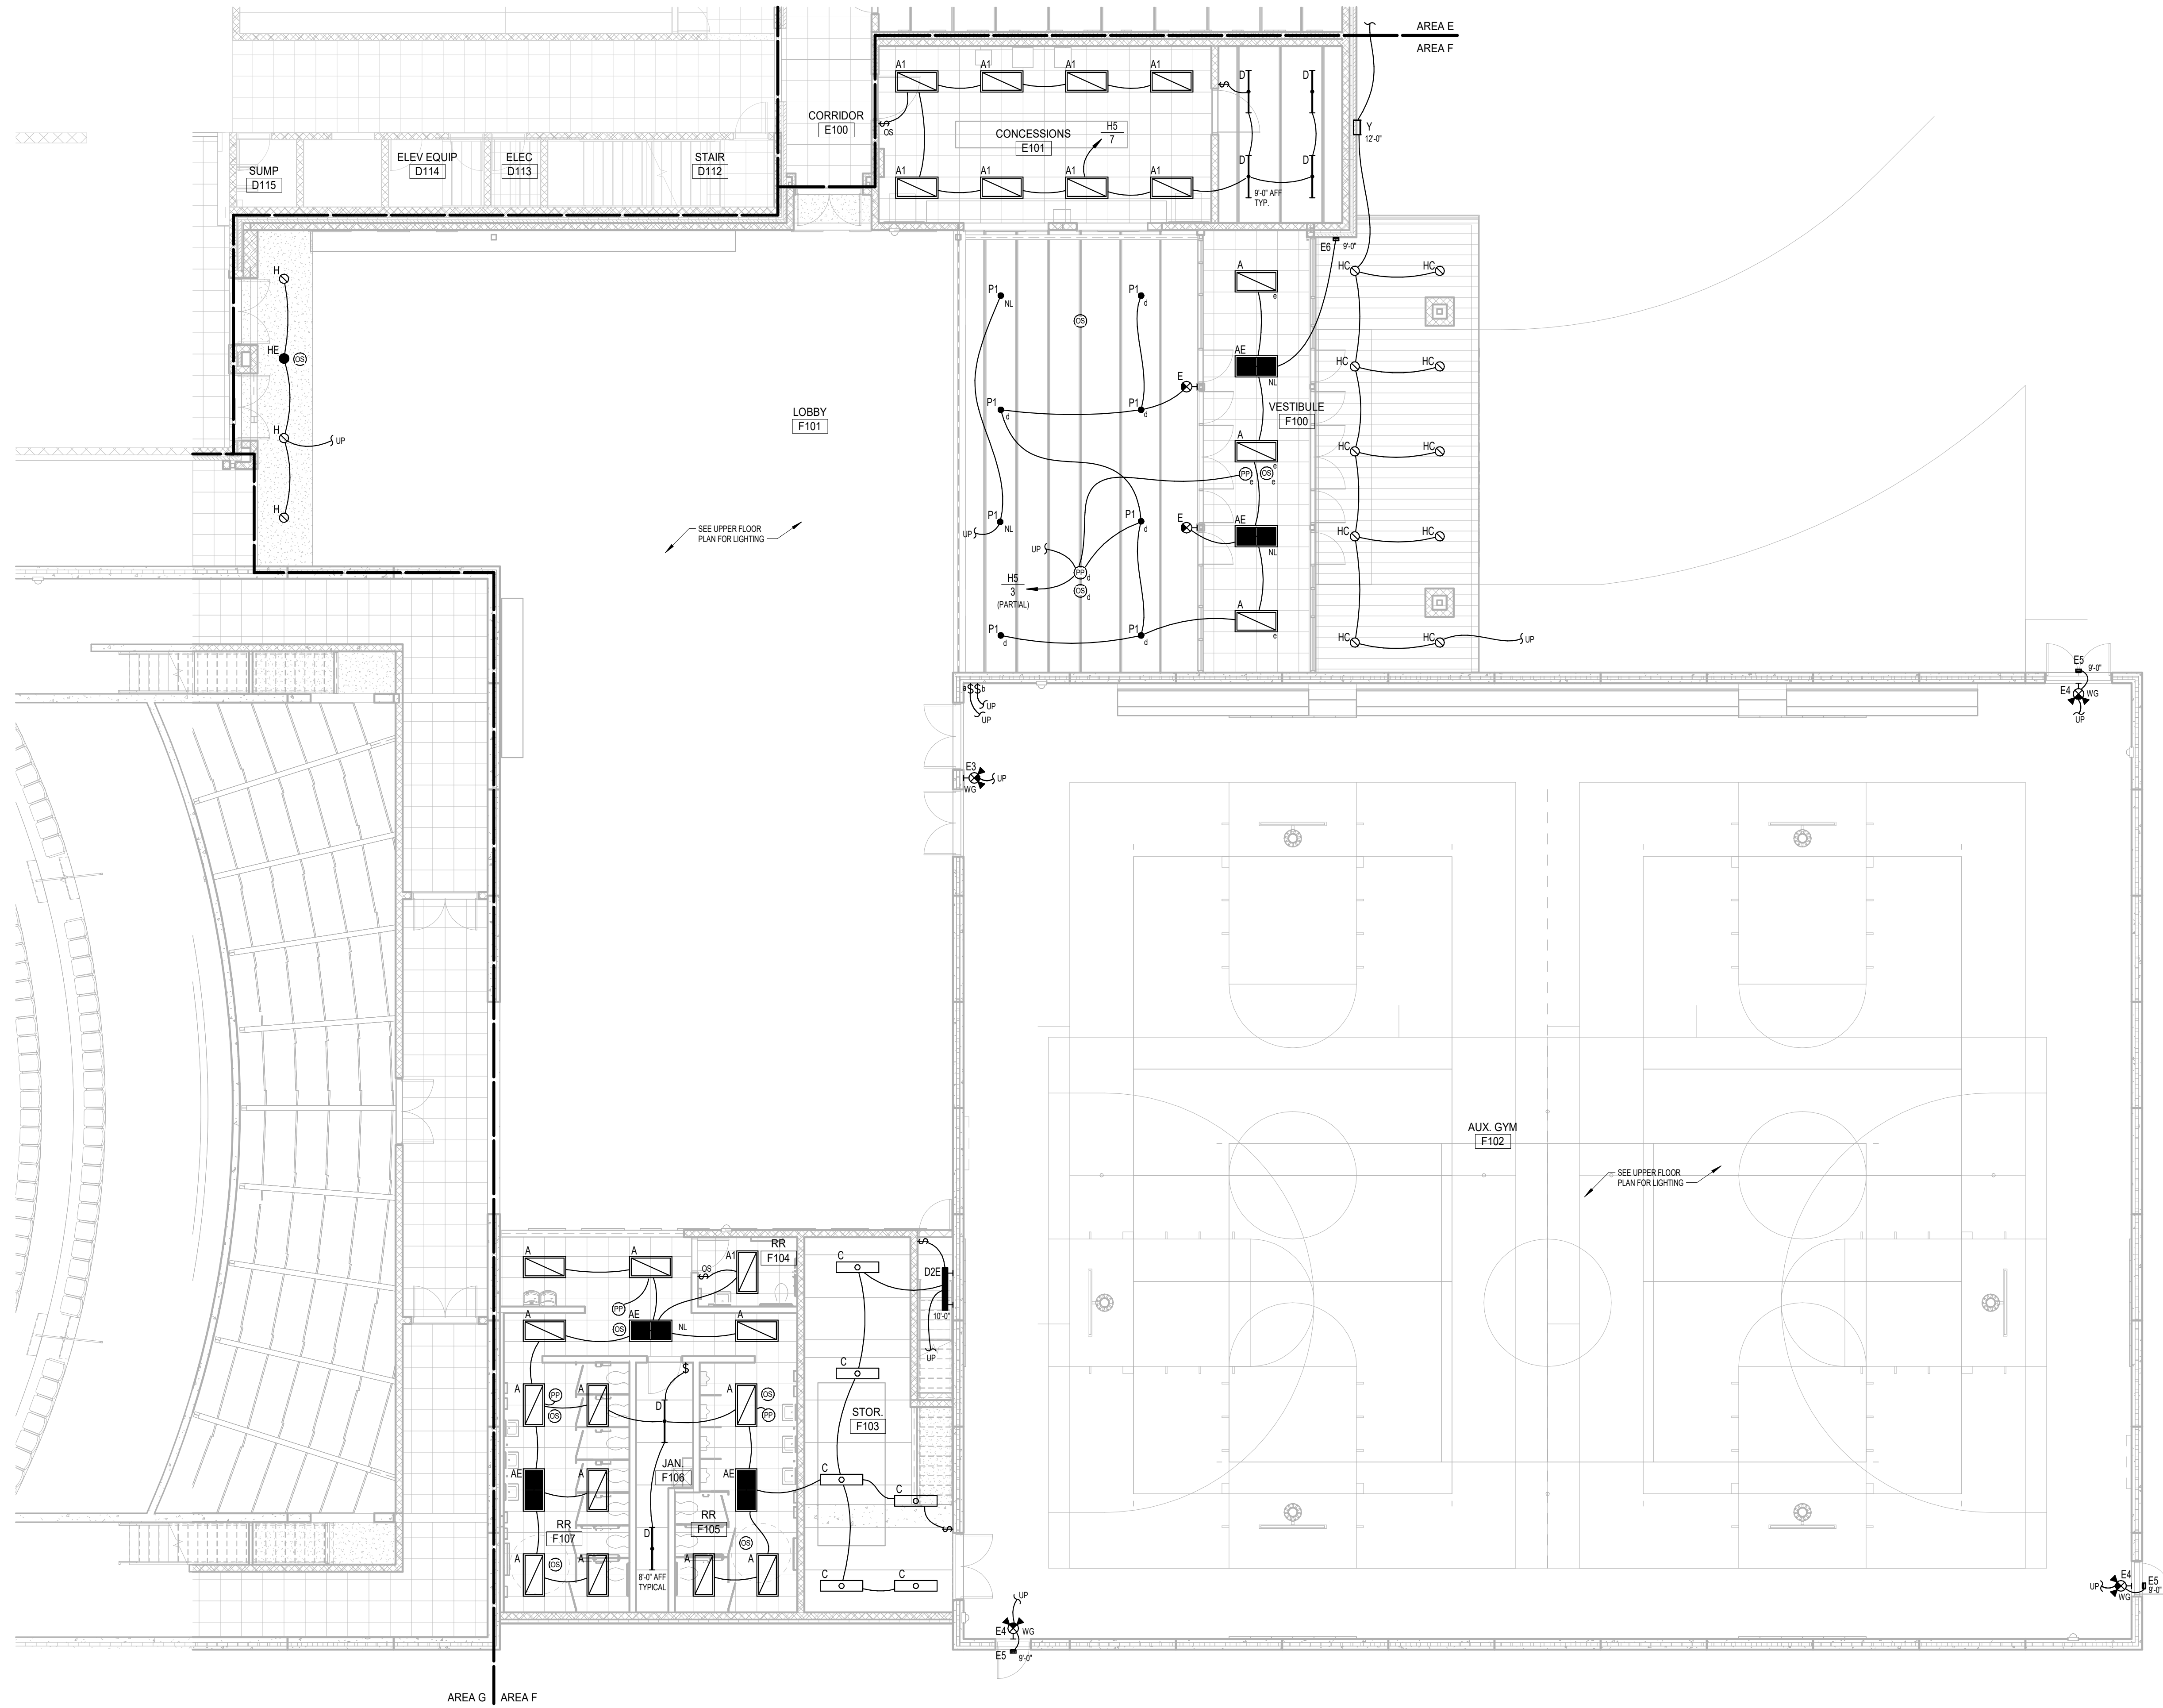

**FIRST FLOOR PLAN - AREA F - LIGHTING**  
SCALE 0 4 8 12 16

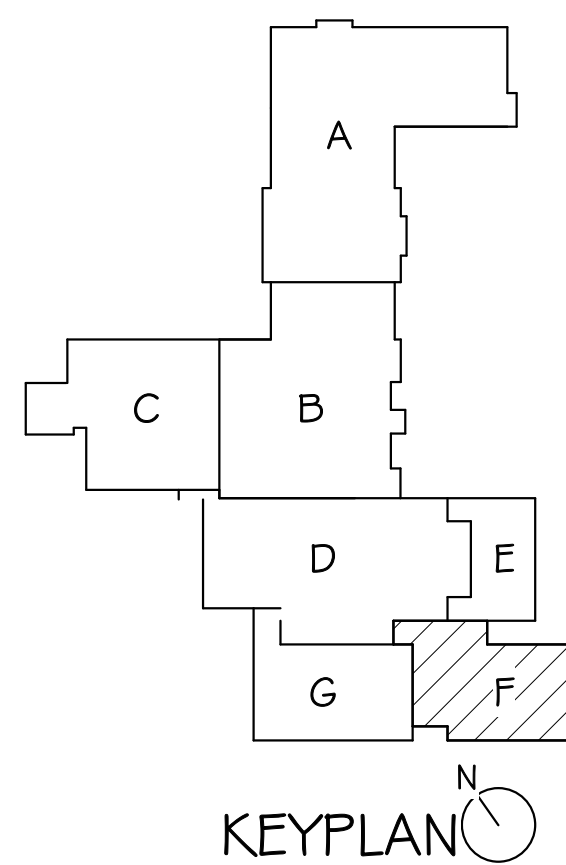


KEY PLAN

**ELECTRICAL NOTES**

**GENERAL SHEET NOTES**


- A. ELECTRICAL CONTRACTOR SHALL VERIFY ALL CEILING TYPES, AND MOUNTING HARDWARE REQUIRED PRIOR TO PURCHASE OF ANY LIGHTING FIXTURES.
- B. ALL STEP LIGHTS SHALL BE MOUNTED AT +2'-0" A.F.F. TO CENTER OF FIXTURE UNLESS OTHERWISE NOTED.
- C. ALL SWITCHES, DIMMERS OR BUTTON STATIONS SHALL BE MOUNTED AT +4'-0" A.F.F. TO BOTTOM OF FIXTURE UNLESS OTHERWISE NOTED. CONFIRM WITH ARCHITECTURAL DRAWINGS.

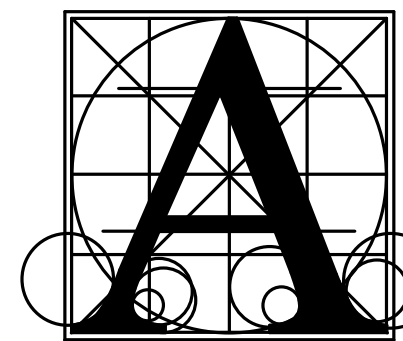

**Architecture  
Incorporated**

415 South Main Avenue  
P.O. Box 2140  
Sioux Falls, South Dakota 57101  
Phone: (605) 339-1711

815 St. Joseph Street, Suite 203  
Rapid City, South Dakota 57701  
Phone: (605) 721-1158

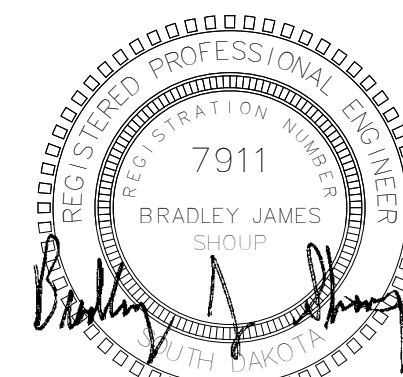

**Associated  
Consulting  
Engineering,  
Incorporated**

340 S. Phillips Ave.  
Sioux Falls, SD 57104

(605) 335-3720  
Fax 335-6220  
E-mail acei@aceinet.com

ACEI PROJ. #123034



**LENNOX HIGH SCHOOL ADDITION**  
FIRST FLOOR PLAN - AREA F - LIGHTING - BASE BID

Project  
number 0215.2902.22  
date DECEMBER 21, 2023  
revision  
drawn KMT checked BJ5


DATE	DESCRIPTION
01-18-2024	Addendum #2

**9.44-F**

1/18/2024 3:20:31 PM

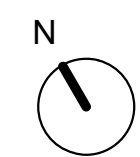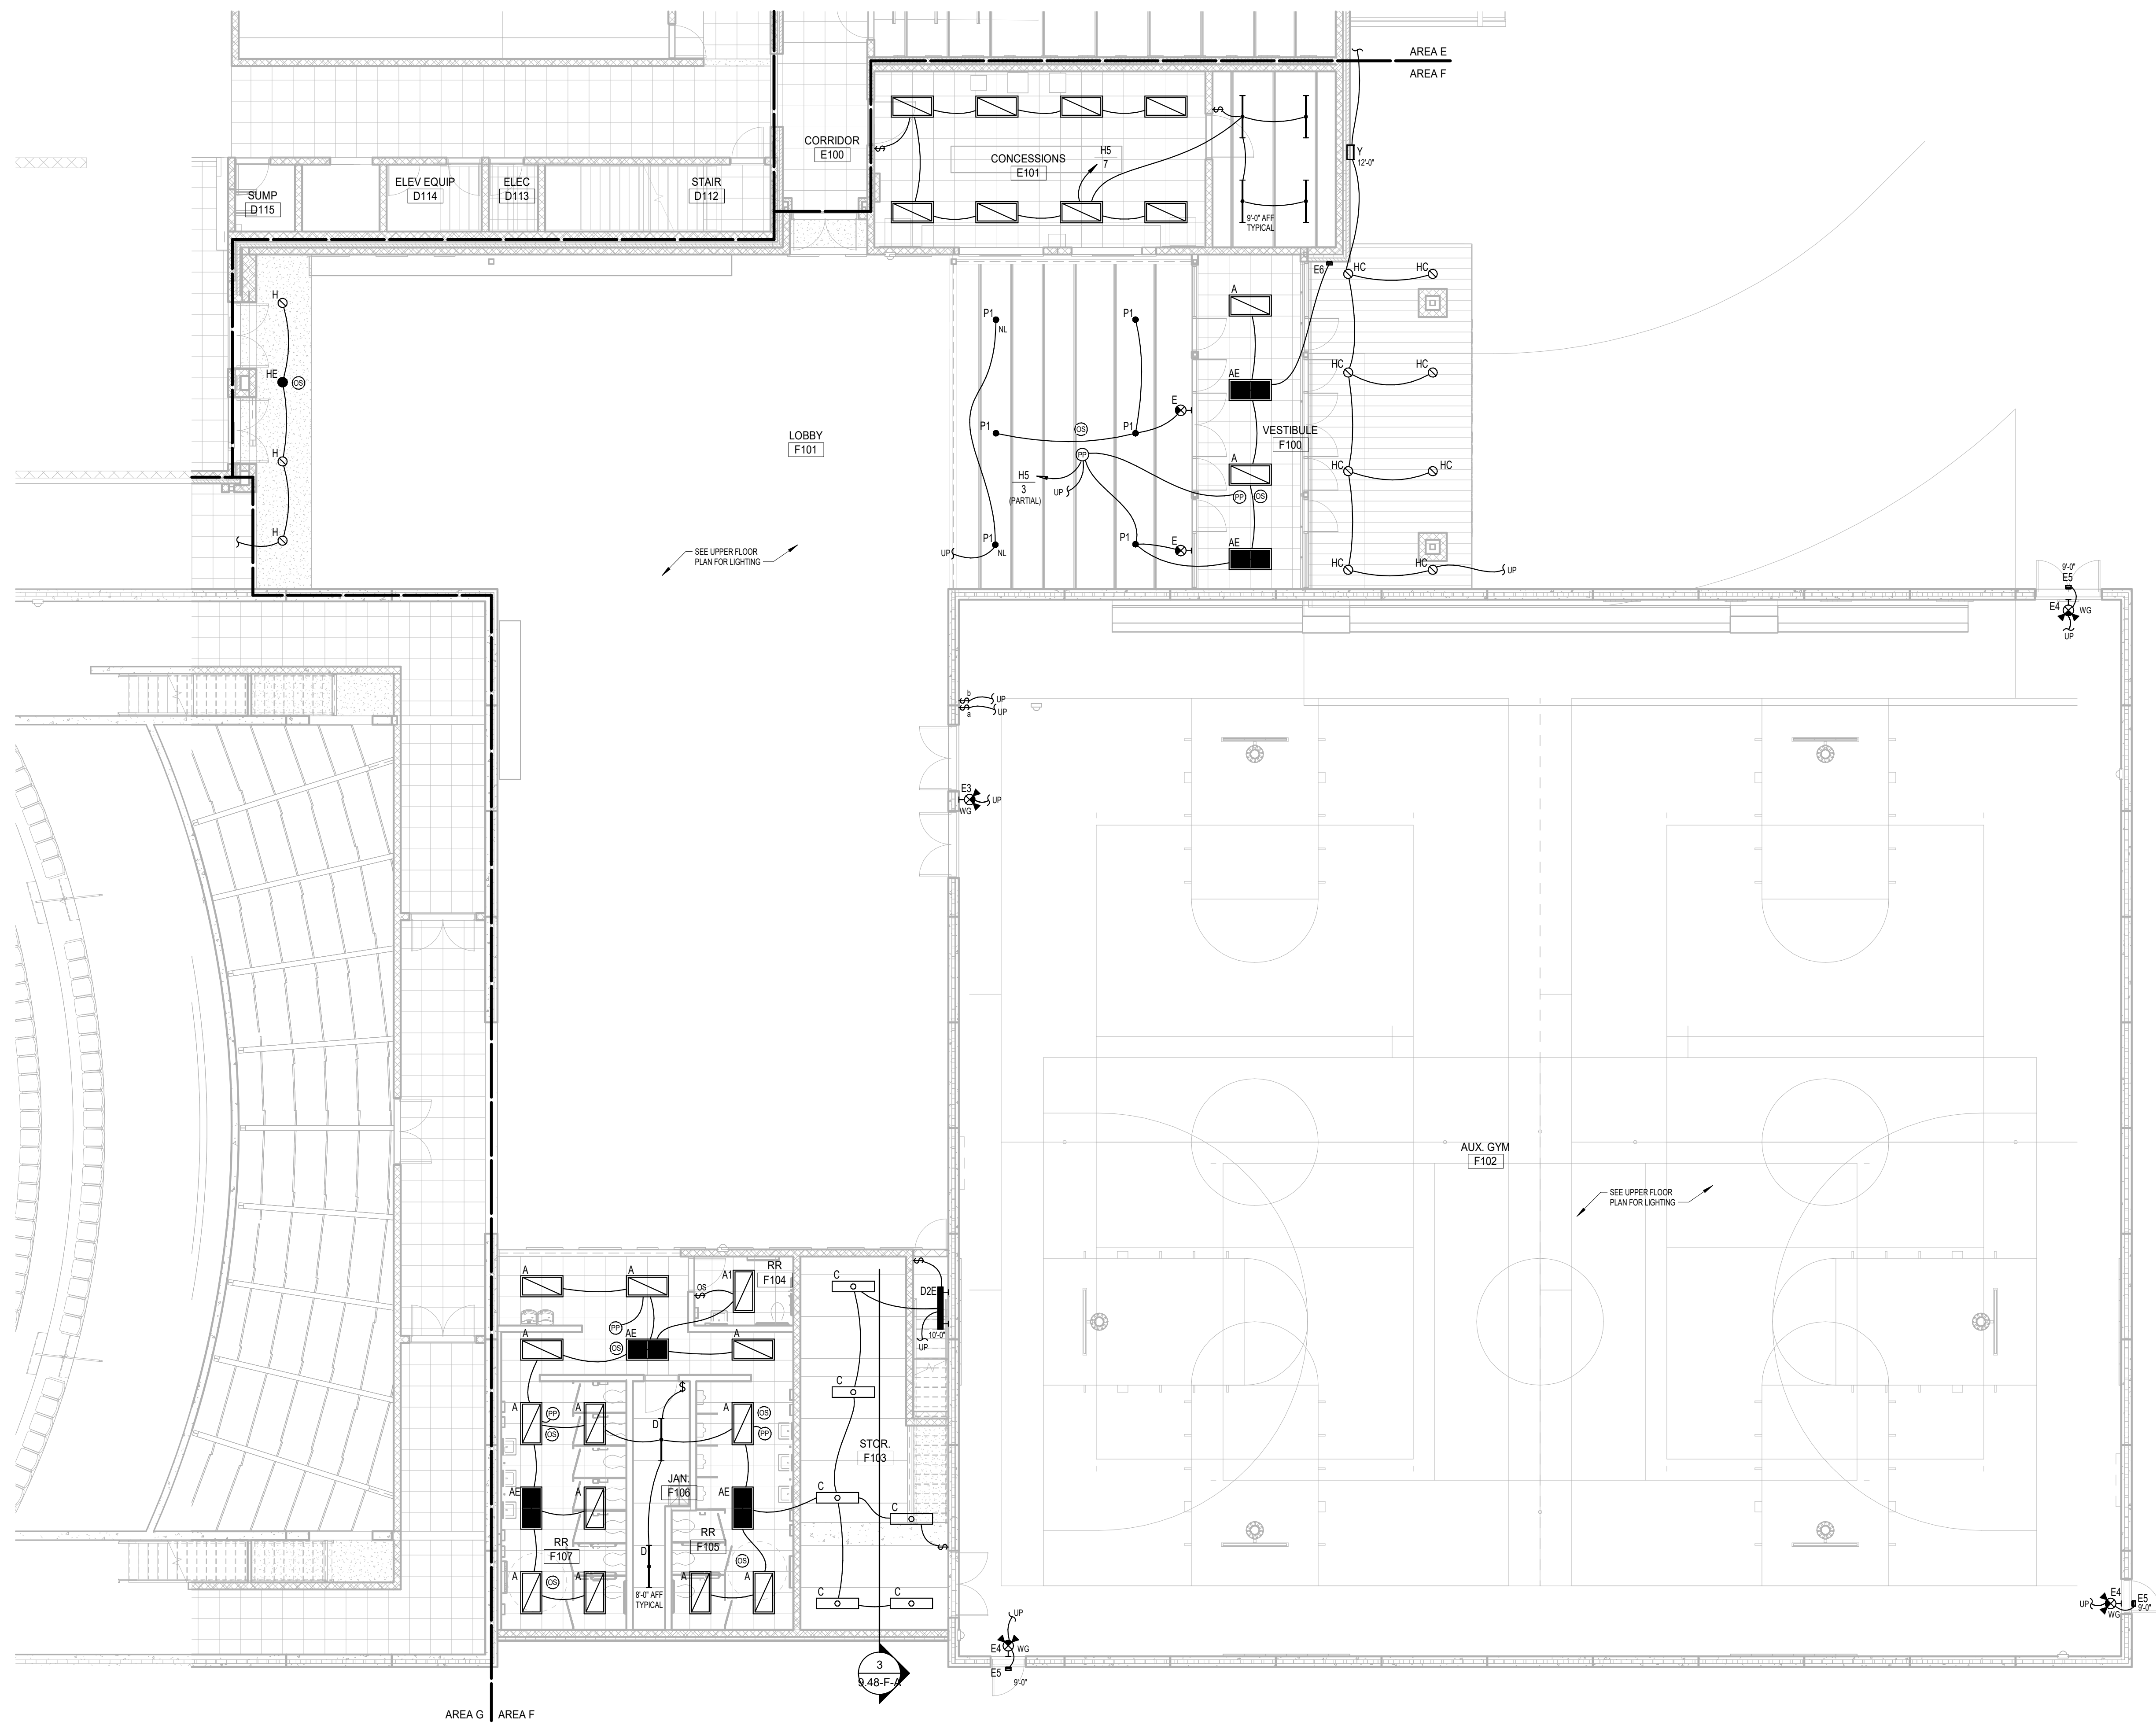

**FIRST FLOOR PLAN - AREA F - LIGHTING ADD ALTERNATE**  
SCALE 0 4 8 12 16

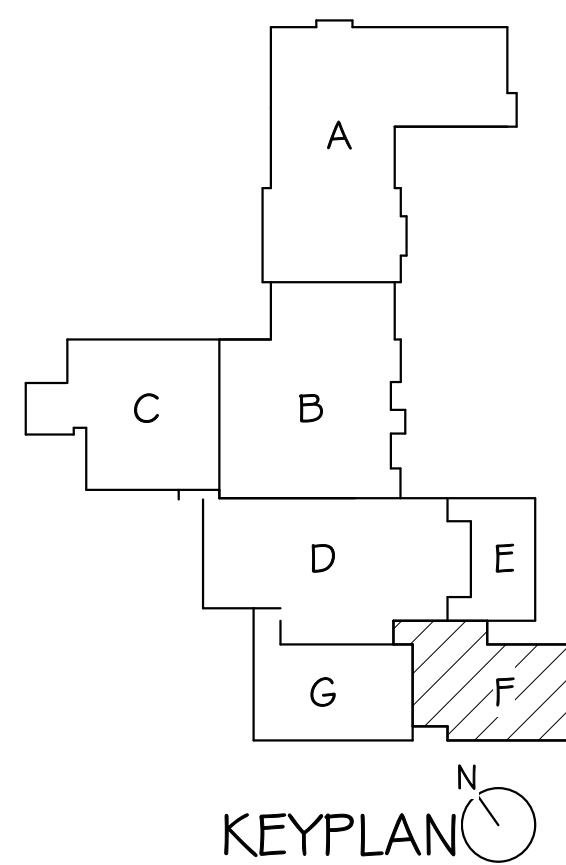


KEY PLAN

**ELECTRICAL NOTES**

**GENERAL SHEET NOTES**


- A. ELECTRICAL CONTRACTOR SHALL VERIFY ALL CEILING TYPES, AND MOUNTING HARDWARE REQUIRED PRIOR TO PURCHASE OF ANY LIGHTING FIXTURES.
- B. ALL STEP LIGHTS SHALL BE MOUNTED AT +2'-0" A.F.F. TO CENTER OF FIXTURE UNLESS OTHERWISE NOTED.
- C. ALL SWITCHES, DIMMERS OR BUTTON STATIONS SHALL BE MOUNTED AT +4'-0" A.F.F. TO BOTTOM OF FIXTURE UNLESS OTHERWISE NOTED. CONFIRM WITH ARCHITECTURAL DRAWINGS.

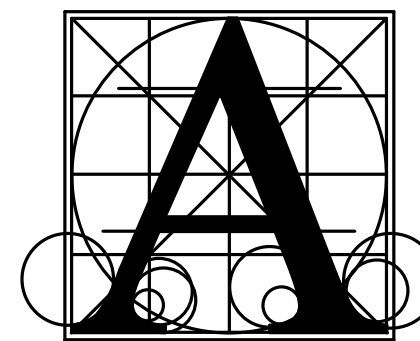

**Architecture  
Incorporated**

415 South Main Avenue  
P.O. Box 2140  
Sioux Falls, South Dakota 57101  
Phone: (605) 339-1711

815 St. Joseph Street, Suite 203  
Rapid City, South Dakota 57701  
Phone: (605) 721-1158

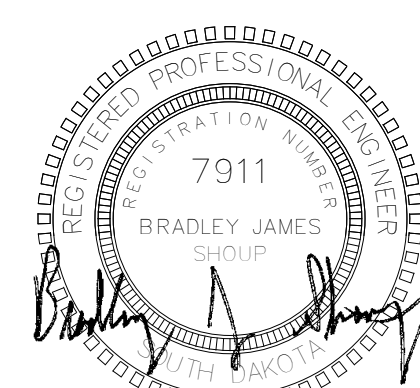

**Associated  
Consulting  
Engineering,  
Incorporated**

340 S. Phillips Ave.  
Sioux Falls, SD 57104

(605) 335-3720  
Fax 335-6220

E-mail acei@aceinet.com

ACEI PROJ. #123034

Project

**LENNOX HIGH SCHOOL ADDITION**

Sheet Contents

**FIRST FLOOR PLAN - AREA F - LIGHTING - ADD ALTERNATE**

number 0215.2902.22

date DECEMBER 21, 2023

revision


drawn KMT checked BJ5

DATE DESCRIPTION


01-18-2024 Addendum #2

**9.44-F-A**



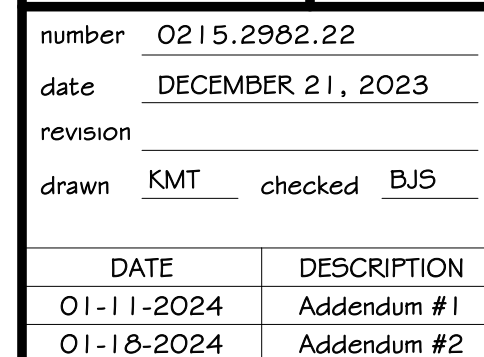

**9.45-F**

- 
- Architecture  
Incorporated**
- 415 South Main Avenue  
P.O. Box 2140  
Sioux Falls, South Dakota 57101  
Phone: (605) 339-1711
- 
- 815 St Joseph Street, Suite 203  
Rapid City, South Dakota 57701  
Phone: (605) 721-1158



Project

---


**LENNOX HIGH SCHOOL ADDITION**

---


Sheet contents

**FIRST FLOOR PLAN - AREA F - POWER & SIGNAL - BASE BID**

11/18/2024 3:20:32 PM

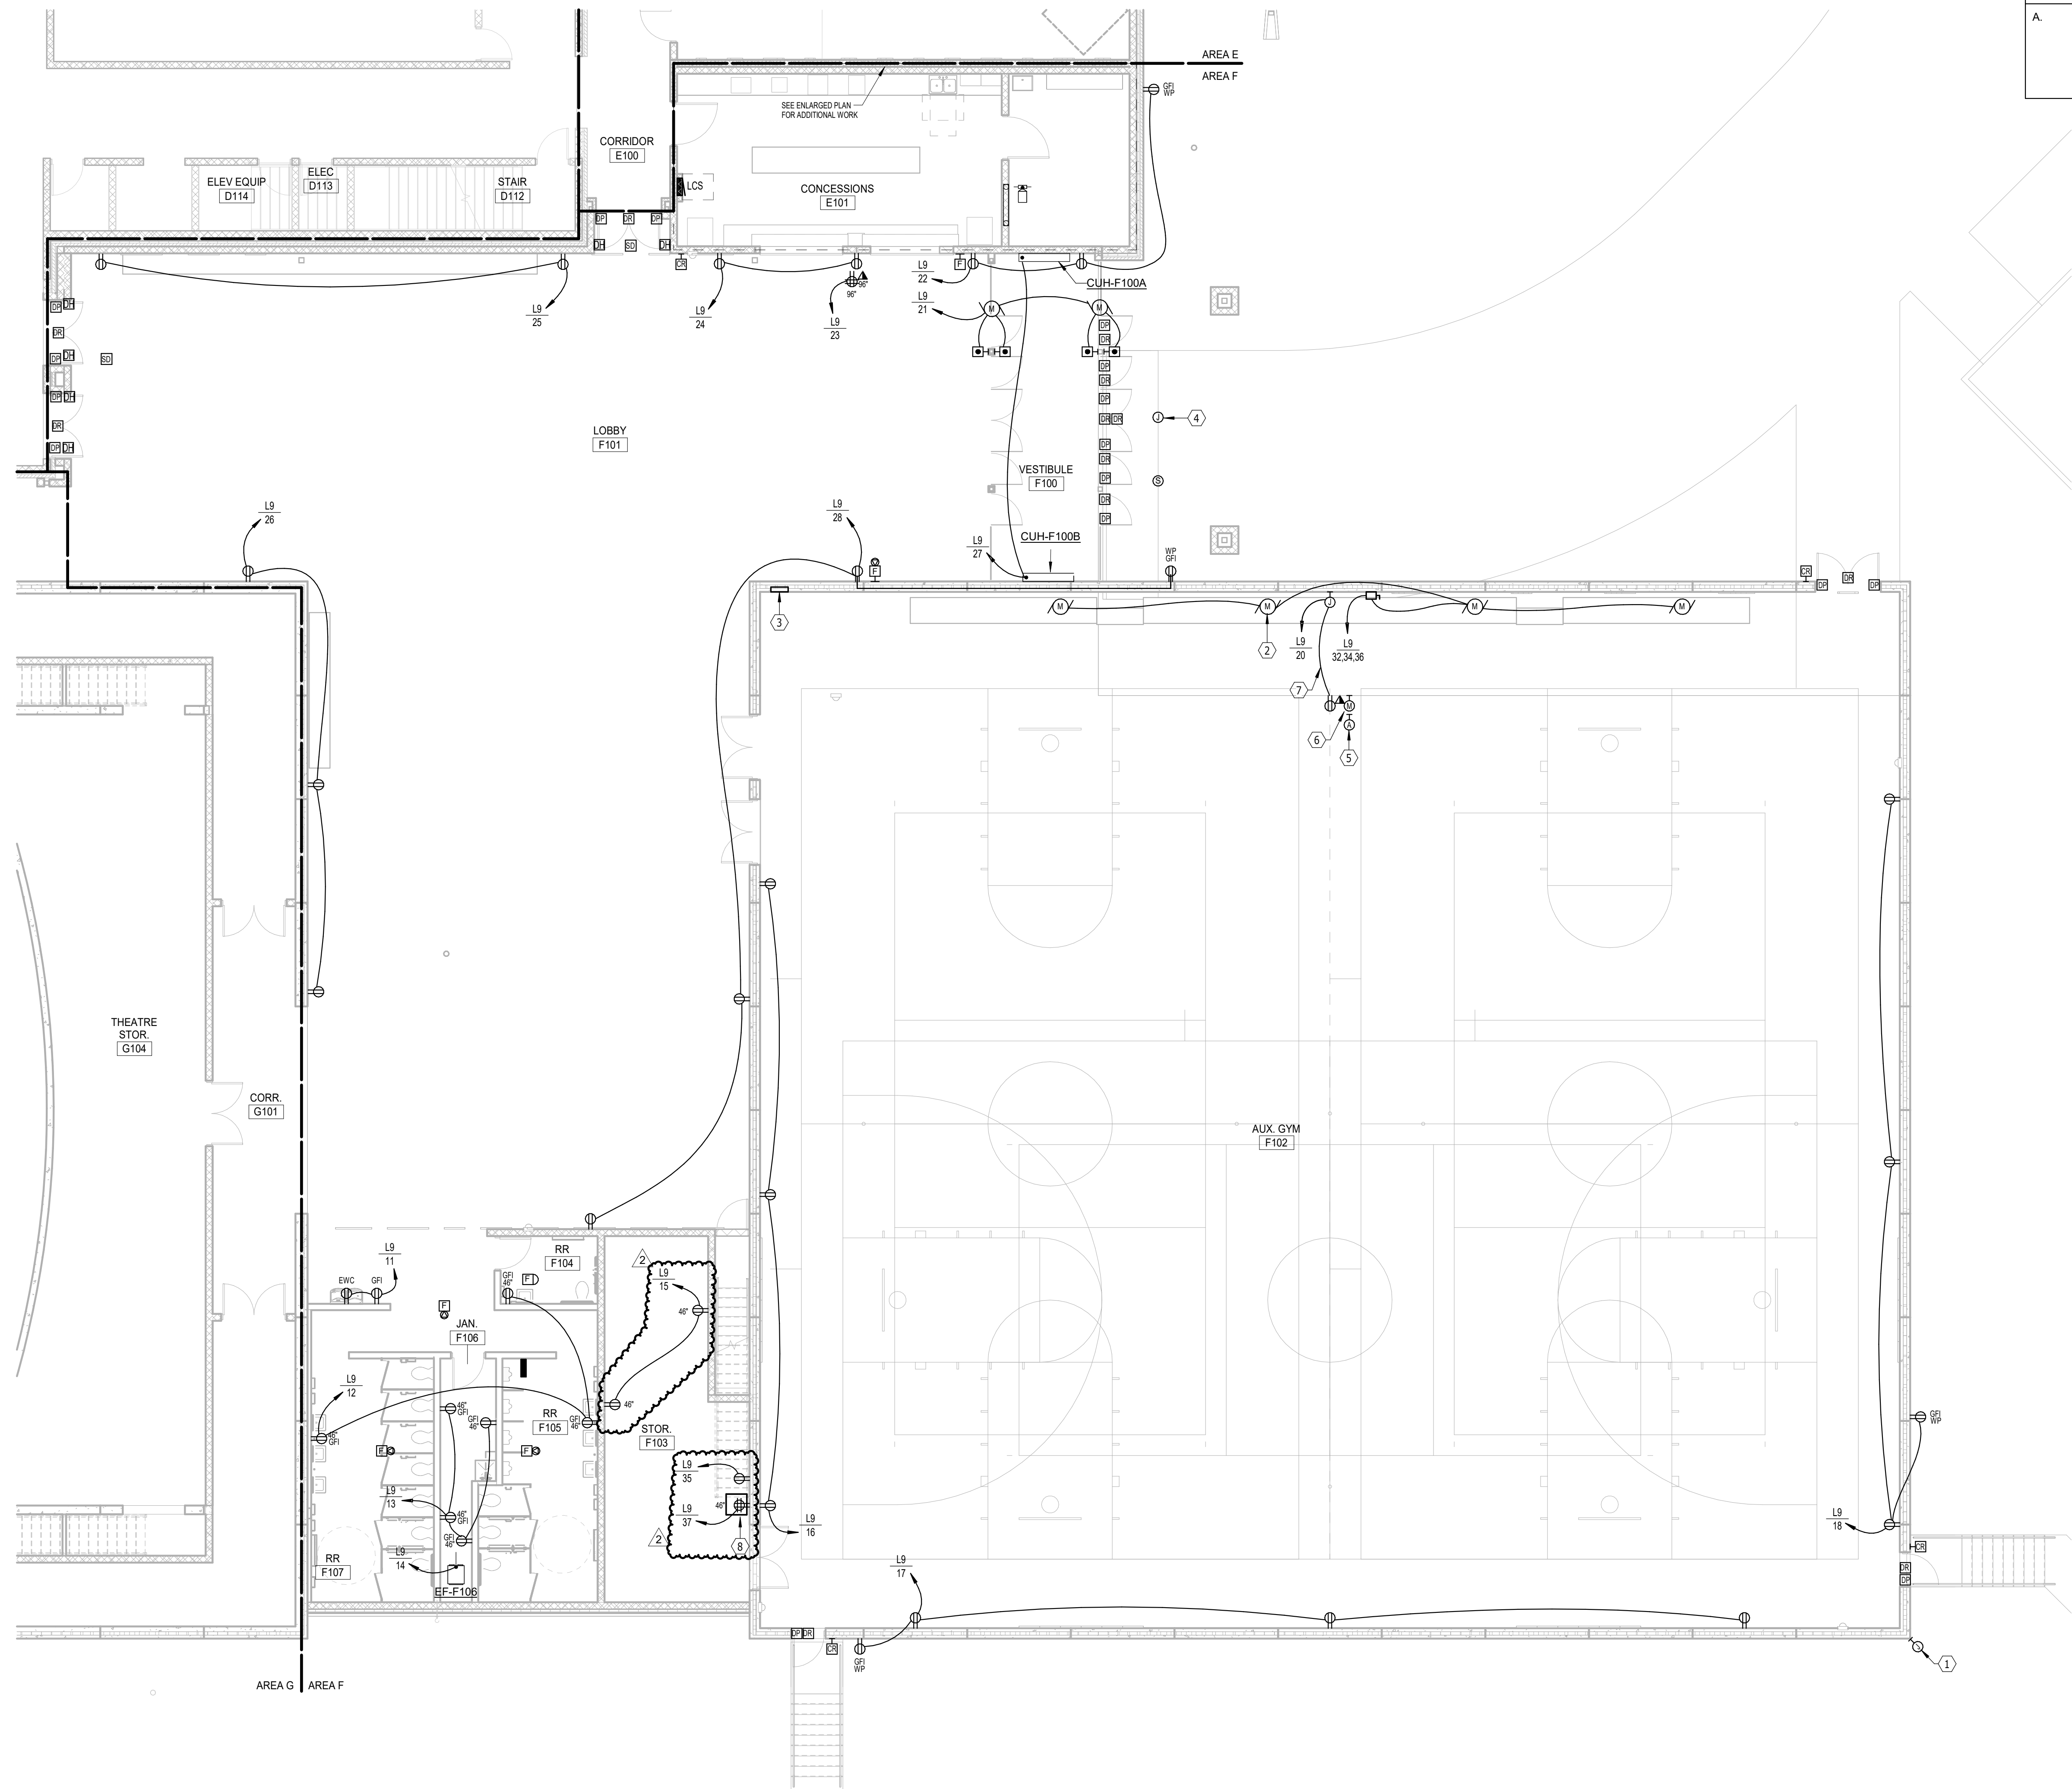

**FIRST FLOOR PLAN - AREA F - POWER & SIGNAL - ADD ALTERNATE**

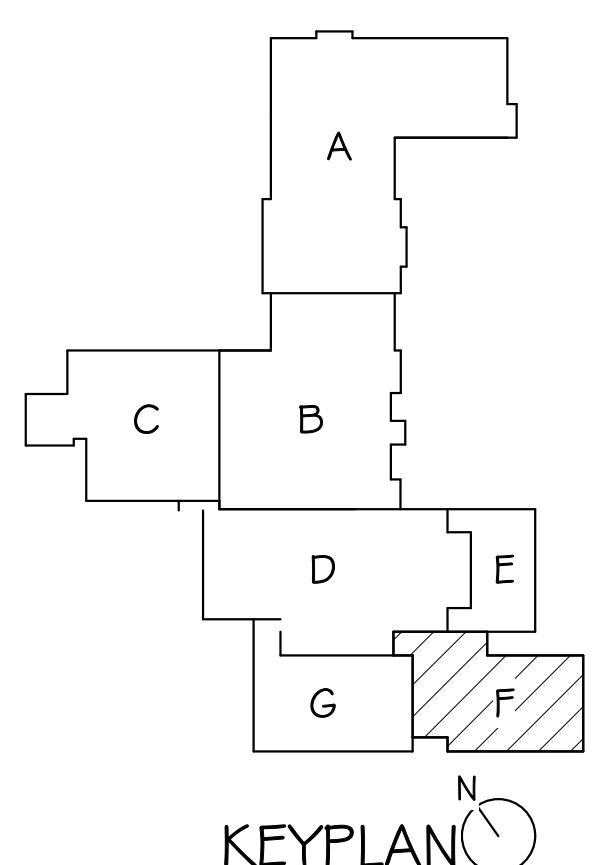

**ELECTRICAL NOTES**

1. PROVIDE PROVISION FOR FUTURE CCTV CAMERA MOUNTED ON CORNER OF BUILDING. FIELD VERIFY MOUNTING HEIGHT WITH OWNER.
2. COORDINATE CONNECTION REQUIREMENTS WITH BLEACHER SUPPLIER.
3. GYM CONTROL PANEL "GCP". SEE DETAIL.
4. PROVIDE PROVISION FOR FUTURE CCTV CAMERA MOUNTED IN CANOPY.
5. GYM SOUND SYSTEM MIC/AUX INPUT, TYPICAL.
6. LOCATE DEVICES IN FACE OF LOWEST BLEACHER RISER (COORDINATE WITH ARCHITECT).
7. ALL CABLES FEEDING DEVICES IN FACE OF BLEACHER SHALL BE SUPPORTED TO UNDERSIDE OF BLEACHERS IN A MANNER THAT PREVENTS CABLES FROM BEING PINCHED WHEN BLEACHERS ARE MOVED IN AND OUT.

GYM SOUND SYSTEM EQUIPMENT RACK BY OTHERS. EQUIPMENT GROUNDING CONDUCTOR BY EC.

**GENERAL SHEET NOTES**

A. SEE AV DRAWINGS FOR ADDITIONAL WORK.

**Architecture Incorporated**  
415 South Main Avenue  
P.O. Box 2140  
Sioux Falls, South Dakota 57101  
Phone: (605) 339-1711

815 St Joseph Street, Suite 203  
Rapid City, South Dakota 57701  
Phone: (605) 721-1158

**Associated Consulting Engineering, Incorporated**  
340 S. Phillips Ave.  
Sioux Falls, SD 57104  
(605) 335-3720  
Fax 335-6220  
E-mail acei@aceinet.com  
ACEI PROJ. #123034

**LENNOX HIGH SCHOOL ADDITION**

**FIRST FLOOR PLAN - AREA F - POWER & SIGNAL - ADD ALTERNATE**

Project number 0215.2902.22  
date DECEMBER 21, 2023  
revision  
drawn KMT checked BUS



DATE	DESCRIPTION
01-11-2024	Addendum #1
01-18-2024	Addendum #2

**9.45-F-A**

1/18/2024 3:20:34 PM




1/10/2024 3:20:36 PM

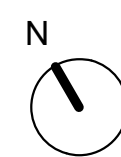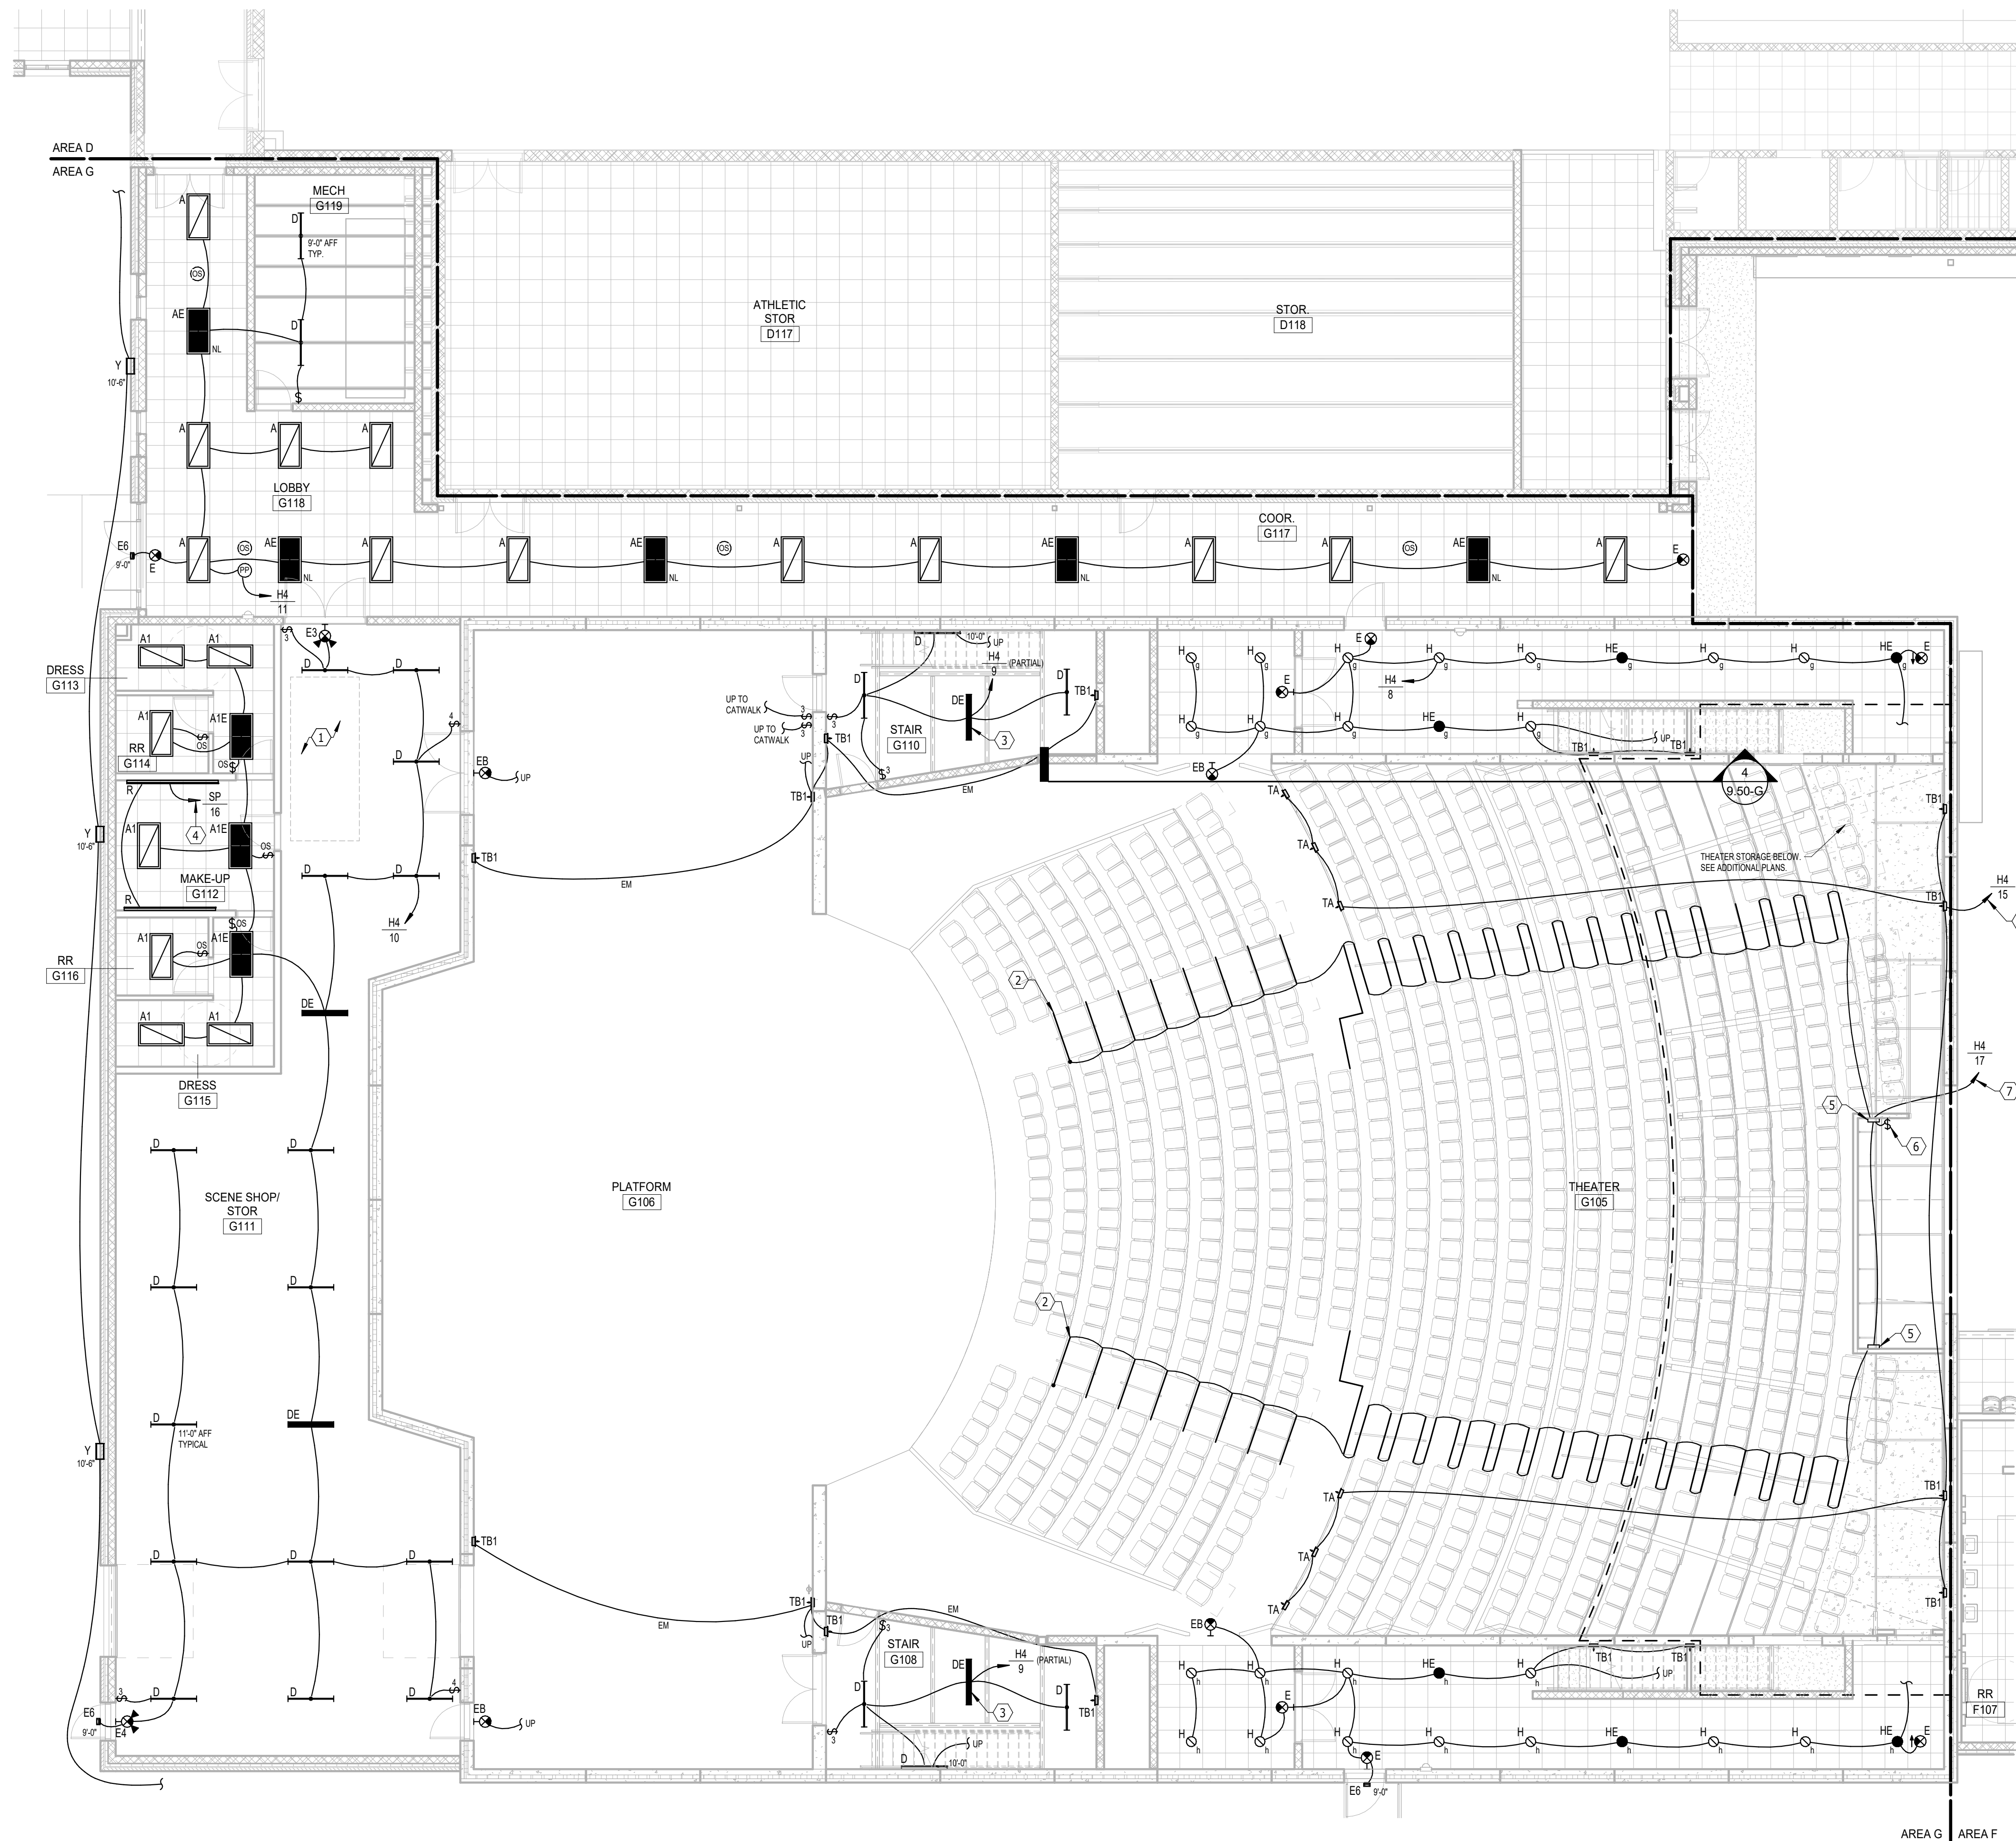


FIRST FLOOR PLAN - AREA G - LIGHTING

SCALE 0 4 8 12 16

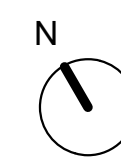

THEATER STORAGE - AREA G - LIGHTING

SCALE 0 4 8 12 16

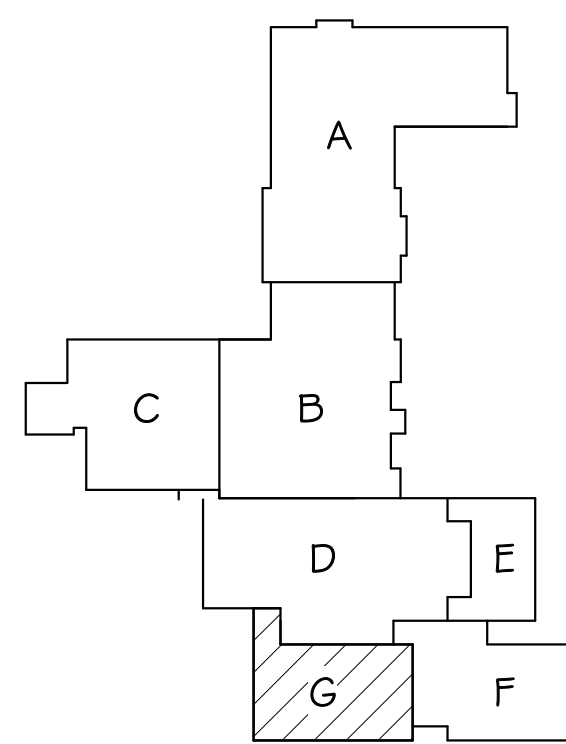


KEYPLAN

ELECTRICAL NOTES

- COORDINATE LIGHTING INSTALLATION WITH MECHANICAL EQUIPMENT, SHIFT AS NECESSARY.
- TYPE 'TS' STEP LIGHT, TYPICAL.
- TO THE EXTENT POSSIBLE, SURFACE MOUNT TYPE 'D' LUMINAIRE, TYPICAL IN THIS ROOM.
- TYPE 'R' MAKE-UP MIRROR LIGHTS, MOUNT SUCH THAT THE CENTER OF FIXTURE IS 8'-6" AFF (ABOVE MIRROR). ROUTE CIRCUIT THROUGH CONTACTOR 'CR'.
- STEP LIGHT POWER SUPPLY, 277V PRI.
- PROVIDE SWITCH TO CONTROL STEP LIGHTS TA AND TS IN THE AUDITORIUM.
- WIRE THIS CIRCUIT THRU THE SC1008 FED BY THE INVERTER.

GENERAL SHEET NOTES


- ELECTRICAL CONTRACTOR SHALL VERIFY ALL CEILING TYPES, AND MOUNTING HARDWARE REQUIRED PRIOR TO PURCHASE OF ANY LIGHTING FIXTURES.
- ALL STEP LIGHTS SHALL BE MOUNTED AT +2'-0" A.F.F. TO CENTER OF FIXTURE UNLESS OTHERWISE NOTED.
- ALL SWITCHES, DIMMERS OR BUTTON STATIONS SHALL BE MOUNTED AT +40" A.F.F. TO BOTTOM OF FIXTURE UNLESS OTHERWISE NOTED. CONFIRM WITH ARCHITECTURAL DRAWINGS.

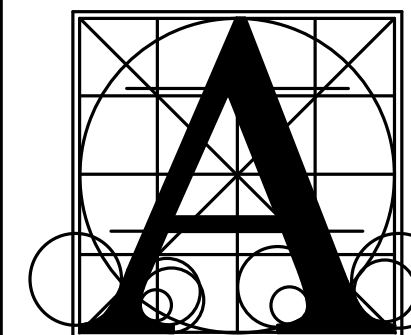

Architecture  
Incorporated

415 South Main Avenue  
P.O. Box 2140  
Sioux Falls, South Dakota 57101  
Phone: (605) 339-1711

815 St. Joseph Street, Suite 203  
Rapid City, South Dakota 57701  
Phone: (605) 721-1158

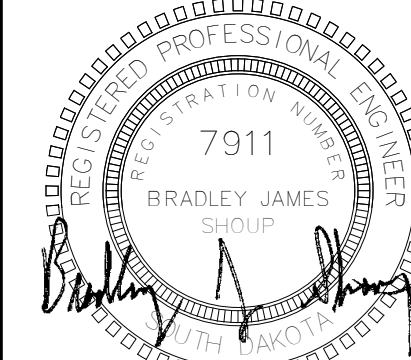

Associated  
Consulting  
Engineering,  
Incorporated

340 S. Phillips Ave.  
Sioux Falls, SD 57104

(605) 335-3720  
Fax 335-6220

E-mail acei@aceinet.com

ACEI PROJ. #123034

Project  
**LENNOX HIGH SCHOOL ADDITION**  
sheet contents  
FIRST FLOOR PLAN - AREA G - LIGHTING


number 0215.2902.22  
date DECEMBER 21, 2023  
revision  
drawn KMT checked BJS

DATE	DESCRIPTION
01-11-2024	Addendum #1
01-18-2024	Addendum #2


9.46-G




1/1/2024 3:20:40 PM

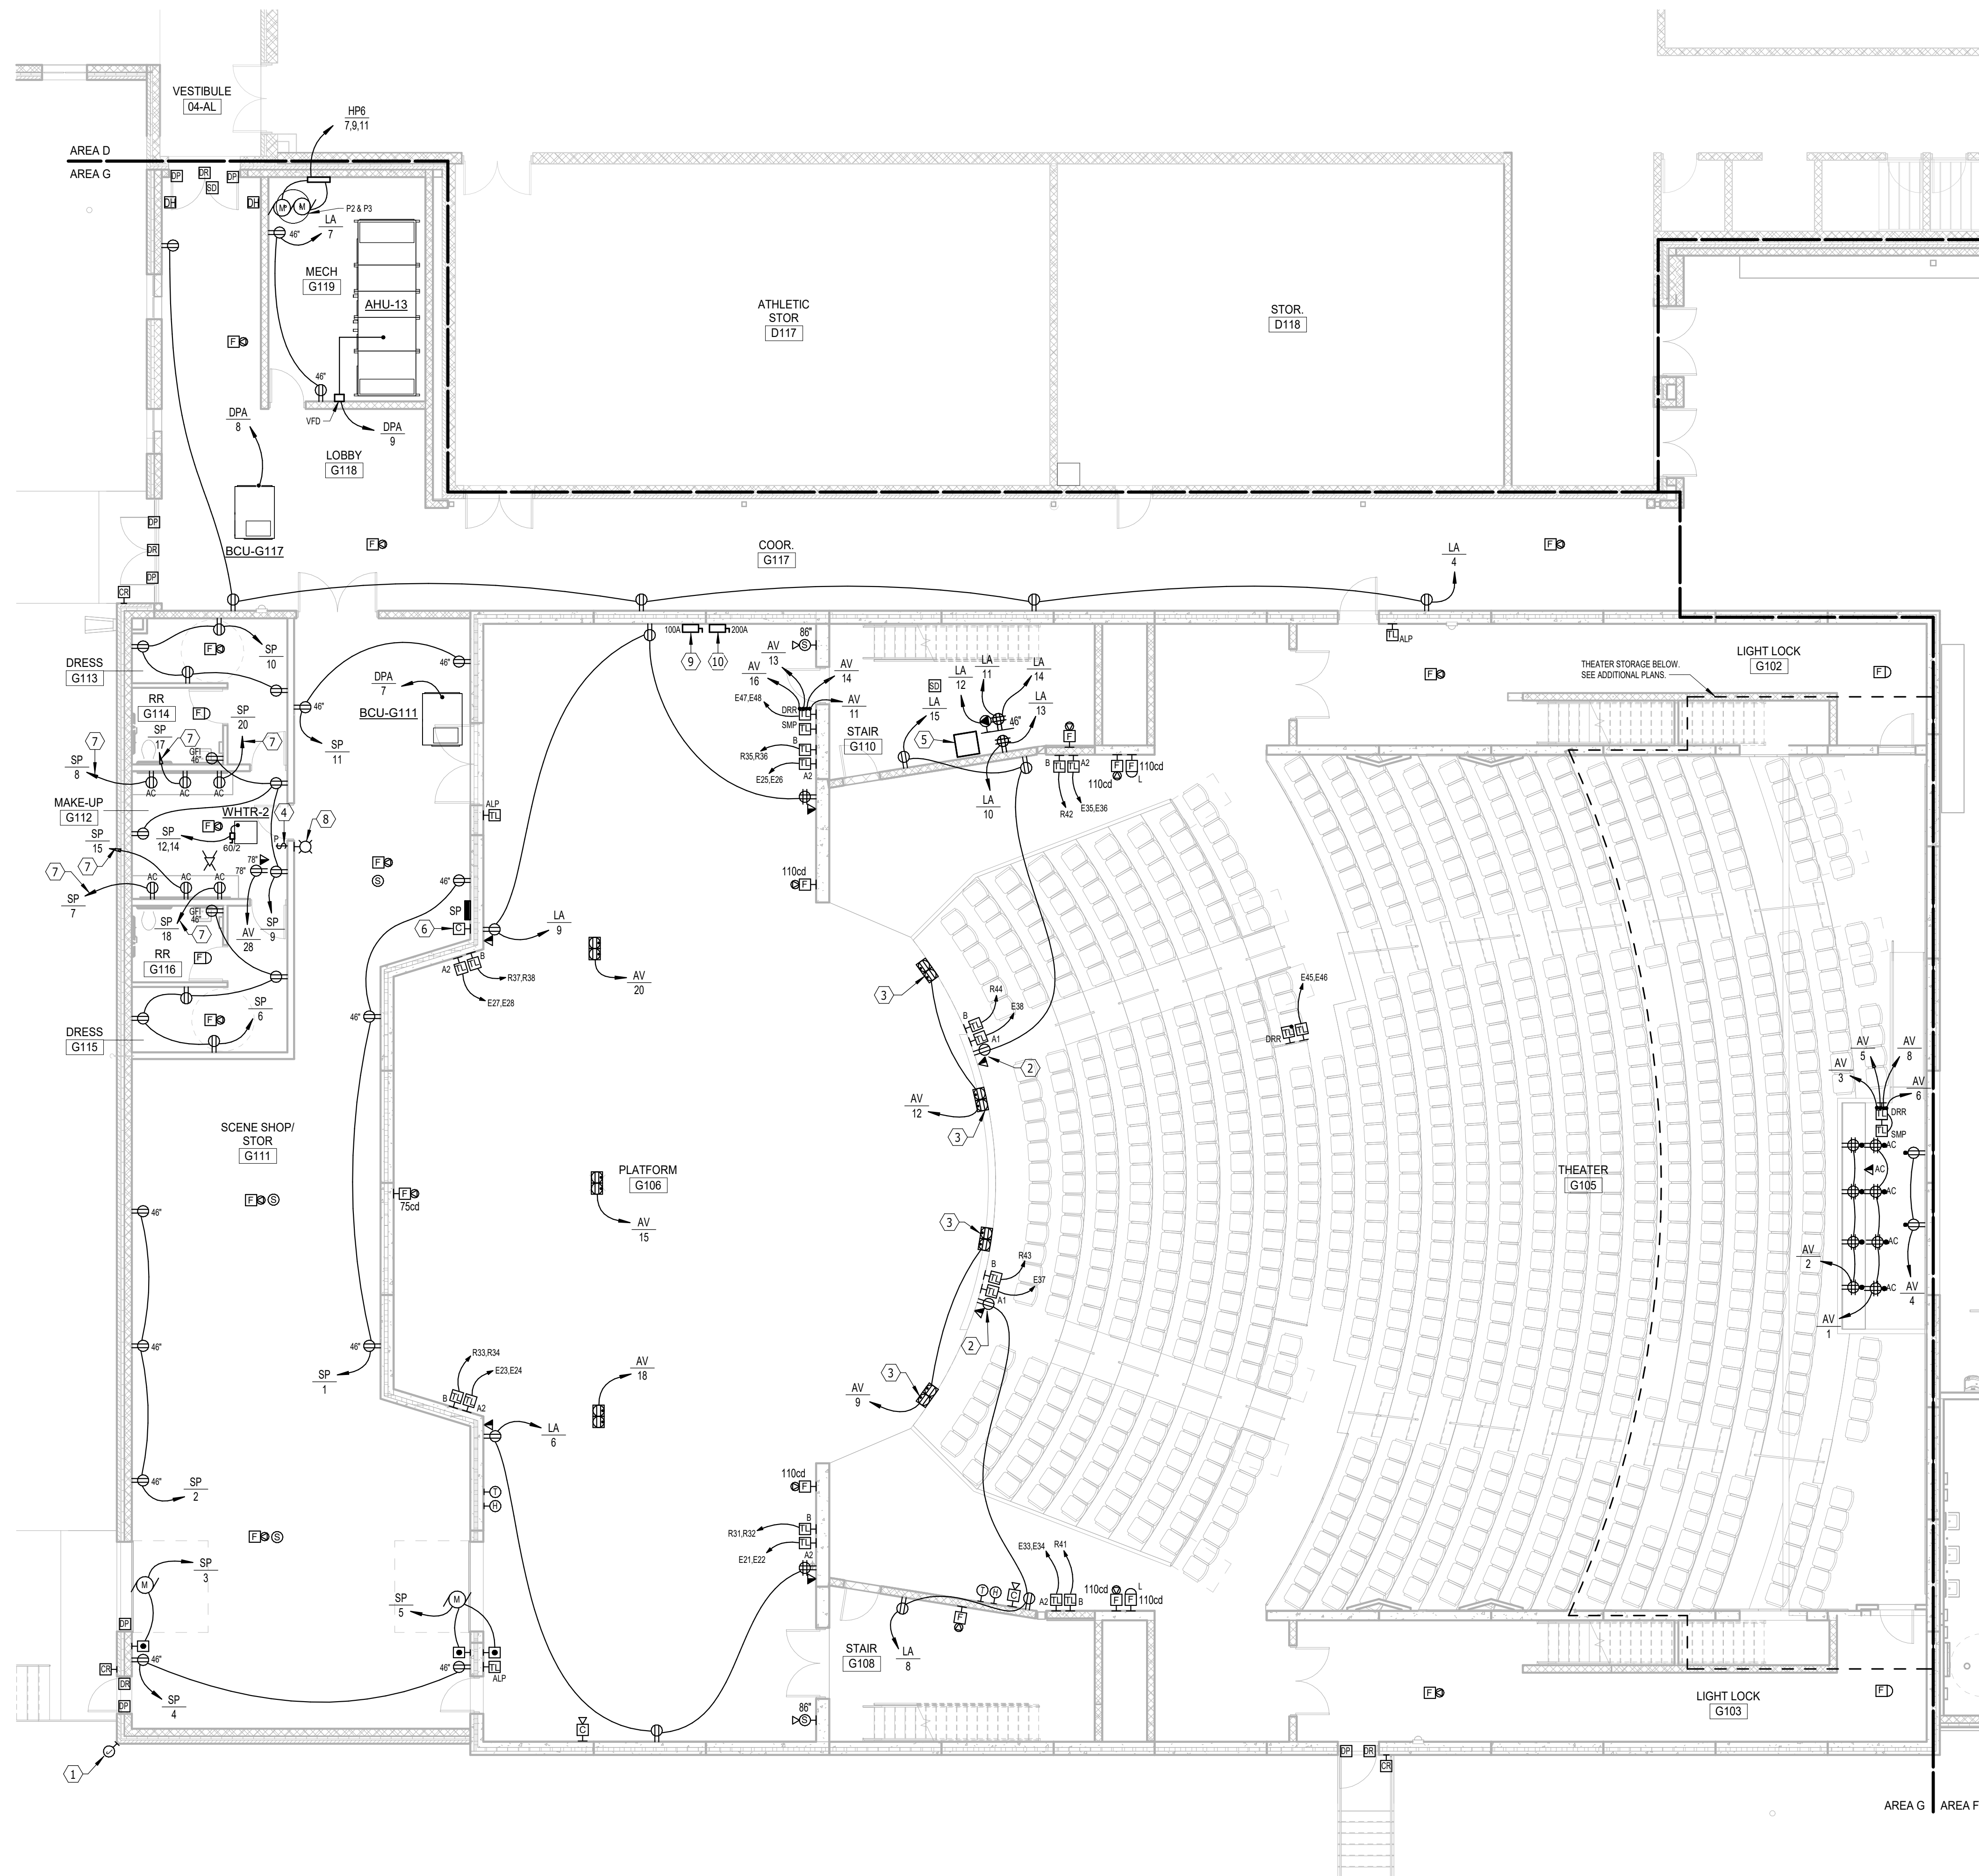

**FIRST FLOOR PLAN - AREA G - POWER & SIGNAL**  
SCALE 0 4 8 12 16

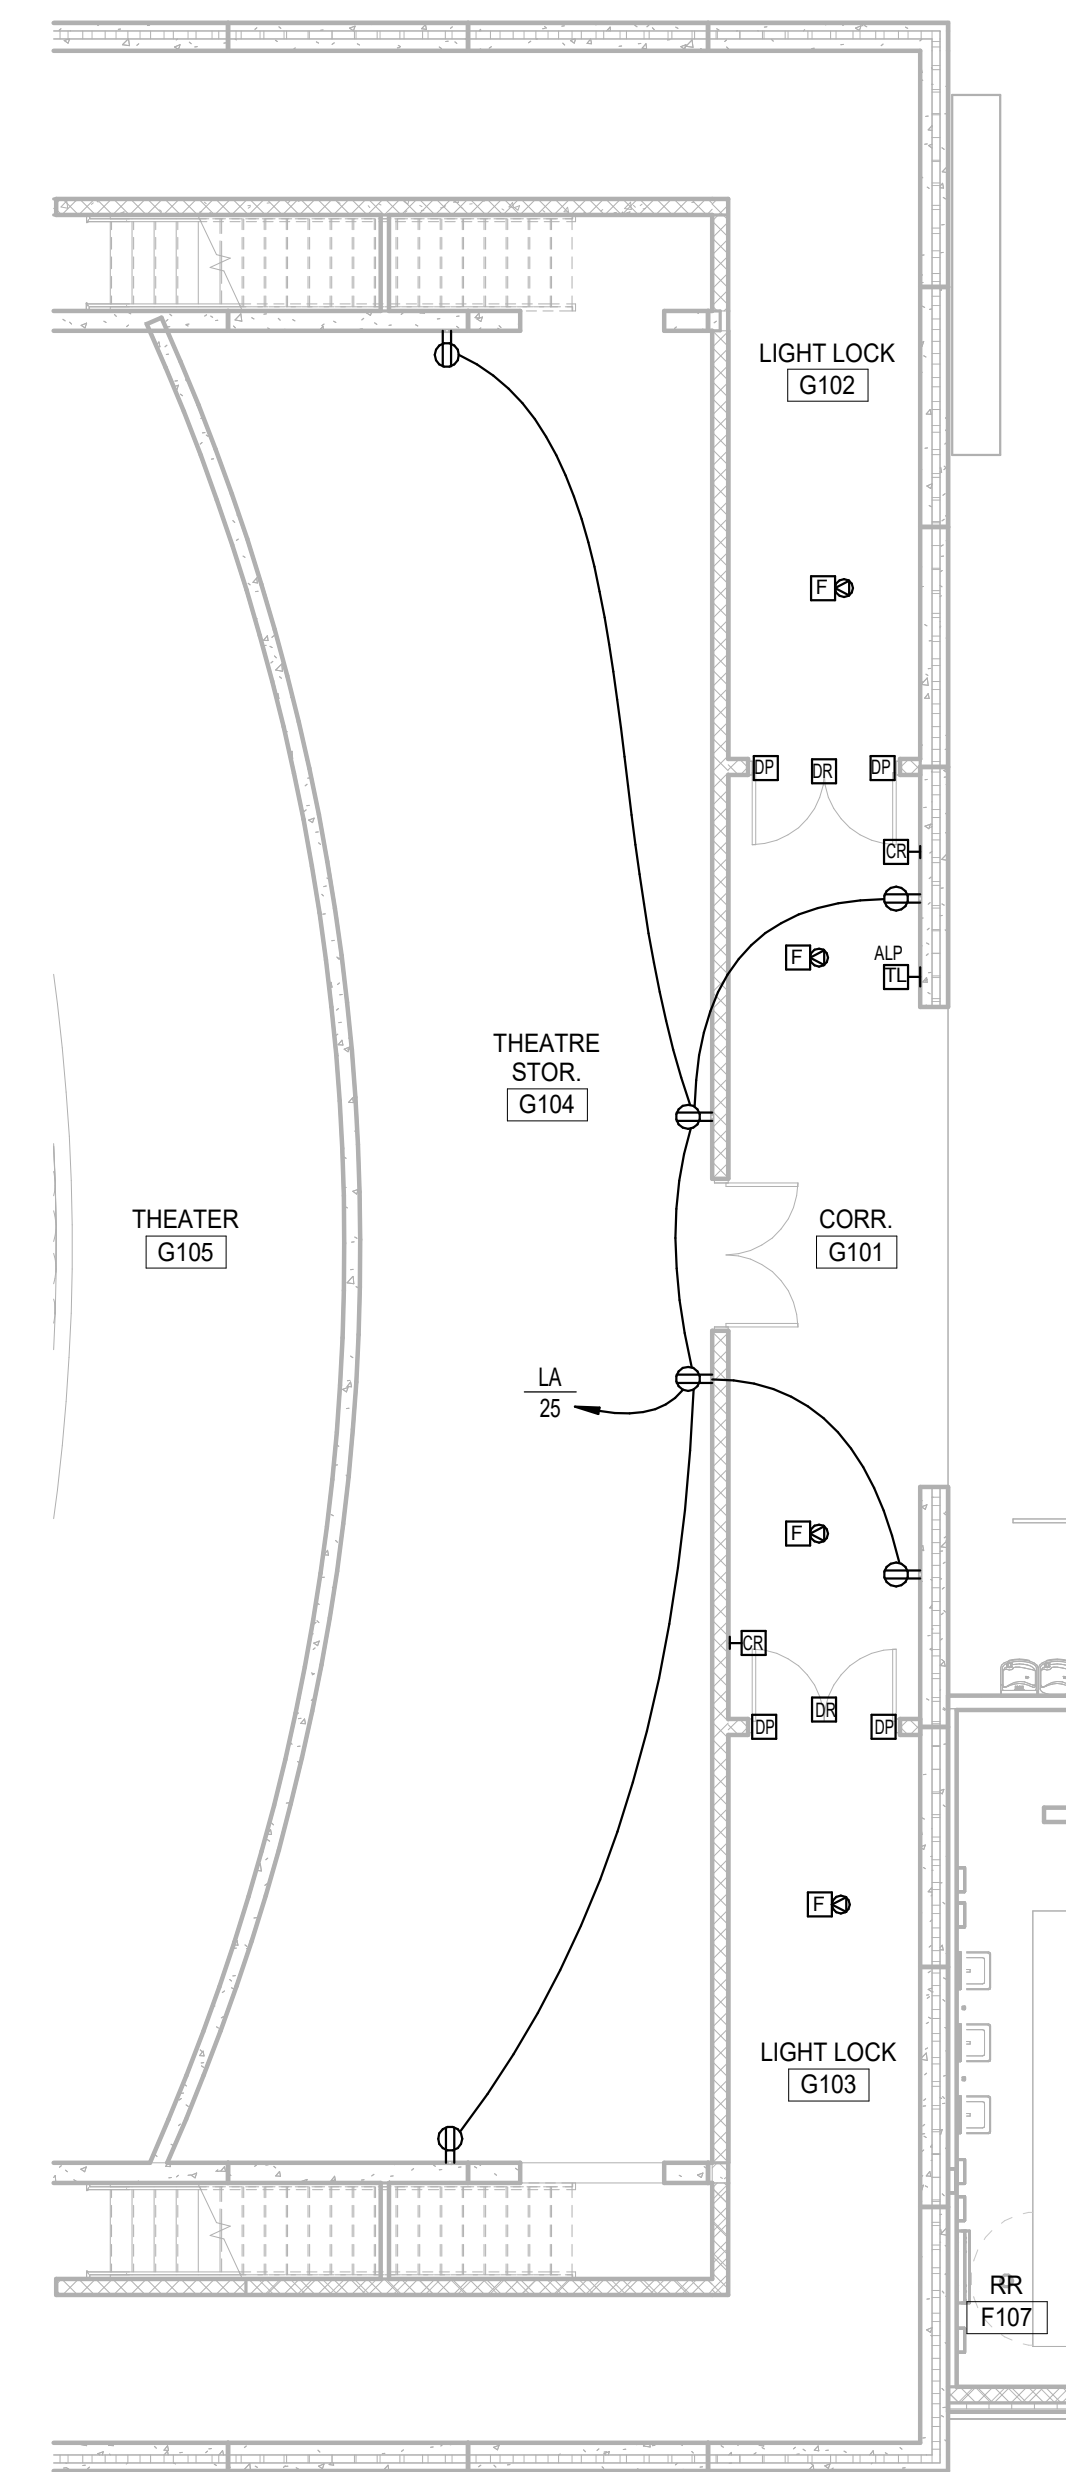

**THEATER STORAGE - AREA G - POWER & SIGNAL**  
SCALE 0 4 8 12 16

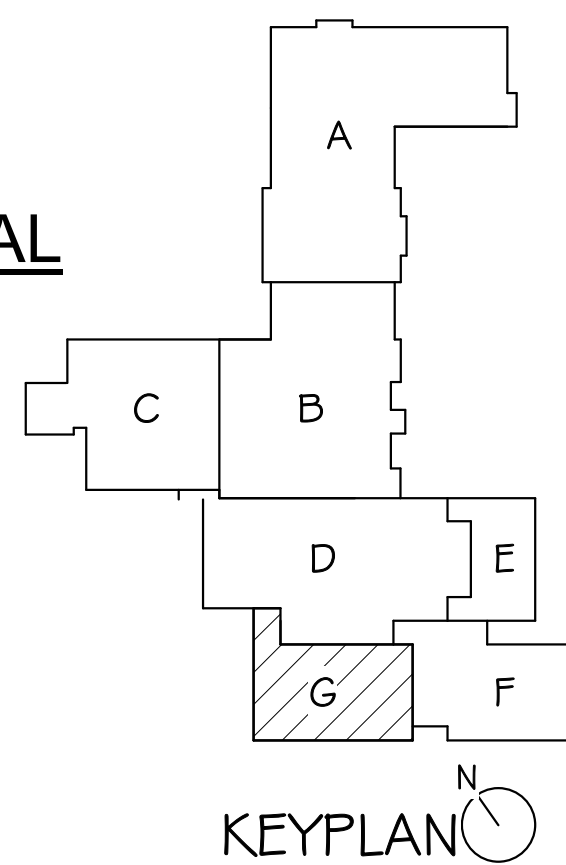


**ELECTRICAL NOTES**

1. PROVIDE PROVISION FOR FUTURE CCTV CAMERA MOUNTED ON CORNER OF BUILDING. FIELD VERIFY MOUNTING HEIGHT WITH OWNER.
2. MOUNT IN FACE OF STAGE.
3. DEVICES ARE LOCATED IN AV FLOOR BOX FURNISHED BY AV CONTRACTOR.
4. PILOT LIGHT SWITCH FOR CONTROL OF CONTACTOR "CR".
5. AV EQUIPMENT RACK "AR". PROVIDE EQUIPMENT GROUNDING BUS AND CONDUCTOR. SEE SPECIFICATIONS. RACK AND EQUIPMENT PROVIDED BY OWNER.
6. CONTACTOR "CR" (10 POLES).
7. VIA CONTACTOR "CR".
8. REMOTE PILOT LIGHT TO INDICATE WHEN RECEPTACLES AND LIGHTS AT DRESSING ROOM MIRRORS ARE ENERGIZED. MOUNT AT 6' AFF.
9. STAGE SOUND COMPANY SWITCH.
10. STAGE LIGHTING COMPANY SWITCH.

**GENERAL SHEET NOTES**


- A. SEE AV DRAWINGS FOR ADDITIONAL WORK.

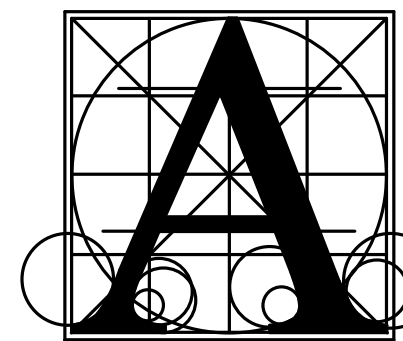

**Architecture  
Incorporated**

415 South Main Avenue  
P.O. Box 2140  
Sioux Falls, South Dakota 57101  
Phone: (605) 339-1711

815 St. Joseph Street, Suite 203  
Rapid City, South Dakota 57701  
Phone: (605) 721-1158

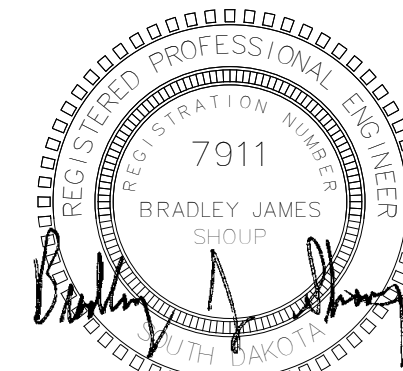

**Associated  
Consulting  
Engineering,  
Incorporated**

340 S. Phillips Ave.  
Sioux Falls, SD 57104

(605) 335-3720  
Fax 335-6220

E-mail acei@aceinet.net

ACEI PROJ. #123034

**LENNOX HIGH SCHOOL ADDITION**

**FIRST FLOOR PLAN - AREA G - POWER & SIGNAL**

Project

number 0215.2902.22

date DECEMBER 21, 2023



revision

drawn KMT checked BJ5


DATE	DESCRIPTION
01-11-2024	Addendum #1
01-18-2024	Addendum #2

**9.47-G**




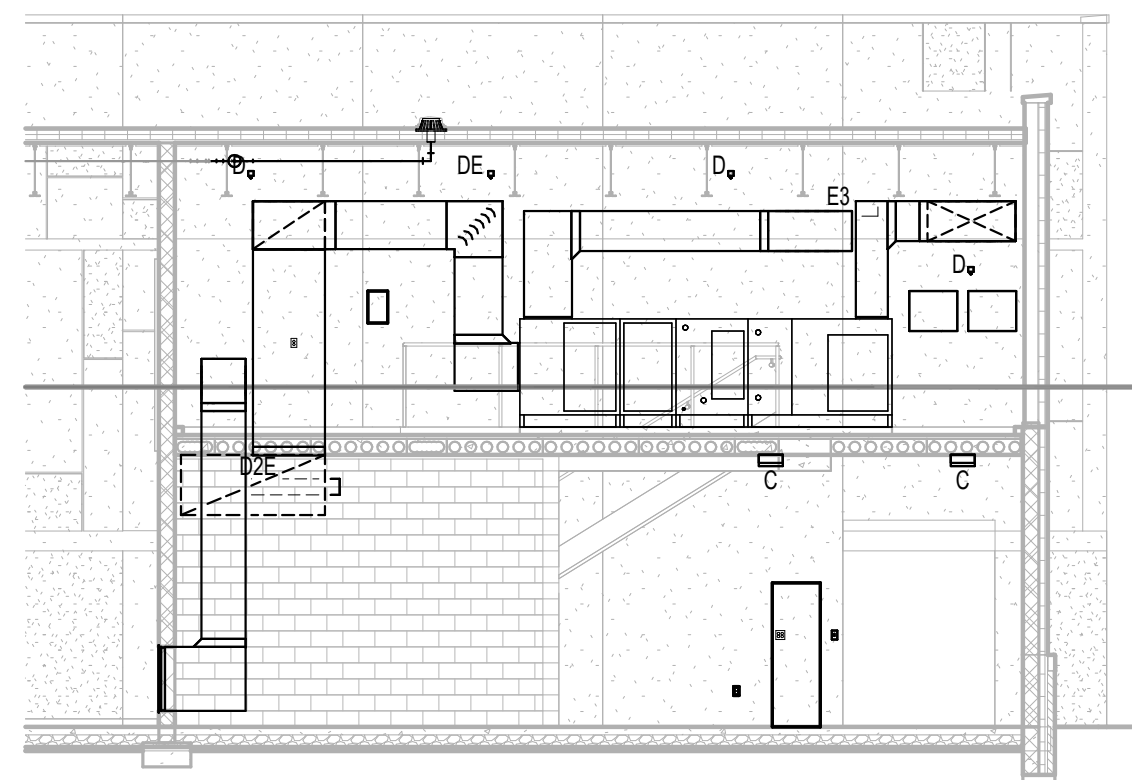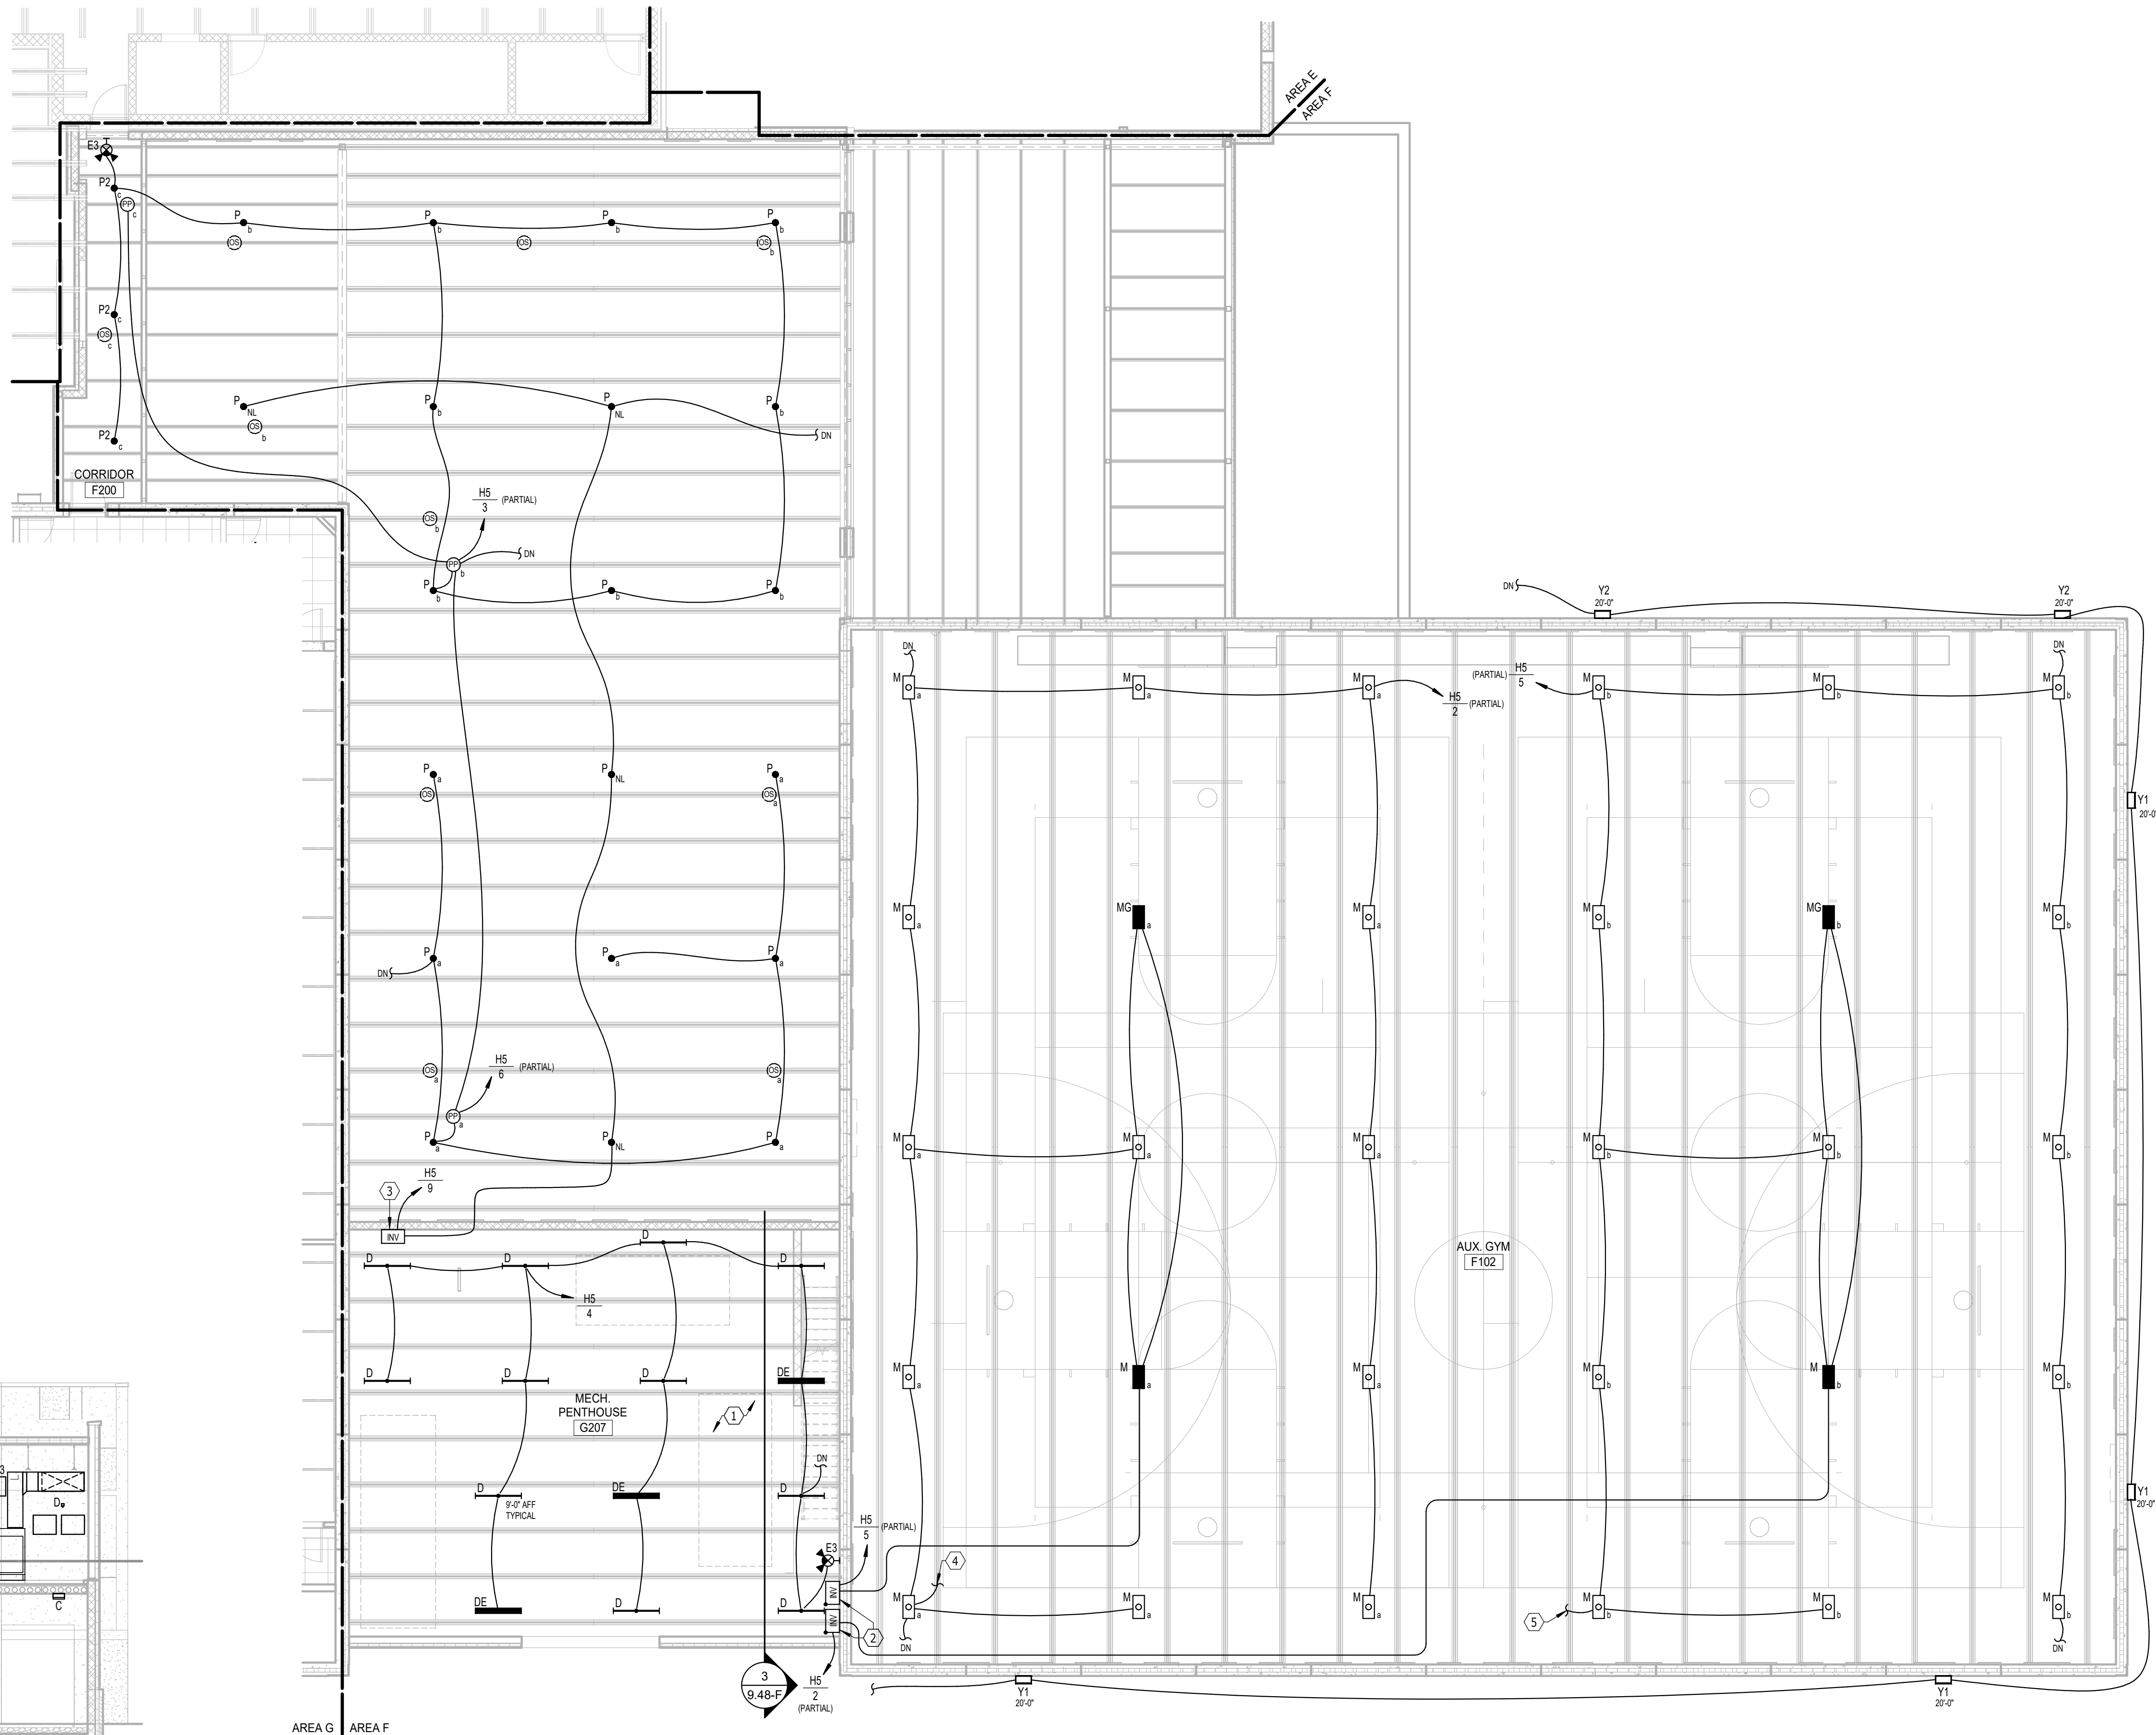

③ MECH. PENTHOUSE G207  
1/8" = 1'-0"

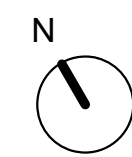

MEZZANINE PLAN - AREA F - LIGHTING  
SCALE 0 4 8 12 16

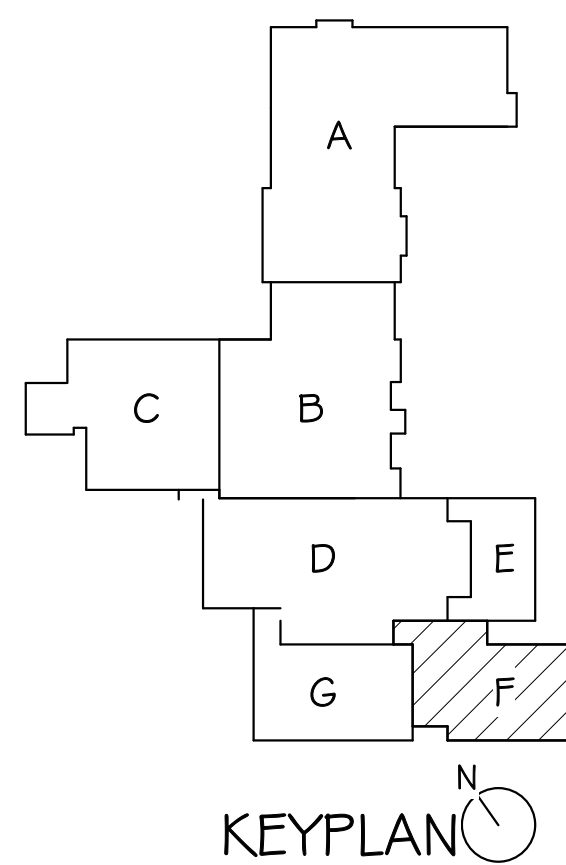


#### ELECTRICAL NOTES

- COORDINATE LIGHTING INSTALLATION WITH MECHANICAL EQUIPMENT, SHIFT AS NECESSARY.
- EMERGENCY LIGHTING INVERTERS "INV-GA" (EQUAL TO EMERGH-LITE EMU-720) AND "INV-GB" (EQUAL TO EMERGH-LITE EMU 720), AND BODINE GTD-20A TRANSFER DEVICES "GTD-A" AND GTD-B".
- INVERTOR EQUAL TO EMERGH-LITE EMU-1000.
- SWITCHLEG TO GTD DEVICE "GTD-A".
- SWITCHLEG TO GTD DEVICE "GTD-B".

#### GENERAL SHEET NOTES


- ELECTRICAL CONTRACTOR SHALL VERIFY ALL CEILING TYPES, AND MOUNTING HARDWARE REQUIRED PRIOR TO PURCHASE OF ANY LIGHTING FIXTURES.
- ALL STEP LIGHTS SHALL BE MOUNTED AT +2'-0" A.F.F. TO CENTER OF FIXTURE UNLESS OTHERWISE NOTED.
- ALL SWITCHES, DIMMERS OR BUTTON STATIONS SHALL BE MOUNTED AT +4'-0" A.F.F. TO BOTTOM OF FIXTURE UNLESS OTHERWISE NOTED. CONFIRM WITH ARCHITECTURAL DRAWINGS.

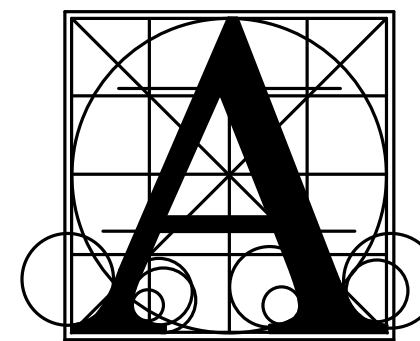

Architecture  
Incorporated

415 South Main Avenue  
P.O. Box 2140  
Sioux Falls, South Dakota 57101  
Phone: (605) 339-1711

815 St. Joseph Street, Suite 203  
Rapid City, South Dakota 57701  
Phone: (605) 721-1158

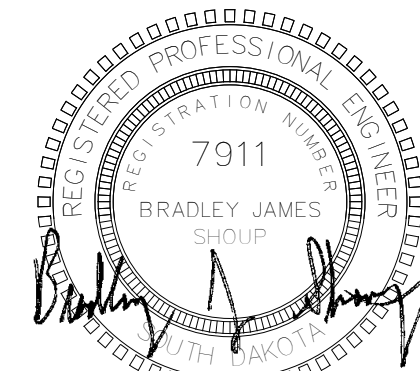

Associated  
Consulting  
Engineering,  
Incorporated

340 S. Phillips Ave.  
Sioux Falls, SD 57104  
(605) 335-3720  
Fax 335-6220  
E-mail acei@aceinet.com  
ACEI PROJ. #123034

LENNOX HIGH SCHOOL ADDITION



MEZZANINE PLAN - AREA F - LIGHTING

Project


number 0215.2902.22  
date DECEMBER 21, 2023  
revision  
drawn KMT checked BJS

DATE	DESCRIPTION
01-11-2024	Addendum #1
01-18-2024	Addendum #2


9.48-F

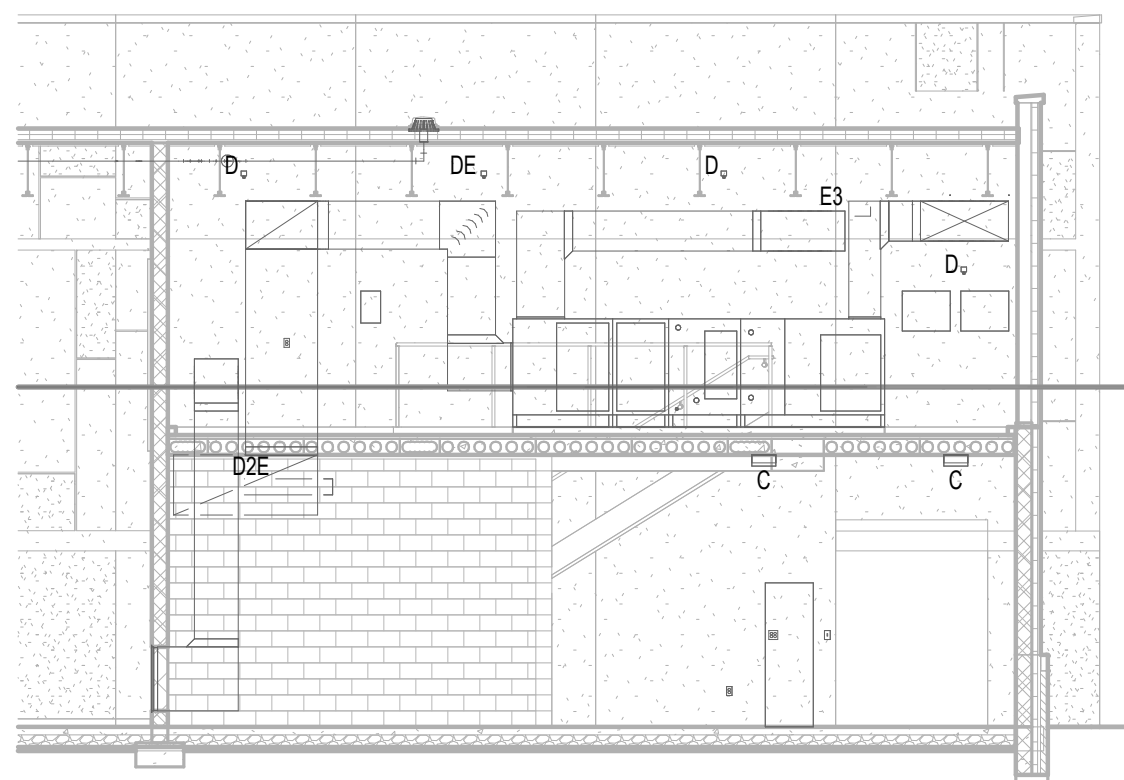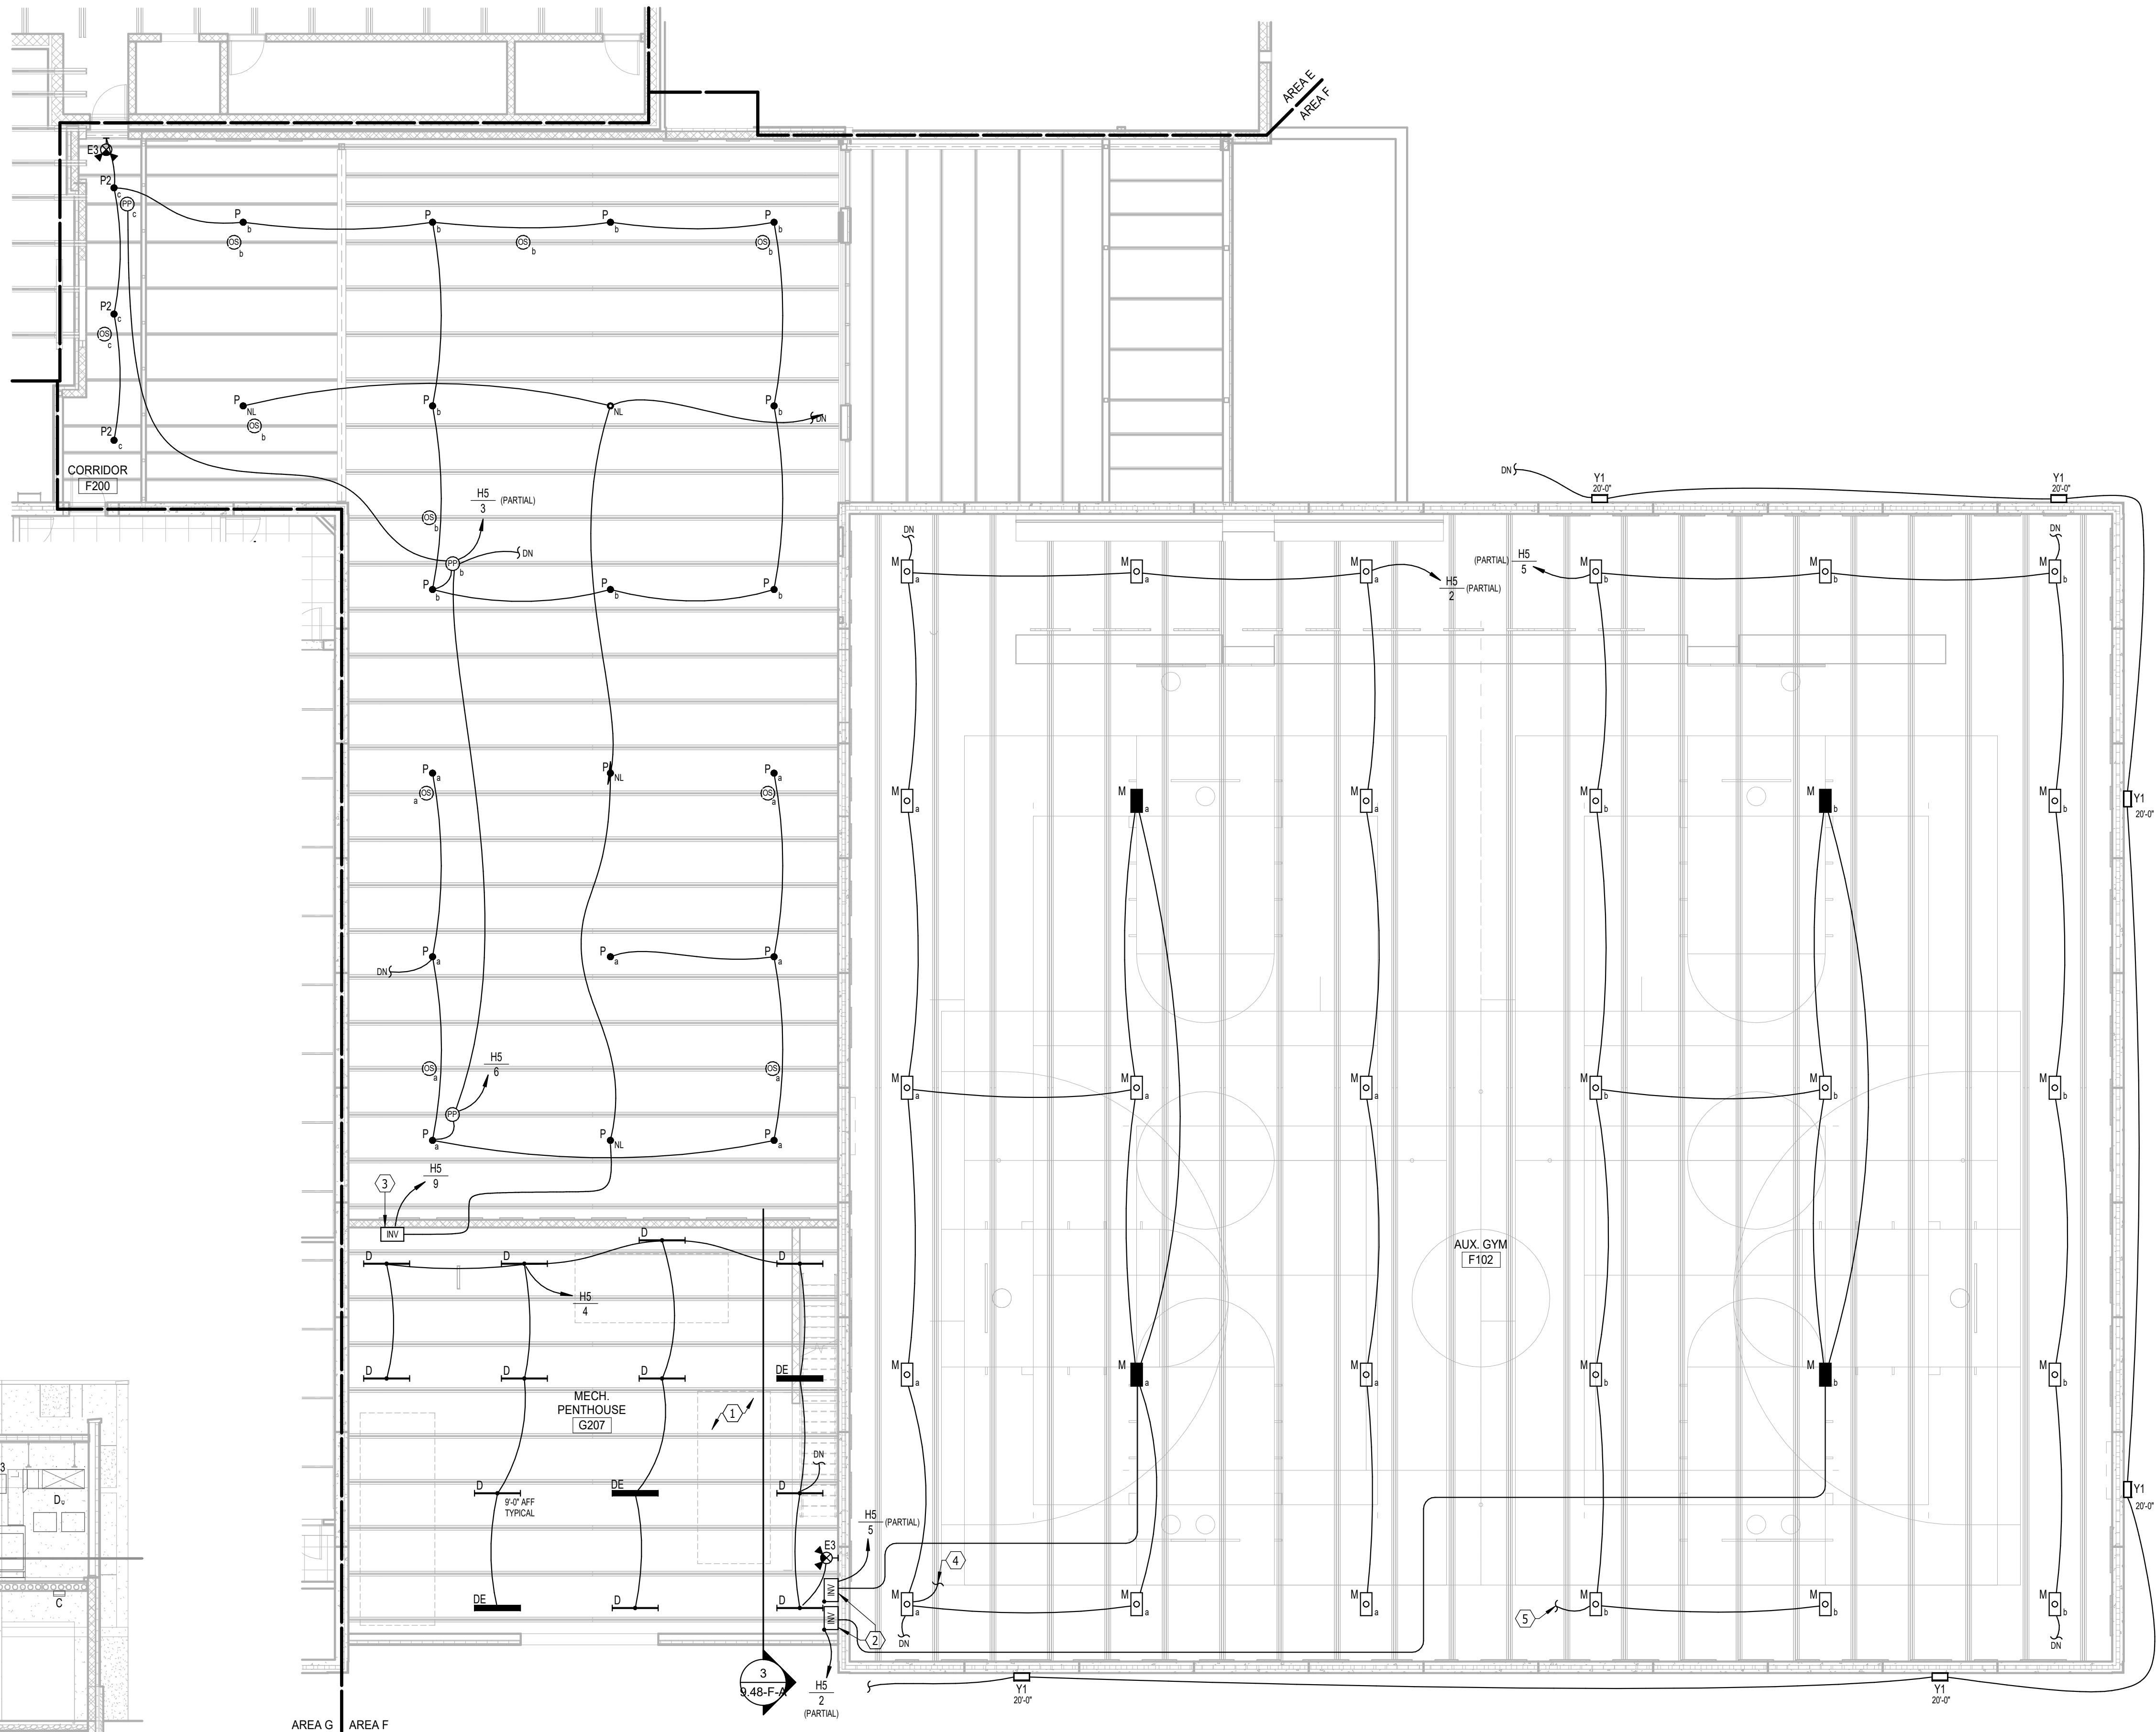

3 MECH. PENTHOUSE G207 ADD ALTERNATE  
1/8" = 1'-0"

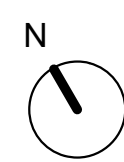

MEZZANINE PLAN - AREA F - LIGHTING ADD ALTERNATE  
SCALE 0 4 8 12 16

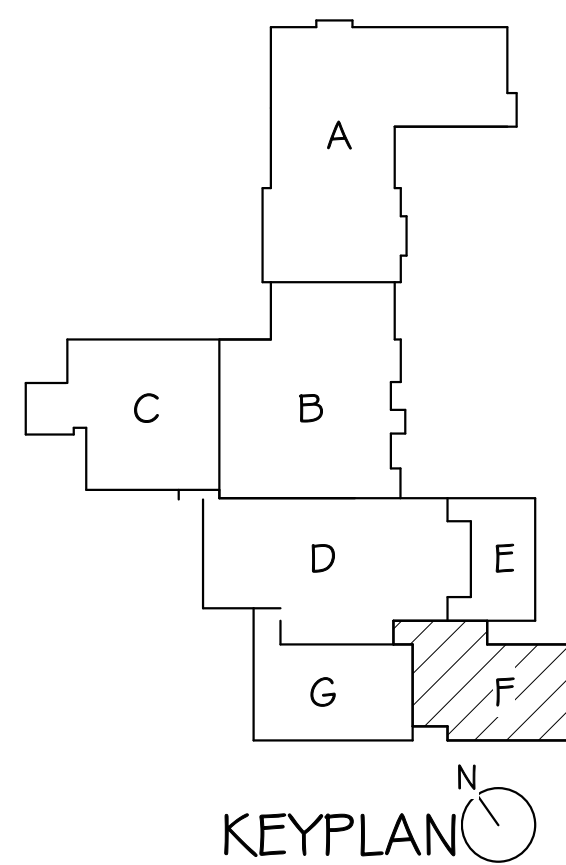


KEYPLAN

#### ELECTRICAL NOTES

- COORDINATE LIGHTING INSTALLATION WITH MECHANICAL EQUIPMENT, SHIFT AS NECESSARY.
- EMERGENCY LIGHTING INVERTERS "INV-GA" (EQUAL TO EMERGH-LITE EMU-720) AND "INV-GB" (EQUAL TO EMERGH-LITE EMU 720), AND BODINE GTD-20A TRANSFER DEVICES "GTD-A" AND "GTD-B".
- INVERTOR EQUAL TO EMERGH-LITE EMU-1000.
- SWITCHLEG TO GTD DEVICE "GTD-A".
- SWITCHLEG TO GTD DEVICE "GTD-B".

#### GENERAL SHEET NOTES


- ELECTRICAL CONTRACTOR SHALL VERIFY ALL CEILING TYPES, AND MOUNTING HARDWARE REQUIRED PRIOR TO PURCHASE OF ANY LIGHTING FIXTURES.
- ALL STEP LIGHTS SHALL BE MOUNTED AT +2'-0" A.F.F. TO CENTER OF FIXTURE UNLESS OTHERWISE NOTED.
- ALL SWITCHES, DIMMERS OR BUTTON STATIONS SHALL BE MOUNTED AT +40" A.F.F. TO BOTTOM OF FIXTURE UNLESS OTHERWISE NOTED. CONFIRM WITH ARCHITECTURAL DRAWINGS.

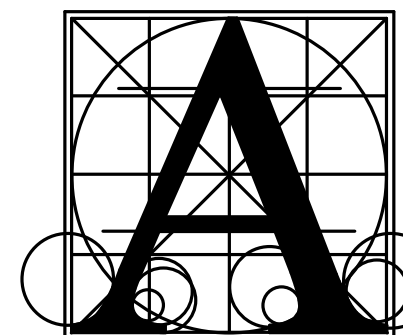

Architecture  
Incorporated

415 South Main Avenue  
P.O. Box 2140  
Sioux Falls, South Dakota 57101  
Phone: (605) 339-1711

815 St. Joseph Street, Suite 203  
Rapid City, South Dakota 57701  
Phone: (605) 721-1158

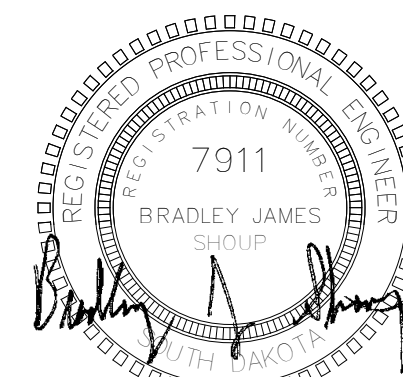

Associated  
Consulting  
Engineering,  
Incorporated

340 S. Phillips Ave.  
Sioux Falls, SD 57104

(605) 335-3720  
Fax 335-6220

E-mail acei@aceinet.com

ACEI PROJ. #123034

LENNOX HIGH SCHOOL ADDITION

MEZZANINE PLAN - AREA F - LIGHTING ADD ALTERNATE

Project

number 0215.2902.22

date DECEMBER 21, 2023

revision

drawn KMT checked BJS


DATE DESCRIPTION

01-11-2024 Addendum #1


01-18-2024 Addendum #2

9.48-F-A



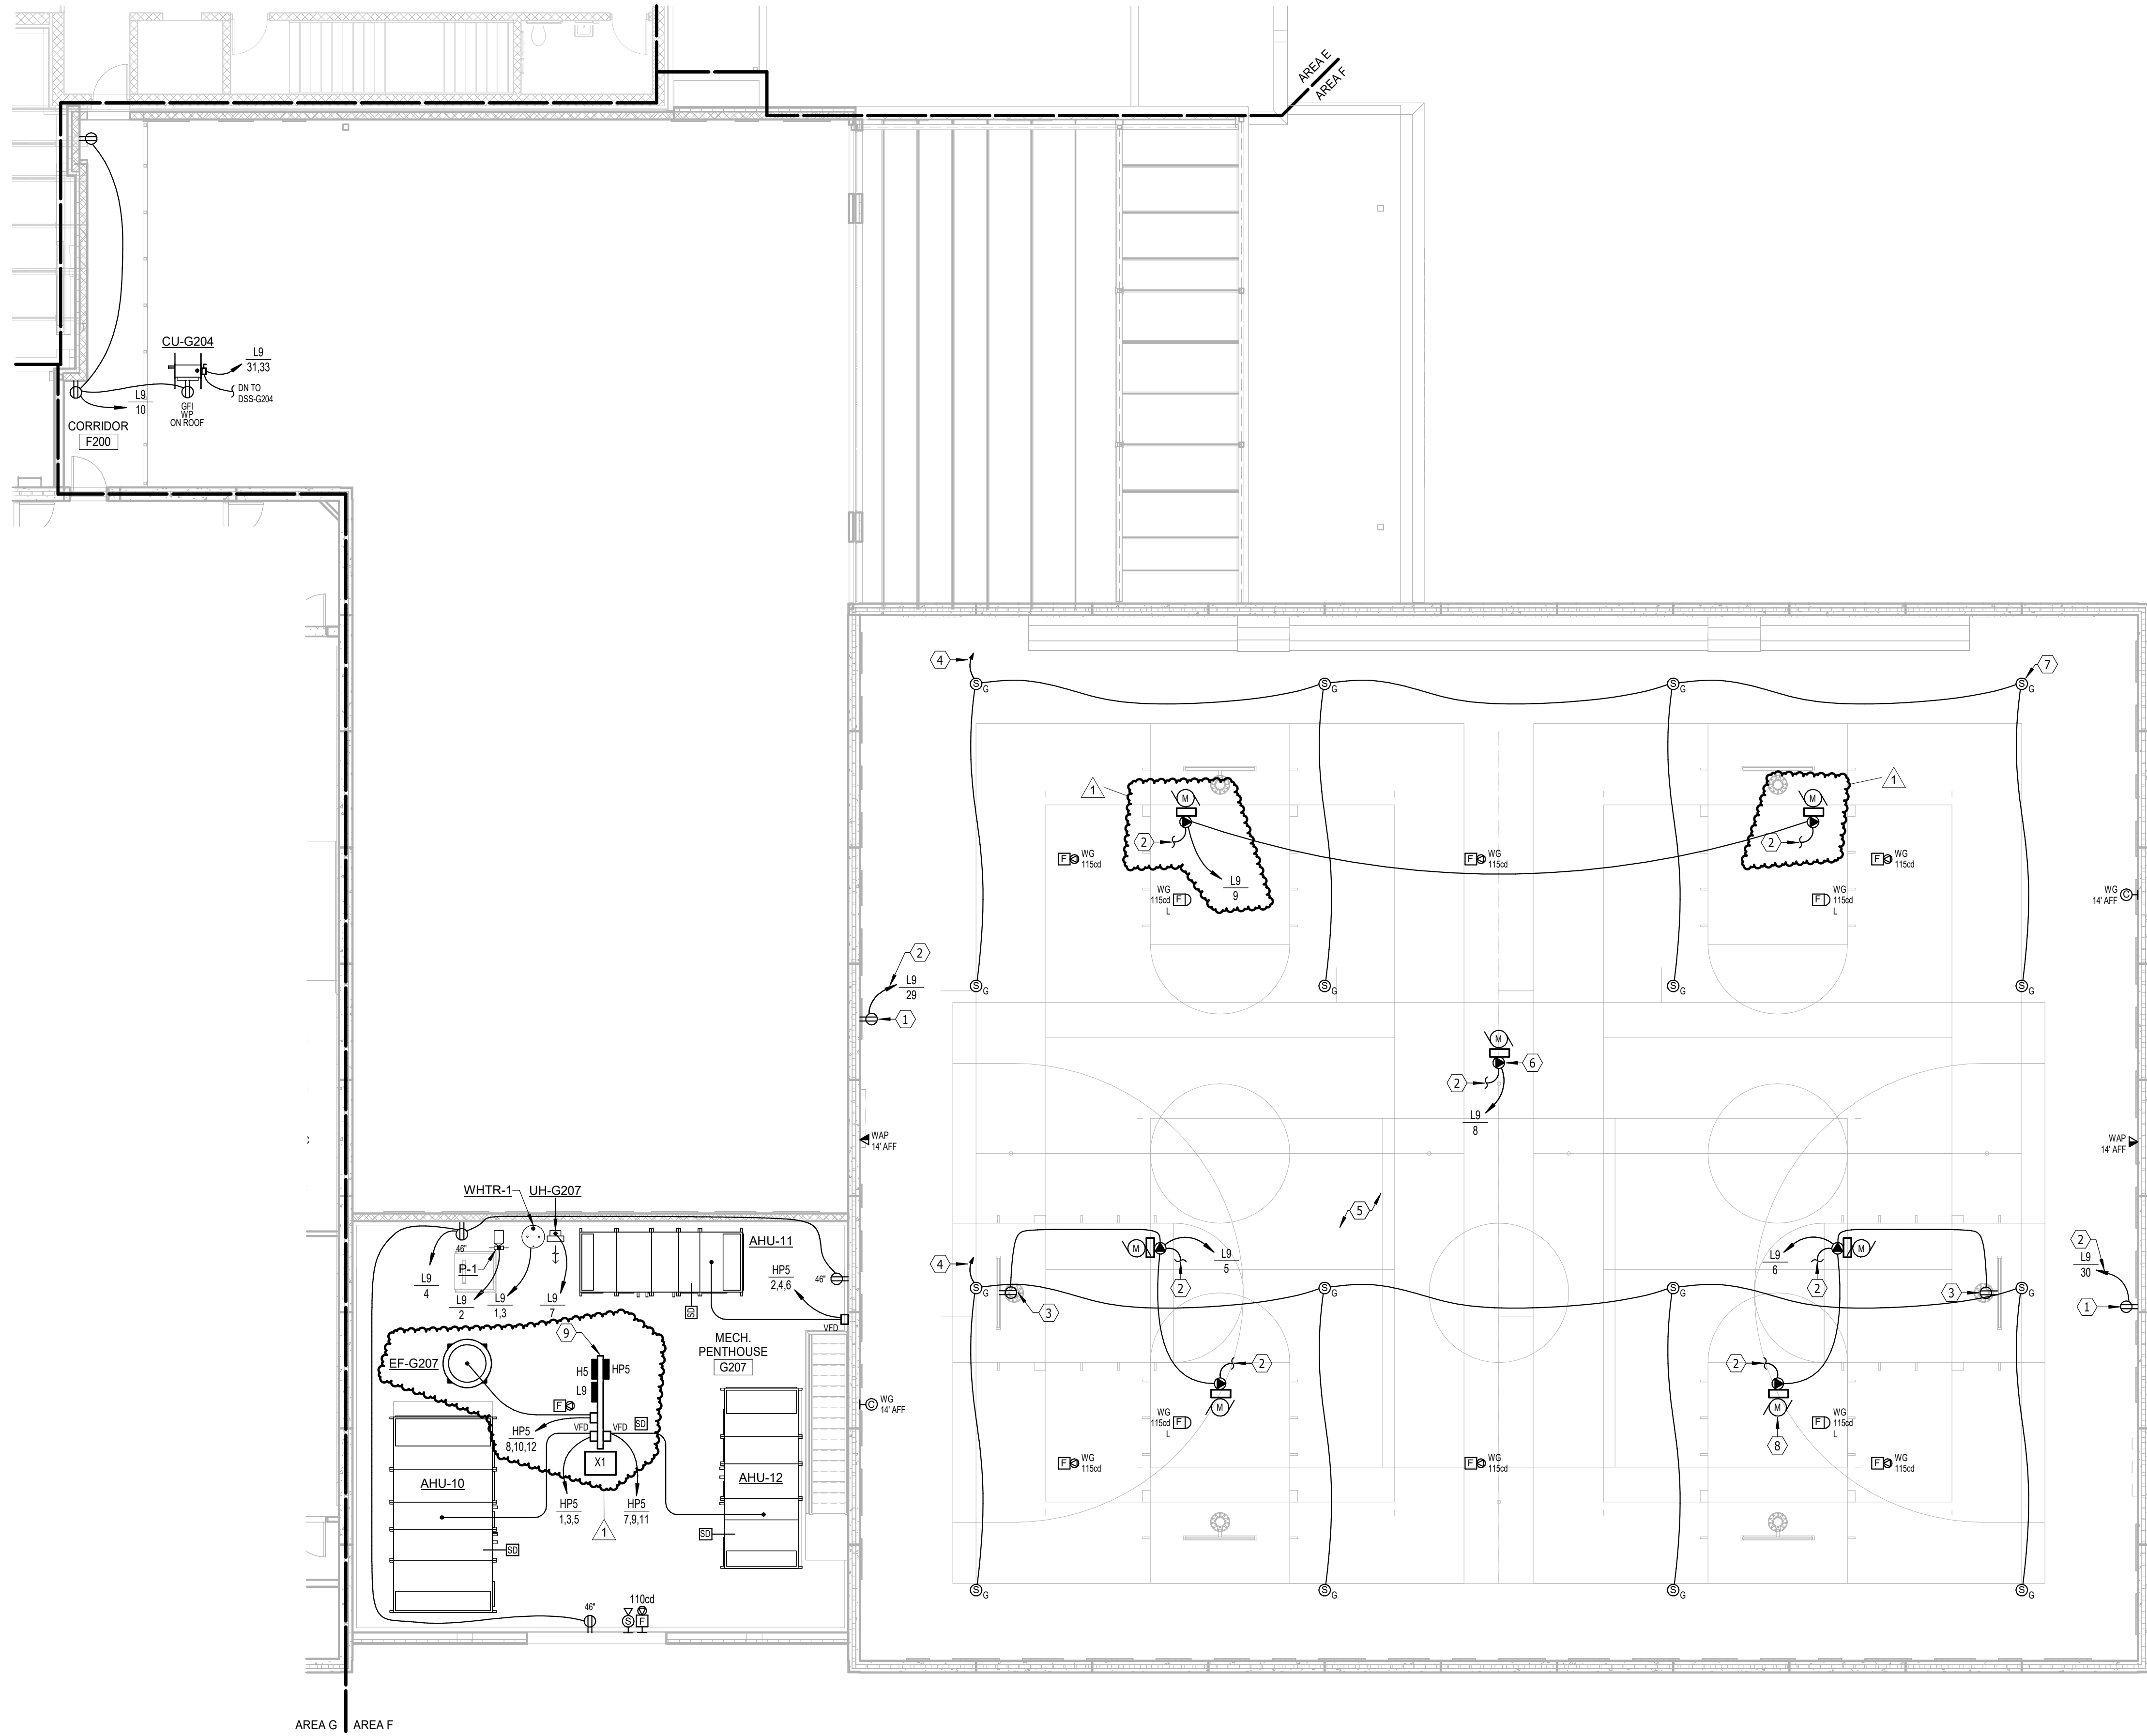

MEZZANINE PLAN - AREA F - POWER & SIGNAL

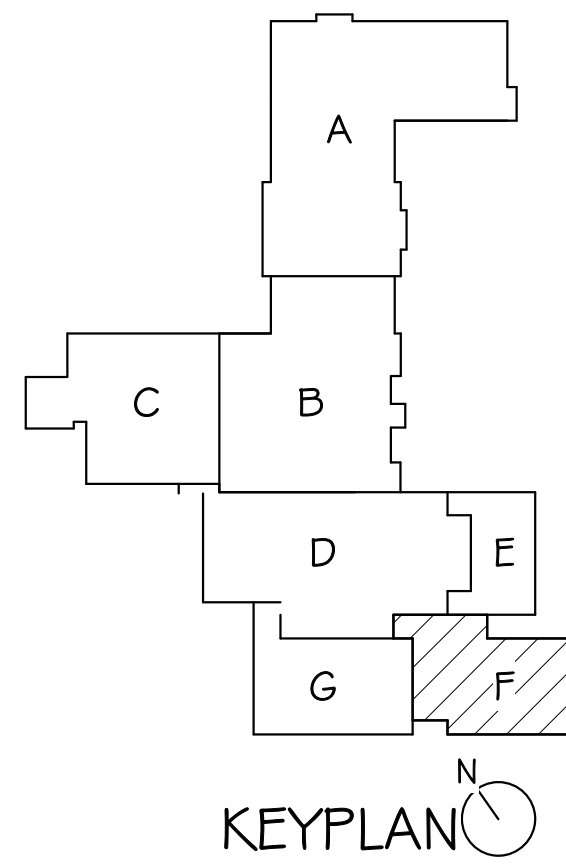


ELECTRICAL NOTES

1. PROVIDE DUPLEX RECEPTACLE FOR SCOREBOARD, COORDINATE MOUNTING HEIGHT WITH OWNER.
2. TO SWITCH IN GGP.
3. COORDINATE INSTALLATION WITH SHOT CLOCK AND BACKBOARD EQUIPMENT SUPPLIERS.
4. TO GYM SOUND RACK.
5. ALL 120V RECEPTACLE CIRCUITS IN THIS ROOM SHALL BE IN #10 AWG THROUGHOUT.
6. COORDINATE CONNECTION REQUIREMENTS WITH DIVIDER CURTAIN SUPPLIER.
7. GYM SOUND SYSTEM SPEAKER, TYPICAL.
8. COORDINATE CONNECTION REQUIREMENTS WITH BACKBOARD EQUIPMENT SUPPLIER, TYPICAL OF 6 EACH.
9. EC TO MOUNT ELECTRICAL EQUIPMENT IN UNISTRUT.

GENERAL SHEET NOTES


- A. SEE AV DRAWINGS FOR ADDITIONAL WORK.

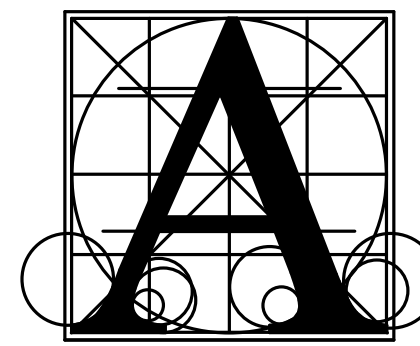

Architecture  
Incorporated

415 South Main Avenue  
P.O. Box 2140  
Sioux Falls, South Dakota 57101  
Phone: (605) 339-1711

815 St. Joseph Street, Suite 203  
Rapid City, South Dakota 57701  
Phone: (605) 721-1158

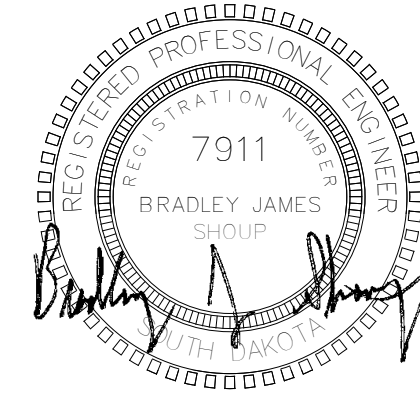


Associated  
Consulting  
Engineering,  
Incorporated

340 S. Phillips Ave.  
Sioux Falls, SD 57104  
(605) 335-3720  
Fax 335-6220  
E-mail acei@aceinet.com  
ACEI PROJ. #123034


LENNOX HIGH SCHOOL ADDITION  
MEZZANINE PLAN - AREA F - POWER & SIGNAL

number	0215.2902.22
date	DECEMBER 21, 2023
revision	
drawn	KMT
checked	BJ5
DATE	DESCRIPTION
01-18-2024	Addendum #2

9.49-F

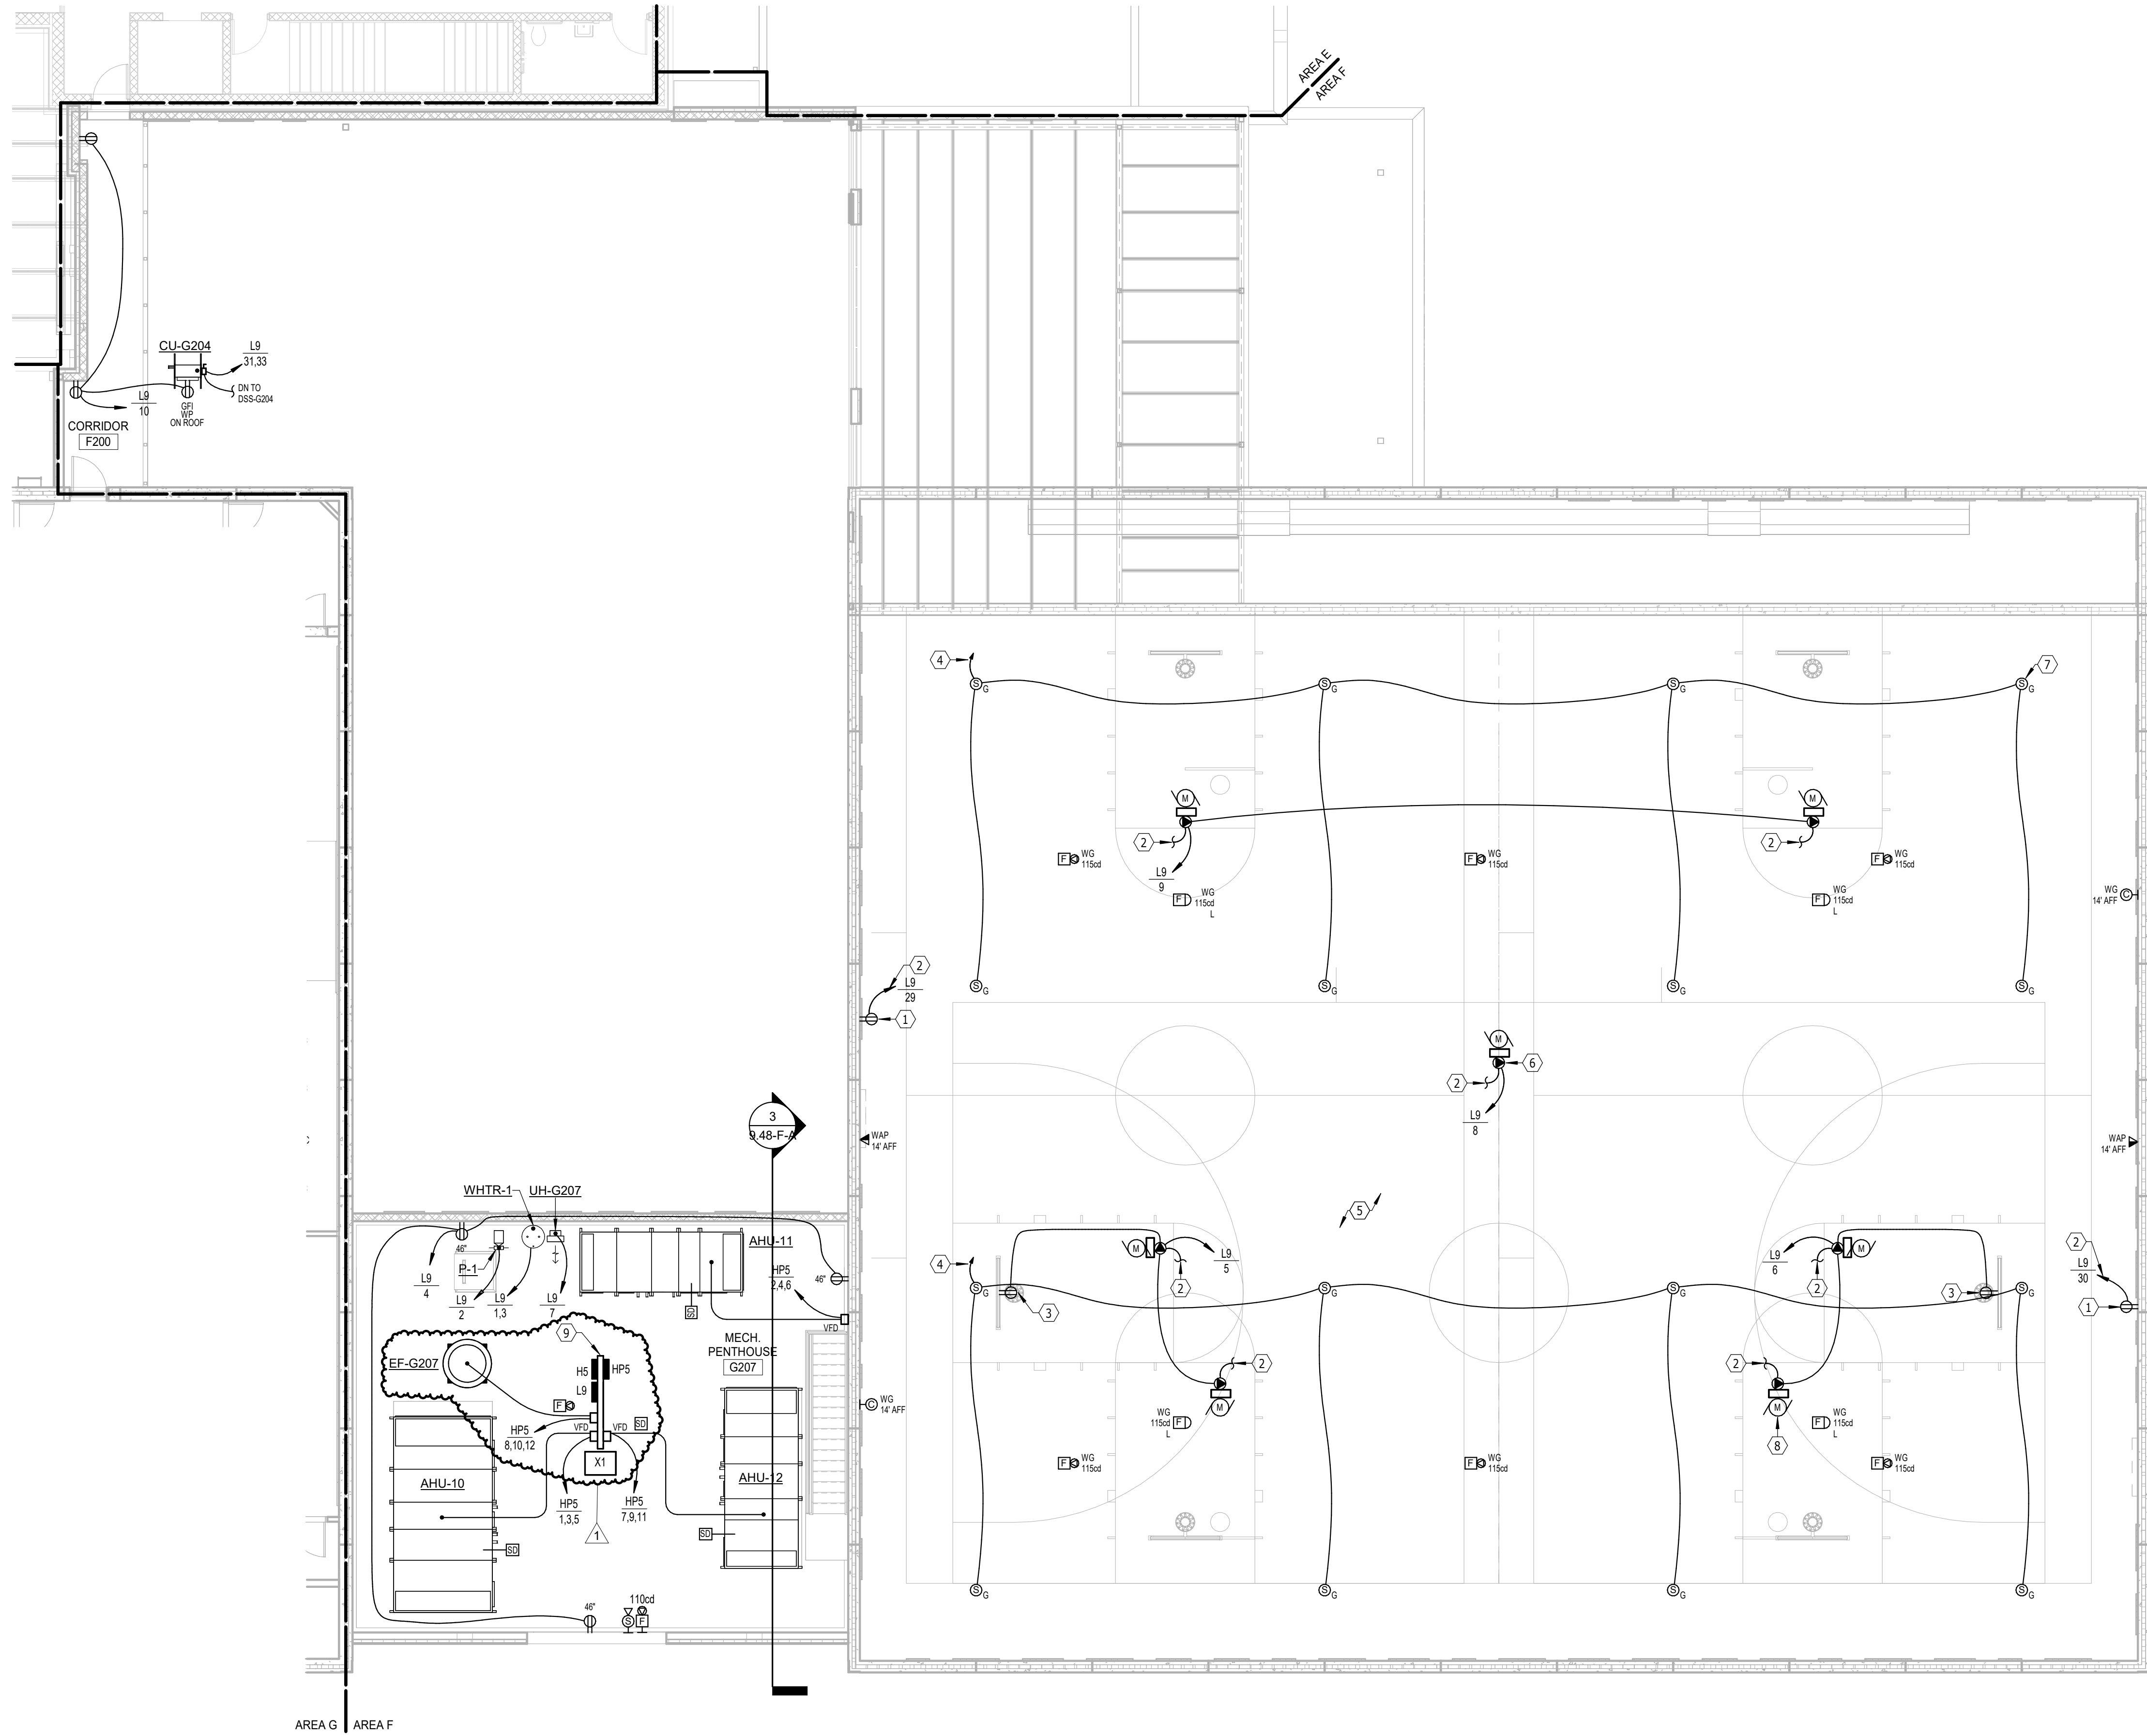

MEZZANINE PLAN - AREA F - POWER & SIGNAL - ADD ALTERNATE

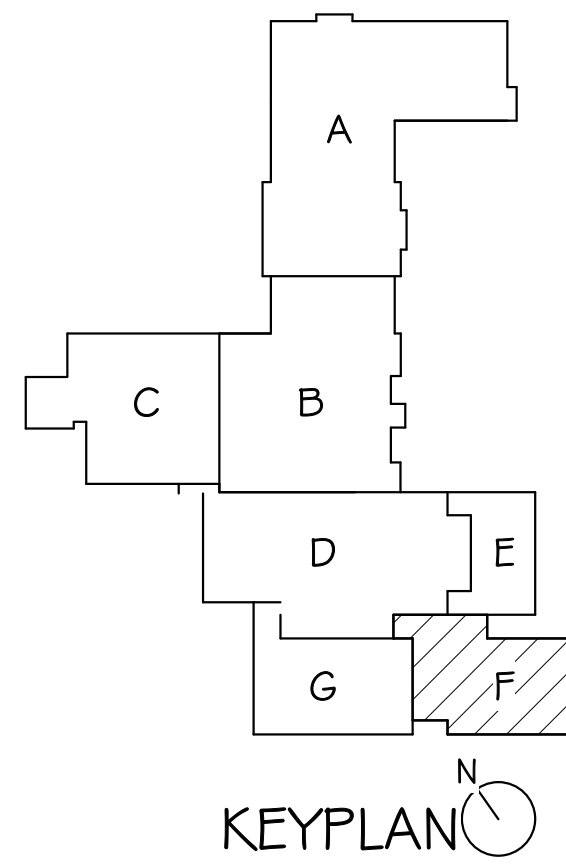


ELECTRICAL NOTES

1. PROVIDE DUPLEX RECEPTACLE FOR SCOREBOARD, COORDINATE MOUNTING HEIGHT WITH OWNER.
2. TO SWITCH IN GGP.
3. COORDINATE INSTALLATION WITH SHOT CLOCK AND BACKBOARD EQUIPMENT SUPPLIERS.
4. TO GYM SOUND RACK.
5. ALL 120V RECEPTACLE CIRCUITS IN THIS ROOM SHALL BE IN #10 AWG THROUGHOUT.
6. COORDINATE CONNECTION REQUIREMENTS WITH DIVIDER CURTAIN SUPPLIER.
7. GYM SOUND SYSTEM SPEAKER, TYPICAL.
8. COORDINATE CONNECTION REQUIREMENTS WITH BACKBOARD EQUIPMENT SUPPLIER, TYPICAL OF 6 EACH.
9. EC TO MOUNT ELECTRICAL EQUIPMENT IN UNISTRUT.

GENERAL SHEET NOTES


- A. SEE AV DRAWINGS FOR ADDITIONAL WORK.

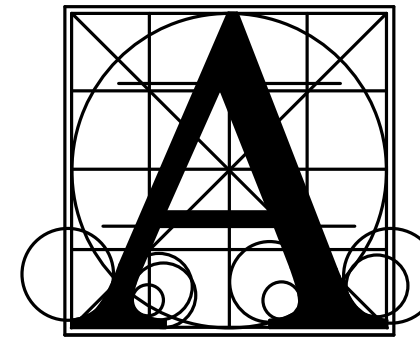

Architecture  
Incorporated

415 South Main Avenue  
P.O. Box 2140  
Sioux Falls, South Dakota 57101  
Phone: (605) 339-1711

815 St. Joseph Street, Suite 203  
Rapid City, South Dakota 57701  
Phone: (605) 721-1158

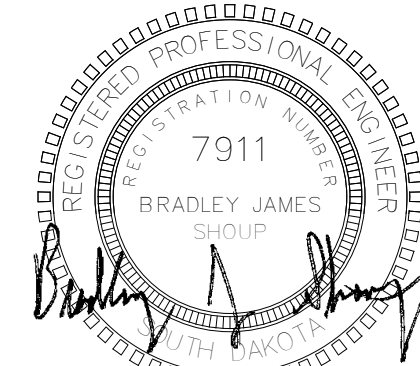

Associated  
Consulting  
Engineering,  
Incorporated

340 S. Phillips Ave.  
Sioux Falls, SD 57104  
(605) 335-3720  
Fax 335-6220  
E-mail acei@aceinet.com  
ACEI PROJ. #123034

LENNOX HIGH SCHOOL ADDITION

MEZZANINE PLAN - AREA F - POWER & SIGNAL - ADD ALTERNATE


Project

number 0215.2902.22  
date DECEMBER 21, 2023  
revision  
drawn KMT checked BJ5


DATE DESCRIPTION  
01-18-2024 Addendum #2

9.49-F-A




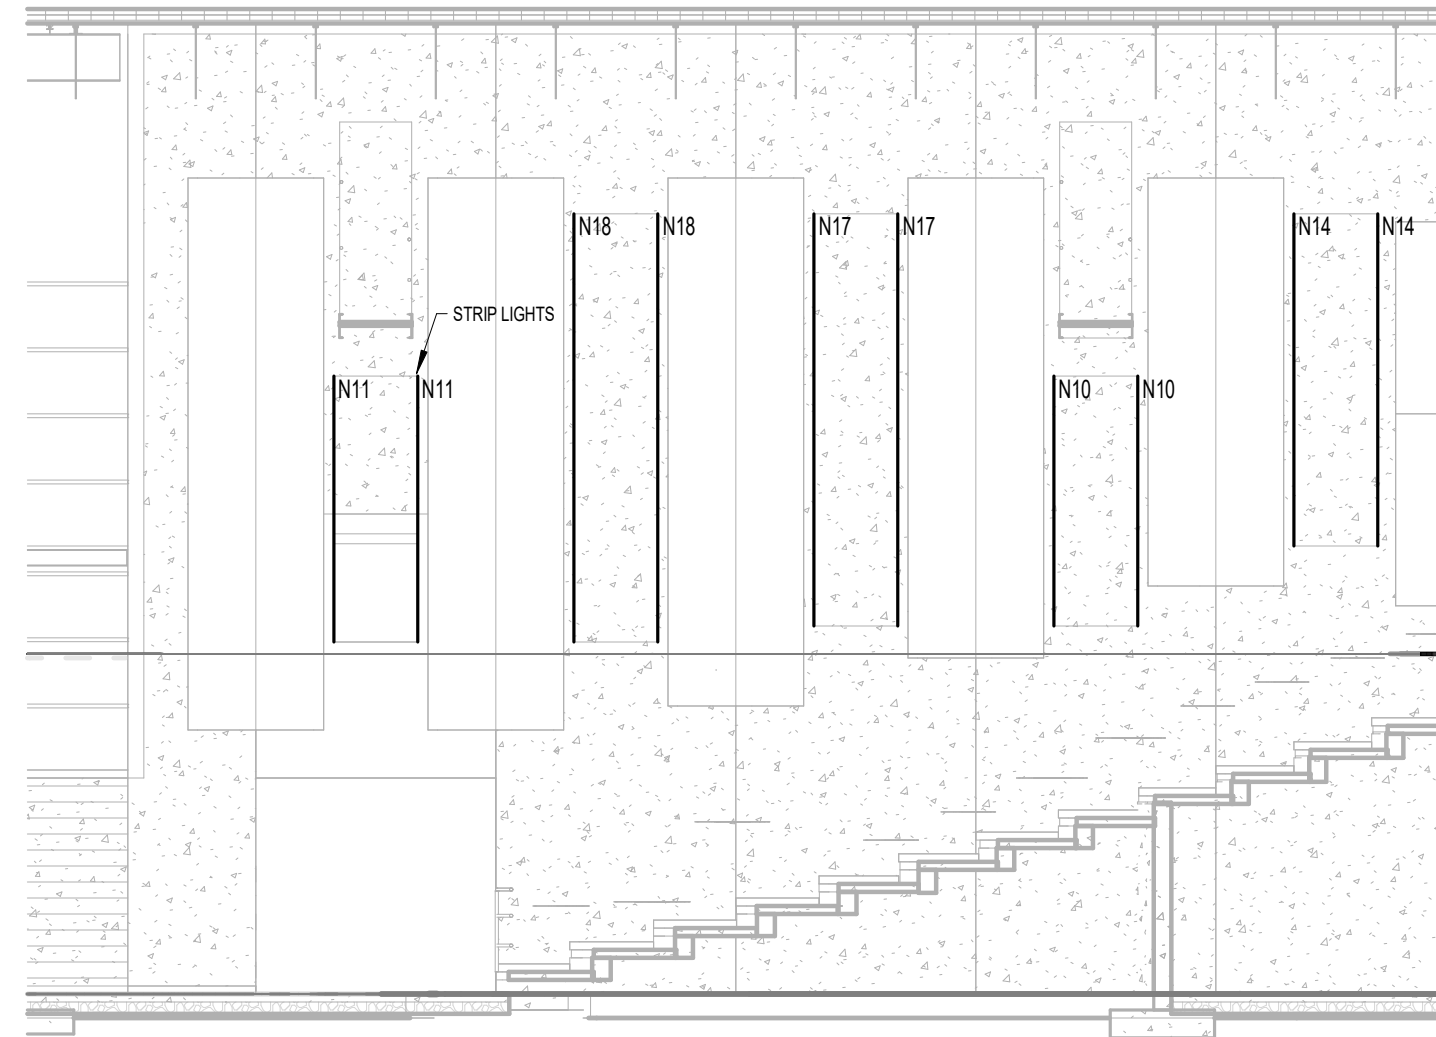

**AUDITORIUM STRIP LIGHT DETAIL**  
SCALE 0 4 8 12 16

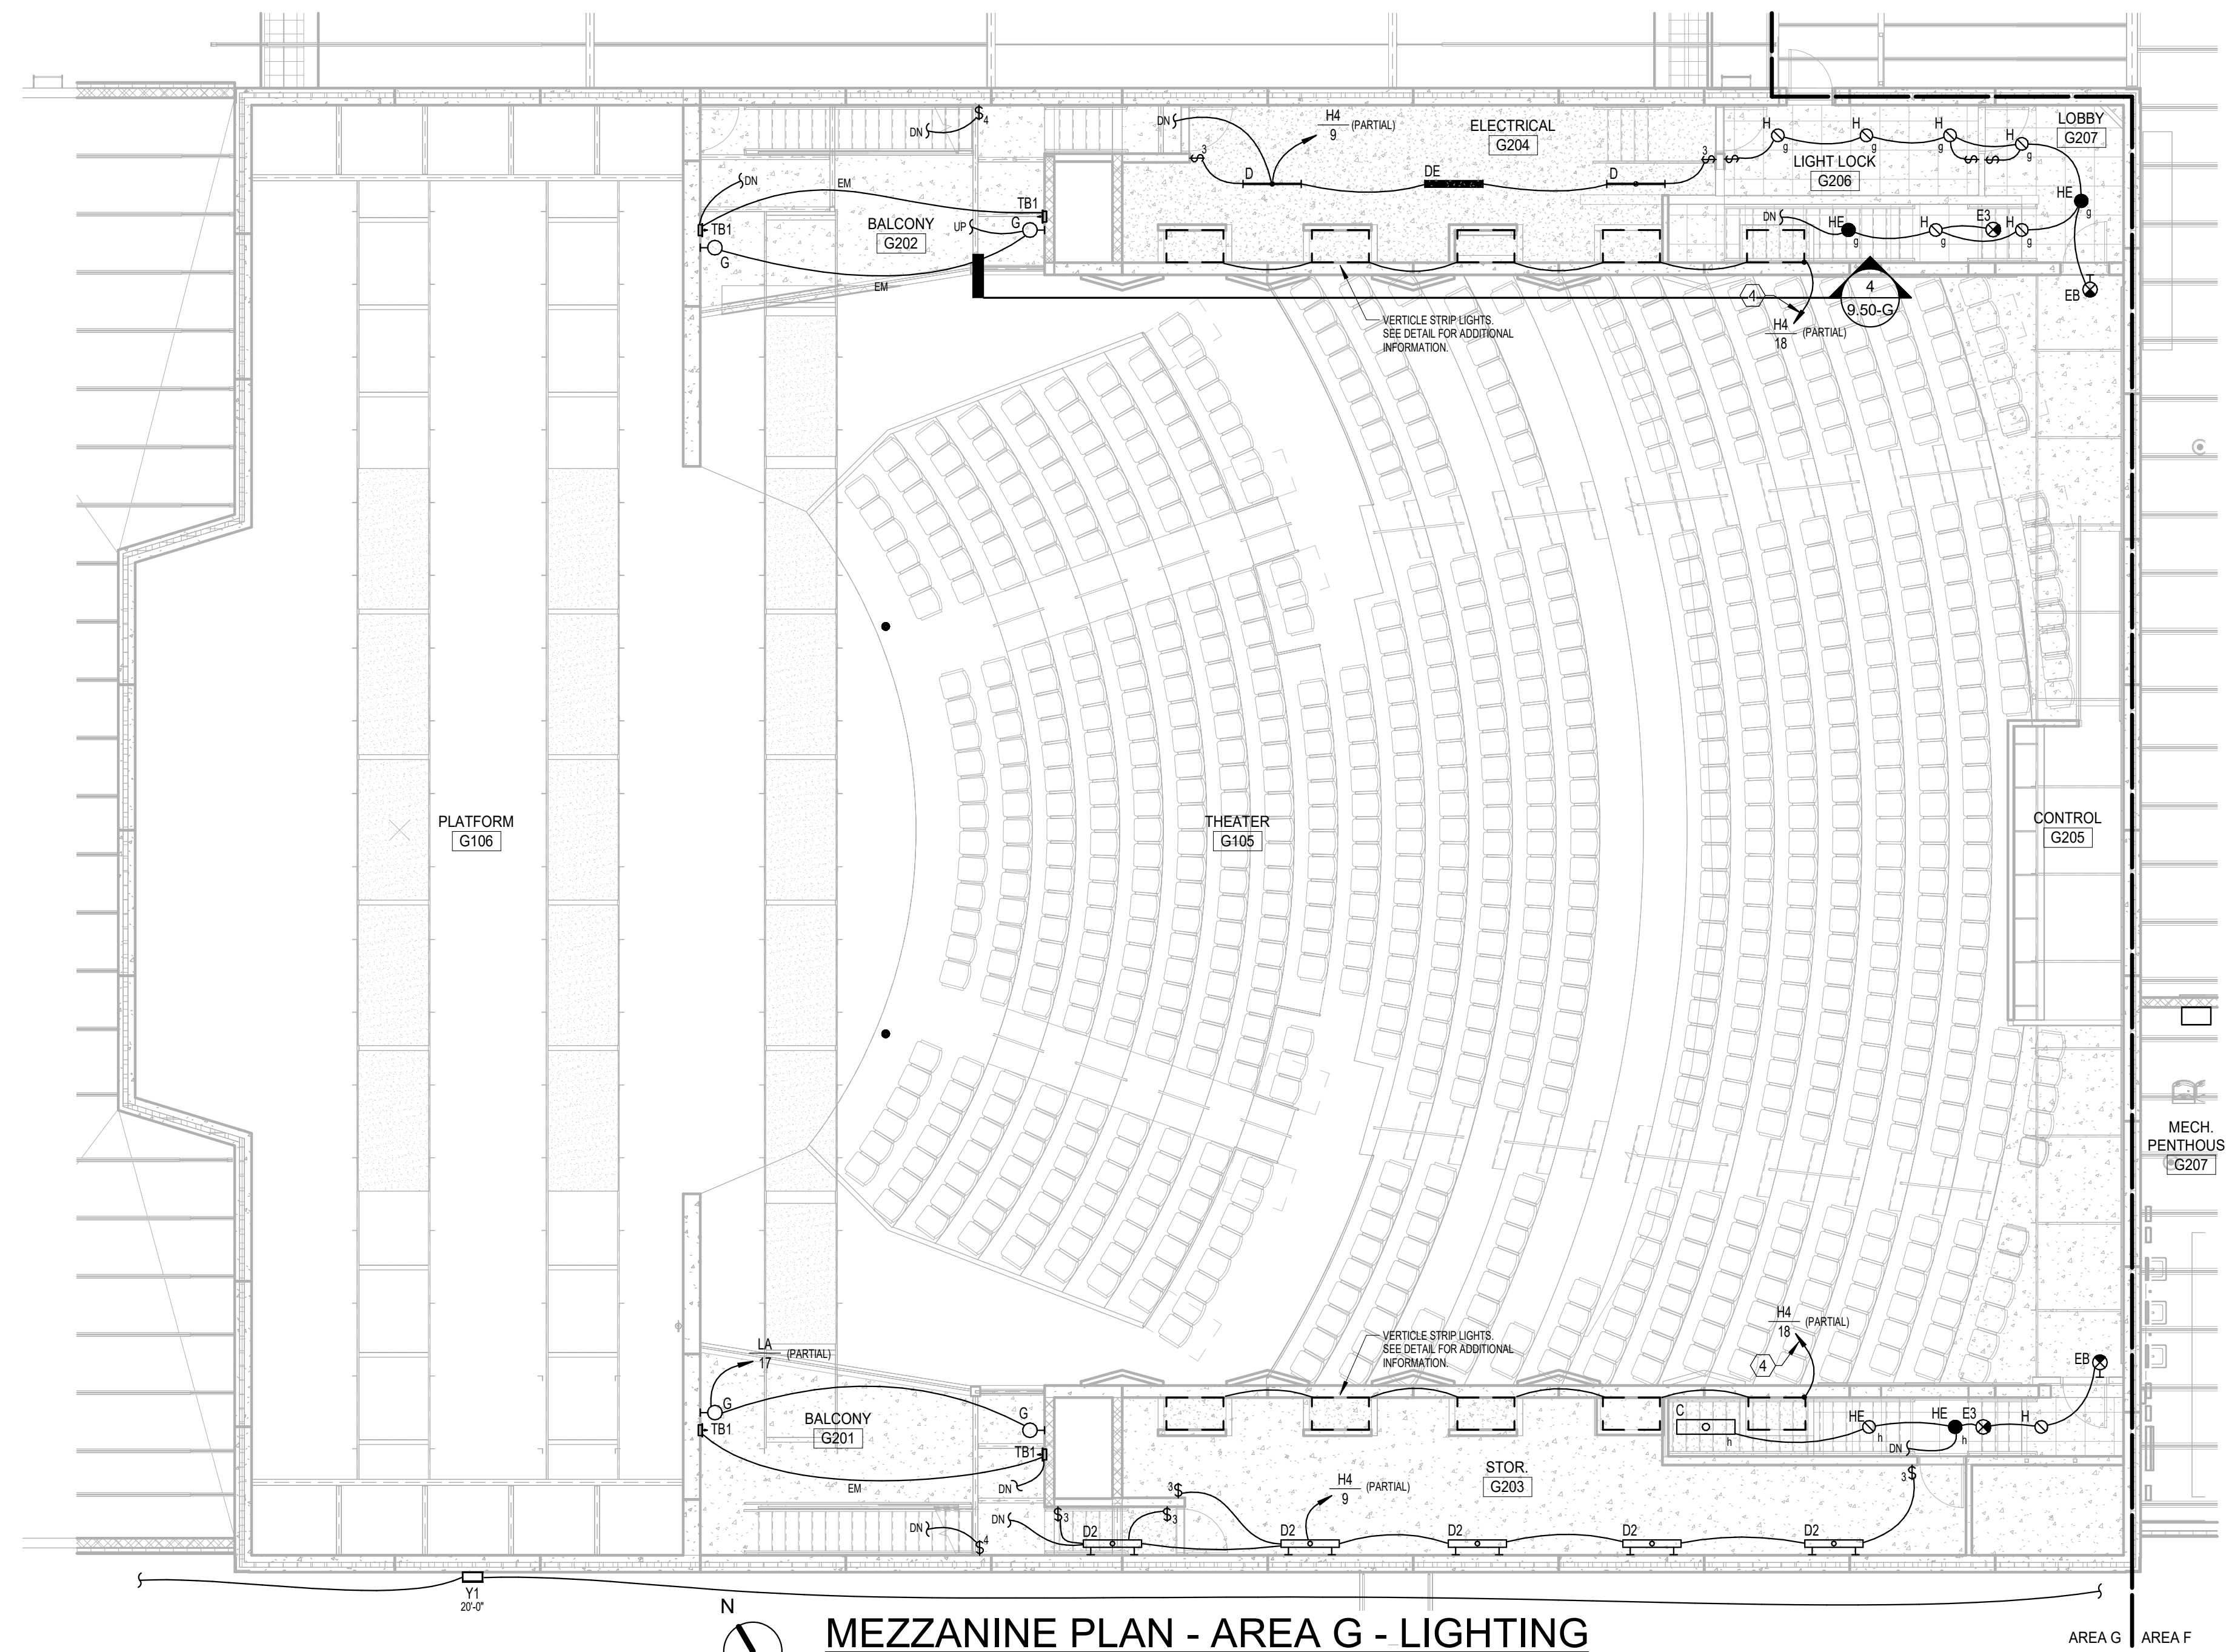

**MEZZANINE PLAN - AREA G - LIGHTING**  
SCALE 0 4 8 12 16

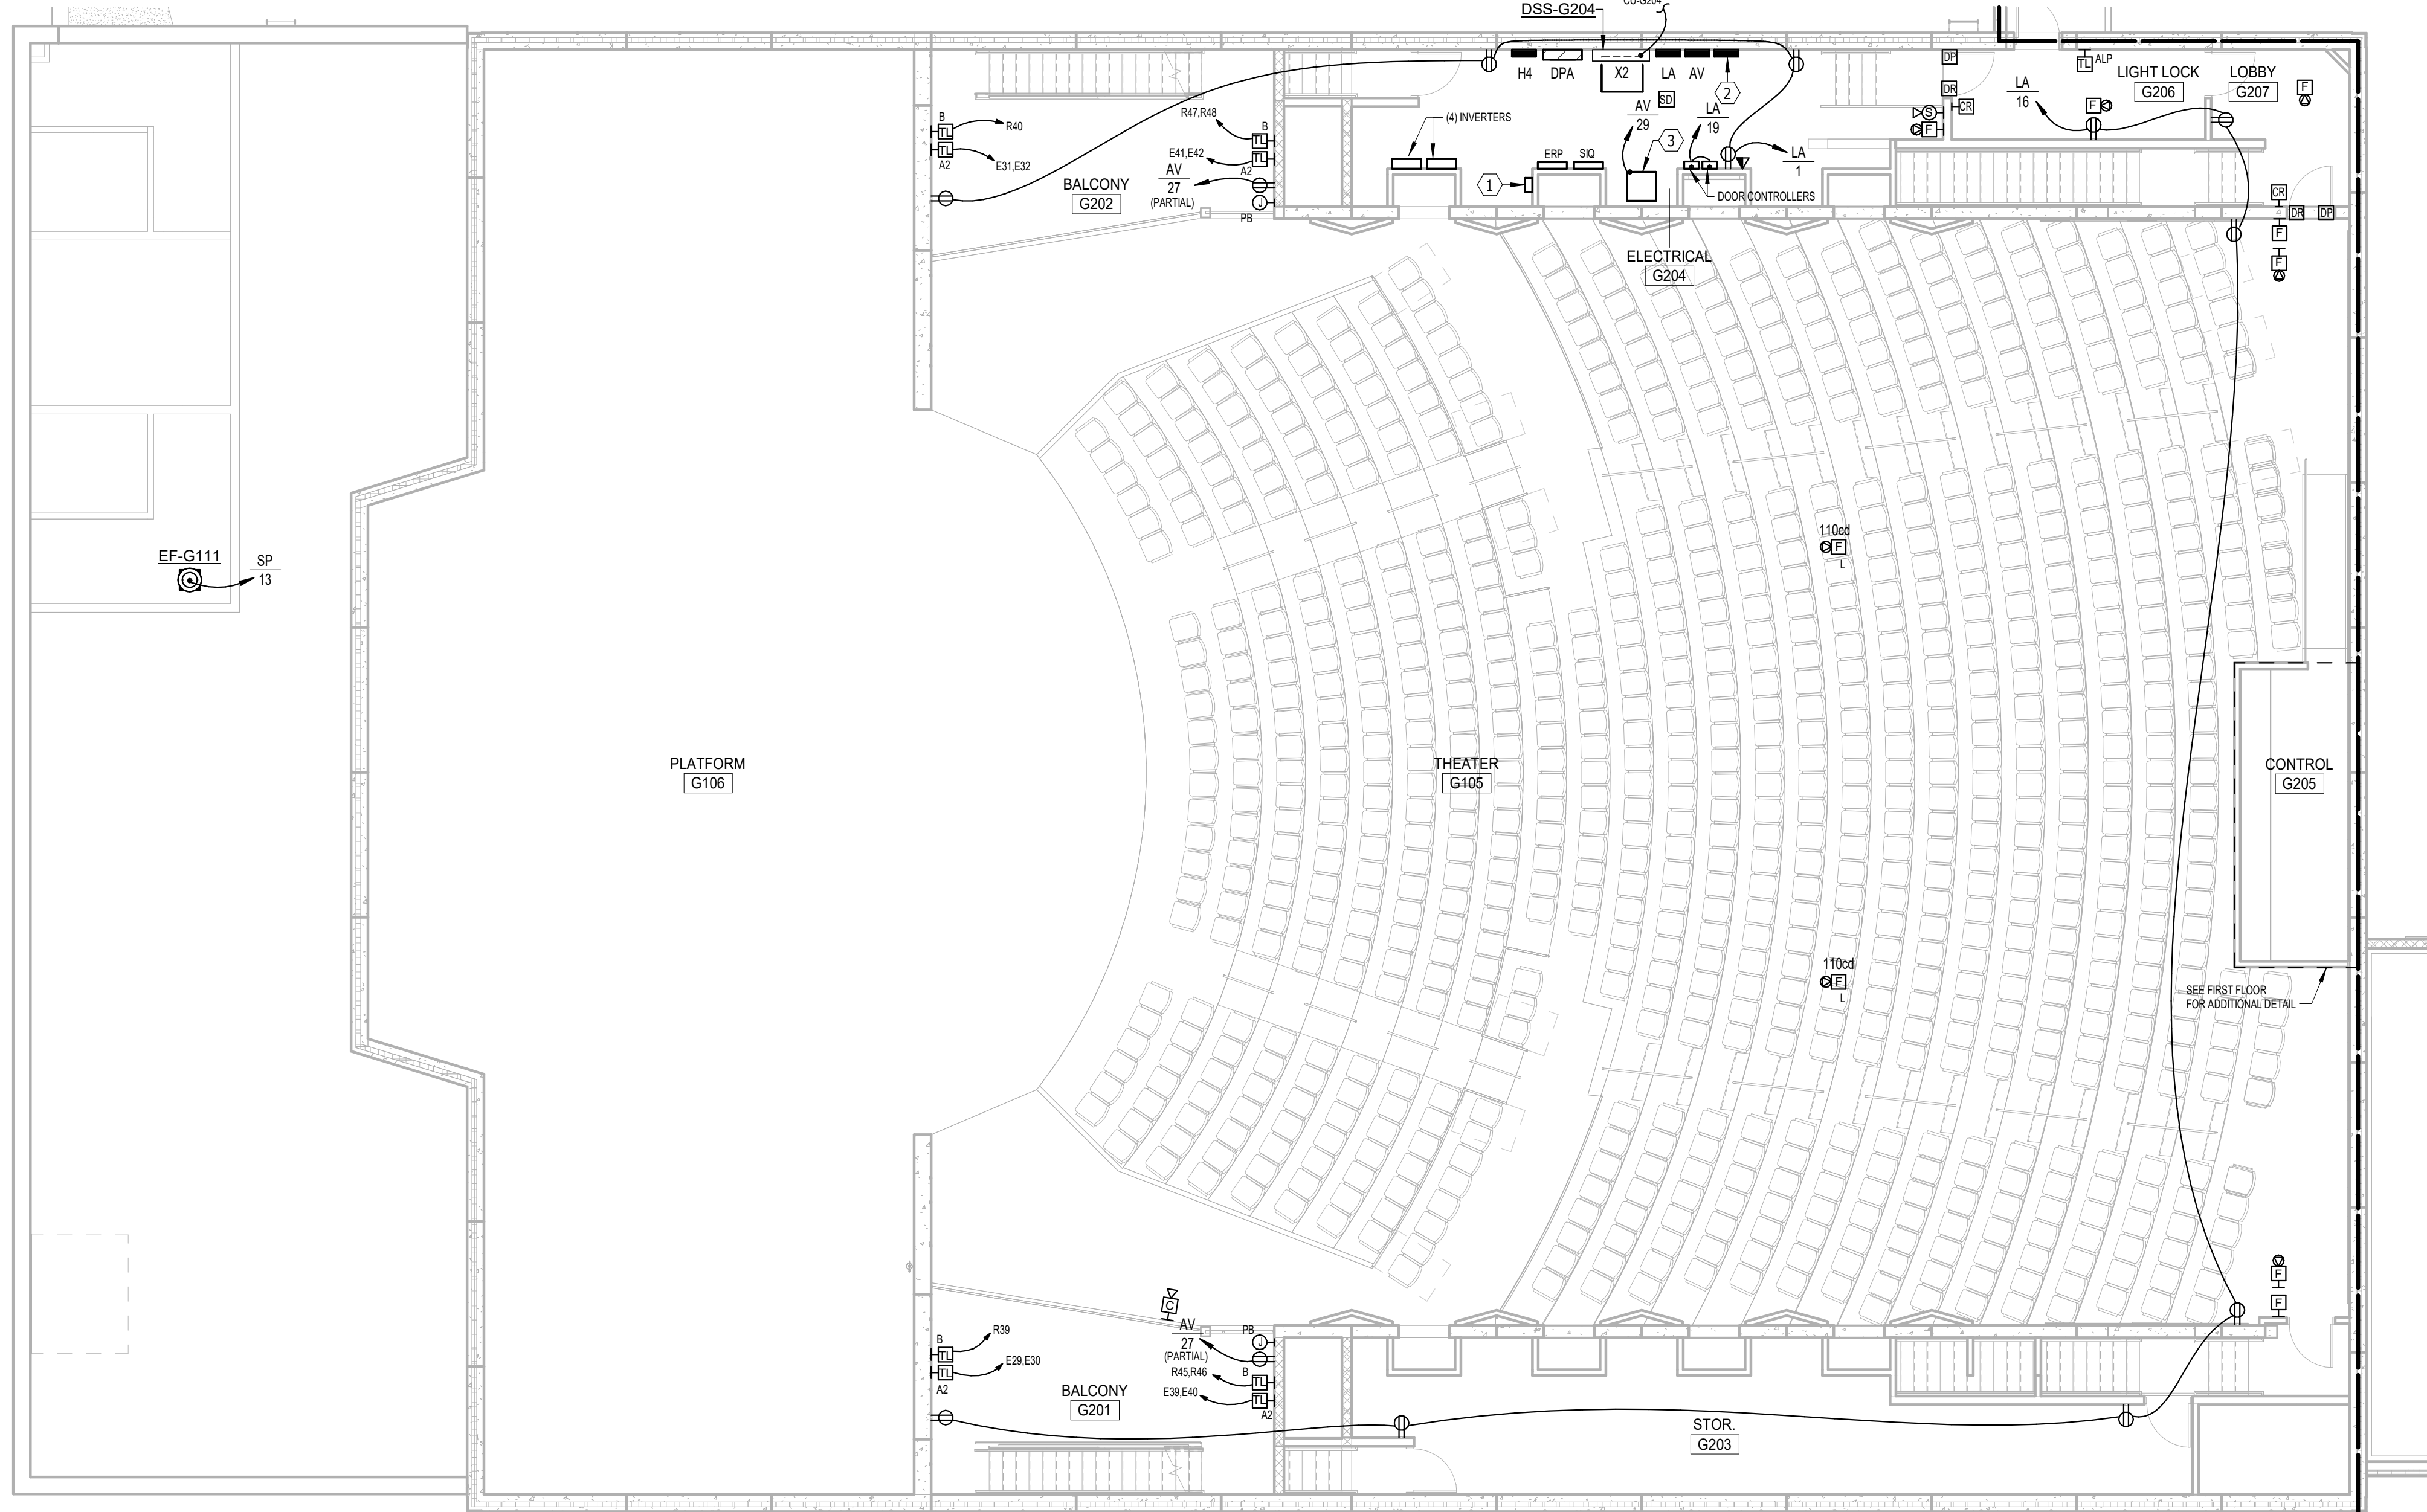


**MEZZANINE PLAN - AREA G - POWER & SIGNAL**  
SCALE 0 4 8 12 16

**ELECTRICAL NOTES**

- (4) BCELTS AND (1) EBDK. REFER TO THEATRICAL LIGHTING POWER AND CONTROL DIAGRAM.
- ETC ECHO FEED-THRU RELAY PANEL.
- THEATRICAL LIGHTING EQUIPMENT RACK.
- WIRED THRU ECHO RELAY PANEL (DMX CONTROL).

**GENERAL SHEET NOTES**


- ELECTRICAL CONTRACTOR SHALL VERIFY ALL CEILING TYPES AND MOUNTING HARDWARE REQUIRED PRIOR TO PURCHASE OF ANY LIGHTING FIXTURES.
- ALL STEP LIGHTS SHALL BE MOUNTED AT +2'-0" A.F.F. TO CENTER OF FIXTURE UNLESS OTHERWISE NOTED.
- ALL SWITCHES, DIMMERS OR BUTTON STATIONS SHALL BE MOUNTED AT +40" A.F.F. TO BOTTOM OF FIXTURE UNLESS OTHERWISE NOTED. CONFIRM WITH ARCHITECTURAL DRAWINGS.

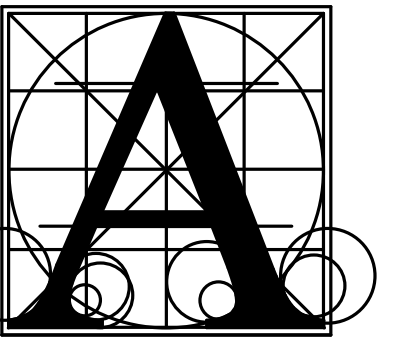

**Architecture  
Incorporated**

415 South Main Avenue  
P.O. Box 2140  
Sioux Falls, South Dakota 57101  
Phone: (605) 339-1711

815 St. Joseph Street, Suite 203  
Rapid City, South Dakota 57701  
Phone: (605) 721-1158

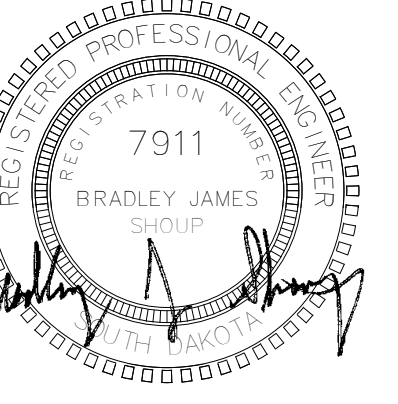

**Associated  
Consulting  
Engineering,  
Incorporated**

340 S. Phillips Ave.  
Sioux Falls, SD 57104

(605) 335-3720  
Fax 335-6220  
E-mail acei@aceinet.com

ACEI PROJ. #123034


**LENNOX HIGH SCHOOL ADDITION**

**MEZZANINE PLAN - AREA G - ELECTRICAL**

Project

number 0215.2902.22  
date DECEMBER 21, 2023  
revision  
drawn KMT checked BJ5

DATE DESCRIPTION  
01-18-2024 Addendum #2

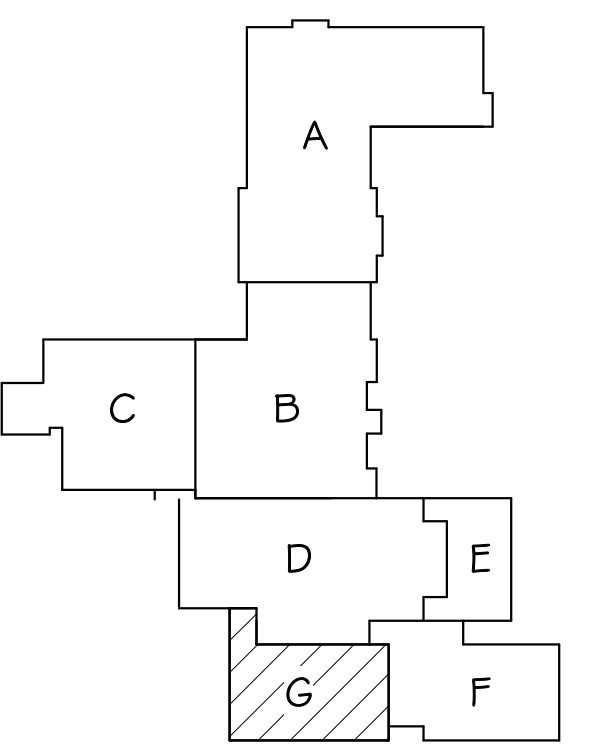


**KEYPLAN**


**9.50-G**



1/18/2024 3:21:03 PM

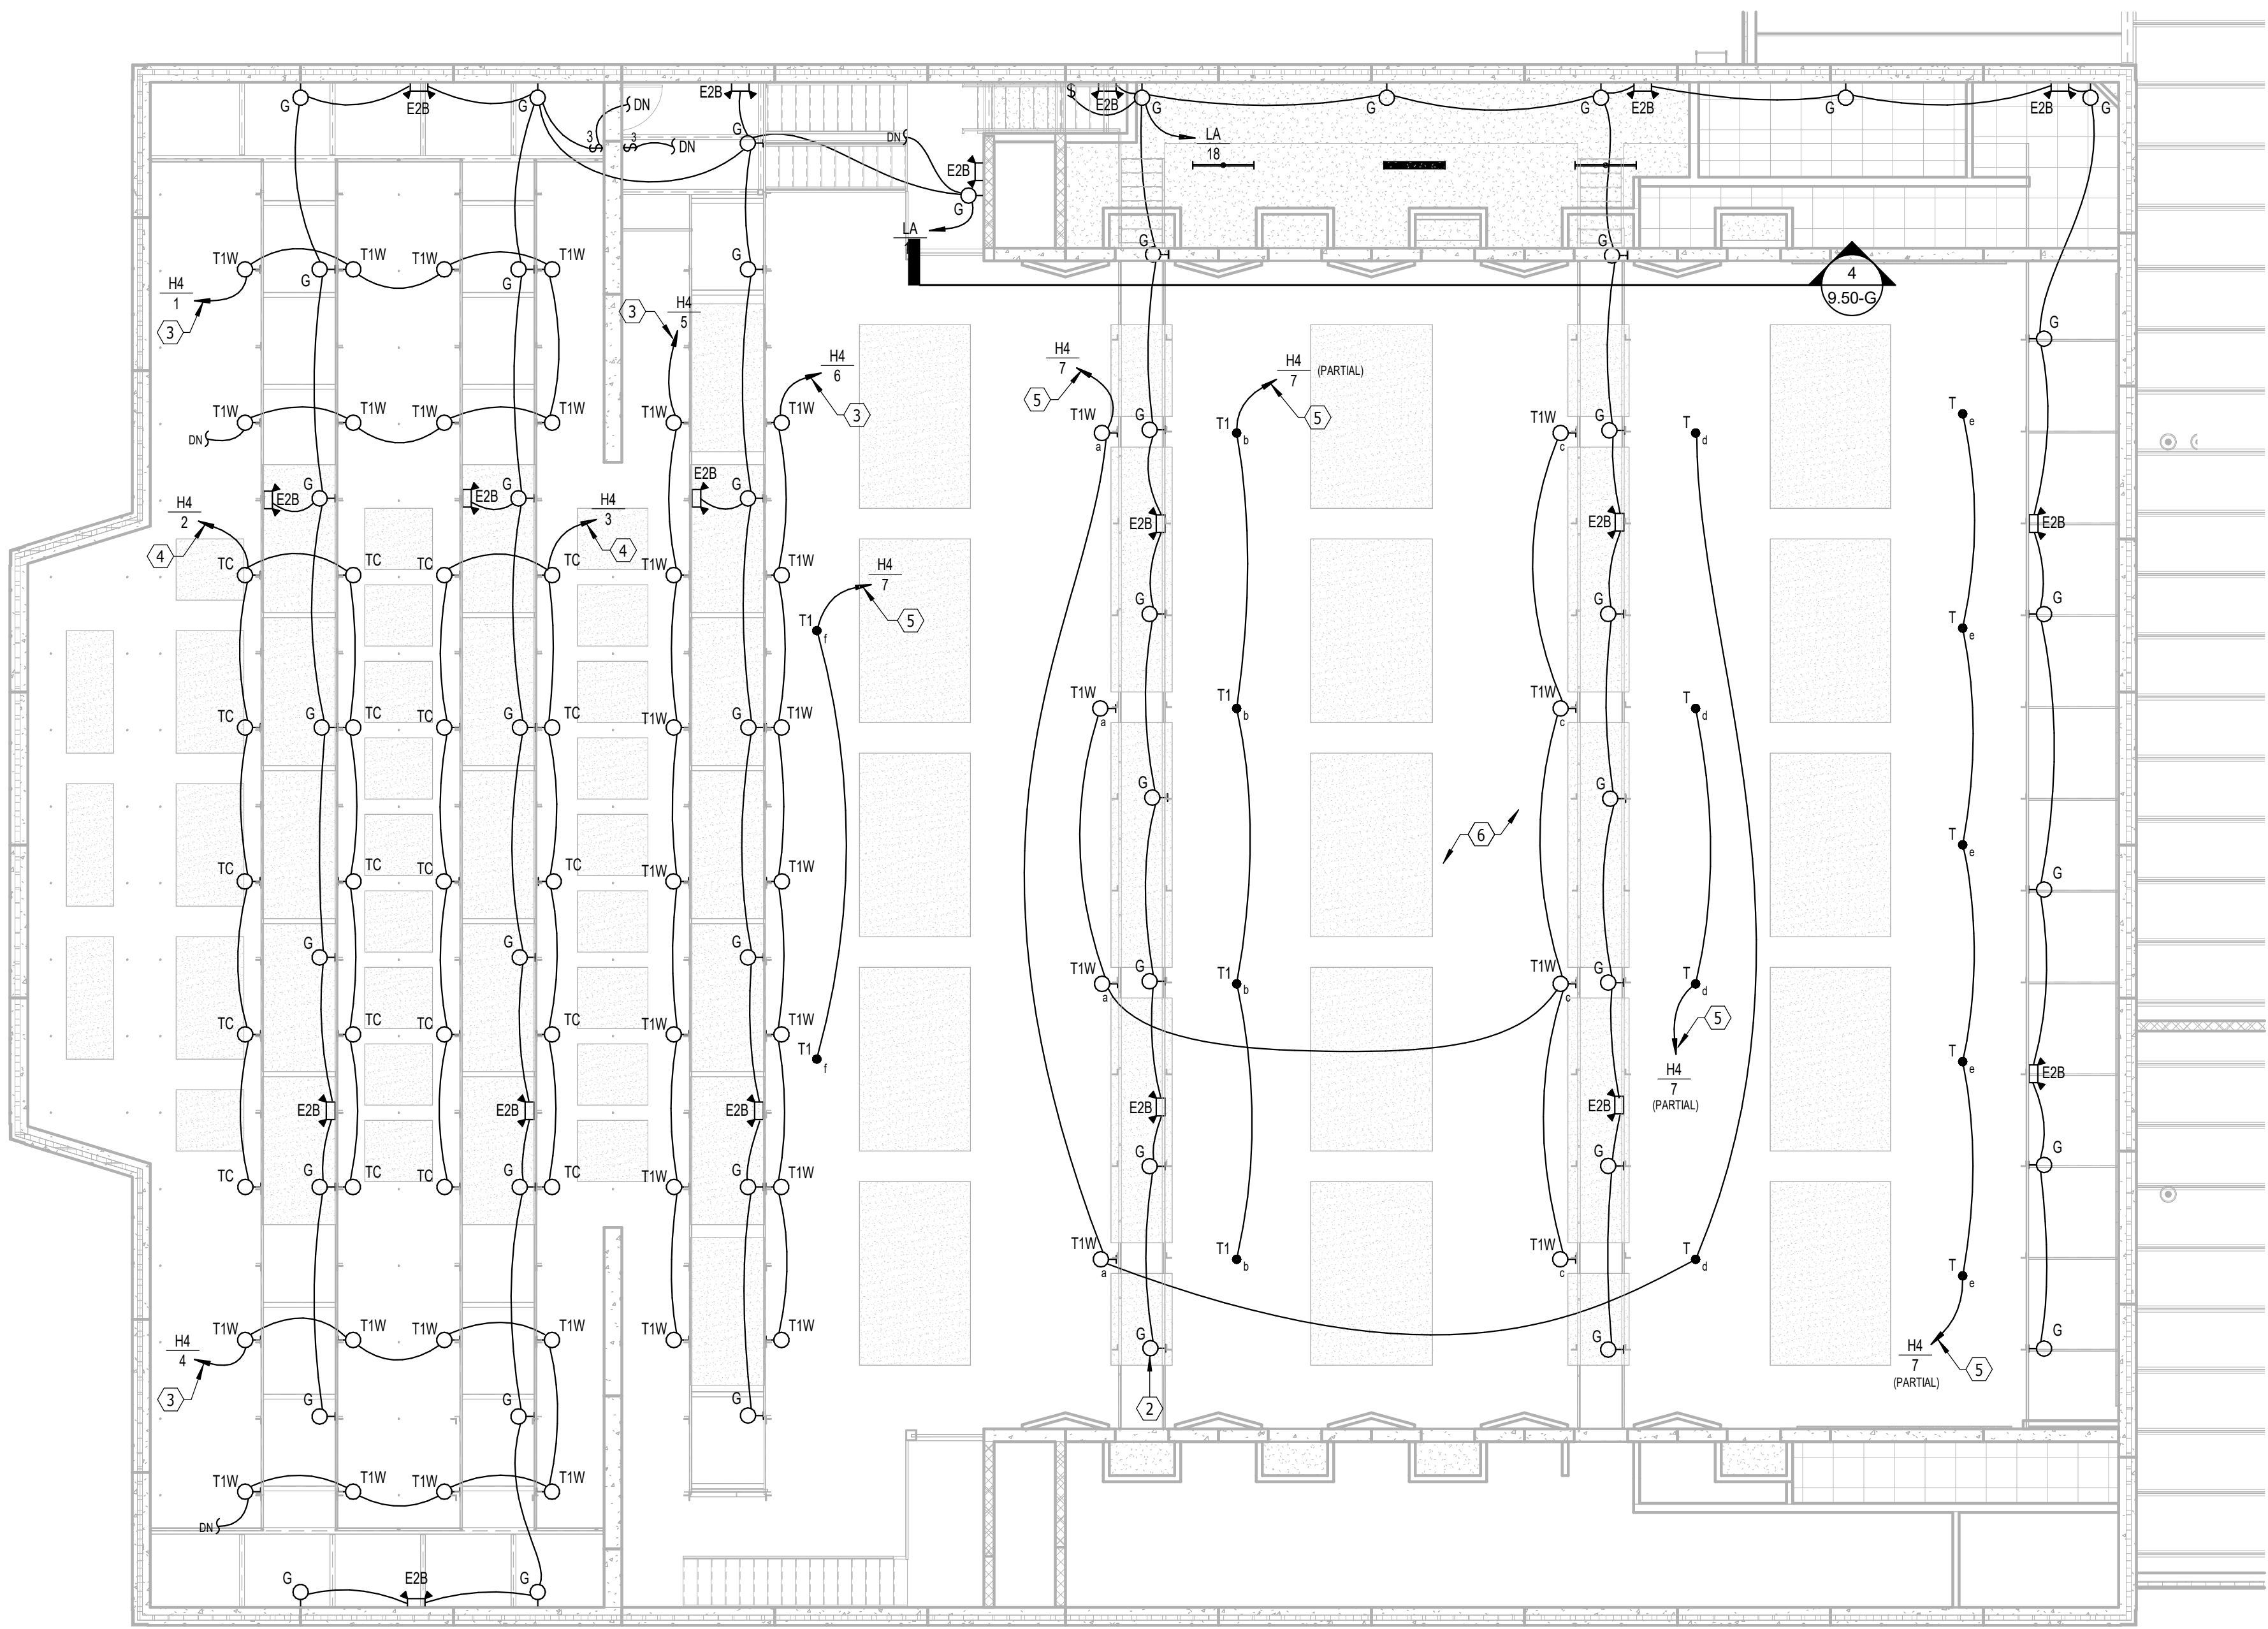

**CATWALK PLAN - AREA G - LIGHTING**  
SCALE 0 4 8 12 16

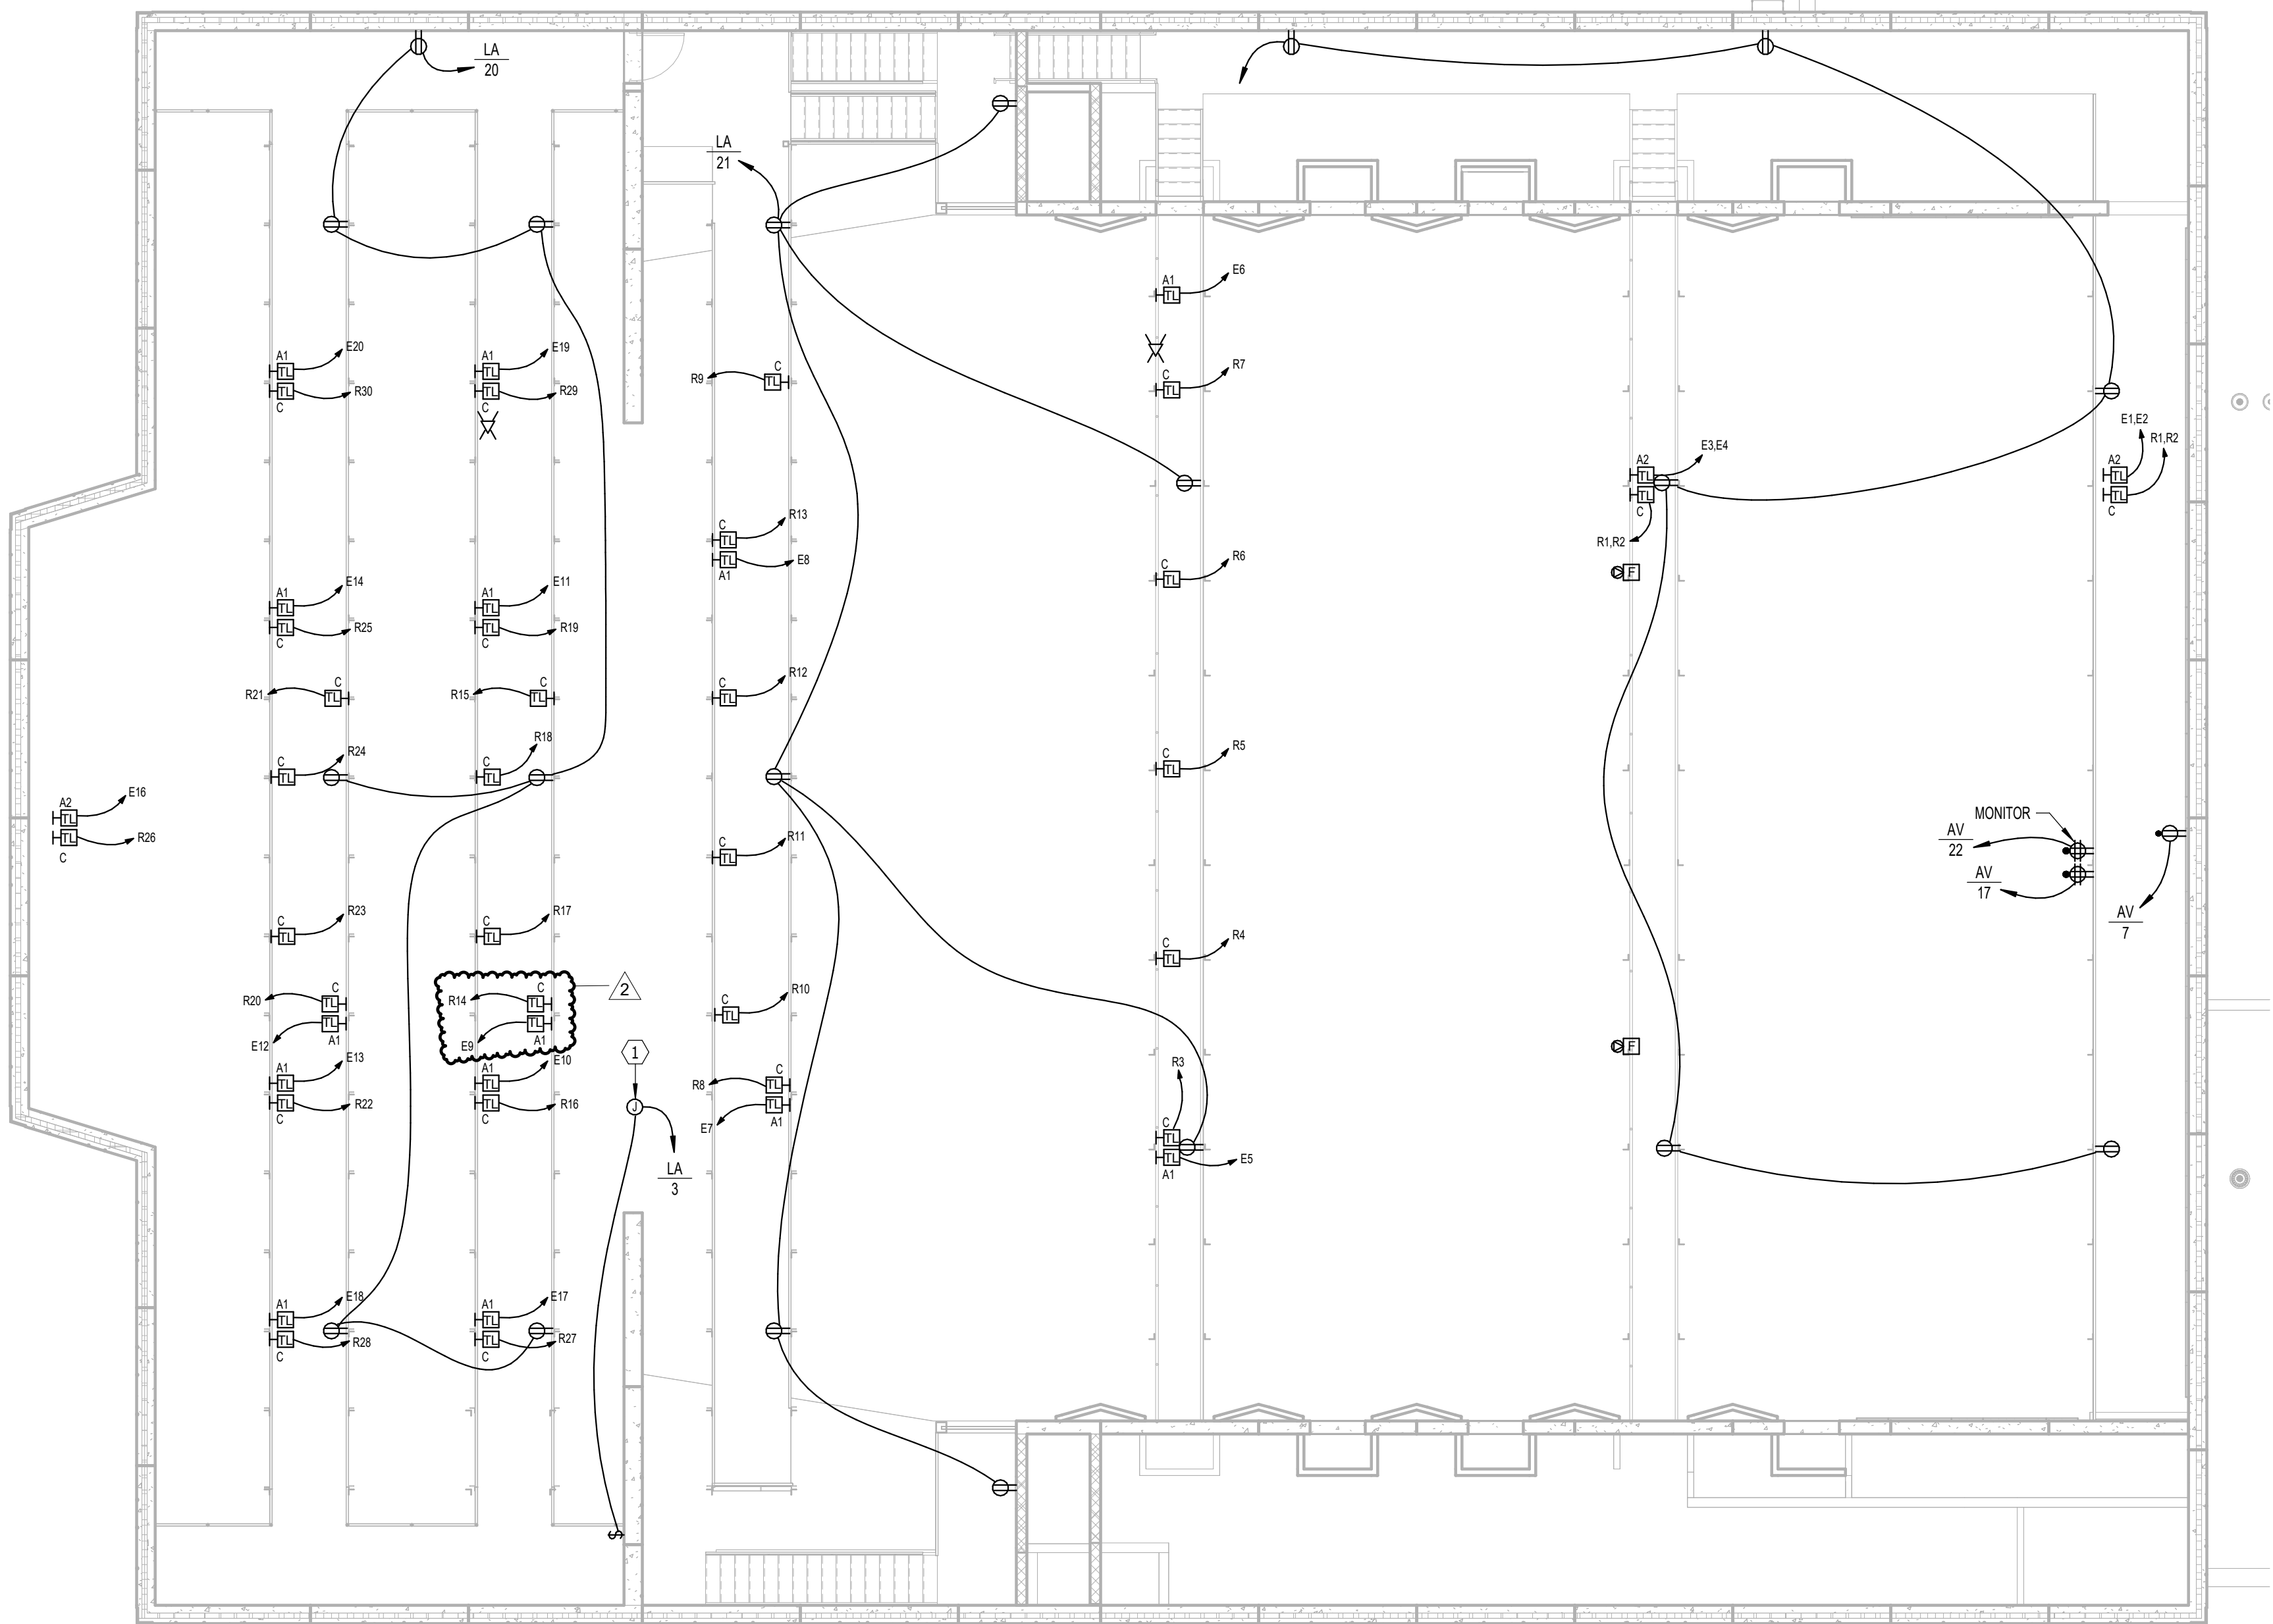


**CATWALK PLAN - AREA G - POWER & SIGNAL**  
SCALE 0 4 8 12 16

**ELECTRICAL NOTES**

- PROJECTOR SCREEN MOUNTED TO PIPE GRID. COORDINATE EXACT LOCATION WITH AV CONTRACTOR.
- TYPE G AND E2B FIXTURES NEED TO MOUNT ON VERTICAL SUPPORTS (ABOUT 7' ABOVE THE CATWALK FLOOR). TYPICAL.
- WIRED THRU ECHO RELAY PANEL (0-10V CONTROL).
- WIRED THRU ECHO RELAY PANEL (DMX CONTROL).
- WIRED THRU ECHO RELAY PANEL (DMX CONTROL).
- UNLESS OTHERWISE NOTED, CIRCUIT ALL TYPE T, T1, T1W AND T2 LUMINAIRES TO PANEL "H4" VIA ECHO RELAY PANEL. EACH GROUP LISTED WITH A SUB LETTER SHALL BE AN INDIVIDUAL FEED FROM THE ECHO RELAY PANEL.

**GENERAL SHEET NOTES**


- ELECTRICAL CONTRACTOR SHALL VERIFY ALL CEILING TYPES, AND MOUNTING HARDWARE REQUIRED PRIOR TO PURCHASE OF ANY LIGHTING FIXTURES.
- ALL STEP LIGHTS SHALL BE MOUNTED AT +2'-0" A.F.F. TO CENTER OF FIXTURE UNLESS OTHERWISE NOTED.
- ALL SWITCHES, DIMMERS OR BUTTON STATIONS SHALL BE MOUNTED AT +4'-0" A.F.F. TO BOTTOM OF FIXTURE UNLESS OTHERWISE NOTED. CONFIRM WITH ARCHITECTURAL DRAWINGS.

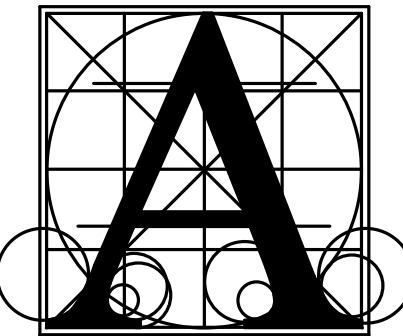

**Architecture  
Incorporated**

415 South Main Avenue  
P.O. Box 2140  
Sioux Falls, South Dakota 57101  
Phone: (605) 339-1711

815 St. Joseph Street, Suite 203  
Rapid City, South Dakota 57701  
Phone: (605) 721-1158

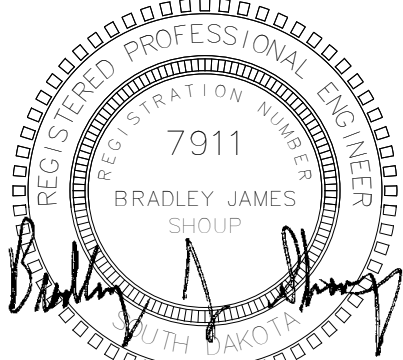

**Associated  
Consulting  
Engineering,  
Incorporated**

340 S. Phillips Ave.  
Sioux Falls, SD 57104

(605) 335-3720  
Fax 335-6220  
E-mail acei@aceinet.net

ACEI PROJ. #123034


**LENNOX HIGH SCHOOL ADDITION**  
CATWALK PLAN - AREA G - ELECTRICAL

Project

number 0215.2902.22  
date DECEMBER 21, 2023  
revision  
drawn KMT checked BJS

DATE	DESCRIPTION
01-11-2024	Addendum #1
01-18-2024	Addendum #2

**9.51-G**

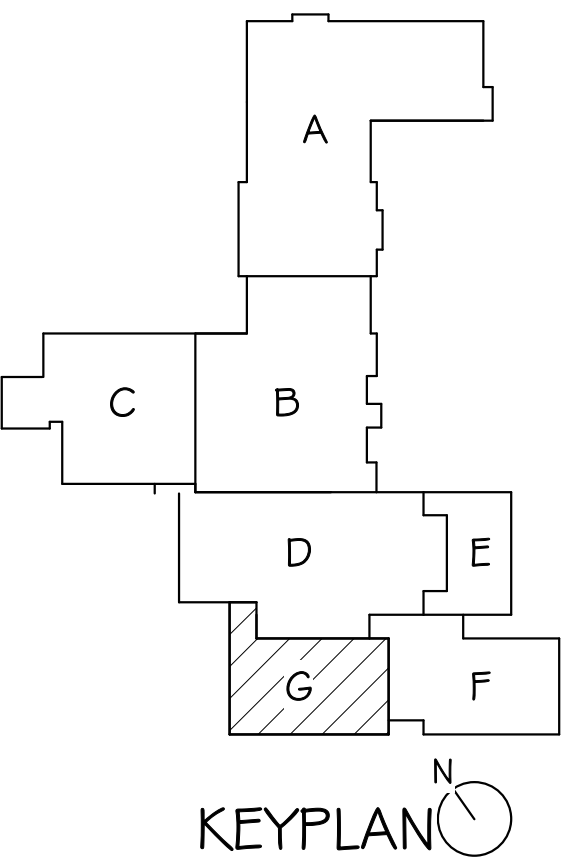





DISTRIBUTION PANEL: DPA									
LOCATION: ELECTRICAL-4 G204-4					VOLTAGE: 480Y/277V, 3Ø4W.				
MAIN DEVICE: 800 AMCB					AIC RATING: 22,000 AMPS SYM				
BUS AMPS: 800 AMPS					SPECIAL:				
MAIN DEVICE									
CB SIZE/POLES		SPECIAL		DESCRIPTION/NAMEPLATE					
SECTION NO. 1									
CKT	CB SIZE	POLES	Load	DESCRIPTION/NAMEPLATE					NOTES
1	250 A	3	43990 VA	TRANSFORMER "X2" (PANEL LA, AV & SP)					
2	125 A	3	51875 VA	TRANSFORMER "X1" (PANEL LB, L9, L10, LCS)					
3	100 A	3	18320 VA	PANEL "H4"					
4	100 A	3	16441 VA	PANEL "H5"					
5	100 A	3	46722 VA	PANEL "HP5"					
6	100 A	3	32333 VA	PANEL "HP6"					
7	15 A	3	2827 VA	MOTORS BCU-G111					
8	15 A	3	2827 VA	MOTORS BCU-G117					
9	20 A	3	9145 VA	MOTORS AHU-13					
10	-	3	-	Space					
11	50 A	3	0 VA	SURGE SUPPRESSION					
12	-	-	-						
LOAD SUMMARY									
				DISTRIBUTION LOAD			CONN. LOAD		
				MDP-A			221906 VA		
LOAD CLASSIFICATION		CONNECTED	DEMAND	ESTIMATED	PANEL TOTALS				
Lighting		0 VA	0.00%	0 VA					
MOTORS		103675 VA	100.00%	103675 VA					
RCPT		73116 VA	56.84%	41558 VA					
LITES		37838 VA	125.00%	47297 VA					
HEAT		8604 VA	100.00%	8604 VA					
				CONN. LOAD: 221906 VA					
				EST. DEMAND LOAD: 200045 VA					
				CONN. CURRENT: 287 A					
				EST. DEMAND... 241 A					
NOTES:									

PANELBOARD: HP6										
LOCATION: MECH/STOR. E105					VOLTAGE: 480Y/277 V, 3 ø 4 W.					
MOUNTING: SURFACE NEMA 1					A.I.C. RATING: 14,000 AMPS SYMMETRICAL					
MAIN DEVICE: 100 A MLO					SPECIAL:					
BUS AMPS: 100 AMPS										
LOAD DESCRIPTION	BKR	POLES	CKT	A	B	C	CKT	POLES	BKR	LOAD DESCRIPTION
ERV-1 - SUPPLY FANS	40 A	3	1	6.1	4.0		2	3	30 A	ERV-1 - EXHAUST FANS
--	--	--	3		6.1	4.0		4	--	--
--	--	--	5			6.1	4.0	6	--	--
MOTORS P-2 & P-3	15 A	3	7	0.8	0.0		8	3	15 A	Spare
--	--	--	9		0.8	0.0		10	--	--
--	--	--	11				0.8	0.0	12	--
Space	--	3	13	--	--			14	--	Space
--	--	--	15		--	--		16	--	--
--	--	--	17			--	--	18	--	--
Space	--	3	19	--	--			20	3	Space
--	--	--	21		--	--		22	--	--
--	--	--	23			--	--	24	--	--
--	--	--	25					26	--	--
--	--	--	27					28	--	--
--	--	--	29					30	--	--
TOTAL LOAD:				11 kVA	11 kVA	11 kVA				
TOTAL AMPS:				39 A	39 A	39 A				
LOAD CLASSIFICATION				PANEL TOTALS						
CONNECTED				DEMAND		ESTIMATED				
MOTORS				32333 VA		100.00%		32333 VA		
								CONNECTED LOAD: 32333 VA		
								ESTIMATED DEMAND: 32333 VA		
								CONNECTED CURRENT: 39 A		
								EST. DEMAND CURRENT: 39 A		
NOTES:										

PANELBOARD: HP5													
LOCATION: MECH PENTHOUSE G207					VOLTAGE: 480Y/277 V, 3 ø 4 W.								
MOUNTING: SURFACE NEMA1					A.I.C. RATING: 14,000 AMPS SYMMETRICAL								
MAIN DEVICE: 100 A MLO					SPECIAL:								
BUS AMPS: 100 AMPS													
LOAD DESCRIPTION	BKR	POLES	CKT	A		B		C		CKT	POLES	BKR	LOAD DESCRIPTION
MOTORS AHU-10	60 A	3	1	7.5	2.1					2	3	15 A	MOTORS AHU-11
--	--	--	3			7.5	2.1				4	--	--
--	--	--	5					7.5	2.1		6	--	--
MOTORS AHU-12	25 A	3	7	3.9	2.1					8	3	15 A	MOTORS EF-G207
--	--	--	9			3.9	2.1			10	--	--	--
--	--	--	11					3.9	2.1		12	--	--
Spare	20 A	3	13	0.0	0.0					14	3	15 A	Spare
--	--	--	15			0.0	0.0				16	--	--
--	--	--	17					0.0	0.0	18	--	--	--
Space	--	3	19	--	--					20	3	--	Space
--	--	--	21			--	--			22	--	--	--
--	--	--	23					--	--	24	--	--	--
--	--	--	25							26	--	--	--
--	--	--	27							28	--	--	--
--	--	--	29							30	--	--	--
TOTAL LOAD:				16 kVA		16 kVA		16 kVA					
TOTAL AMPS:				56 A		56 A		56 A					
LOAD CLASSIFICATION													
CONNECTED				DEMAND		ESTIMATED		PANEL TOTALS					
MOTORS				46722 VA		100.00%		46722 VA					
										CONNECTED LOAD: 46722 VA			
										ESTIMATED DEMAND: 46722 VA			
										CONNECTED CURRENT: 56 A			
										EST. DEMAND CURRENT: 56 A			
NOTES:													

PANELBOARD: LE1										
LOCATION: FREEZER C124					VOLTAGE: 208Y/120 V, 3 ø 4 W.					
MOUNTING: SURFACE NEMA1					A.I.C. RATING: 10,000 AMPS SYMMETRICAL					
MAIN DEVICE: 100 A MLO					SPECIAL:					
BUS AMPS: 100 AMPS										
LOAD DESCRIPTION	BKR	POLES	CKT	A	B	C	CKT	POLES	BKR	LOAD DESCRIPTION
WALK-IN FREEZER	20 A	1	1	0.4	1.0		2	2	20 A	WALK-IN FREEZER EVAP.
HEAT TAPE	20 A	1	3		0.8	1.0		4	--	--
WALK-IN FREEZER EVAP.	20 A	2	5			0.0	0.5	6	1	RCPT EXTERIOR
--	--	--	7	1.0	1.9			8	3	WALK-IN FREEZER COND.
			9			1.9		10	--	--
			11				1.9	12	--	--
			13					14		
			15					16		
			17					18		
			19					20		
			21					22		
			23					24		
			25					26		
			27					28		
			29					30		
			31					32		
			33					34		
			35					36		
			37					38		
			39					40		
			41					42		
TOTAL LOAD:				4 kVA	5 kVA	2 kVA				
TOTAL AMPS:				39 A	42 A	20 A				
PANEL TOTALS										
LOAD CLASSIFICATION				CONNECTED	DEMAND	ESTIMATED				
RCPT				1671 VA	100.00%	1671 VA	CONNECTED LOAD: 11418 VA			
MOTORS				9960 VA	100.00%	9960 VA	ESTIMATED DEMAND: 11418 VA			
							CONNECTED CURRENT: 32 A			
							EST. DEMAND CURRENT: 32 A			
NOTES:										

PANELBOARD: L10												
LOCATION: MECH/STOR. E105					VOLTAGE: 208Y/120 V, 3 ø 4 W.							
MOUNTING: SURFACE NEMA1					A.I.C. RATING: 10,000 AMPS SYMMETRICAL							
MAIN DEVICE: 250 A MLO					SPECIAL:							
BUS AMPS: 250 AMPS												
LOAD DESCRIPTION	BKR	POLES	CKT	A	B	C	CKT	POLES	BKR	LOAD DESCRIPTION		
RCPT LOCKER E115	20 A	1	1	1.5	0.9		2	1	20 A	RCPT OFFICE E113		
RCPT OFFICE E111	20 A	1	3		0.9	1.7	4	1	20 A	RCPT LOCKER E108		
RCPT MECH/STOR. E105	20 A	1	5			0.9	0.7	6	1	20 A	RCPT FITNESS RM E103	
RCPT FITNESS RM E103	20 A	1	7	0.2	0.2			8	1	20 A	RCPT FITNESS RM E103	
RCPT FITNESS RM E103	20 A	1	9		0.2	0.2		10	1	20 A	RCPT FITNESS RM E103	
RCPT FITNESS RM E103	20 A	1	11			0.2	0.2	12	1	20 A	RCPT FITNESS RM E103	
RCPT FITNESS RM E103	20 A	1	13	0.5	0.4			14	1	20 A	RCPT FITNESS RM E103	
RCPT FITNESS RM E103	20 A	1	15		0.7	0.6		16	1	15 A	MOTORS ERV-1 HT WHEEL	
HEAT CUH-E107, E108 &	15 A	1	17				1.1	0.7	18	1	20 A	RCPT OFFICE E104
			19					20				
			21					22				
			23					24				
			25					26				
			27					28				
			29					30				
			31					32				
			33					34				
			35					36				
			37					38				
			39					40				
			41					42				
			TOTAL LOAD:	4 kVA	4 kVA	4 kVA						
				31 A	35 A	31 A						
LOAD CLASSIFICATION	CONNECTED	DEMAND	ESTIMATED	PANEL TOTALS								
RCPT	9960 VA	100.00%	9960 VA									
MOTORS	552 VA	100.00%	552 VA									
HEAT	1080 VA	100.00%	1080 VA									



PANELBOARD: LCS													
LOCATION: CONCESSIONS E101							VOLTAGE: 208Y/120 V, 3 ø 4 W.						
MOUNTING: RECESSED NEMA1							A.I.C. RATING: 10,000 AMPS SYMMETRICAL						
MAIN DEVICE: 250 A MLO							SPECIAL:						
BUS AMPS: 250 AMPS													
LOAD DESCRIPTION	BKR	POLES	CKT	A		B		C		CKT	POLES	BKR	LOAD DESCRIPTION
RCPT CONCESSIONS E101	20 A	1	1	0.2	1.5					2	1	20 A	HOT DOG ROLLER
PRETZEL WARMER	20 A	1	3			1.5	1.5			4	1	20 A	PIZZA WARMER
ALL PURPOSE WARMER	20 A	1	5					1.5	0.2	6	1	20 A	RCPT CONCESSIONS E101
RCPT CONCESSIONS E101	20 A	1	7	1.2	1.2					8	1	20 A	RCPT CONCESSIONS E101
RCPT CONCESSIONS E101	20 A	1	9			0.2	0.2			10	1	20 A	RCPT CONCESSIONS E101
RCPT CONCESSIONS E101	20 A	1	11					0.2	0.8	12	1	20 A	REFRIGERATOR
RCPT CONCESSIONS E101	20 A	1	13	0.2	0.8					14	1	20 A	MOTORS CONCESSIONS...
POPCORN MACHINE	20 A	1	15			1.5	0.2			16	1	20 A	RCPT CONCESSIONS E101
MOTORS CONCESSIONS...	20 A	1	17					0.8	0.2	18	1	20 A	RCPT CONCESSIONS E101
REFRIGERATOR	20 A	1	19	0.8	1.0					20	1	20 A	FREEZER
COOLER	20 A	1	21			0.8	0.8			22	1	20 A	COOLER
COOLER	20 A	1	23					0.8	0.2	24	1	20 A	RCPT STOR. E102
RCPT STOR. E102	20 A	1	25	0.2	0.2					26	1	20 A	RCPT CONCESSIONS E101
RCPT CONCESSIONS E101	20 A	1	27			0.2	0.8			28	1	20 A	MOTORS PL
			29							30			
			31							32			
			33							34			
			35							36			
			37							38			
			39							40			
			41							42			
TOTAL LOAD:				7 kVA		7 kVA		5 kVA					
TOTAL AMPS:				62 A		64 A		38 A					
PANEL TOTALS													
LOAD CLASSIFICATION				CONNECTED		DEMAND		ESTIMATED					
RCPT				17220 VA		79.04%		13610 VA					
MOTORS				2208 VA		100.00%		2208 VA					
										CONNECTED LOAD: 19033 VA			
										ESTIMATED DEMAND: 15433 VA			
										CONNECTED CURRENT: 53 A			
										EST. DEMAND CURRENT: 43 A			
NOTES:													

PANELBOARD: AV													
LOCATION: ELECTRICAL G204				VOLTAGE: 208Y/120 V, 3 ø 4 W.									
MOUNTING: SURFACE NEMA1				A.I.C. RATING: 10,000 AMPS SYMMETRICAL									
MAIN DEVICE: 200 A MAIN CB				SPECIAL: ISOLATED GROUND BUS									
BUS AMPS: 200 AMPS													
LOAD DESCRIPTION	BKR	POLES	CKT	A		B		C		CKT	POLES	BKR	LOAD DESCRIPTION
RCPT THEATER G105	20 A	1	1	0.7	0.9					2	1	20 A	RCPT CONTROL G205
RCPT CONTROL G205	20 A	1	3			0.2	0.4			4	1	20 A	RCPT THEATER G105
RCPT CONTROL G205	20 A	1	5					0.2	0.2	6	1	20 A	RCPT CONTROL G205
RCPT CATWALK	20 A	1	7	0.2	0.2					8	1	20 A	RCPT CONTROL G205
RCPT STAGE G106	20 A	1	9			1.6				10			
RCPT STAGE G106	20 A	1	11					0.2	1.6	12	1	20 A	RCPT STAGE G106
RCPT STAGE G106	20 A	1	13	0.2	0.2					14	1	20 A	RCPT STAGE G106
RCPT STAGE G106	20 A	1	15			0.8	0.2			16	1	20 A	RCPT STAGE G106
RCPT CATWALK	20 A	1	17					0.4	0.8	18	1	20 A	RCPT STAGE G106
Spare	20 A	1	19	0.0	0.8					20	1	20 A	RCPT STAGE G106
Spare	20 A	1	21			0.0	0.4			22	1	20 A	RCPT CATWALK
Spare	20 A	1	23					0.0	0.0	24	1	20 A	Spare
Spare	20 A	1	25	0.0	0.0					26	1	20 A	Spare
RCPT BALCONY G202	20 A	1	27			0.4	0.2			28	1	20 A	RCPT MAKE-UP G112
LIGHTING AUX. RACK	20 A	1	29					1.5	0.0	30	1	20 A	ERP CONTROL
Spare	20 A	1	31	0.0						32			
			33							34			
			35							36			
COMPANY SWITCH	100 A	3	37	0.0	0.0					38	3	30 A	SURGE SUPPRESSION
--	--	--	39			0.0	0.0			40	--	--	--
--	--	--	41					0.0	0.0	42	--	--	--
TOTAL LOAD:				3 kVA		4 kVA		5 kVA					
TOTAL AMPS:				25 A		34 A		40 A					
PANEL TOTALS													
LOAD CLASSIFICATION				CONNECTED	DEMAND	ESTIMATED							
RCPT				11628 VA	93.00%	10814 VA							
								CONNECTED LOAD: 11628 VA					
								ESTIMATED DEMAND: 10814 VA					
								CONNECTED CURRENT: 32 A					
								EST. DEMAND CURRENT: 30 A					
NOTES:													

PANELBOARD: SP													
LOCATION: SCENE SHOP/ STOR G111							VOLTAGE: 208Y/120 V, 3 ø 4 W.						
MOUNTING: SURFACE NEMA1							A.I.C. RATING: 10,000 AMPS SYMMETRICAL						
MAIN DEVICE: 100 A MLO							SPECIAL:						
BUS AMPS: 100 AMPS													
LOAD DESCRIPTION	BKR	POLES	CKT	A	B	C	CKT	POLES	BKR	LOAD DESCRIPTION			
RCPT SCENE / STOR G111	20 A	1	1	0.5	0.5		2	1	20 A	RCPT SCENE / STOR G111			
MOTORS SCENE / STOR....	20 A	1	3		0.4	0.4	4	1	20 A	RCPT SCENE / STOR G111			
MOTORS SCENE / STOR....	20 A	1	5				6	1	20 A	RCPT DRESS G115			
RCPT MAKE-UP G112	20 A	1	7	0.2	0.2		8	1	20 A	RCPT MAKE-UP G112			
RCPT MAKE-UP G112	20 A	1	9		0.7	0.7	10	1	20 A	RCPT DRESS G113			
RCPT SCENE / STOR G111	20 A	1	11				12	2	40 A	HEAT WHTR-2			
MOTORS EF-G111	15 A	1	13	0.3	3.1		14	--	--	--			
RCPT MAKE-UP G112	20 A	1	15			0.2	16	1	20 A	LITES MAKE-UP G112			
RCPT MAKE-UP G112	20 A	1	17				18	1	20 A	RCPT MAKE-UP G112			
Spare	20 A	1	19	0.0	0.2		20	1	20 A	RCPT MAKE-UP G112			
Spare	20 A	1	21		0.0	0.0	22	1	20 A	Spare			
			23				24						
			25				26						
			27				28						
			29				30						
			31				32						
			33				34						
			35				36						
			37				38						
			39				40						
			41				42						
TOTAL LOAD:				5 kVA	2 kVA	5 kVA							
TOTAL AMPS:				45 A	19 A	45 A							
PANEL TOTALS													
LOAD CLASSIFICATION				CONNECTED	DEMAND	ESTIMATED							
RCPT				5220 VA	100.00%	5220 VA	CONNECTED LOAD: 12311 VA						
MOTORS				1020 VA	100.00%	1020 VA	ESTIMATED DEMAND: 12316 VA						
LITES				20 VA	125.00%	25 VA	CONNECTED CURRENT: 34 A						
HEAT				6240 VA	100.00%	6240 VA	EST. DEMAND CURRENT: 34 A						
NOTES:													

EQUIPMENT SCHEDULE FOR LENNOX HS, SD							ACEI PROJECT #: 123034		
	DESCRIPTION	KW	HP	MCA	MOCF	VOLTS	PH	NOTES	
1	AHU-10	21.5	20	33.8	60/3	480	3	6	
2	AHU-11	6.0	5	9.5	15/3	480	3	6	
3	AHU-12	11.1	10	17.5	25/3	480	3	6	
4	AHU-13	8.7	7.5	13.8	20/3	480	3	6	
5	BCU-G111	2.7	2	4.3	15/3	480	3	4	
6	BCU-G117	2.7	2	4.3	15/3	480	3	4	
9	EF-F106	1.1	1/2	12.3	20/1	120	1	3	
10	EF-G111	0.3	1/15	3.1	15/1	120	1	3	
11	ERV - SUPPLY FANS	17.5	(2) 7.5	-	40/3	480	3	2	
12	ERV - EXHAUST FANS	12.1	(2) 5	-	30/3	480	3	2	
13	ERV - WHEEL	0.8	1/2	1.3	15/1	120	1	1	
14	CUH-E107	0.3	1/10	3.1	15/1	120	1	1	
15	CUH-E108	0.3	1/10	3.1	15/1	120	1	1	
16	CUH-E115	0.3	1/10	3.1	15/1	120	1	1	
17	CUH-F100A	0.3	1/10	3.1	15/1	120	1	1	
18	CUH-F100B	0.3	1/10	3.1	15/1	120	1	1	
19	UH-G207	0.1	16w	3.1	15/1	120	1	3	
20	WHTR-1	4.5	/	27.0	30/2	208	1	4	
21	WHTR-2	6.24	/	37.5	40/2	208	1	4	
22	RECIRC PUMP P-1	0.3	1/12	3.1	15/1	115	1	3	
23	SEWAGE PUMP P-2	2.1	1 1/2	3.3	15/3	480	3	7	
24	SEWAGE PUMP P-3	2.1	1 1/2	3.3	15/3	480	3	7	
25	DSS-G204	0.4	/	/	/	208	1	fed from CU-G204	
26	CU-G204	3.2	/	19.5	20/2	208	1	4	
27	CH-1	267.9	/	532.0	600/3	480	3	reconnected to existing	
28	IN FLOOR HEAT PUMP P-4	0.5	1/6	5.5	15/1	115	1	3	
29	EXHAUST FAN EF-G207	6	5	9.5	20/3	480	3	6	

# Lennox School District

## Lennox High School Addition

## Audio - Video - Lighting

### GENERAL NOTES - AVL Plans Overall:

A. Design Responsibility: For AC Electrical Power sources, panels, conduits, wiring and related, all technical details including size, routing, etc. are responsibility of Electrical Designer and/or Electrical Contractor. They must verify compliance with local codes & proper design practice, and make any modifications needed for compliance, while maintaining the original conceptual intent of the AV diagrams as much as possible.

B. AVL Equipment Schedule: Each AVL layout sheet includes a schedule for the AVL Equipment that applies to the indicated floor, wall or ceiling locations.

C. Locations & Placement: Electrical Contractor must verify all locations, positions, & mounting heights with Owner and/or Reach Communications.

D. Tech Power for AV: The TP (Technical Power) and LP (theatrical Lighting Power) locations and requirements shown in these plans are for AV purposes only.

E. Non-Tech Power: GP receptacles, as indicated, are dedicated for AV equiment that can be powered by the nearest general power circuit. We include these power requirements, when necessary, to aid in switch gear and power distribution sizing, by Electrical Consultant or Contractor.

F. Convenience Electrical Power: Not Shown. Convenience power is for general use, and additional outlets & circuits should be added and located accordingly, per code and as determined by others.

G. AV Conduits & Boxes - Materials & Installation Responsibility: All such items in these diagrams must be supplied & installed by the Electrical Contractor, unless explicitly indicated otherwise.

H. Conduit Size: Low-voltage conduit runs shall be EMT, and sized at or above the size specified in these drawings.

I. Conduit Bends & Distance: Conduit runs shall not have more than 360 degrees of bends, per code, without an appropriately-sized pull box. AV contractor needs to approve any variance to this specification. Conduit used shall be EMT.

J. AV Conduits Condition & Pull String: Electrical Contractor is responsible to verify that all AV conduits are free from debris & water, are open through their entire run such that they can accommodate their standard fill, and that all joints and couplings are installed according to proper workmanship. A nylon pull line must be installed in all AV conduits, unless approved otherwise.

K. Wire Protection at Stubs & Sleeves: All Conduit ends & terminations must be finished. Stubs & sleeves must be fitted with bushings to protect wiring insulation & cable jackets, e.g. Arlington EMTxxx, white nylon bushing, or similar method.

L. Conduit Separation: Wherever running parallel, AV conduits shall be separated by 2-ft, or as close to this as practical, from electrical power conduits, and shall cross at 90 degree angles, to avoid signal interference. This is especially critical for non-metallic conduits.

M. Bonding: Bond metal enclosures for AV, all Device boxes & J-Boxes, etc. to Earth Ground, and verify all AV metal conduits and metal boxes have a bonding path to Earth Ground.

N. Power-limited Cabling: All power-limited and signal cabling for AVL systems is supplied, installed & terminated by AVL Contractor except as indicated specifically otherwise in these drawings.

EXCEPTION - It is typical that 0-10v control cables, for House Lighting fixtures, be installed by the Electrical Contractor.

O. Fire Barrier Caulk: Where fire caulk is required per code & AHJ, for signal cabling sleeve penetrating a fire-rated wall or floor, approved fire-caulk product will be provided or specified by General Contractor or Electrical Contractor, to AV Contractor.

P. Atmospheric Effects Devices / Impact on Fire Detection: Fire detection system is By Others, and must be compatible with the use of atmospheric effect. Owner expects that atmospheric effects (e.g. Hazer, Fogger, "Smoke Machine") devices will be used in the room, either more immediately, or in the future, or for special events. Fire detection systems must be designed to accommodate this usage without triggering false alarms. For example, unless only individually heat-activated sprinkler heads are in use, a multi-criteria fire detection system suitable for the purpose should be considered, rather than smoke detectors based on single criteria such as ionization, photoelectric sensing, or reflected light beam sensing. Smoke detectors may be suitable for some supplemental purposes, if carefully placed to avoid false alarms during the usage of atmospheric effects.









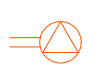
Sheet List			
Drawing #	Rev	Title	Comments
AV-001	0	Title Sheet	Cover Sheet, Legend & Overall General Notes
AV-002	0	AV Box Schedule	Signal Box Schedule & Notes
AV-101	0	Main Floor AVL Plan	Equipment, Signal Box & Tech Power Locations, Equipment Schedule
AV-102	0	Mezzanine AVL Plan	Equipment, Signal Box & Tech Power Locations, Equipment Schedule
AV-103	0	Catwalk AVL Plan	Equipment, Signal Box & Tech Power Locations, Equipment Schedule
AV-201	0	AVL Conduits Diagram	Riser Diagram for Signal Conduits & Boxes
AV-211	0	Electrical & Thermal Requirements for AVL	Electrical Circuit Schedules, Thermal Load, & Notes for Electrical
Total Sheets in this Release = 7			

### LEGEND:

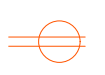
#### Device Designations for AVL:

AR = Audio Rack  
AVR = Audio-Video Rack  
AMP = Audio Amplifier  
CAM = Camera on Stand  
CB = Ceiling Box  
CP = Control Panel  
CS = Ceiling Speaker  
CSW = Company Switch  
CTRL = Control Pane  
DA = Signal Distribution Amplifier  
DS = Distributed Speaker  
DSP = Digital Signal Processor  
FB = Floor Box  
FF = Front-Fill Speaker  
FOH = Front Of House (Control Booth)  
FS = Fill-area Speaker  
ICOM = Intercom  
IO = Input/Output Device  
KC = Keyswitch Control, Wall-plate type  
LB = Lighting Batten  
LC = Lighting Control, Wall-plate type  
LF = Light Fixture  
LT = Lighting Truss  
MCP = Motor Control Panel  
MIX = Audio Mixing Console  
MOD = Modulator  
MON = Monitor  
NS = Network Switch  
OG = Open Gear Frame  
PB = Patch Bay  
PCR = Power Control Relay  
PDU = Power Distribution Unit  
PSQ = Power Sequencer  
PTZ = Robotic Camera  
REC = Media Capture Device  
RMT = Remote  
RTR = Router  
RX = Receiver  
SP = Speaker (Main Performance)  
SUB = Sub-Bass Speaker  
TSG = Test Signal Generator  
TX = Transmitter  
VC = Volume Control, Wall-plate type  
VD = Video Display, Flat-Panel type  
VSP = Video Signal Processor  
VM = Video Mixer  
VP = Video Projector  
VR = Video Rack  
VS = Video Screen, Projection type  
WAP = Wireless Access Point  
WB = Wall Box

#### Symbols:

 Duplex Electrical Wall Outlet  
 Duplex Electrical Floor Outlet  
 Duplex Electrical Ceiling  
 Quad Electrical Wall Outlet  
 Quad Electrical Floor Outlet  
 Quad Electrical Ceiling Outlet  
 Duplex Split-Wired  
 Quad Split-Wired  
 Special Purpose Electrical Wall Outlet


**TP**  Electrical Power Rough-in Location

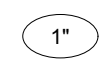
 1"

 (2nd Example, no inches symbol)

 Conduit Stub


 Ceiling Penetration

 Wall J-Box / Device Box for AVL

 Floor J-Box / Device Box for AVL

 Ceiling J-Box / Device Box for AVL

 Data Outlet - General Purpose

 Data & Voice Outlet - General Purpose

 **SUB2** AVL Device Designation

#### Circuit Designations for Electrical:

TP = Tech Power  
LP = Lighting Power  
GP = General Power  
IG = Isolated Ground (Iso Ground)  
Note: All TP Outlets are Iso Ground by Default.

#### Circuit Designations for AVL:

M = Mic Level Circuits  
L = Line Level Circuits  
S = Speaker Level Circuits  
V = Video Signal  
CX = Coax  
D = DMX Lighting Control  
IC = Intercom Communications  
N = Network, Serial, Digital Data  
FO = Fiber Optic  
C = Control Low-Voltage Ckt.s  
KC = Key Control  
F = Future Use

Client

**Lennox School District**

Lennox, SD

Project

**Lennox High School Addition**

Title

**Title Sheet**



Reach Communications

8600 109th Ave N - Ste 400  
Champlin, MN 55316

Drafted By: JJB

Scale:	Sheet Size:
See Detail Label	US Arch E1
Rev: 1	Date: 12/21/23

Release Status:

Release to CD Coord.

Sheet #:

**AV-001**



AV BOX SCHEDULE

EC = Electrical Contractor; AV-C = AV Contractor										Electrical Contractor Installs All Boxes & Conduits. ALL Power Receptacles for Floor Boxes are Provided & Installed by EC.			
Identifier	Loc. Page	Room	Location	Function / Purpose	Size	Type	Height	Mounting	Backbox Model	BBX By	Cover or Device Model	Cov/Dev By	Comments
FB1	AV-101	Stage G106	Stage G106, Front-Right	Stage AV Connections	10x10x8	Floor Box	Stage	Floor	Ace Backstage: BRK1028BBX	AV-C	Ace Backstage: BZ132M2BK	AV-C	
FB2	AV-101	Stage G106	Stage G106, Front-Right-Middle	Stage AV Connections	10x10x8	Floor Box	Stage	Floor	Ace Backstage: BRK1028BBX	AV-C	Ace Backstage: BZ132M2BK	AV-C	
FB3	AV-101	Stage G106	Stage G106, Front-Left-Middle	Stage AV Connections	10x10x8	Floor Box	Stage	Floor	Ace Backstage: BRK1028BBX	AV-C	Ace Backstage: BZ132M2BK	AV-C	
FB4	AV-101	Stage G106	Stage G106, Front-Left	Stage AV Connections	10x10x8	Floor Box	Stage	Floor	Ace Backstage: BRK1028BBX	AV-C	Ace Backstage: BZ132M2BK	AV-C	
FB5	AV-101	Stage G106	Stage G106, Back-Right	Stage AV Connections	18x10x8	Floor Box	Stage	Floor	Ace Backstage: BRK1048BBX	AV-C	Ace Backstage: BZ134M2BK	AV-C	
FB6	AV-101	Stage G106	Stage G106, Back-Middle	Stage AV Connections	18x10x8	Floor Box	Stage	Floor	Ace Backstage: BRK1048BBX	AV-C	Ace Backstage: BZ134M2BK	AV-C	
FB7	AV-101	Stage G106	Stage G106, Back-Left	Stage AV Connections	18x10x8	Floor Box	Stage	Floor	Ace Backstage: BRK1048BBX	AV-C	Ace Backstage: BZ134M2BK	AV-C	
WB1	AV-101	Stair G110	Stair G110, South Wall	Transition Box	8x8x72	Screw-Cover Wireway	12-18" AFF	Surface	Wiegmann: S8872NK, or Equiv.	EC	Screw Cover, incl 'd w/ Box	EC	Opens Away from Wall
WB2	AV-102	Control G63	Control G63, Below Counter	Transition Box	6x8x72	Screw-Cover Wireway	12-18" AFF	Surface	Wiegmann: S6672NK, or Equiv.	EC	Screw Cover, incl 'd w/ Box	EC	Opens Away from Wall
WB21	AV-101	Stair G110	Stair G110; West Wall, See AV-101	RMT, DSP Remote	4" Sq	2-1/8" Deep, w/ 2G Mud Ring	60" AFF, or Match Height of Others	Flush	Raco or similar	EC	2G Blank, Match Color of Others	EC	
WB22	AV-101	Make-Up G112	Make-Up G112; East Wall, See AV-101	RMT, DSP Remote	4" Sq	2-1/8" Deep, w/ 1G Mud Ring	46" AFF, or Match Height of Others	Flush	Raco or similar	EC	1G Blank, Match Color of Others	EC	
WB31	AV-101	Stage G106	Stage G106, SE-Wall Facing Backstage	Speaker	4" Sq	2-1/8" Deep, w/ 1G Mud Ring	86" AFF	Flush	Raco or similar	EC	1G Blank, Match Color of Others	EC	
WB32	AV-101	Stage G106	Stage G106, NE-Wall Facing Backstage	Speaker	4" Sq	2-1/8" Deep, w/ 1G Mud Ring	86" AFF	Flush	Raco or similar	EC	1G Blank, Match Color of Others	EC	
WB41	AV-101	Make-Up G112	Make-Up G112; East Wall, Above RMT	VD, Video Display	4" Sq	2-1/8" Deep, w/ 8x 1"KO, w/ 1G Mud Ring	78" AFF	Flush	Cooper/Crouse-Hinds TP436 or similar	EC	1G Blank, Match Color of Others	EC	
WB51	AV-101	Lobby F101	Lobby F101, West Wall, Adjacent to WB51	VD, Video Display	4" Sq	2-1/8" Deep, w/ 8x 1"KO, w/ 1G Mud Ring	84" AFF	Flush	Cooper/Crouse-Hinds TP436 or similar	EC	1G Blank, Match Color of Others	EC	
WB71	AV-102	Balcony G201	Balcony G201, East Wall	AVL Connections	8x8x4	Screw-Cover Box	12-18" AFF	Flush	Wiegmann: SC080804NK, or Equiv.	EC	Screw Cover, incl 'd w/ Box	EC	
WB72	AV-102	Balcony G202	Balcony G202, East Wall	AVL Connections	8x8x4	Screw-Cover Box	12-18" AFF	Flush	Wiegmann: SC080804NK, or Equiv.	EC	Screw Cover, incl 'd w/ Box	EC	
WB111	AV-103	Theater G105	Theater G105, Catwalk 1, Front Rail Center	AVL Connections	8x8x4	Screw-Cover Box	Top Rail	Surface	Wiegmann: SC080804NK, or Equiv.	EC	Screw Cover, incl 'd w/ Box	EC	Box Faces into Catwalk
WB112	AV-103	Theater G105	Theater G105, Catwalk 2, Front Rail Center	AVL Connections	8x8x4	Screw-Cover Box	Top Rail	Surface	Wiegmann: SC080804NK, or Equiv.	EC	Screw Cover, incl 'd w/ Box	EC	Box Faces into Catwalk
WB113	AV-103	Theater G105	Theater G105, Catwalk 3, Front Rail Center	AVL Connections	8x8x4	Screw-Cover Box	Top Rail	Surface	Wiegmann: SC080804NK, or Equiv.	EC	Screw Cover, incl 'd w/ Box	EC	Box Faces into Catwalk
WB114	AV-103	Stage G106	Stage G106; Catwalk 4, Front Rail Center	AVL Connections	8x8x4	Screw-Cover Box	Top Rail	Surface	Wiegmann: SC080804NK, or Equiv.	EC	Screw Cover, incl 'd w/ Box	EC	Box Faces into Catwalk
WB115	AV-103	Stage G106	Stage G106; Catwalk 5, Front Rail Center	AVL Connections	8x8x4	Screw-Cover Box	Top Rail	Surface	Wiegmann: SC080804NK, or Equiv.	EC	Screw Cover, incl 'd w/ Box	EC	Box Faces into Catwalk
WB116	AV-103	Stage G106	Stage G106; Catwalk 6, Front Rail Center	AVL Connections	8x8x4	Screw-Cover Box	Top Rail	Surface	Wiegmann: SC080804NK, or Equiv.	EC	Screw Cover, incl 'd w/ Box	EC	Box Faces into Catwalk

BOX TYPE - FURTHER DETAILS

ID	Box Size	Box Type	Mount Type	Further Description	Example Model	Comments
A	4" Sq	2-1/8" Deep, w/ 1G Mud Ring	Flush	4" Square, 2-1/8" Deep Steel standard device box with 1/2" & 3/4" knockouts with 1-Gang Mud Ring.	Raco or similar	Used for Flush-Mount in GWB (drywall), for mounting 1-Gang connector plate or device.
B	4" Sq	2-1/8" Deep, w/ 2G Mud Ring	Flush	4" Square, 2-1/8" Deep Steel standard device box with 1/2" & 3/4" knockouts with 2-Gang Mud Ring.	Raco or similar	Used for Flush-Mount in GWB (drywall), for mounting 2-Gang connector plate or device.
C	4" Sq	2-1/8" Deep, w/ 8x 1"KO, w/ 1G Mud Ring	Flush	4" Square, 2-1/8" Deep w/ 8x 1" Knock-Outs on sides, 1/2" & 3/4" on back with 1-Gang Mud Ring.	Cooper/Crouse-Hinds TP436 or similar	Used for Flush-Mount in GWB (drywall), with 1" Knock-Outs.
D	4" Sq	2-1/8" Deep, w/ 8x 1"KO, w/ 2G Mud Ring	Flush	4" Square, 2-1/8" Deep w/ 8x 1" Knock-Outs on sides, 1/2" & 3/4" on back with 2-Gang Mud Ring.	Cooper/Crouse-Hinds TP436 or similar	Used for Flush-Mount in GWB (drywall), with 1" Knock-Outs.
E	4" Sq	2-1/8" Deep, w/ 8x 1"KO	Surface	4" Square, 2-1/8" Deep w/ 8x 1" Knock-Outs on sides, 1/2" & 3/4" on back.	Cooper/Crouse-Hinds TP436 or similar	Used for Small Surface-Mount Cabling Pull or Device Box with 1" Knock-Outs.
F	4-11/16" Sq	2-1/8" Deep, w/ 8x 1"KO	Surface	4-11/16" Sq. box 2-1/8" Deep, w/ 8x 1" Knock-Outs on sides, other 1/2" & 3/4" on back.	Cooper/Crouse-Hinds TP560 or similar	Surface-mount for Device mounting with 1" Knock-Outs. Blank cover is typical.
G	4-11/16" Sq	2-1/8" Deep, w/ 1" & 3/4" KO w/ 1G Ring	Surface	4-11/16" Sq. box 2-1/8" Deep, w/ 4x 1" & 4x 3/4" Knock-Outs on sides, others on back, 1G Flat Ring.	Cooper/Crouse-Hinds TP558 or similar	1G Flat Ring: Garvin 72C62A or similar. Results in No plate overlap for device mounting.
H	4-11/16" Sq	2-1/8" Deep, w/ 1" & 3/4" KO, w/ 2G Ring	Surface	4-11/16" Sq. box 2-1/8" Deep, w/ 4x 1" & 4x 3/4" Knock-Outs on sides, others on back, 2G Flat Ring.	Cooper/Crouse-Hinds TP558 or similar	2G Flat Ring: Cooper/CH TP590 or similar. Results in No plate overlap for device mounting.
I	1G	2-1/2" Deep Flush	Flush	Device box for flush-mounting, 1-Gang 2-1/2" Deep, Steel, with 1/2" & 3/4" knockouts.	Raco or similar	GWB (drywall) or Masonry type, as appropriate.
J	2G	2-1/2" Deep Flush	Flush	Device box for flush-mounting, 2-Gang 2-1/2" Deep, Steel, with 1/2" & 3/4" knockouts.	Raco or similar	GWB (drywall) or Masonry type, as appropriate.
K	3G	3G, Deep, w/ 3G Ring	Flush or Surface	4-1/2" H x 2-1/2" D x 8-5/8" W, 90 cu.in. Steel Box w/ 3/4" & 1" Knock-Outs, 3-Gang Ring.	Cooper/Crouse-Hinds TP871 or similar	Flush in GWB (drywall) or Surface, w/ Garvin GBGFI-3 Flat Decora 3-Sp Ring; Initially w/ Blank cover by EC, Typ.
L	4G	4G, Deep, w/ 4G Ring	Flush or Surface	4-1/2" H x 2-1/2" D x 10-7/16" W, 110 cu.in. Steel Box w/ 3/4" & 1" Knock-Outs, 4-Gang Ring.	Cooper/Crouse-Hinds TP872 or similar	Flush in GWB (drywall) or Surface, w/ Garvin GBGFI-4 Flat Decora 4-Sp Ring; Initially w/ Blank cover by EC, Typ.
M	1G	Deep Masonry	Flush	Device box for flush-mounting in masonry, 1-Gang 2-1/2" Deep, Steel, with 1/2" & 3/4" knockouts.	Cooper/Crouse-Hinds TP682 or similar	Specifically for Masonry flush mounting.
N	2G	Deep Masonry	Flush	Device box for flush-mounting in masonry, 2-Gang 2-1/2" Deep, Steel, with 1/2" & 3/4" knockouts.	Cooper/Crouse-Hinds TP683 or similar	Specifically for Masonry flush mounting.
O	3G	Deep Masonry	Flush	Device box for flush-mounting in masonry, 3-Gang 2-1/2" Deep, Steel, with 1/2" & 3/4" knockouts.	Cooper/Crouse-Hinds TP684 or similar	Specifically for Masonry flush mounting.
P	1G	Surface, Metal Raceway Box	Surface	Surface-mount steel box, factory painted. 1 Gang, 4.5" x 2.75" min., no plate overlap. 1.5" Deep min.	Wiremold or similar	Coordinate color for job. Typically White, Almond or Beige. Field-paint for Black.
Q	2G	Surface, Metal Raceway Box	Surface	Surface-mount steel box, factory painted. 2 Gang, 4.5" x 4.562" min., no plate overlap. 1.5" Deep min.	Wiremold or similar	Coordinate color for job. Typically White, Almond or Beige. Field-paint for Black.

NOTES - Specific to This Sheet - AV Boxes:

1. AV Boxes - Supplied By: Electrical Contractor will supply & install all Back-Boxes and attached conduits, and also blank or standard covers. Devices (e.g. controls, connectors, custom plates, and similar) installed inside of, and as special purpose covers for these boxes, are installed by AVL Contractor, unless noted otherwise. Racks are supplied and installed by AVL Contractor.
2. Box Types As-Listed Are Required: Electrical Contractor will install the specific box types listed, or equivalent, unless approved otherwise by AVL Contractor. Further box details are listed for 1G, 2G, 3G, 4 Square & 4-11/16 Square in the separate table on this sheet, to help clarify.

Client

Lennox School District

Lennox, SD

Project

Lennox High School Addition

Title

AVL Box Schedule



Reach Communications  
8600 109th Ave N - Ste 400  
Champlin, MN 55316

Drafted By: JJB

Scale: None Sheet Size: US Arch E1  
Rev: 1 Date: 12/21/23

Release Status:

Release to CD Coord.

Sheet #:

AV-002

AVL Equipment Schedule\*

Area: First Floor

Ref ID	Room / Mounting Loc.	Mounting Ht.**	Type	Manuf.	Model #	Acc Model #	Acc Type	By Others	OFE	Comments
AR1	Stair G110	Floor	Audio Rack	Middle Atlantic	WRK-SA44-32	MW-VT, CBS-WRK-32	Vented Top, Caster Base			

\*All Equipment in this Schedule is Supplied & Installed By AV-Contractor, Except as Indicated with "Yes" in "By Others" or "OFE" Columns. (OFE = Owner Furnished Equip.)


\*\*Trim Height as Indicated is From Lowest Elevation Point of Equipment, Except Electrical Boxes or Panels Installed by EC are On Centers.

KEYED NOTES - Specific To AV-101:

- Power Receptacles shown alongside of Floor Boxes are Located Inside Floor Boxes (i.e. Integrated).
- House Data Wall Jack needed at this location, by Others.
- Thermal Load of AV Equipment in Smaller, Enclosed Area: See "Thermal Load Table" on Sheet AV-211.


GENERAL NOTES - Audio, Video, Lighting Plan:

- Symbols Legend & General Project Notes: See AV-001.
- AVL Equipment Schedule: This sheet includes a schedule for the AVL Equipment that applies to the indicated floor, wall or ceiling locations.
- Locations & Placement: Electrical Contractor must verify all locations, positions, & mounting heights with Owner and/or Reach Communications.
- AV J-Boxes: See AV-002 for Sizes, Types, Mounting Heights, etc. - Supplied & Installed by Electrical Contractor, Except as noted otherwise in AV Box Schedule.
- AV Conduits Between Boxes: See AV-201, Supplied and Installed by Electrical Contractor.
- Conduit Runs: Low-voltage conduit runs shall not have more than 360 degrees of bends, per code, without a pull box. Conduits shall be EMT, and sized as indicated. AV contractor needs to approve any variance with this specification.
- Electrical Power Requirements: See AV-211.
- Tech Power for AV: The TP (Technical Power) and LP (theatrical Lighting Power) locations and requirements shown in these plans are for AV purposes only.
- Non-Tech Power: GP receptacles, as indicated, are dedicated for AV equipment that can be powered by the nearest general power circuit. We include these power requirements, when necessary, to aid in switch gear and power distribution sizing, by Electrical Consultant or Contractor.
- Convenience Electrical Power: Not Shown. Convenience power is for general use, and additional outlets & circuits should be added and located accordingly, per code and as determined by others.
- Audio, Video and Lighting equipment/fixtures shown are for reference only. Actual number/type of equipment may vary, based on final scope determinations, and in accordance with an install contract.
- Atmospheric Effects Devices / Impact on Fire Detection: Fire detection system is By Others, and must be compatible with the use of atmospheric effects. Owner expects that atmospheric effects (e.g. Hazer, Fogger, "Smoke Machine") devices will be used in the room, either more immediately, or in the future, or for special events. Fire detection systems must be designed to accommodate this usage without triggering false alarms. For example, unless only individually heat-activated sprinkler heads are in use, a multi-criteria fire detection system suitable for the purpose should be considered, rather than smoke detectors based on single criteria such as ionization, photoelectric sensing, or reflected light beam sensing. Smoke detectors may be suitable for some supplemental purposes, if carefully placed to avoid false alarms during the usage of atmospheric effects.

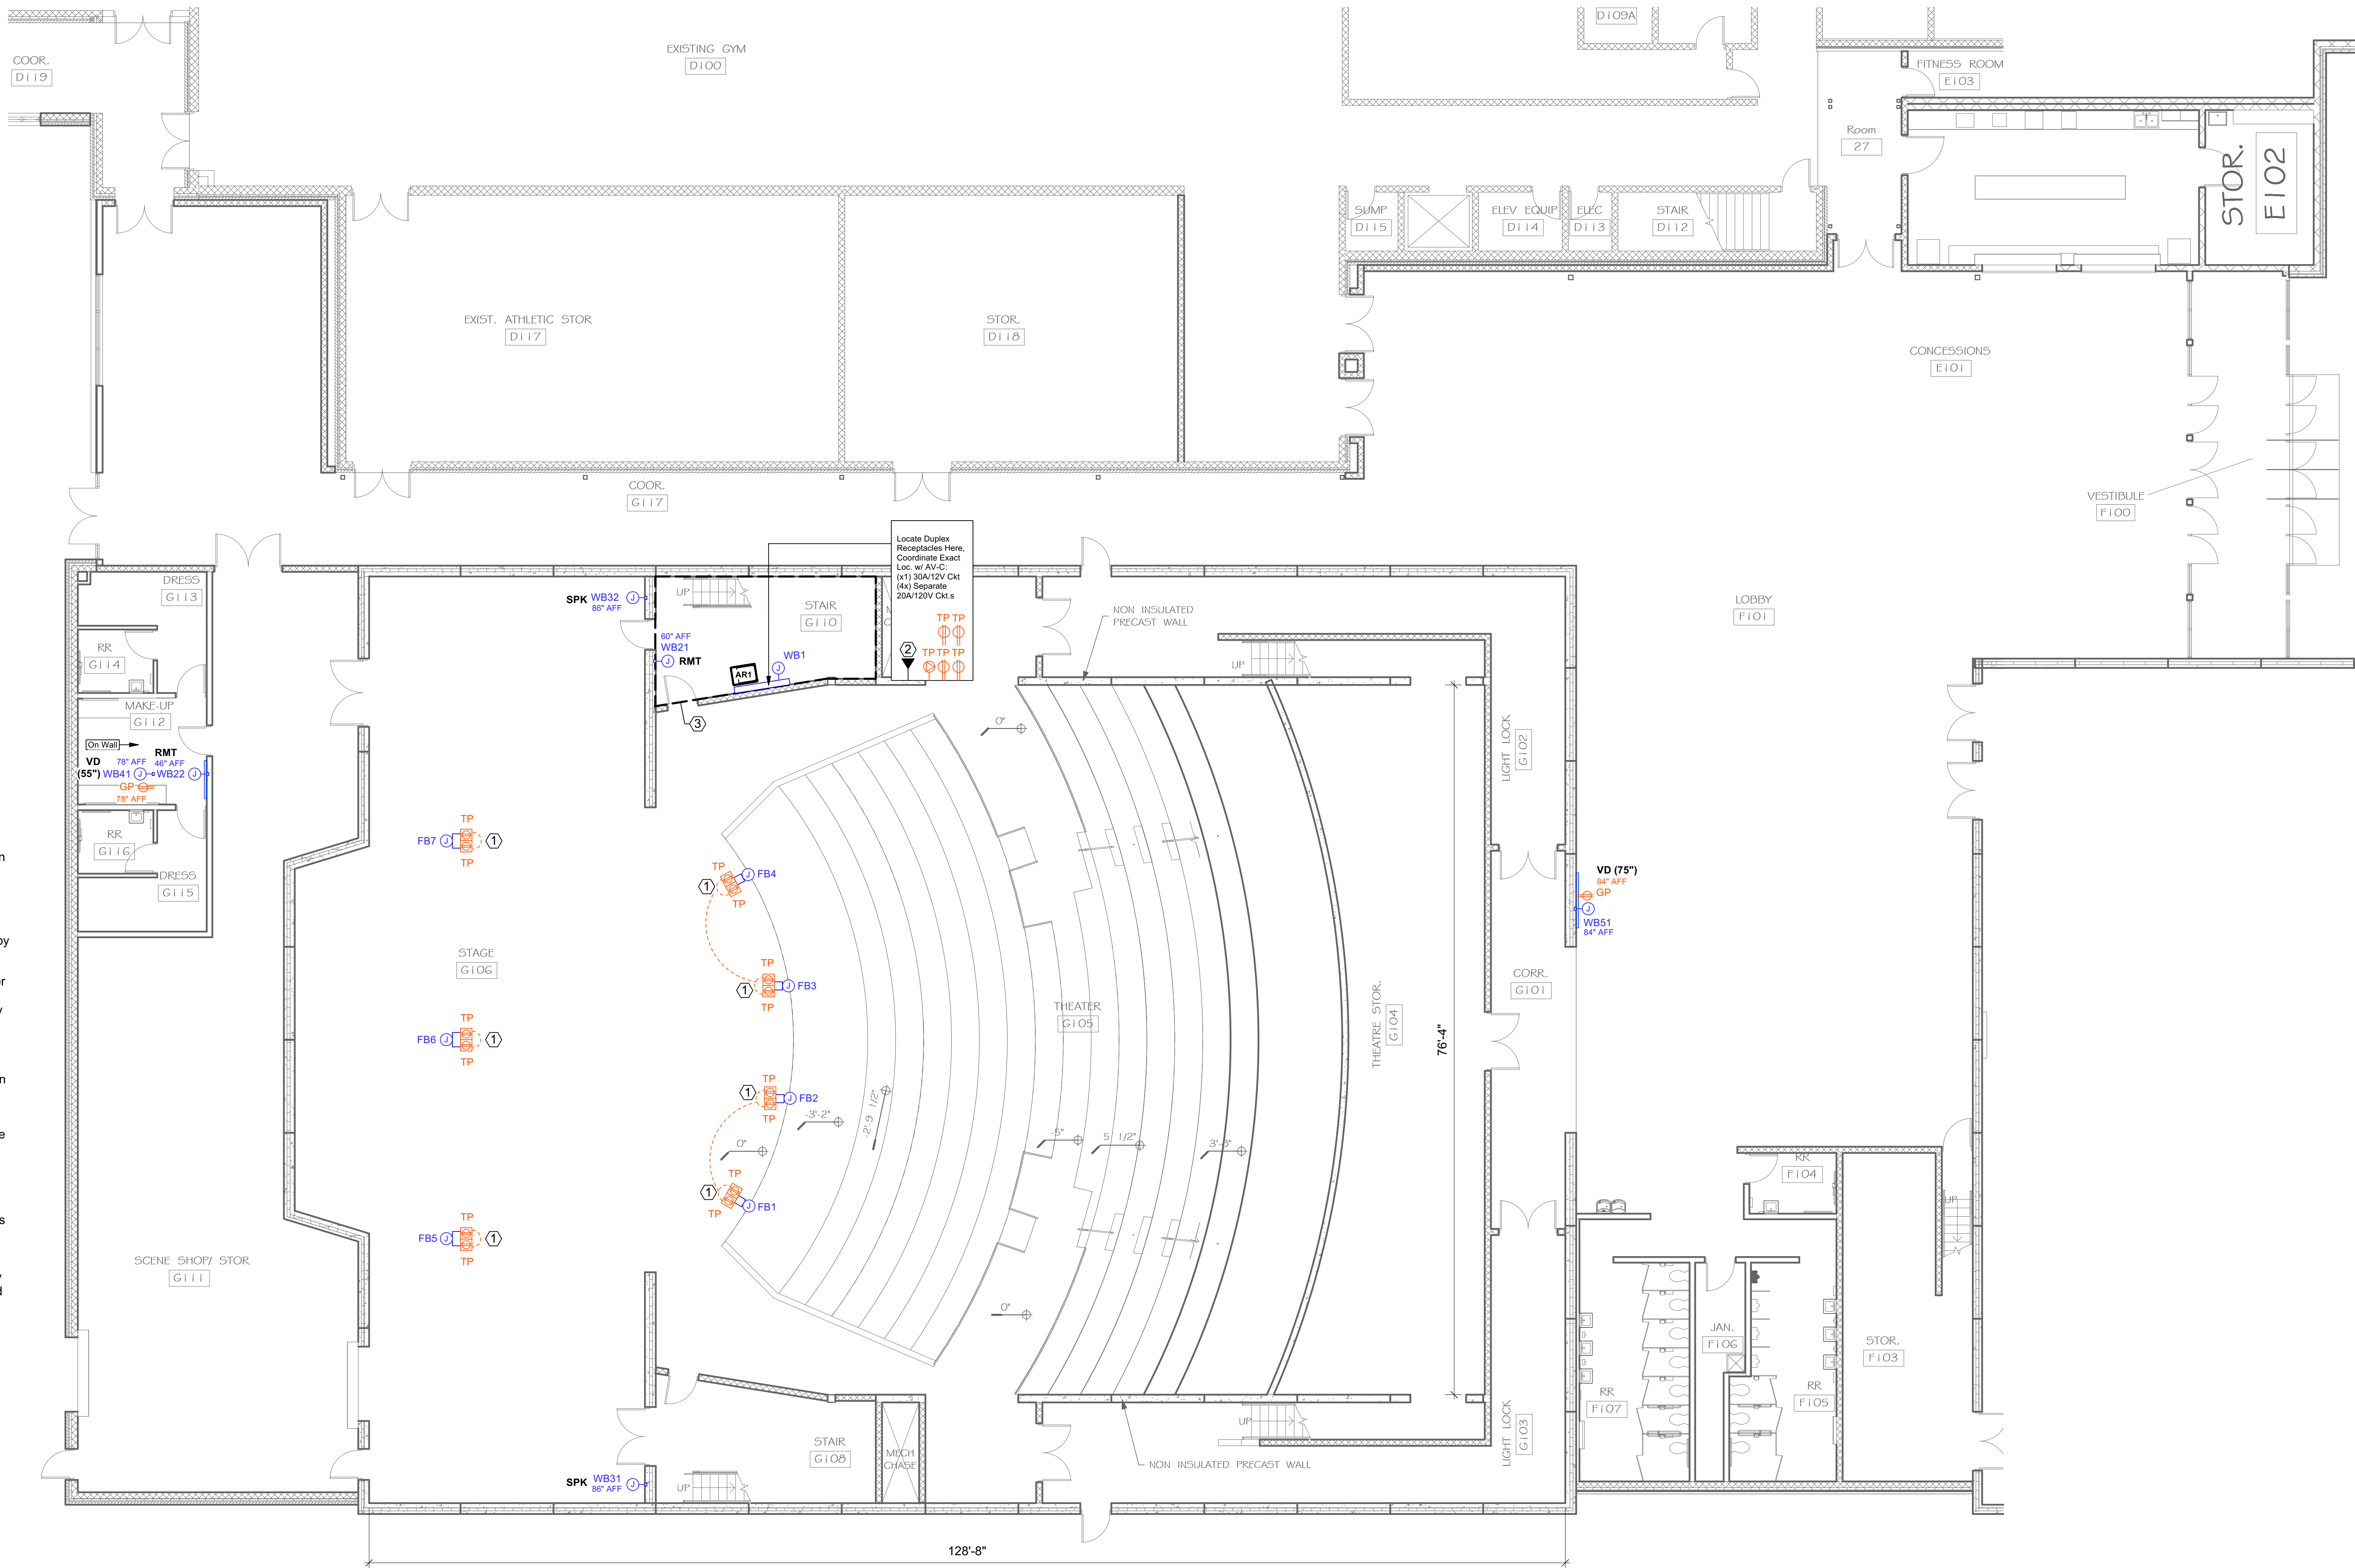

1 First Floor AVL Plan  
SCALE: 1/8" = 1'-0"

0 6 9 12 15 FT

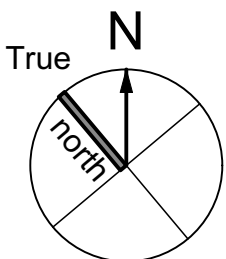

Revision Notes

Client  
**Lennox School District**  
  
Lennox, SD  
  
Project  
**Lennox High School Addition**  
  
Title  
**First Floor AVL Plan**



Reach Communications  
8600 109th Ave N - Ste 400  
Champlin, MN 55316

Drafted By: JJB  
Scale: See Detail Label Sheet Size: US Arch E1  
Rev: 1 Date: 12/21/23  
Release Status:

Release to CD Coord.

Sheet #:  
**AV-101**




KEYED NOTES - Specific To AV-102:


1. House Data Wall Jack needed at this location, by Others.


GENERAL NOTES - Audio, Video, Lighting Plan:

- A. Symbols Legend & General Project Notes: See AV-001.
- B. AVL Equipment Schedule: This sheet includes a schedule for the AVL Equipment that applies to the indicated floor, wall or ceiling locations.
- C. Locations & Placement: Electrical Contractor must verify all locations, positions, & mounting heights with Owner and/or Reach Communications.
- D. AV J-Boxes: See AV-002 for Sizes, Types, Mounting Heights, etc. - Supplied & Installed by Electrical Contractor, Except as noted otherwise in AV Box Schedule.
- E. AV Conduits Between Boxes: See AV-201, Supplied and Installed by Electrical Contractor.
- F. Conduit Runs: Low-voltage conduit runs shall not have more than 360 degrees of bends, per code, without a pull box. Conduits shall be EMT, and sized as indicated. AV contractor needs to approve any variance with this specification.
- G. Electrical Power Requirements: See AV-211.
- H. Tech Power for AV: The TP (Technical Power) and LP (Theatrical Lighting Power) locations and requirements shown in these plans are for AV purposes only.
- I. Non-Tech Power: GP receptacles, as indicated, are dedicated for AV equipment that can be powered by the nearest general power circuit. We include these power requirements, when necessary, to aid in switch gear and power distribution sizing, by Electrical Consultant or Contractor.
- J. Convenience Electrical Power: Not Shown. Convenience power is for general use, and additional outlets & circuits should be added and located accordingly, per code and as determined by others.
- K. Audio, Video and Lighting equipment/fixtures shown are for reference only. Actual number/type of equipment may vary, based on final scope determinations, and in accordance with an install contract.
- L. Atmospheric Effects Devices / Impact on Fire Detection: Fire detection system is By Others, and must be compatible with the use of atmospheric effects. Owner expects that atmospheric effects (e.g. Hazer, Fogger, "Smoke Machine") devices will be used in the room, either more immediately, or in the future, or for special events. Fire detection systems must be designed to accommodate this usage without triggering false alarms. For example, unless only individually heat-activated sprinkler heads are in use, a multi-criteria fire detection system suitable for the purpose should be considered, rather than smoke detectors based on single criteria such as ionization, photoelectric sensing, or reflected light beam sensing. Smoke detectors may be suitable for some supplemental purposes, if carefully placed to avoid false alarms during the usage of atmospheric effects.

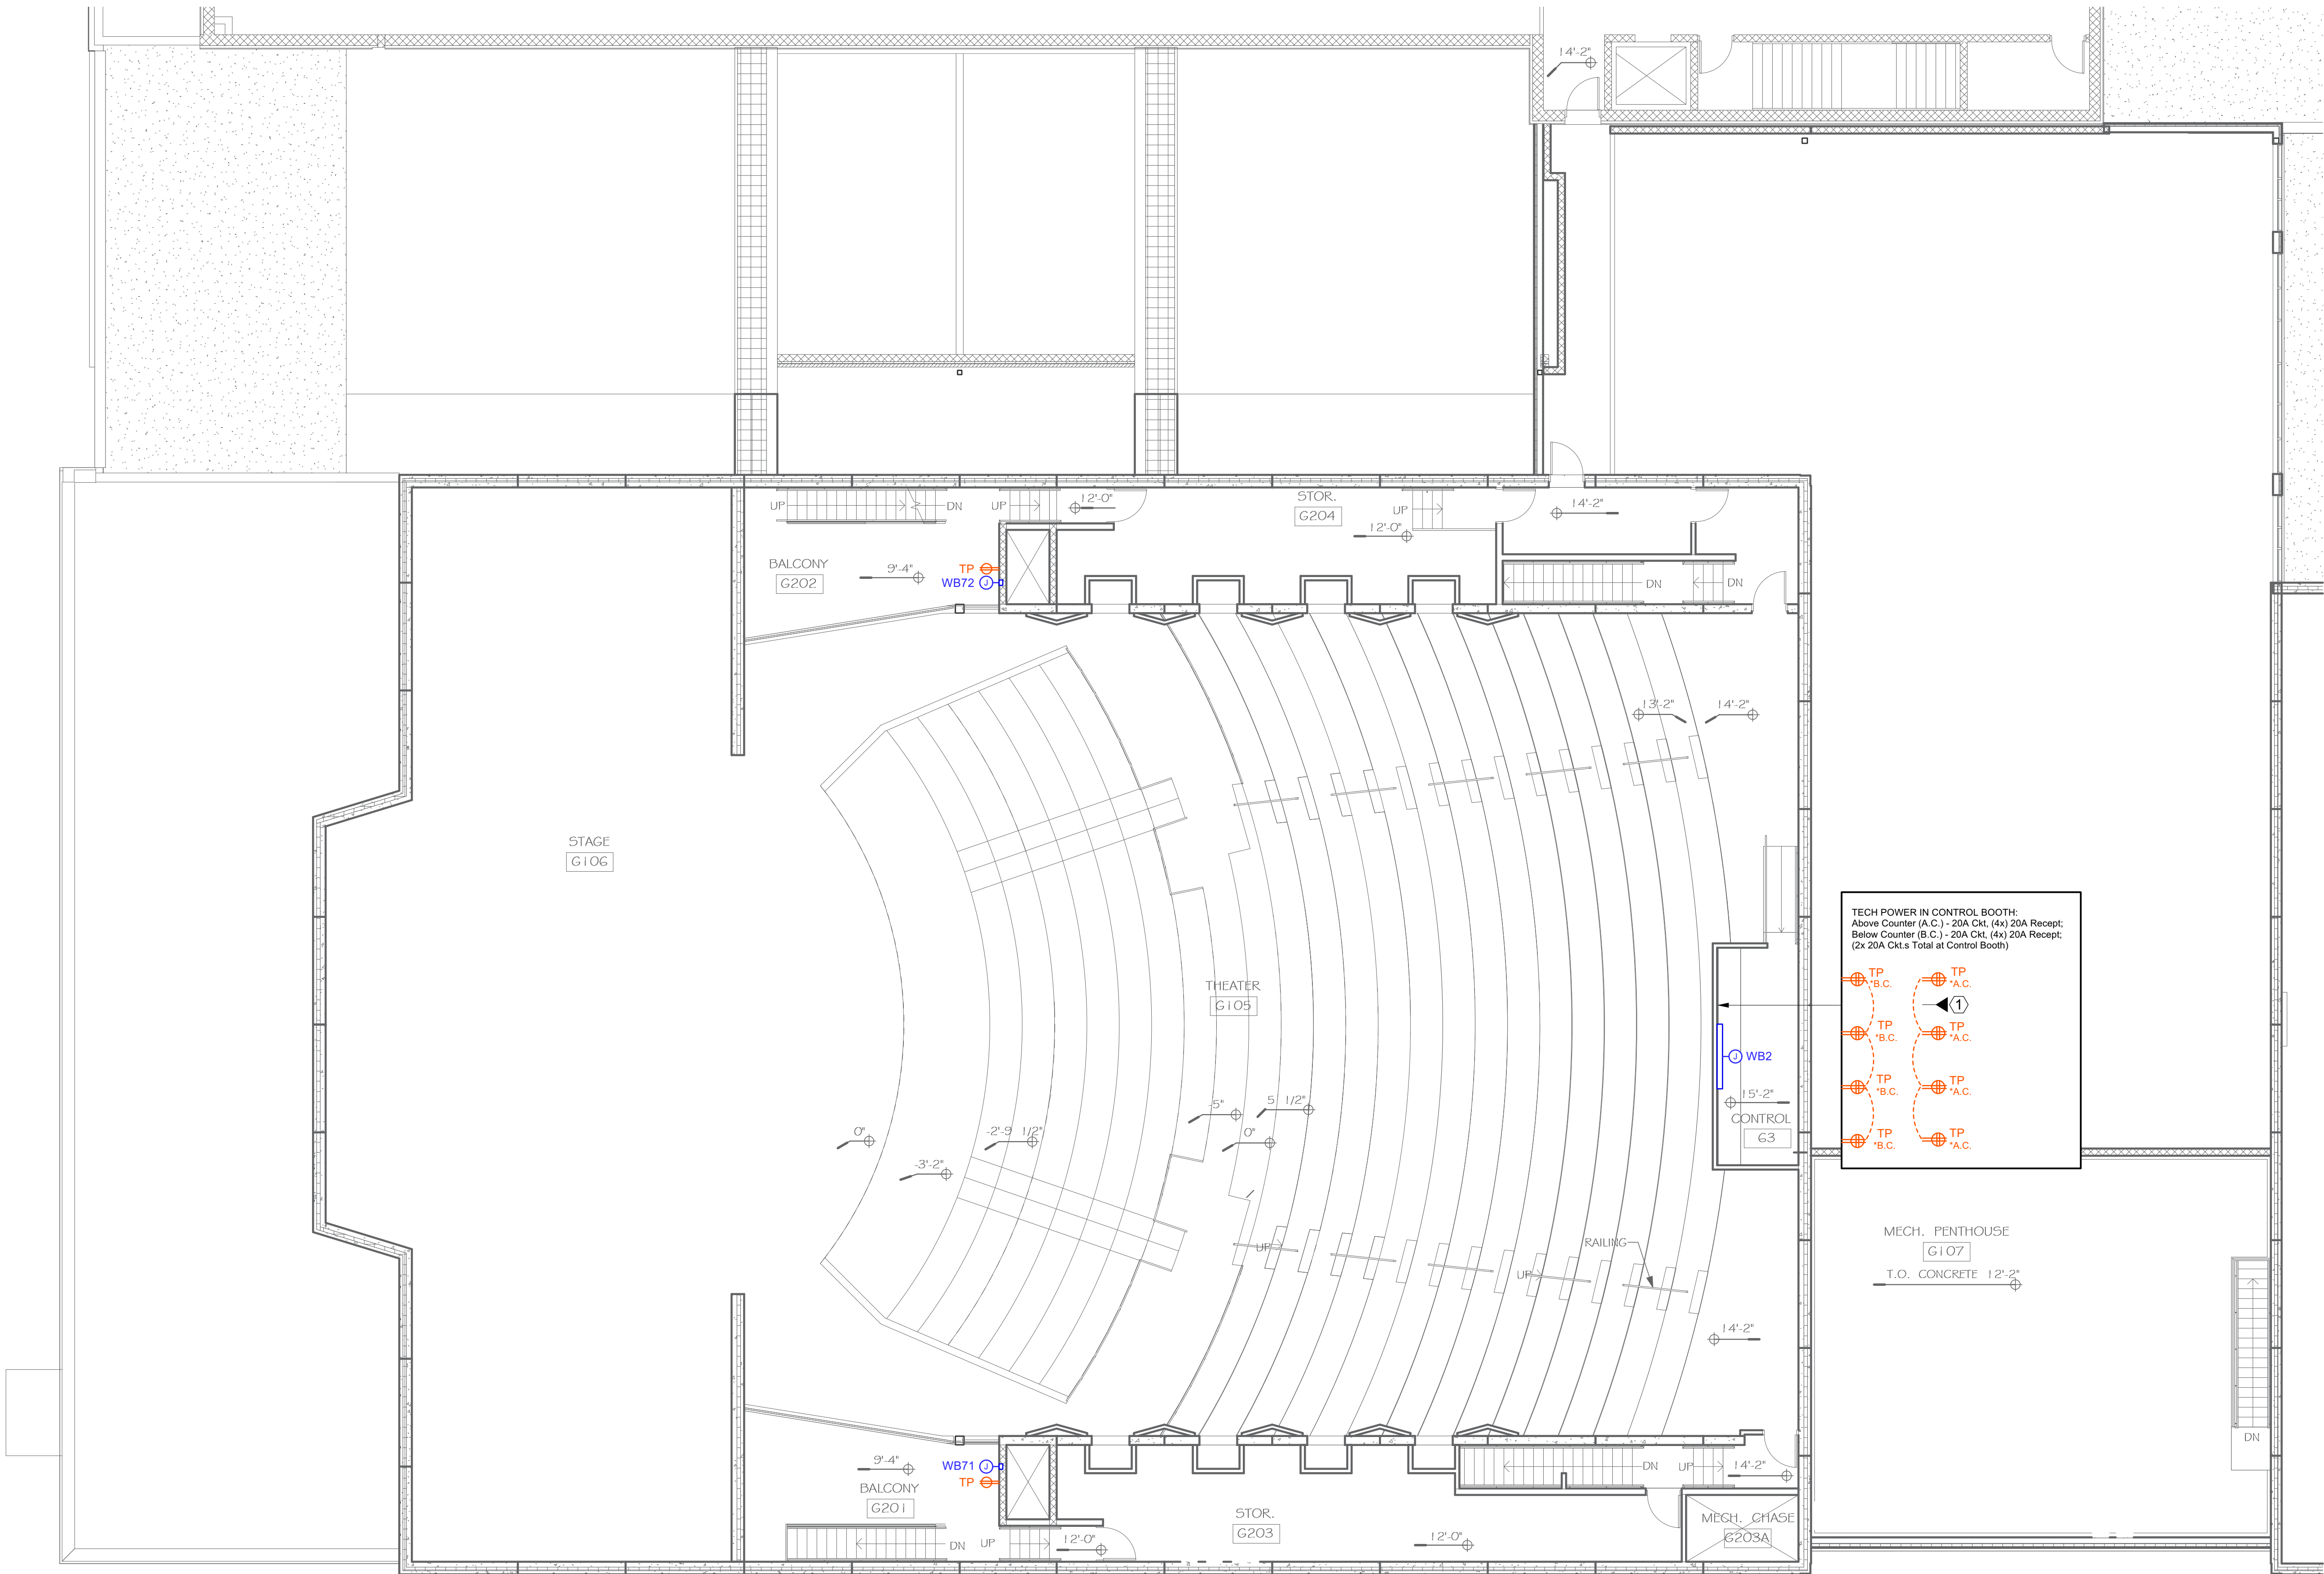

1 Mezzanine AVL Plan  
SCALE: 1/8" = 1'-0"

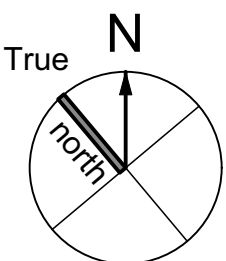

Revision Notes	
Client	Lennox School District
	Lennox, SD
Project	Lennox High School Addition
Title	Mezzanine AVL Plan
 Reach Communications 8600 109th Ave N - Ste 400 Champlin, MN 55316	
Drafted By:	JJB
Scale:	See Detail Label
Rev:	1
Release Status:	Release to CD Coord.
Sheet Size:	US Arch E1
Date:	12/21/23
Sheet #:	AV-102



AVL Equipment Schedule\*

Area:	First Floor Ceiling									
Ref ID	Room / Mounting Loc.	Mounting Ht.**	Type	Manuf.	Model #	Acc Model #	Acc Type	By Others	OFE	Comments
VS1	Stage G106, Pipe Grid	TBD	Video Screen, Projection, Motorized	Da-Lite	38700					21.5 ft Wide nom., 16:9 Aspect, Matte White surface

\*All Equipment in this Schedule is Supplied & Installed By AV-Contractor, Except as Indicated with "Yes" in "By Others" or "OFE" Columns. (OFE = Owner Furnished Equip.)


\*\*Trim Height as indicated is from lowest elevation point of equipment

KEYED NOTES - Specific To AV-103:


1. Elec. Receptacle Mounting - Rail: Mount recept. box directly on rail, facing sideways, with front facing Backstage.
2. Box Mounting - Rail: Mount box directly on rail, facing sideways, with front facing into Catwalk.
3. Projector Screen Elec. Duplex Receptacle: Mount directly on pipe grid, facing down. Coordinate Exact Location with AV-C.
4. CONF MON Location: Catwalk Front Rail; Align with Center of Stage.

GENERAL NOTES - Audio, Video, Lighting Plan:

- A. Symbols Legend & General Project Notes: See AV-001.
- B. AVL Equipment Schedule: This sheet includes a schedule for the AVL Equipment that applies to the indicated floor, wall or ceiling locations.
- C. Locations & Placement: Electrical Contractor must verify all locations, positions, & mounting heights with Owner and/or Reach Communications.
- D. AV J-Boxes: See AV-002 for Sizes, Types, Mounting Heights, etc. - Supplied & Installed by Electrical Contractor, Except as noted otherwise in AV Box Schedule.
- E. AV Conduits Between Boxes: See AV-201, Supplied and Installed by Electrical Contractor.
- F. Conduit Runs: Low-voltage conduit runs shall not have more than 360 degrees of bends, per code, without a pull box. Conduits shall be EMT, and sized as indicated. AV contractor needs to approve any variance with this specification.
- G. Electrical Power Requirements: See AV-211.
- H. Tech Power for AV: The TP (Technical Power) and LP (Theatrical Lighting Power) locations and requirements shown in these plans are for AV purposes only.
- I. Non-Tech Power: GP receptacles, as indicated, are dedicated for AV equipment that can be powered by the nearest general power circuit. We include these power requirements, when necessary, to aid in switch gear and power distribution sizing, by Electrical Consultant or Contractor.
- J. Convenience Electrical Power: Not Shown. Convenience power is for general use, and additional outlets & circuits should be added and located accordingly, per code and as determined by others.
- K. Audio, Video and Lighting equipment/fixtures shown are for reference only. Actual number/type of equipment may vary, based on final scope determinations, and in accordance with an Install contract.
- L. Atmospheric Effects Devices / Impact on Fire Detection: Fire detection system is By Others, and must be compatible with the use of atmospheric effects. Owner expects that atmospheric effects (e.g. Hazer, Fogger, "Smoke Machines") devices will be used in the room, either more immediately, or in the future, or for special events. Fire detection systems must be designed to accommodate this usage without triggering false alarms. For example, unless only individually heat-activated sprinkler heads are in use, a multi-criteria fire detection system suitable for the purpose should be considered, rather than smoke detectors based on single criteria such as ionization, photoelectric sensing, or reflected light beam sensing. Smoke detectors may be suitable for some supplemental purposes, if carefully placed to avoid false alarms during the usage of atmospheric effects.

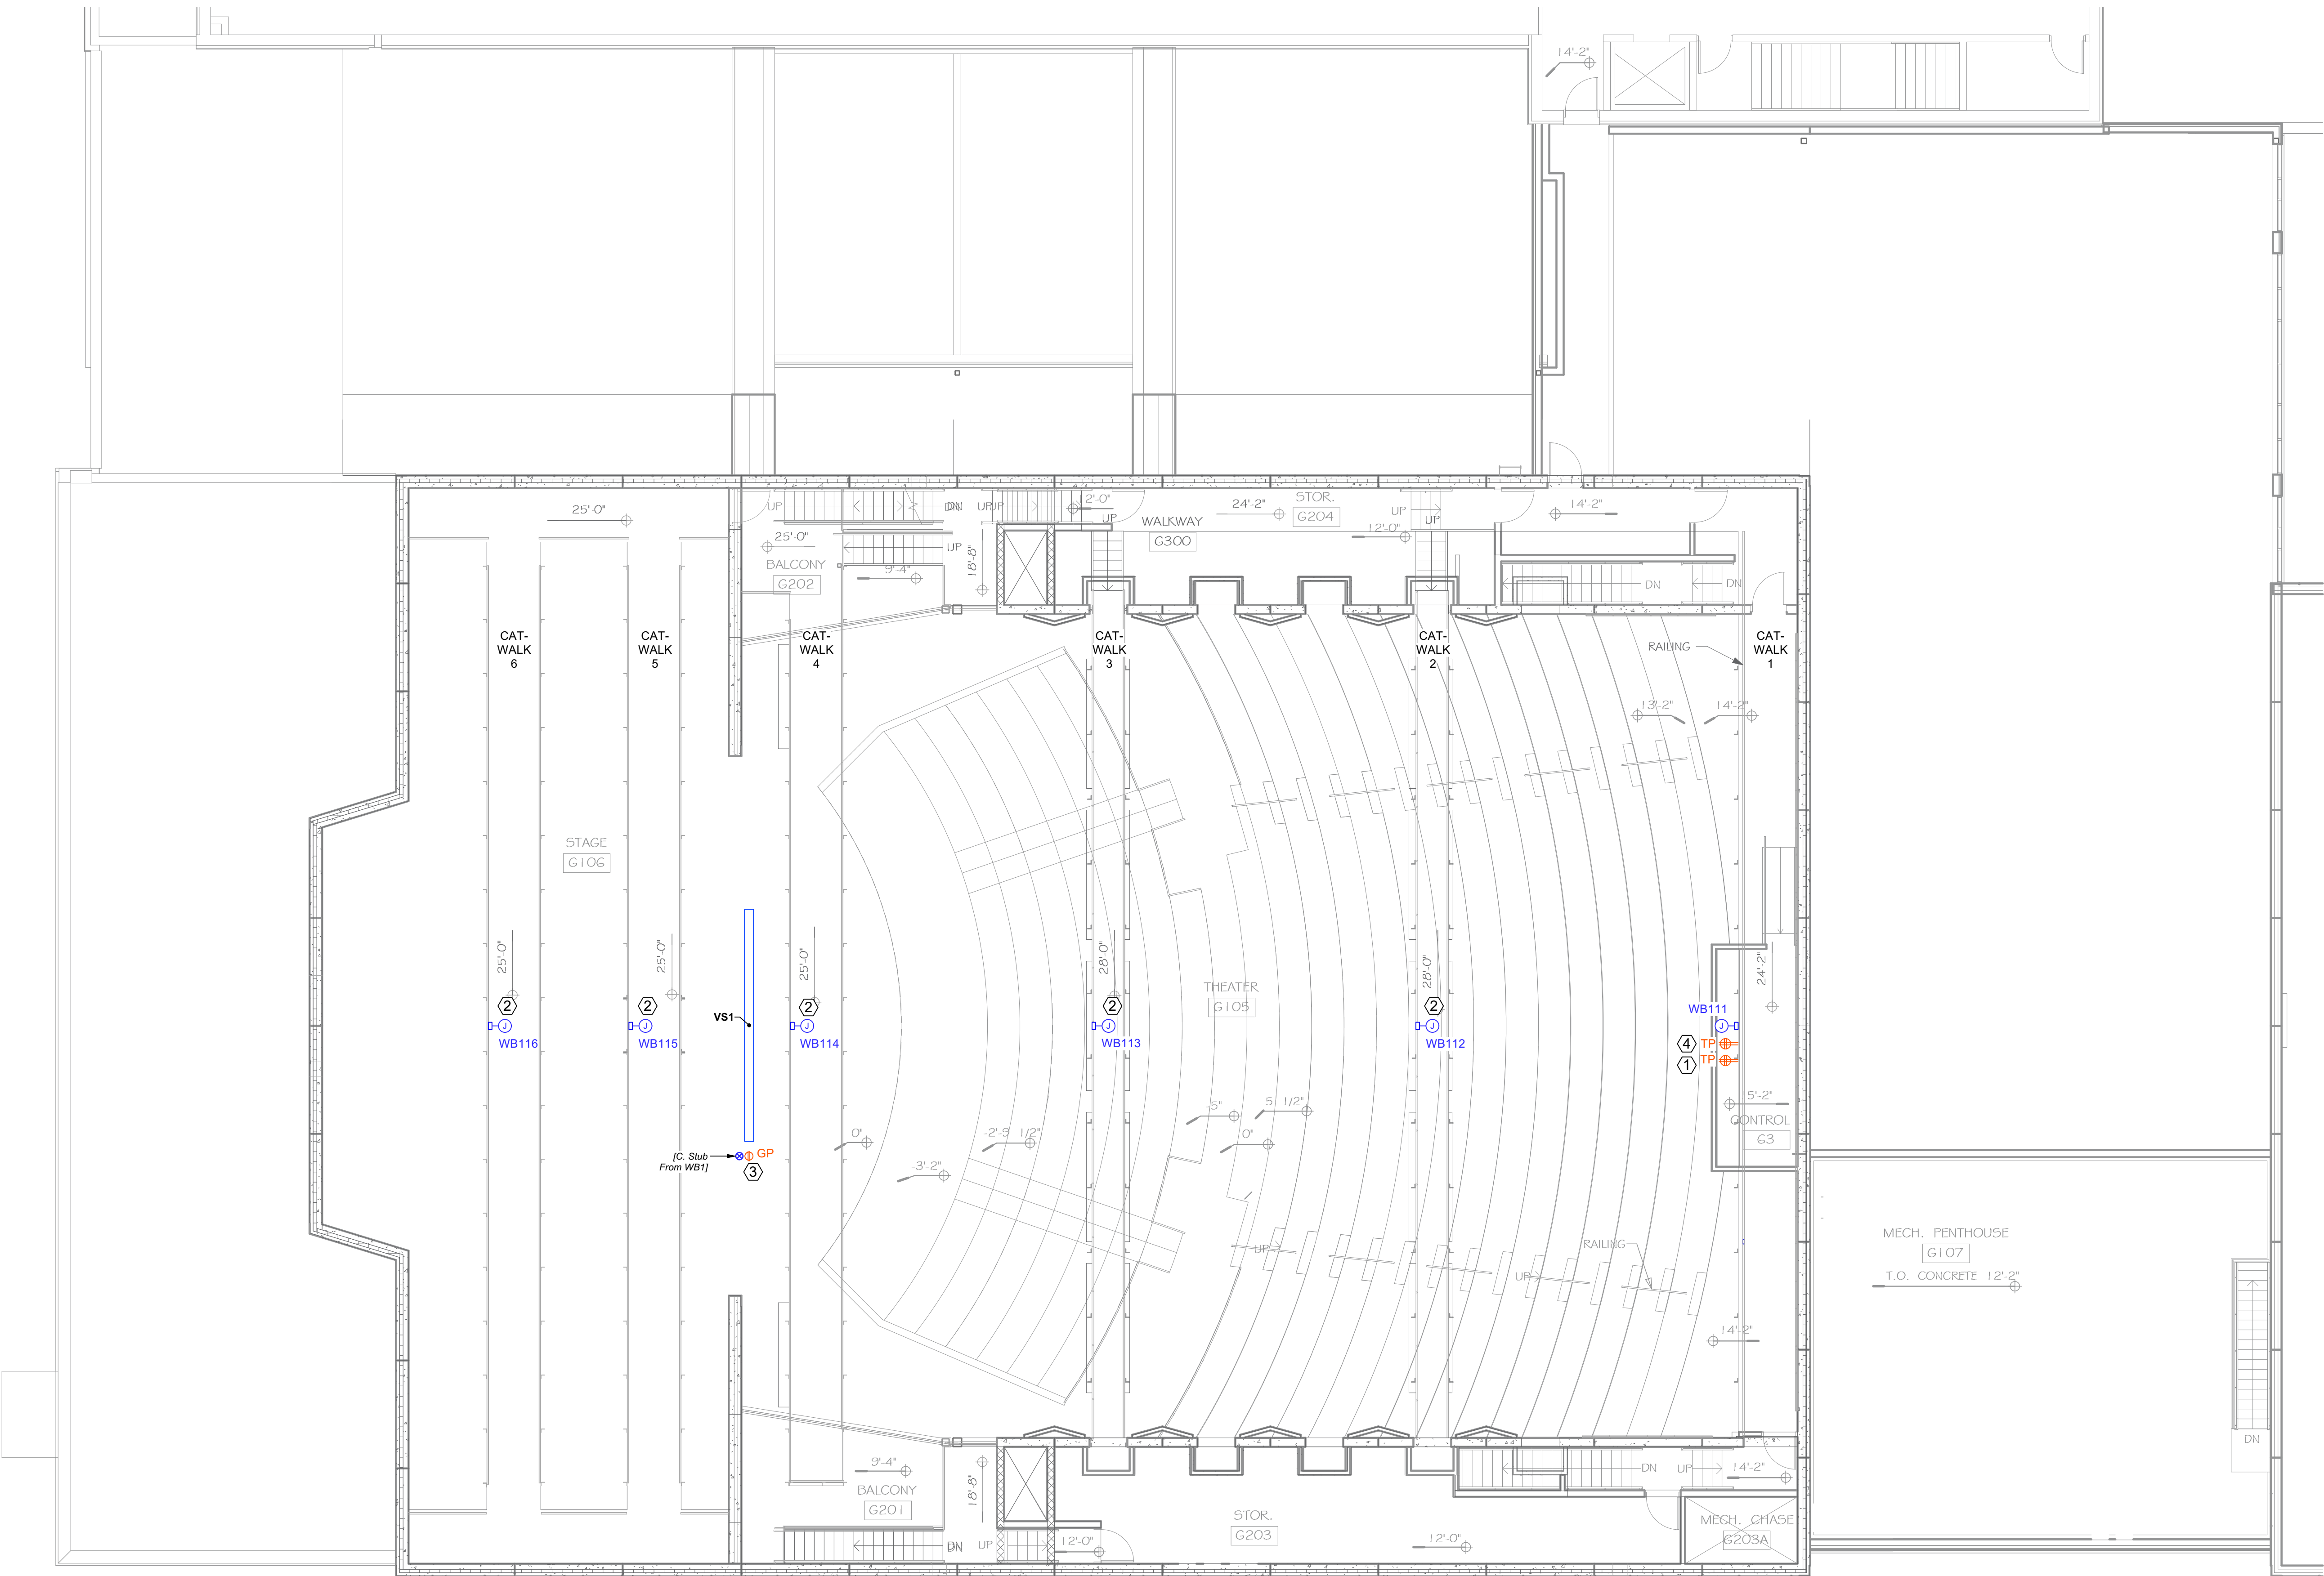

1 Catwalk AVL Plan  
SCALE: 1/8" = 1'-0"

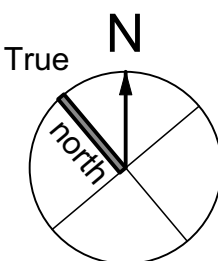

Revision Notes

Client  
**Lennox School District**  
  
Lennox, SD

Project  
**Lennox High School Addition**

Title  
**Catwalk AVL Plan**

Reach Communications  
8600 109th Ave N - Ste 400  
Champlin, MN 55316

Drafted By: JJB  
Scale: See Detail Label  
Rev: 1  
Release Status: Release to CD Coord.

Sheet Size: US Arch E1  
Date: 12/21/23  
Sheet #: **AV-103**





TP - TECH POWER CIRCUIT SCHEDULE FOR AVL											
Space/s: Stair G110											
Type	Purpose	Circuit #	Room	Outlet Location	Height	Qty. Loc.s	Trip(Amps)	Voltage	Poles	VA / Watts	Remarks
TP	Rack Equip 5-20R Outlet-1, AR1		Stair G110	South Wall, Above WB1, See AV-101	12-36" AFF	1	20	120 V	1	1800	Duplex
TP	Rack Equip 5-20R Outlet-2, AR1		Stair G110	South Wall, Above WB1, See AV-101	12-36" AFF	1	20	120 V	1	1800	Duplex
TP	Rack Equip 5-20R Outlet-3, AR1		Stair G110	South Wall, Above WB1, See AV-101	12-36" AFF	1	20	120 V	1	1800	Duplex
TP	Rack Equip 5-20R Outlet-4, AR1		Stair G110	South Wall, Above WB1, See AV-101	12-36" AFF	1	20	120 V	1	1200	Duplex
TP	Rack Equip L5-30R Outlet-5, AR1		Stair G110	South Wall, Above WB1, See AV-101	12-36" AFF	1	30	120 V	1	2880	Simplex
Totals						5			5	9480	
REF: 3-Ph. 120/208V Panel Capacity Required (Amps)										26	
REF: 1-Ph. 120/240V Panel Capacity Required (Amps)										40	

TP - TECH POWER CIRCUIT SCHEDULE FOR AVL											
Space/s: Theater G105											
Type	Purpose	Circuit #	Room	Outlet Location	Height	Qty. Loc.s	Trip(Amps)	Voltage	Poles	VA / Watts	Remarks
TP	Stage AV Power		Stage G106	FB1, FB2	Stage Floor	2	20	120 V	1	1200	2x Duplex in Each FB, Integrated w/ Floor Box
TP	Stage AV Power		Stage G106	FB3, FB4	Stage Floor	2	20	120 V	1	1200	2x Duplex in Each FB, Integrated w/ Floor Box
TP	Stage AV Power		Stage G106	FB5	Stage Floor	1	20	120 V	1	900	2x Duplex in Each FB, Integrated w/ Floor Box
TP	Stage AV Power		Stage G106	FB6	Stage Floor	1	20	120 V	1	900	2x Duplex in Each FB, Integrated w/ Floor Box
TP	Stage AV Power		Stage G106	FB7	Stage Floor	1	20	120 V	1	900	2x Duplex in Each FB, Integrated w/ Floor Box
TP	Control Booth Power		Control G63	Wall; 4x Above Counter	36-48, or Match Others	4	20	120 V	1	1200	
TP	Control Booth Power		Control G63	Wall; 4x Below Counter	12-18", or Match Others	4	20	120 V	1	1200	
TP	CONF Power		Theater G105	Catwalk 1; Front Rail, Center on Stage	6-12" AFF	1	20	120 V	1	1800	Attach to Rail, Facing Sideways to Stage
TP	Catwalk AV Power		Theater G105	Catwalk 1; Front Rail, Center on Catwalk	6-12" AFF re Catwalk	1	20	120 V	1	900	Attach to Rail, Facing Sideways to Stage
TP	Balcony AV Power		Balcony G201	East Wall, See AV-102	12-18" Aff, or Match Others	1	20	120 V	1	900	
TP	Balcony AV Power		Balcony G202	East Wall, See AV-102	12-18" Aff, or Match Others	1	20	120 V	1	900	
Totals						19			11	12000	
REF: 3-Ph. 120/208V Panel Capacity Required (Amps)										33	
REF: 1-Ph. 120/240V Panel Capacity Required (Amps)										50	

GP - GENERAL PURPOSE CIRCUIT SCHEDULE FOR DISTRIBUTED AV											
Space: Common Areas, Displays				NOTE: Example of Electrical Circuiting is Listed Here. New and/or Existing circuits at or near the TV locations can be used for power, and a variety of mixed-usage circuits can be utilized. Nominal circuit loading is 200VA per Flat Panel TV. * Typical Height Listed - Except as Specified Otherwise on AVL Location Plan.							
Type	Purpose	Circuit #	Room	Outlet Location	Height	Qty. Loc.s	Trip(Amps)	Voltage	Poles	VA / Watts	Remarks
GP	Backstage VD		Distributed TV's - Make-Up G112	Adjacent to WB41	78" AFF	1	20	120 V	1	300	Duplex
GP	Lobby VD		Distributed TV's - Lobby F101	Adjacent to WB51	84" AFF	1	20	120 V	1	300	Duplex
Totals						2			2	600	
REF: 3-Ph. 120/208V Panel Capacity Required (Amps)										2	
REF: 1-Ph. 120/240V Panel Capacity Required (Amps)										3	

GP - GENERAL PURPOSE CIRCUIT SCHEDULE FOR UTILITY AV											
Space: Theatre Stage											
Type	Purpose	Circuit #	Room	Outlet Location	Height	Qty. Loc.s	Trip(Amps)	Voltage	Poles	VA / Watts	Remarks
GP	Projection Screen		Stage G106, Screen Motor	Pipe Grid, Behind Left Side of Screen	Pipe Grid	1	20	120 V	1	300	Attach to Pipe, Facing Down
Totals						1			1	300	
REF: 3-Ph. 120/208V Panel Capacity Required (Amps)										1	
REF: 1-Ph. 120/240V Panel Capacity Required (Amps)										1	

THERMAL LOAD TABLE - for AV Equipment in Smaller Enclosed Areas									
Location	Equip. Type	Electrical Watts	Equip. Eff. (Est.d)	Thermal BTU/hr	Type of Thermal Load	(Typical)		(Approximate)	
						Idle Load	On Time Hrs.	Idle / Peak Duty Cycle	Room Occ.?
Stair G110	Audio Amplifiers	8280	80%	5650	Short Duration	15%	6	1.5 hr. Idle / 0.5 hr. Peak	No
Stair G110	AV & Data Equip.	1200	0%	4094	Long Duration	100%	24	NA	No
Electrical Watts : Total Electrical Load in the indicated Area, in Watts (approximated from Volt-Amps, if separate Wattage rating is not available).									
Thermal (BTU/hr) : Thermal Total Load in the indicated area, calculated as Watts x 3.412 BTU/hr per watt.									
(Does not include heat from humans, room lighting or equipment other than AV.)									
(General Cooling Guideline: 1 ton of cooling capacity is required per 12,000 BTU/hr of steady thermal load.)									
Type of Thermal Load = Short Duration : Provide for suitable Air Exchange through this area during peak load periods.									
Type of Thermal Load = Long Duration / Large Idle : Consider additional Cooling by HVAC, as well as Air Exchange during usage periods.									
Type of Thermal Load = Long Duration : Steady Load for Longer Periods, provide appropriate Cooling by HVAC, and/or suitable Air Exchange.									
Idle Load % : This is the percentage of the Thermal BTU/hr value when the system is not running at Peak load or similar.									
On Time Hrs. : This is the typical time per day that the system is on, for Idle & peak periods combined, on days that the system is used.									
Idle / Peak Duty Cycle : This is the approximate duty cycle of Idle periods & Peak periods (or other than Idle, if not operating at Peak).									
Room Occ.?: Yes or No, Is Room Occupied by Humans for Operation or regular Support (other than incidental or infrequent).									

GENERAL NOTES - Electrical Requirements for AVL:

- A. Symbols Legend & General Notes: See AV-001.
- B. Design Responsibility: For AC Electrical Power sources, panels, conduits, wiring and related, all technical details including size, routing, etc. are responsibility of Electrical Designer and/or Electrical Contractor. They must verify compliance with local codes & proper design practice, and make any modifications needed for compliance, while maintaining the original conceptual intent of these plans to the extent possible.
- C. Materials & Installation Responsibility: All items in these Electrical Requirements are supplied & installed by Electrical Contractor, unless indicated otherwise. All electrical power wiring is by Electrical Contractor. All items in this Electrical Requirements plan are mounted by the Electrical Contractor, regardless of supplier, unless indicated otherwise.
- D. Power-limited Cabling: All power-limited and signal cabling for AVL systems is supplied, installed & terminated by AVL Contractor except as indicated specifically otherwise in these drawings.
- EXCEPTION - It is typical that DMX and/or 0-10v control cables for House Lighting fixtures be installed by the Electrical Contractor.
- E. Circuit Details - TP: Technical Power (TP) Ckt.s for AV are each, except where indicated otherwise, a separate 120VAC @ 20A Ckt, wired (for all completely new circuits) as Isolated-Ground and Dedicated (Separate) Neutral to receptacles (IG type) at each outlet location. For all new outlets, these must be NEMA config. 5-20R, or other special outlet type per specific call-out. If existing & not designated specifically as 5-20R, or where approved, outlets may be NEMA 5-15R by exception.
- F. Circuit Details – LP: Lighting Power (LP) Ckt.s are each a separate 120VAC @ 20A Ckt, wired as a Dedicated (Separate) Neutral, to an outlet receptacle as defined per symbol, for individual circuits. For LP special receptacles & multi-phase circuits, where these are indicated, an appropriately sized dedicated neutral is required. All LP outlets must be NEMA 5-20R (NOT 5-15R), unless listed otherwise.
- G. Non-Tech Power: GP receptacles, as indicated, are dedicated for AV equipment that can be powered by the nearest general power circuit. We include these power requirements, when necessary, to aid in switch gear and power distribution sizing, by Electrical Consultant or Contractor.
- H. Convenience Electrical Power: Not Shown. Convenience power is for general use, and additional outlets & circuits should be added and located accordingly, per code and as determined by others.
- I. Control Panel & Receptacle Elevations: Match existing, per code, unless otherwise noted.
- J. Floor Boxes: Floor boxes specified by AV Contractor may have integrated electrical receptacles, and will be indicated as such by the placement of a TP electrical receptacle symbol adjacent to the floor box on the Reach AVL plan set or mark-up. Verify exact placement and mounting depth prior to rough-in.
- K. Wall and Ceiling Boxes: Wall and Ceiling boxes will generally NOT have integrated electrical receptacles, unless otherwise indicated by call-out. SEE Box Schedule AV-002 for sizes and elevations.
- L. Receptacle & Control Panel Elevations: Match existing, per code, unless otherwise noted.
- M. Labels: Electrical Contractor must professionally label all electrical power outlets, at the outlet locations, that are installed for TP or LP purposes. Use a code indicating source panel and circuit number. For example, use TP-A-10 for each outlet connected to Technical Power panel A, Ckt 10, or similar code.
- N. Bonding: Bond metal enclosures for AV, all Device boxes & J-Boxes, etc. to Earth Ground, and verify all AV metal conduits and metal boxes have a bonding path to Earth Ground.
- O. Load Center Panel & Conduit Segregation: AV Tech Power (TP) must be segregated from other load power circuits, preferably using a dedicated Load Center panel (or panels). Keep TP wiring segregated within any shared panel(s). Also, keep TP wiring and associated conduits segregated from wiring used for dimmed lighting, including all LP circuits, and other electrically 'noisy' loads, as well as separate from all other general purpose loads and their associated panels & conduits. Do NOT run AV Tech Power wiring in the same conduits with wiring for LP circuits or similar.
- P. Electrical Supply Comments: For any new major work, a separate transformer for AV Technical Power, where feasible, is useful for additional isolation from other loads. Transformers that are appropriately K-rated (e.g. K-13) should be used where feasible, for both TP & LP, due to the harmonic currents encountered with AV electronics, computers, UPS units & dimmer loads.

Revision Notes

Client

Lennox School District

Lennox, SD

Project

Lennox High School Addition

Title

Electrical & Thermal Requirements for AVL



Reach Communications

8600 109th Ave N - Ste 400  
Champlin, MN 55316

Drafted By: JJB

Scale: None Sheet Size: US Arch E1  
Rev: 1 Date: 12/21/23

Release Status:

Release to CD Coord.

Sheet #:

AV-211